



Technical drawing of a 3x3 grid of window units. The drawing includes dimensions for the total unit, sash, and nail fin, as well as labels for glass and glass logo.

Dimensions:

- TOT UNIT = 2578 [8'-5 1/2"]** (Total width)
- SASH = 730 [2'-4 3/4"]** (Sash width)
- NAIL FIN = 852 [2'-9 9/16"]** (Nail fin width)
- SASH = 1695 [5'-6 11/16"]** (Sash height)
- TOT UNIT = 2934 [9'-7 1/2"]** (Total height)
- NAIL FIN = 1772 [5'-9 3/4"]** (Nail fin height)
- SASH = 580,5 [1'-10 7/8"]** (Sash height)
- NAIL FIN = 657 [2'-1 7/8"]** (Nail fin height)


Labels:


- G 1** (Glass label)
- GLASS LOGO** (Glass logo label)

PD47.....	Guarnizione interna fermavetro
.....	Piattina a cellule chiuse per vetro
AC2608	Clips per fermavetri
AC2683	Kit cremonese (graz) un anta ap. est.
AC2626R	Punto chiusura supplementare
GE2543TT	Guarnizione battuta
GE2645TT	Guarnizione anta
AC2648	Cerniera in acciaio zincato a 3 ali verniciata come serramento
.....	Maniglia vedi TS
AC2680	Maniglia a spingere vedi TS
.....	Braccio limitatore Cotswold
Vetro	G1 - sp. 44 mm [1 3/4"]
Zanzariera	-
Fermavetro	"Sloped" in alluminio
Finitura	Vedi title sheet


PD47.....	Interior bead gasket
.....	Foam tape for glazing
AC2608	Glazing bead clips
AC2683	Cremone bolt set (graz) single outswing leaf
AC2626R	Additional locking point for windows
GE2543TT	Frame weatherstrip
GE2645TT	Sash weatherstrip
AC2648	Galvanized 3 wings hinges - painted to match frame
.....	Round cam handle see TS
.....	Push out handle see TS
.....	Cotswold friction stay arm
Glass	G1 - thk. 44 mm [1 3/4"]
Fly screen	-
Glazing bead	"Sloped" in aluminium
Finishing	See title sheet

RECORD SET
MAY 11th 2020

3	RECORD SET 1	11-05-2020
2	RECORD SET	28-10-2019
1	GENERAL REVISION	17-10-2019
REV.	OBJECT OF THE REVISION - OGGETTO DELLA REVISIONE	DATE / DATA
 <div style="display: inline-block; vertical-align: middle;"> <h1 style="margin: 0;">BROMBAL</h1> <p style="margin: 0;">LUXURY METAL WINDOWS AND DOORS</p> </div>		
<div style="display: flex; justify-content: space-between;"> <div> <p>Via Vallà, 24 - Caselle di Altivole - TV 31030 - ITALY info@brombal.it - www.serramentibrombal.it Tel. (0039) 0423-566.189</p> </div> <div> <p>690 Surf Avenue - Stratford - CT 06615 - USA sales@brombalusa.com - www.brombalusa.com Phone (001) 203-579.5136</p> </div> </div>		
Client:	Type:	Date:
Cliente: GALE RESIDENCE	Tipologia: *	Data: 04/09/2019
Field: *	Position:	Scale:
Cantiere: *	Posizione: *	Scala: 1:24
Object: Elevation	Quantity:	Sheet:
Oggetto: *	Quantità: *	Tavola: N132_1
<p><small>*These drawings belong to Serramenti Brombal S.r.l. with prohibition of reproduction or communication to third parties without permission.</small></p>		

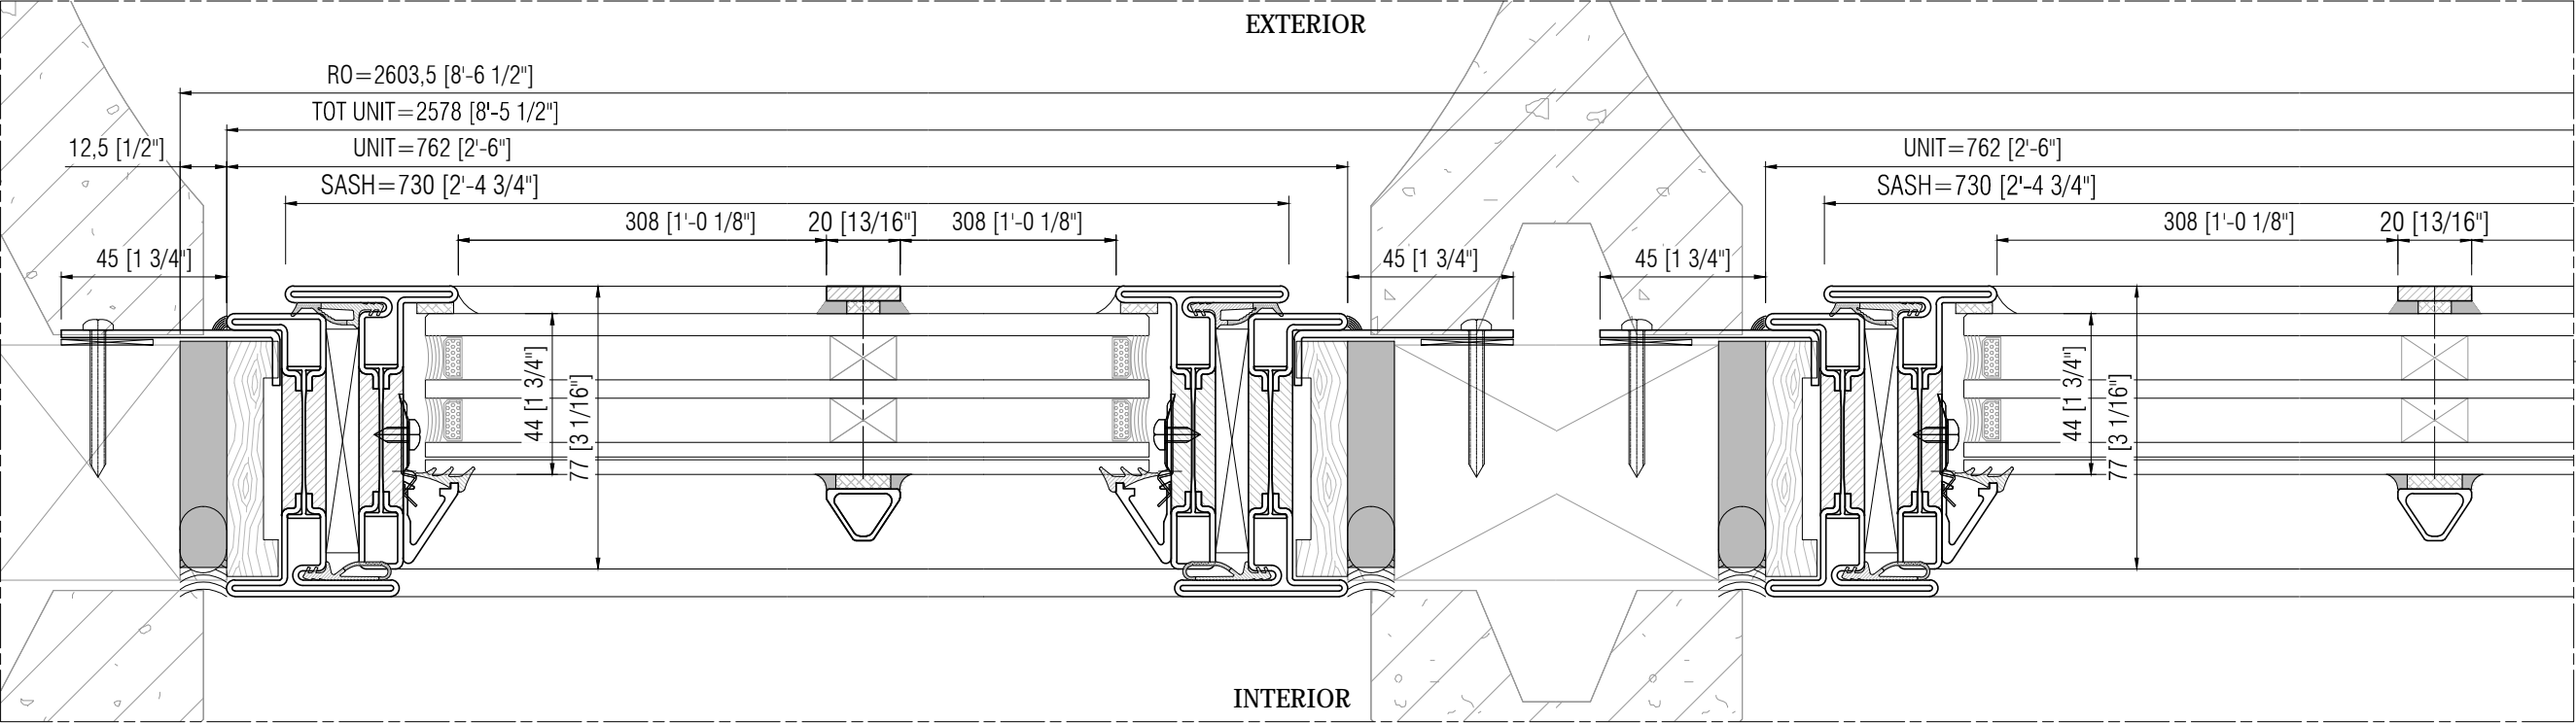


A HORIZONTAL SECTION
Scale: 1:2 - [1"=2"]

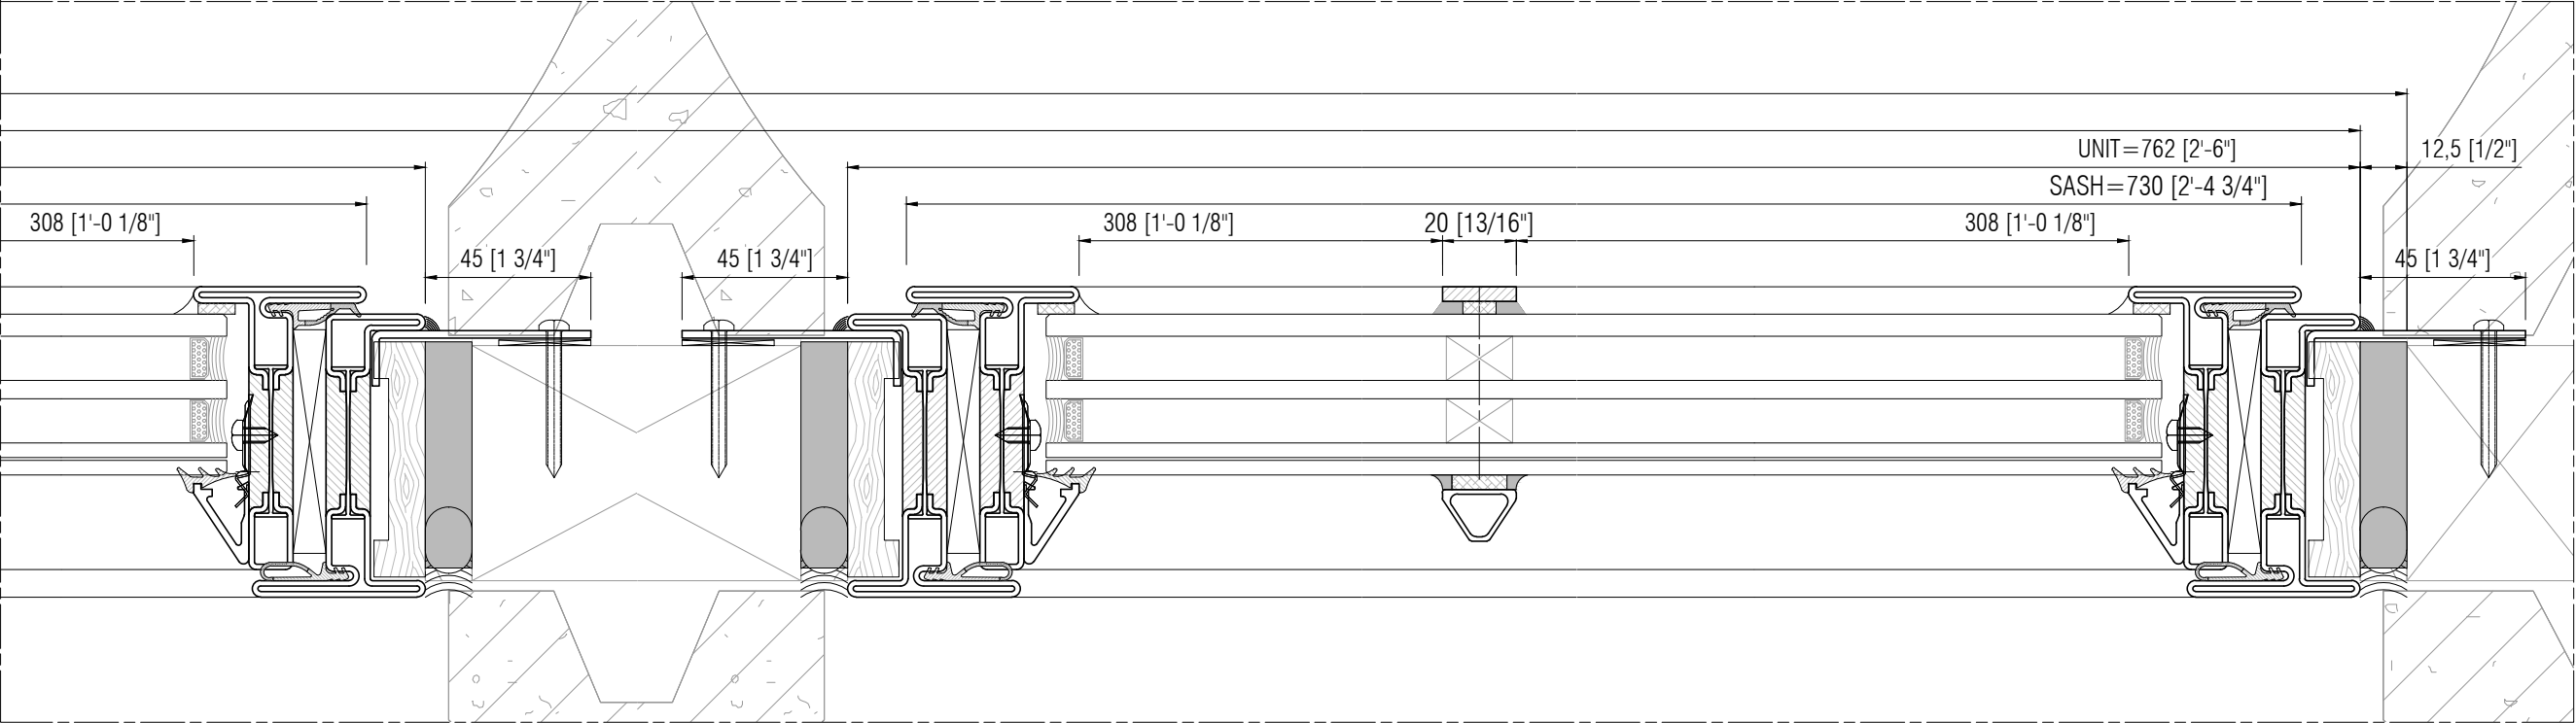

APPROVED
MAY 11th 2020


RECORD SET
MAY 11th 2020

3	RECORD SET 1	11-05-2020
2	RECORD SET	28-10-2019
1	GENERAL REVISION	17-10-2019
REV.	OBJECT OF THE REVISION - OGGETTO DELLA REVISIONE	DATE / DATA
<div><div><div></div></div><div>BROMBAL LUXURY METAL WINDOWS AND DOORS</div><div><div>Via Valla, 24 - Caselle di Altivole - TV 31030 - ITALY info@brombal.it - www.serramentibrombal.it Tel. (0039) 0423-566.189</div><div>690 Surf Avenue - Stratford - CT 06615 - USA sales@brombalusa.com - www.brombalusa.com Phone (001) 203-579.5136</div></div></div>		
Client:	GALE RESIDENCE	Date: 04/09/2019
Field:		Scale: 1:2
Cantiere:		Sheet: N132_2
Object: Details	Quantity:	Tavola:
Objecto:	Quantità:	
These drawings belong to Serramenti Brombal S.r.l. with prohibition of reproduction or communication to third parties without permission		

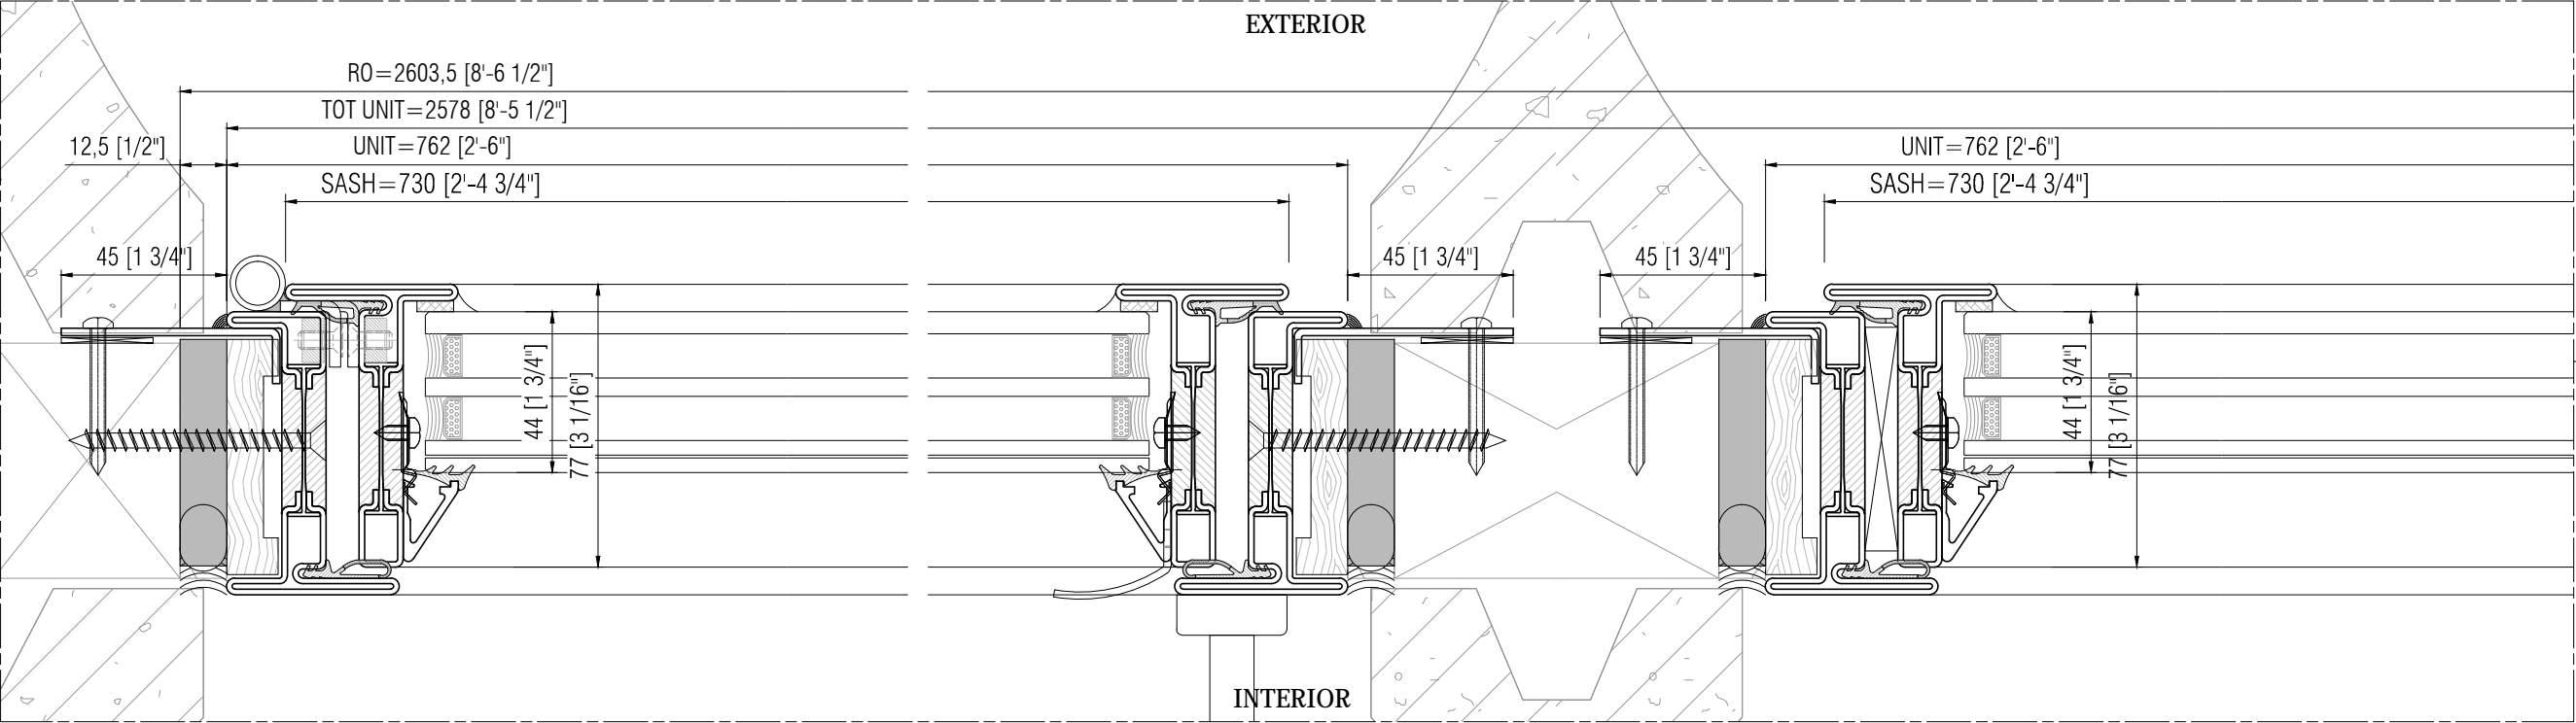


D HORIZONTAL SECTION


Scale: 1:2 - [1"=2"]

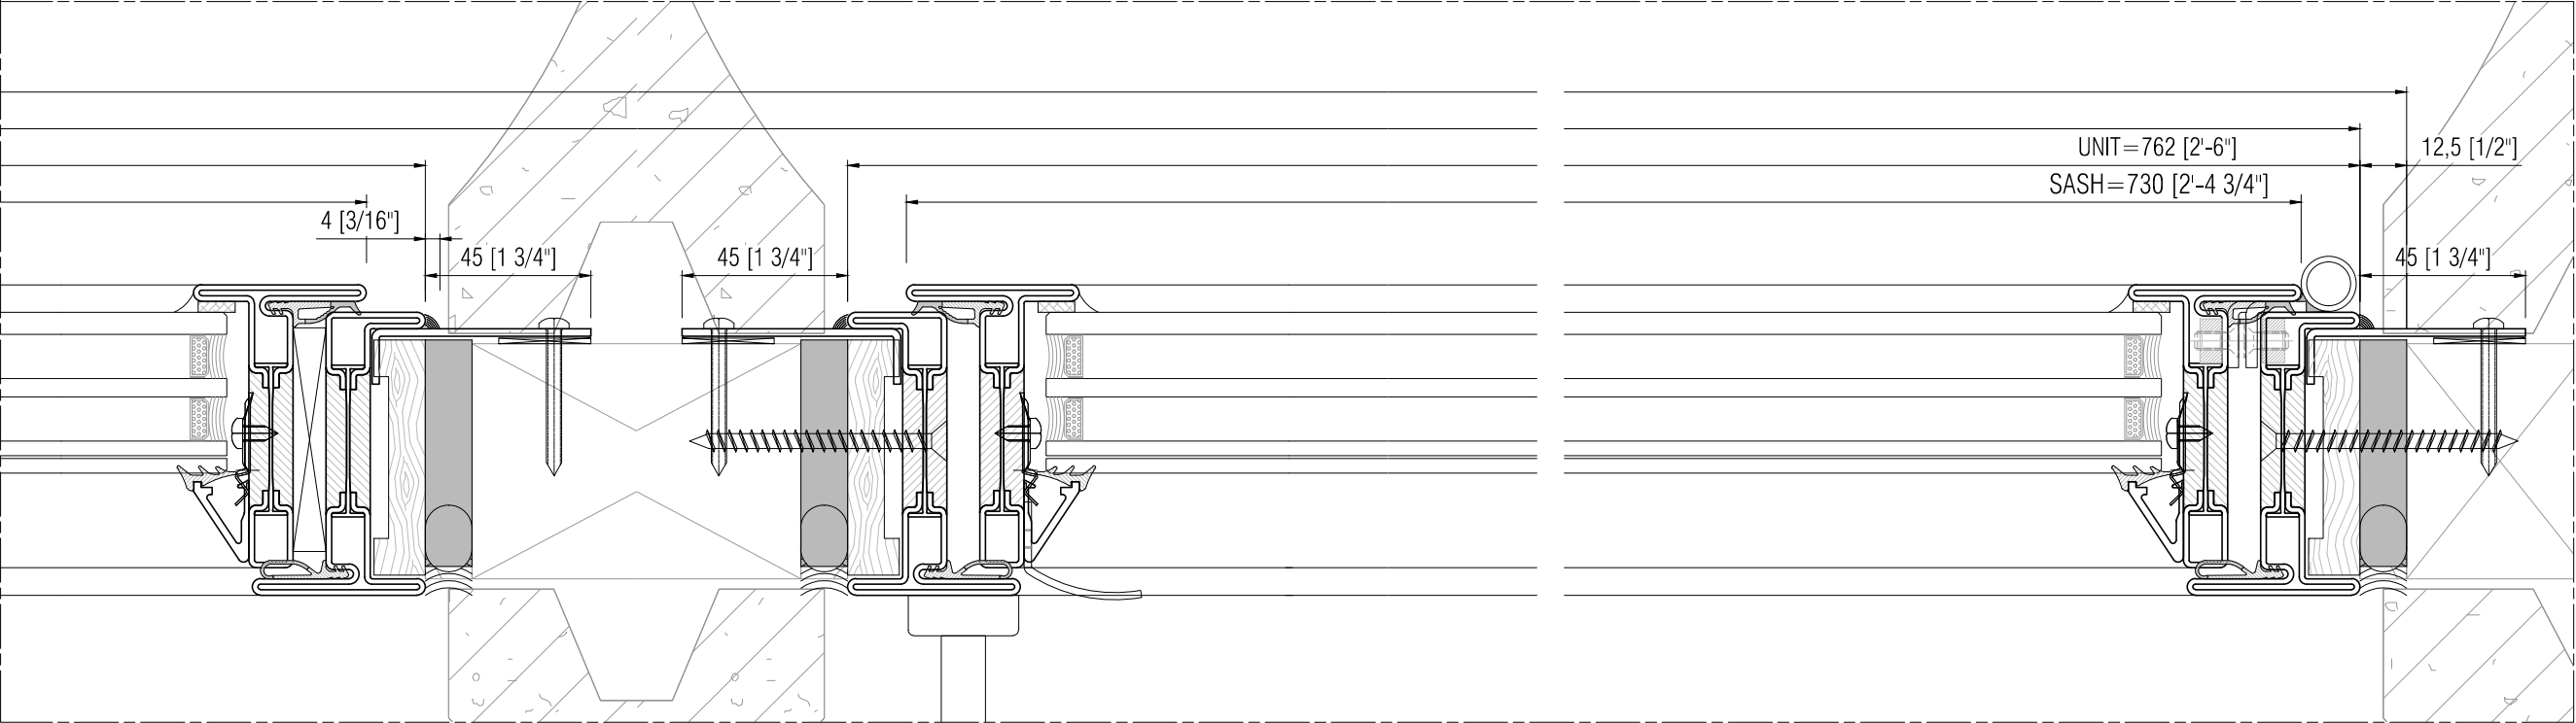

APPROVED
MAY 11th 2020


RECORD SET
MAY 11th 2020

3	RECORD SET 1	11-05-2020
2	RECORD SET	28-10-2019
1	GENERAL REVISION	17-10-2019
REV.	OBJECT OF THE REVISION - OGGETTO DELLA REVISIONE	DATE / DATA
<div><div></div><div>BROMBAL LUXURY METAL WINDOWS AND DOORS</div></div> <div><div>Via Valla, 24 - Caselle di Altivole - TV 31030 - ITALY info@brombal.it - www.serramentibrombal.it Tel. (0039) 0423-566.189</div><div>690 Surf Avenue - Stratford - CT 06615 - USA sales@brombalusa.com - www.brombalusa.com Phone (001) 203-579.5136</div></div>		
Client:	GALE RESIDENCE	Date: 04/09/2019
Field:		Scale: 1:2
Cantiere:		Sheet: N132_3
Object: Details	Quantity:	Tavola:
Object:	Quantity:	Tavola:
These drawings belong to Serramenti Brombal S.r.l. with prohibition of reproduction or communication to third parties without permission		

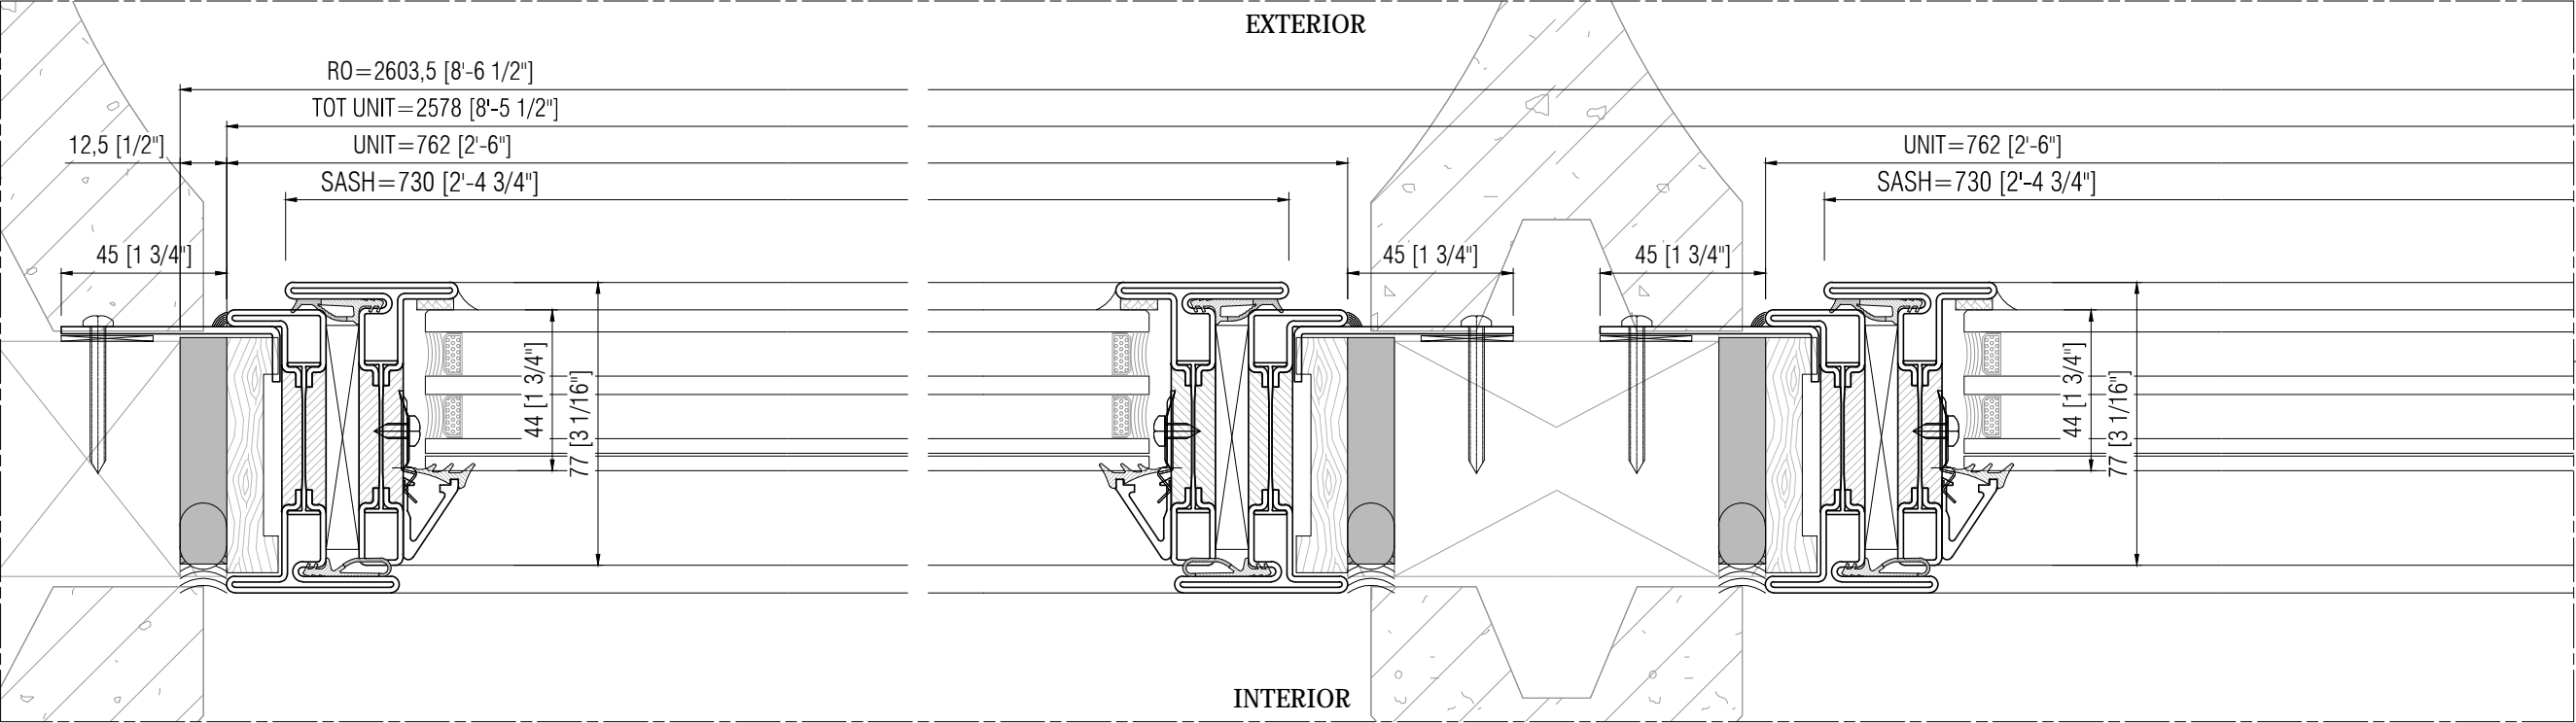

E HORIZONTAL SECTION


Scale: 1:2 - [1"=2"]

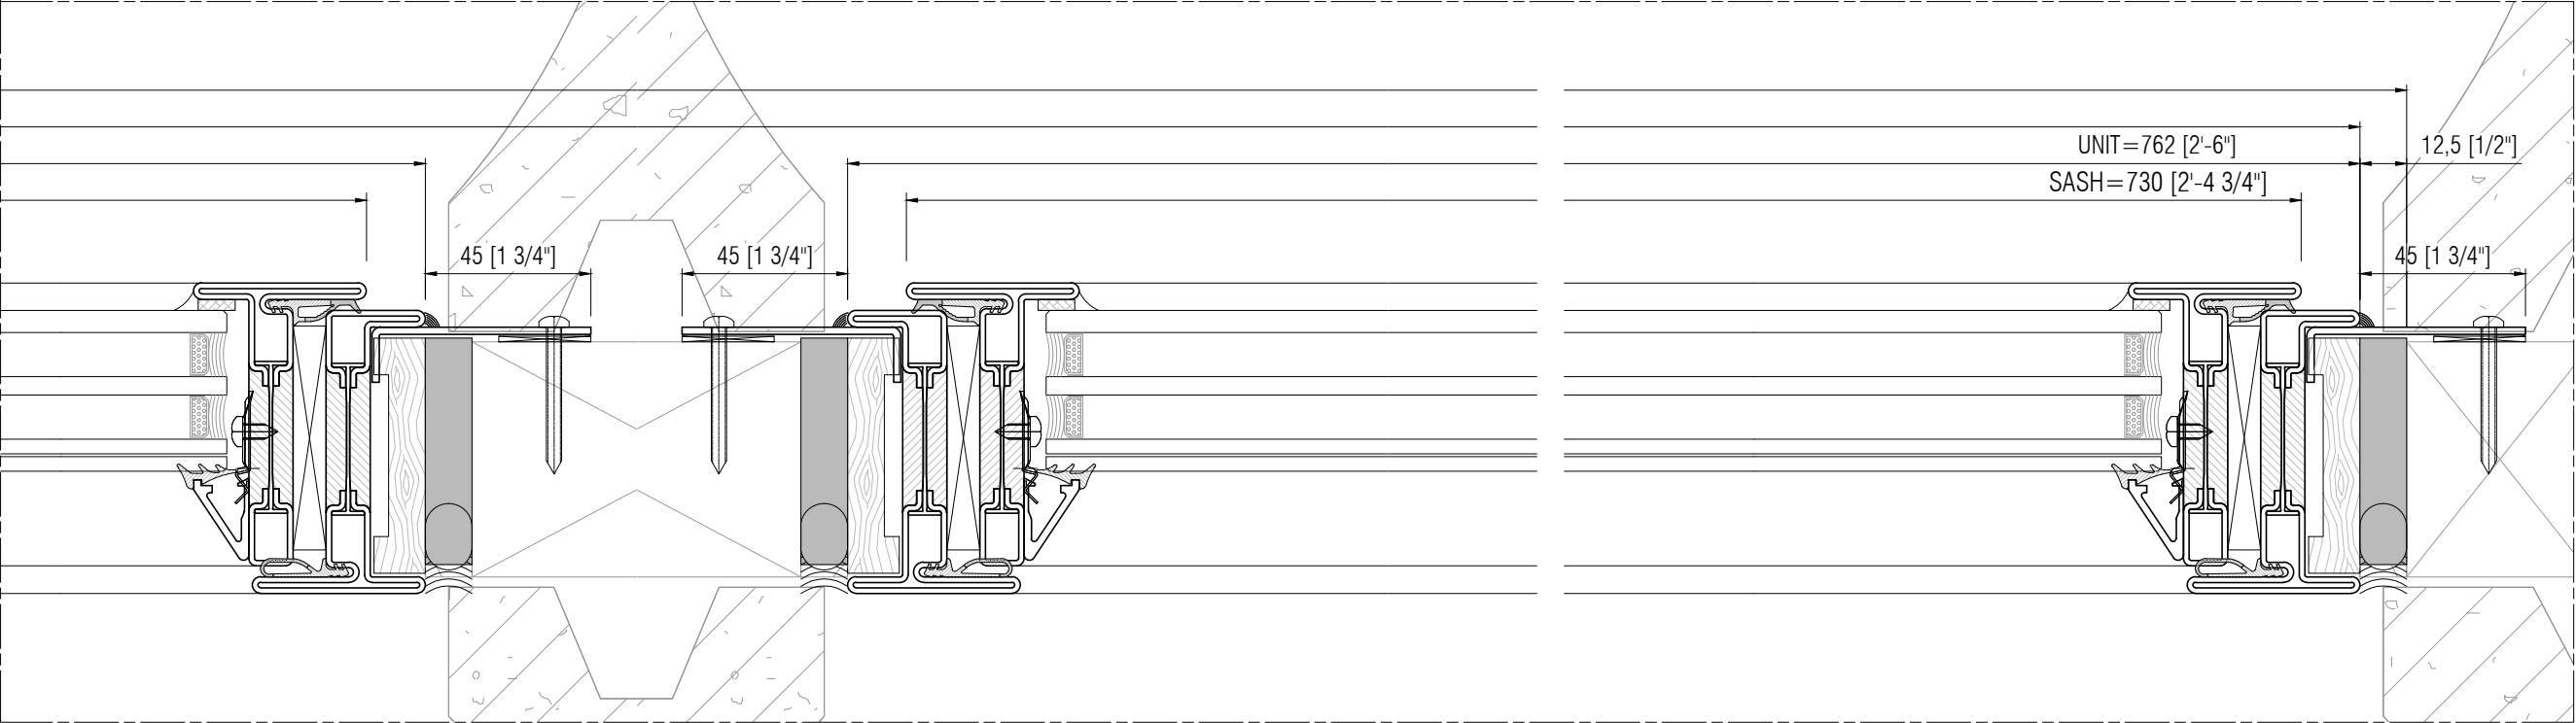


APPROVED
MAY 11th 2020

RECORD SET
MAY 11th 2020

3	RECORD SET 1	11-05-2020
2	RECORD SET	28-10-2019
1	GENERAL REVISION	17-10-2019
REV.	OBJECT OF THE REVISION - OGGETTO DELLA REVISIONE	DATE / DATA
<div><div><div></div><div>BROMBAL</div><div>LUXURY METAL WINDOWS AND DOORS</div></div><div><div>Via Valla, 24 - Caselle di Altivole - TV 31030 - ITALY</div><div>info@brombal.it - www.serramentibrombal.it</div><div>Tel. (0039) 0423-566.189</div></div><div><div>690 Surf Avenue - Stratford - CT 06615 - USA</div><div>sales@brombalusa.com - www.brombalusa.com</div><div>Phone (001) 203-579.5136</div></div></div>		
Client:	GALE RESIDENCE	Date: 04/09/2019
Field:		Scale: 1:2
Cantiere:		Sheet: N132_4
Object: Details	Quantity:	Tavola:
Object:	Quantity:	Tavola:
These drawings belong to Serramenti Brombal S.r.l. with prohibition of reproduction or communication to third parties without permission		

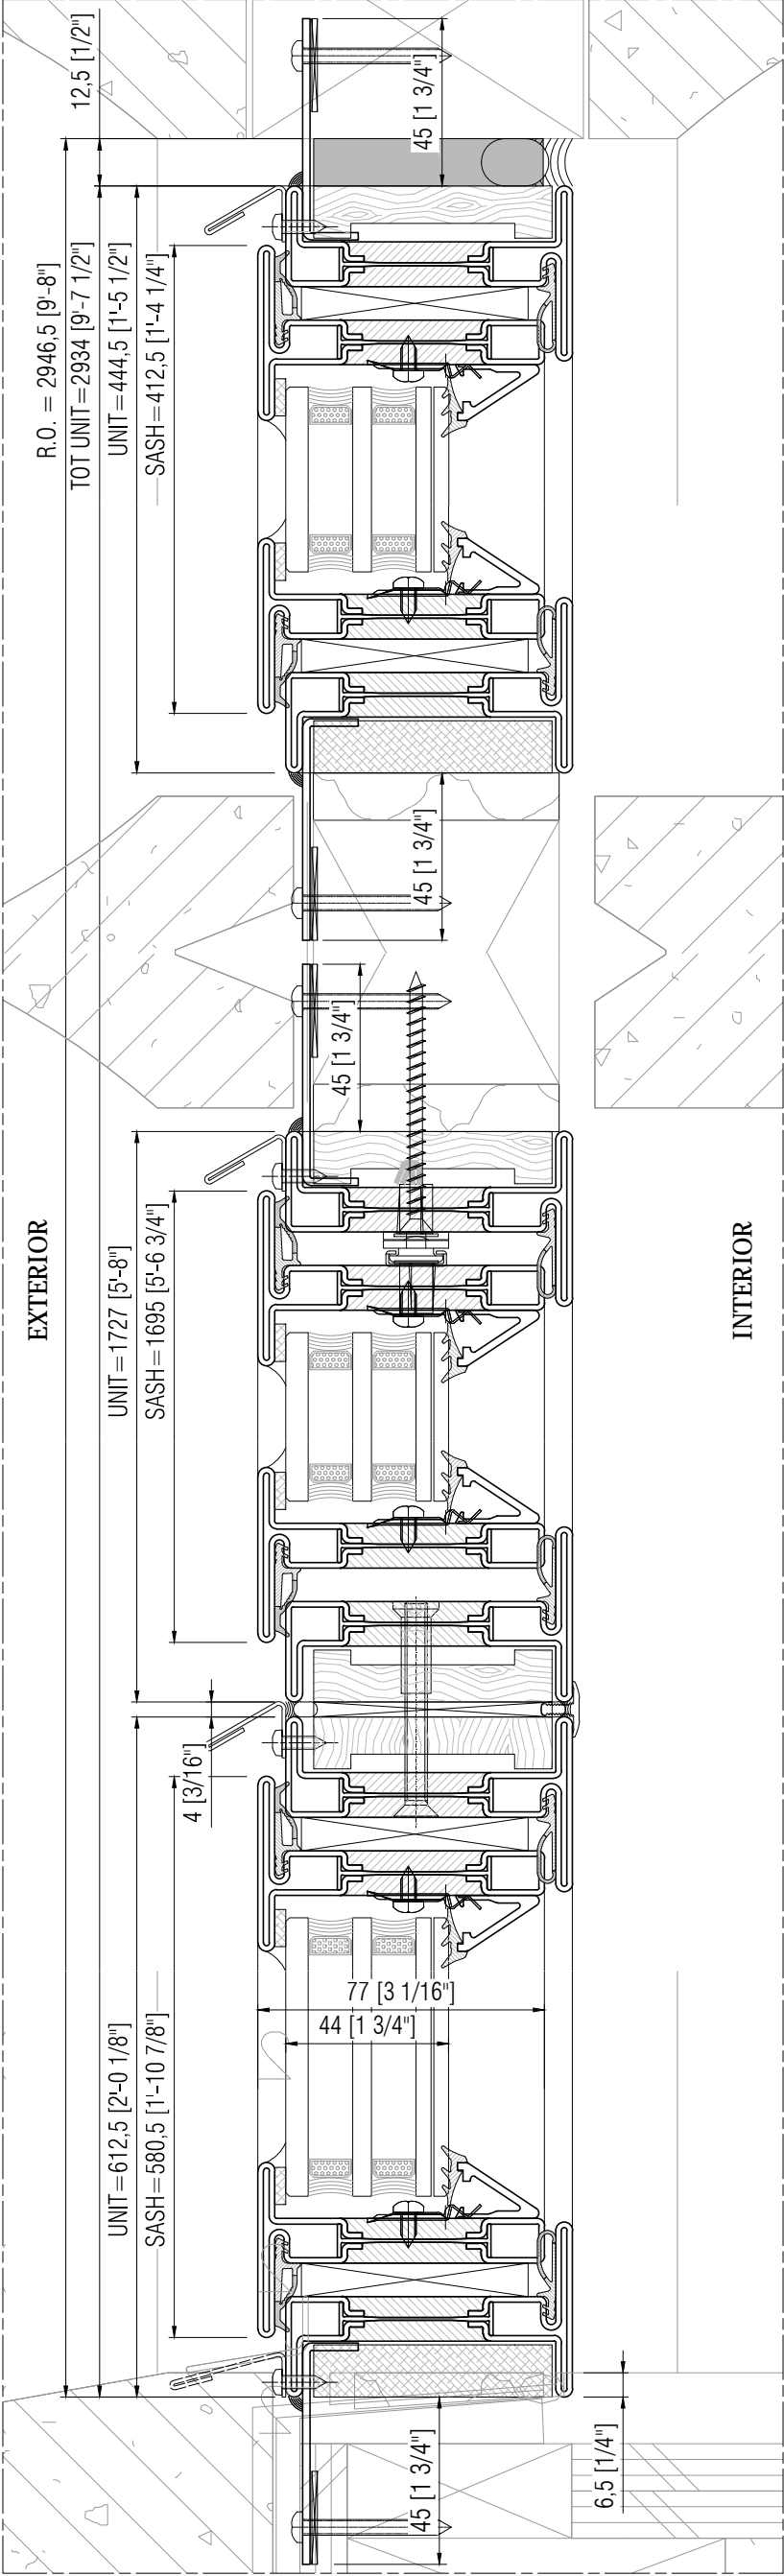

B VERTICAL SECTION
Scale: 1:2 - [1"=2"]

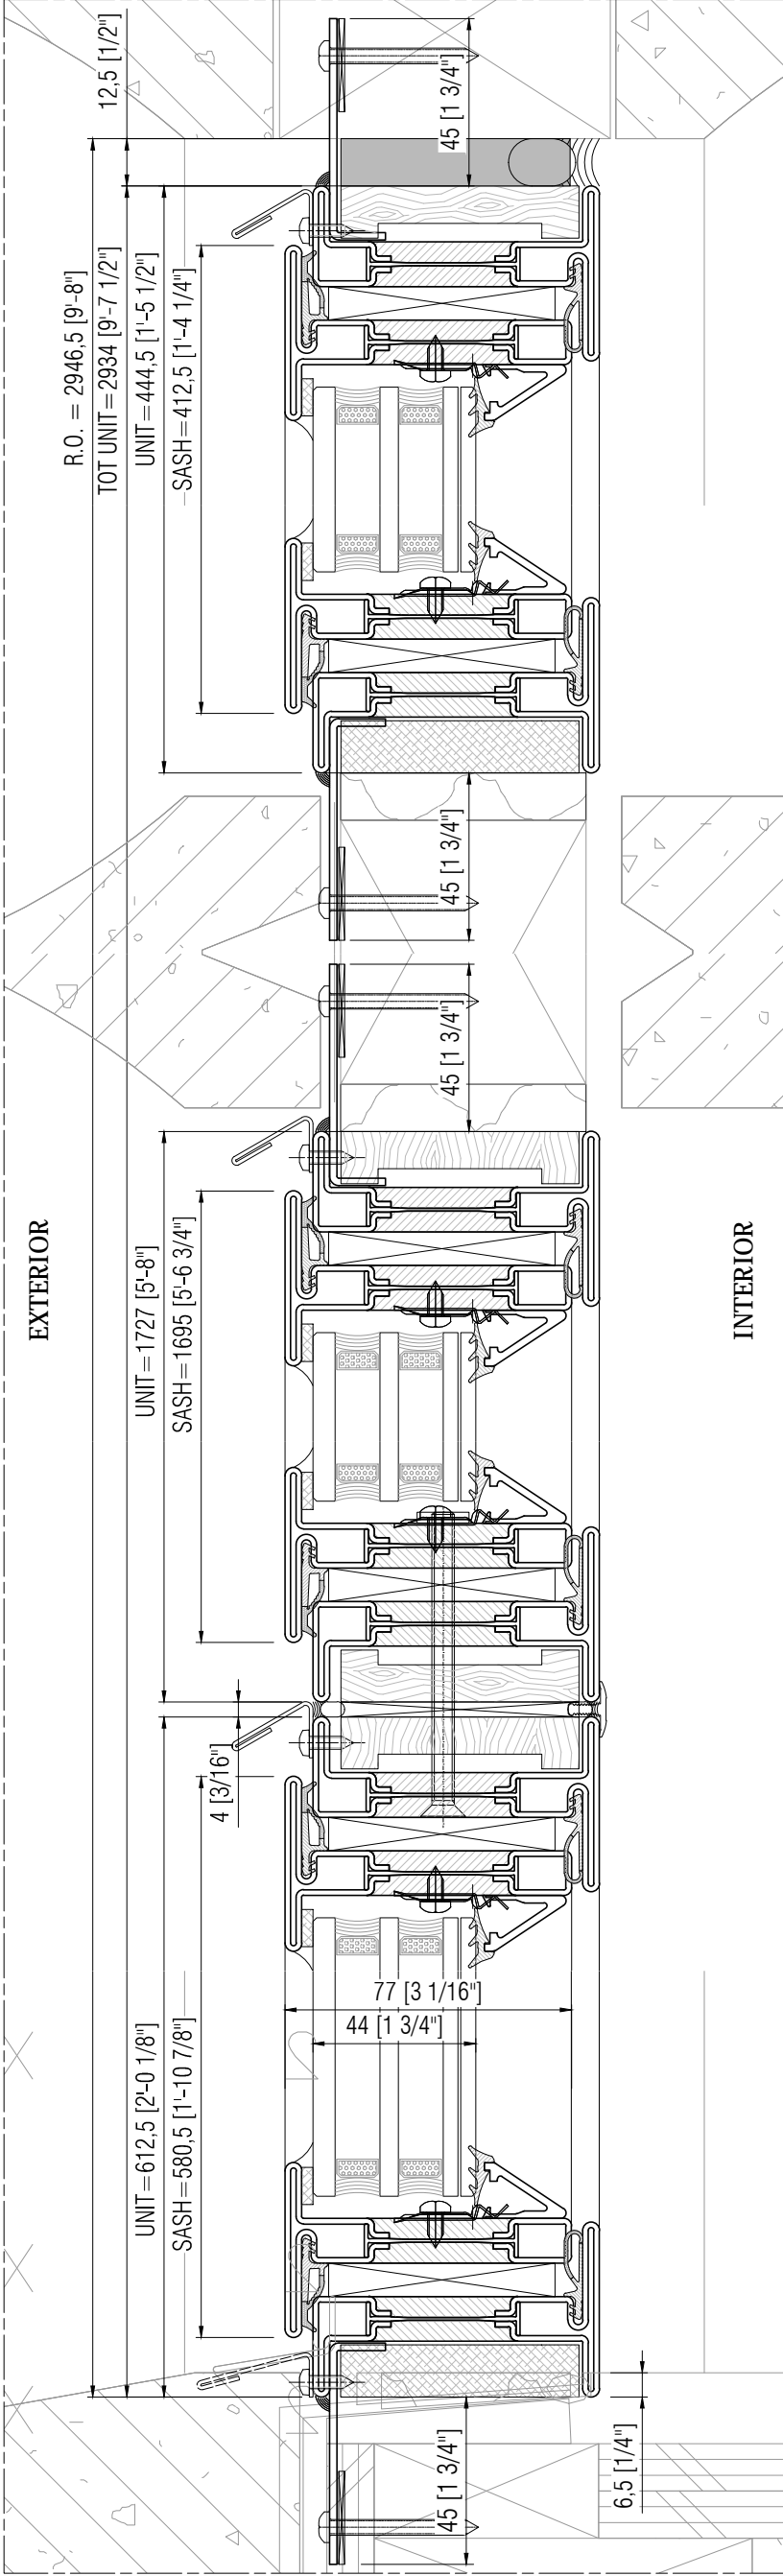

C VERTICAL SECTION
Scale: 1:2 - [1"=2"]

APPROVED
MAY 11th 2020

RECORD SET
MAY 11th 2020

3	RECORD SET 1	11-05-2020
2	RECORD SET	28-10-2019
1	GENERAL REVISION	17-10-2019
REV.	OBJECT OF THE REVISION - OGGETTO DELLA REVISIONE	DATE / DATA
<div><div><div></div><div>B</div></div><div><div>BROMBAL</div><div>LUXURY METAL WINDOWS AND DOORS</div><div>Via Vallà, 24 - Caselle di Altivole - TV 31030 - ITALY info@brombal.it - www.serramentibrombal.it Tel. (0039) 0423-566.189</div></div><div><div>690 Surf Avenue - Stratford - CT 06615 - USA sales@brombalusa.com - www.brombalusa.com Phone (001) 203-579.5136</div></div></div>		
Client:	GALE RESIDENCE	Date: 04/09/2019
Field:		Scale: 1:2
Object: Details	Quantity:	Sheet: N132_5
Oggetto:	Quantità:	Tavola:
These drawings belong to Serramenti Brombal S.r.l. with prohibition of reproduction or communication to third parties without permission		