



1 PARTIAL EAST ELEVATION @ GARAGE WING (1/A2.02)
 $3/8'' = 1'-0"$ 0' 1' 2' 3' 4' 5'




		KASOTA STONE 820 WILLOW STREET MANKATO MN, 56001 (507) 508-0684
Drawing Title: Elevations		
Project: GALE ROAD		
7/29/20 1-Arch Redlines		
Date	Description	Architect: TEA2 ARCHITECTS
Revisions	Drawn By:	General Contractor: XX
	PDD	Date: 03/10/2021
		Scale: 3/8" = 1'-0"
		Drawing Number: 1 of 14

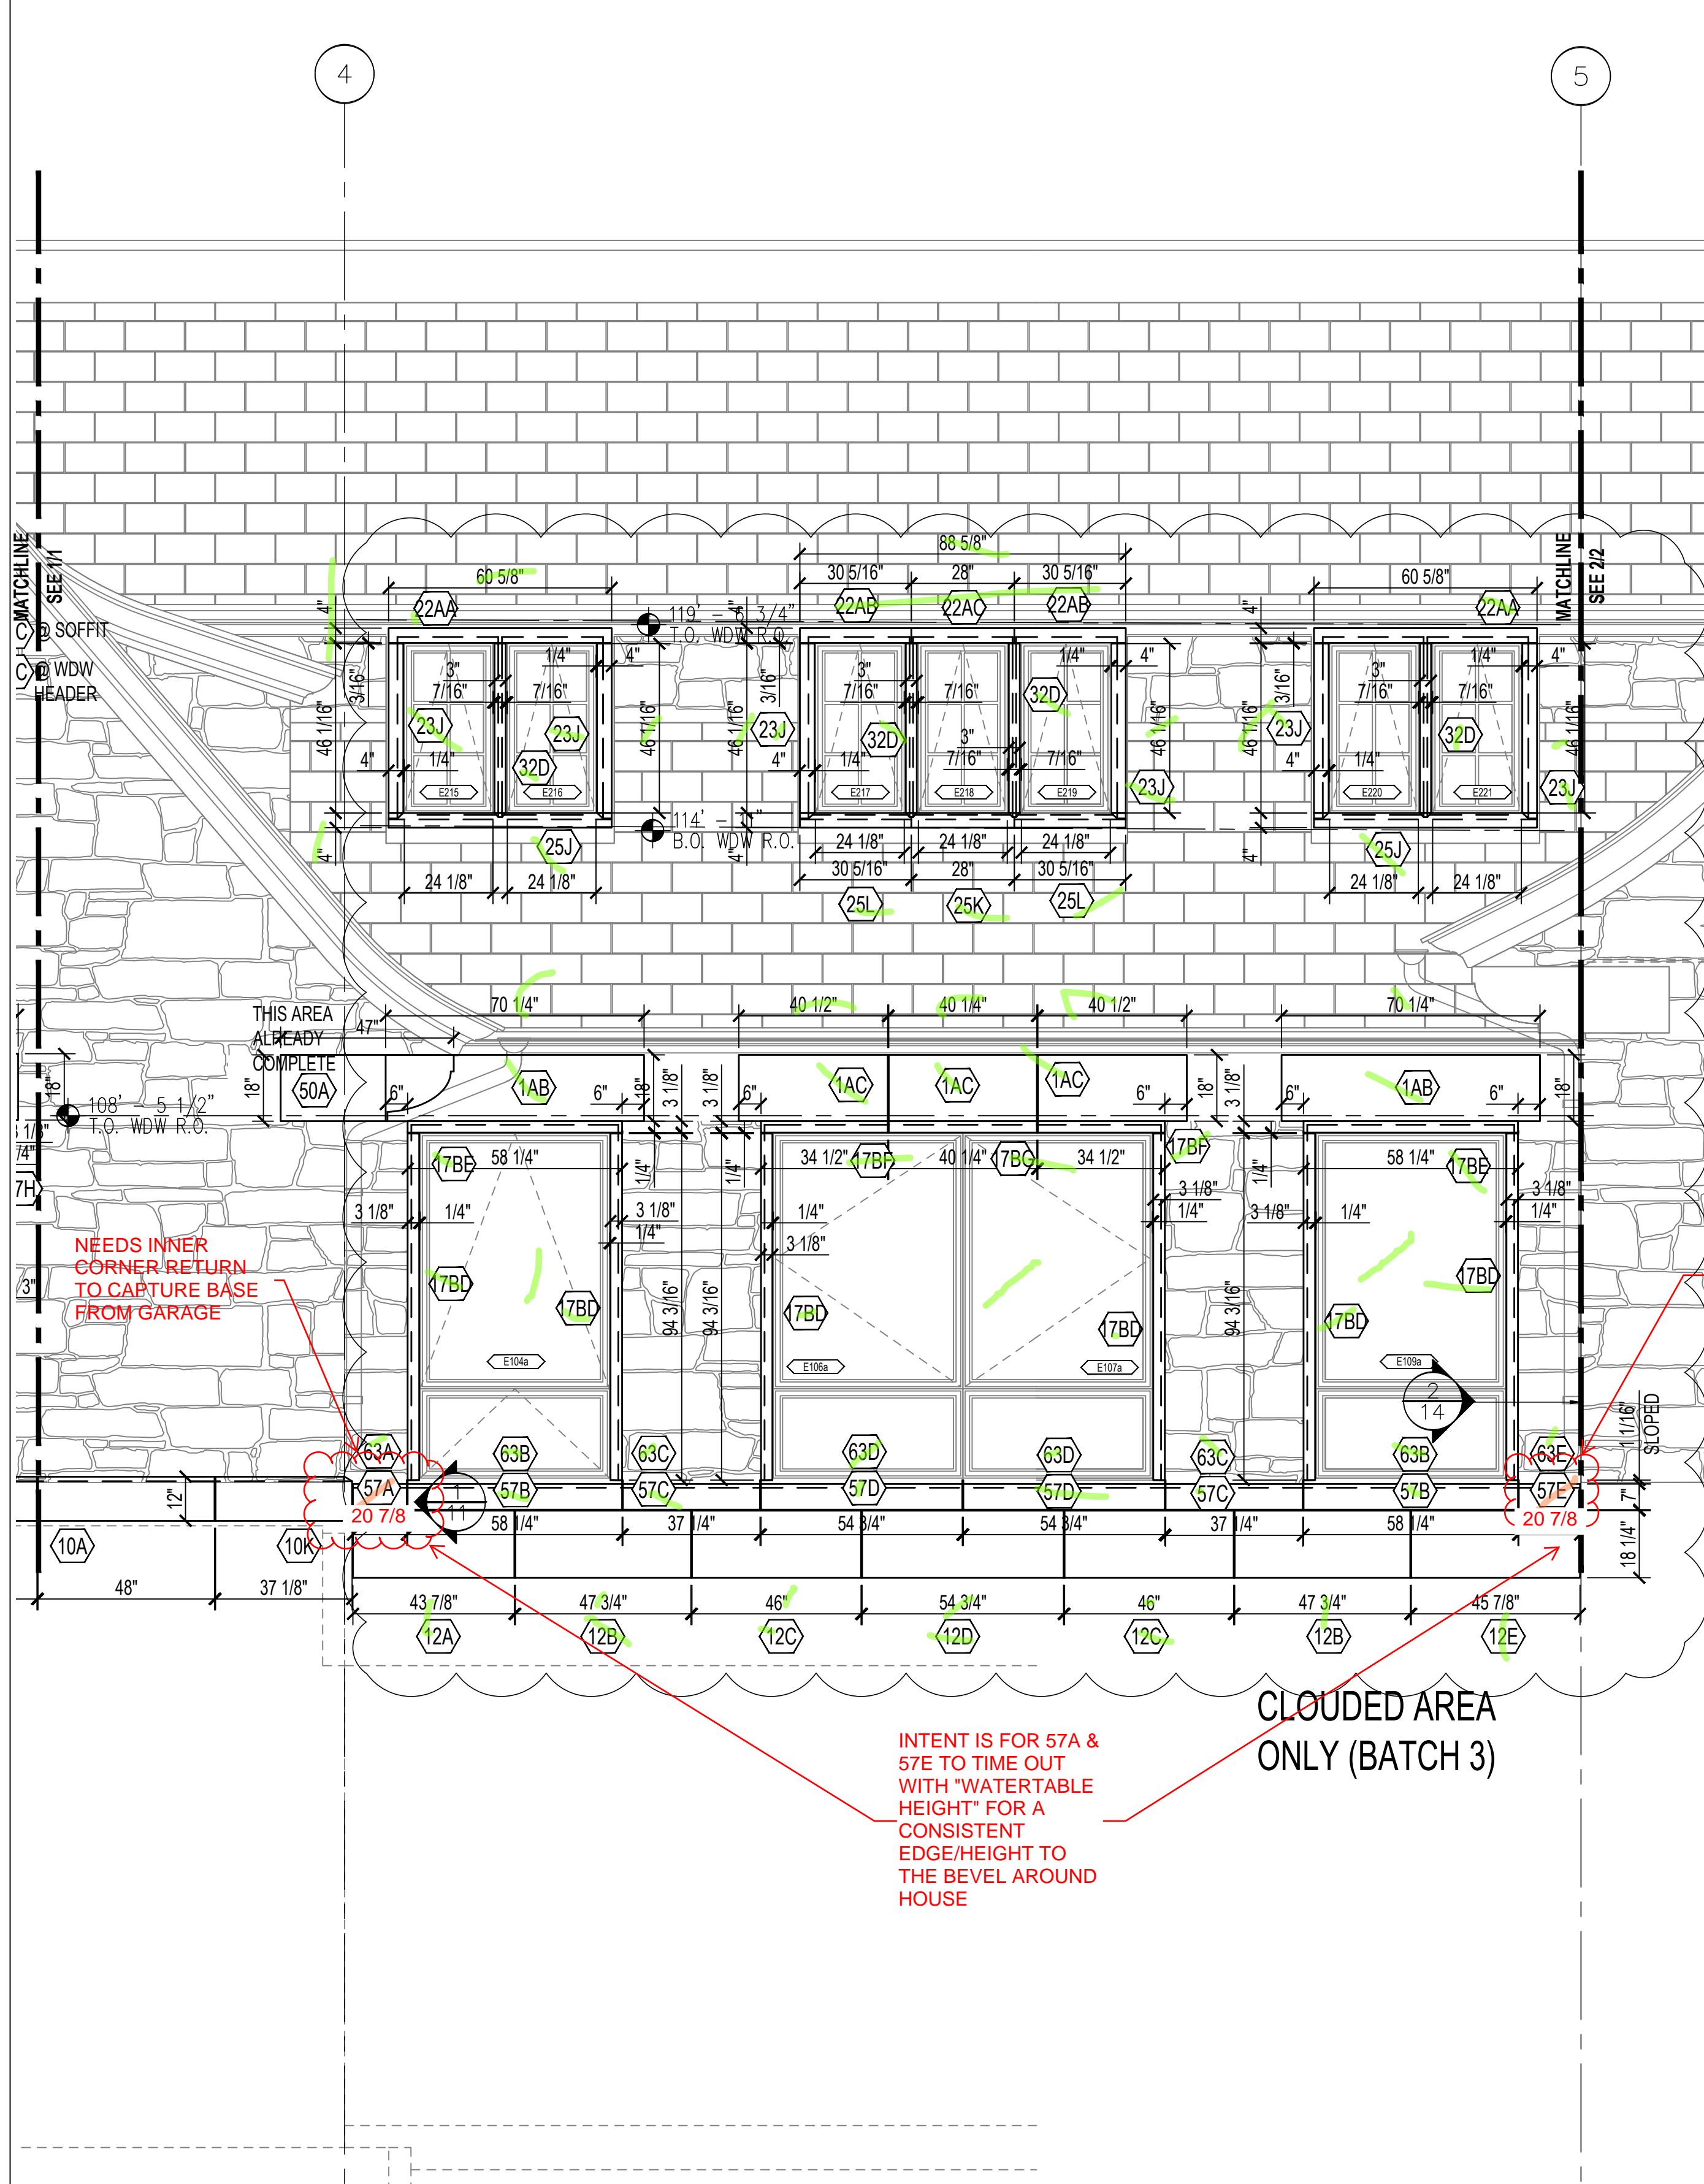

1 PARTIAL EAST ELEVATION @ GARAGE WING (1/A2.02)
2 3/8" = 1'-0" 0' 1' 2' 3' 4' 5'

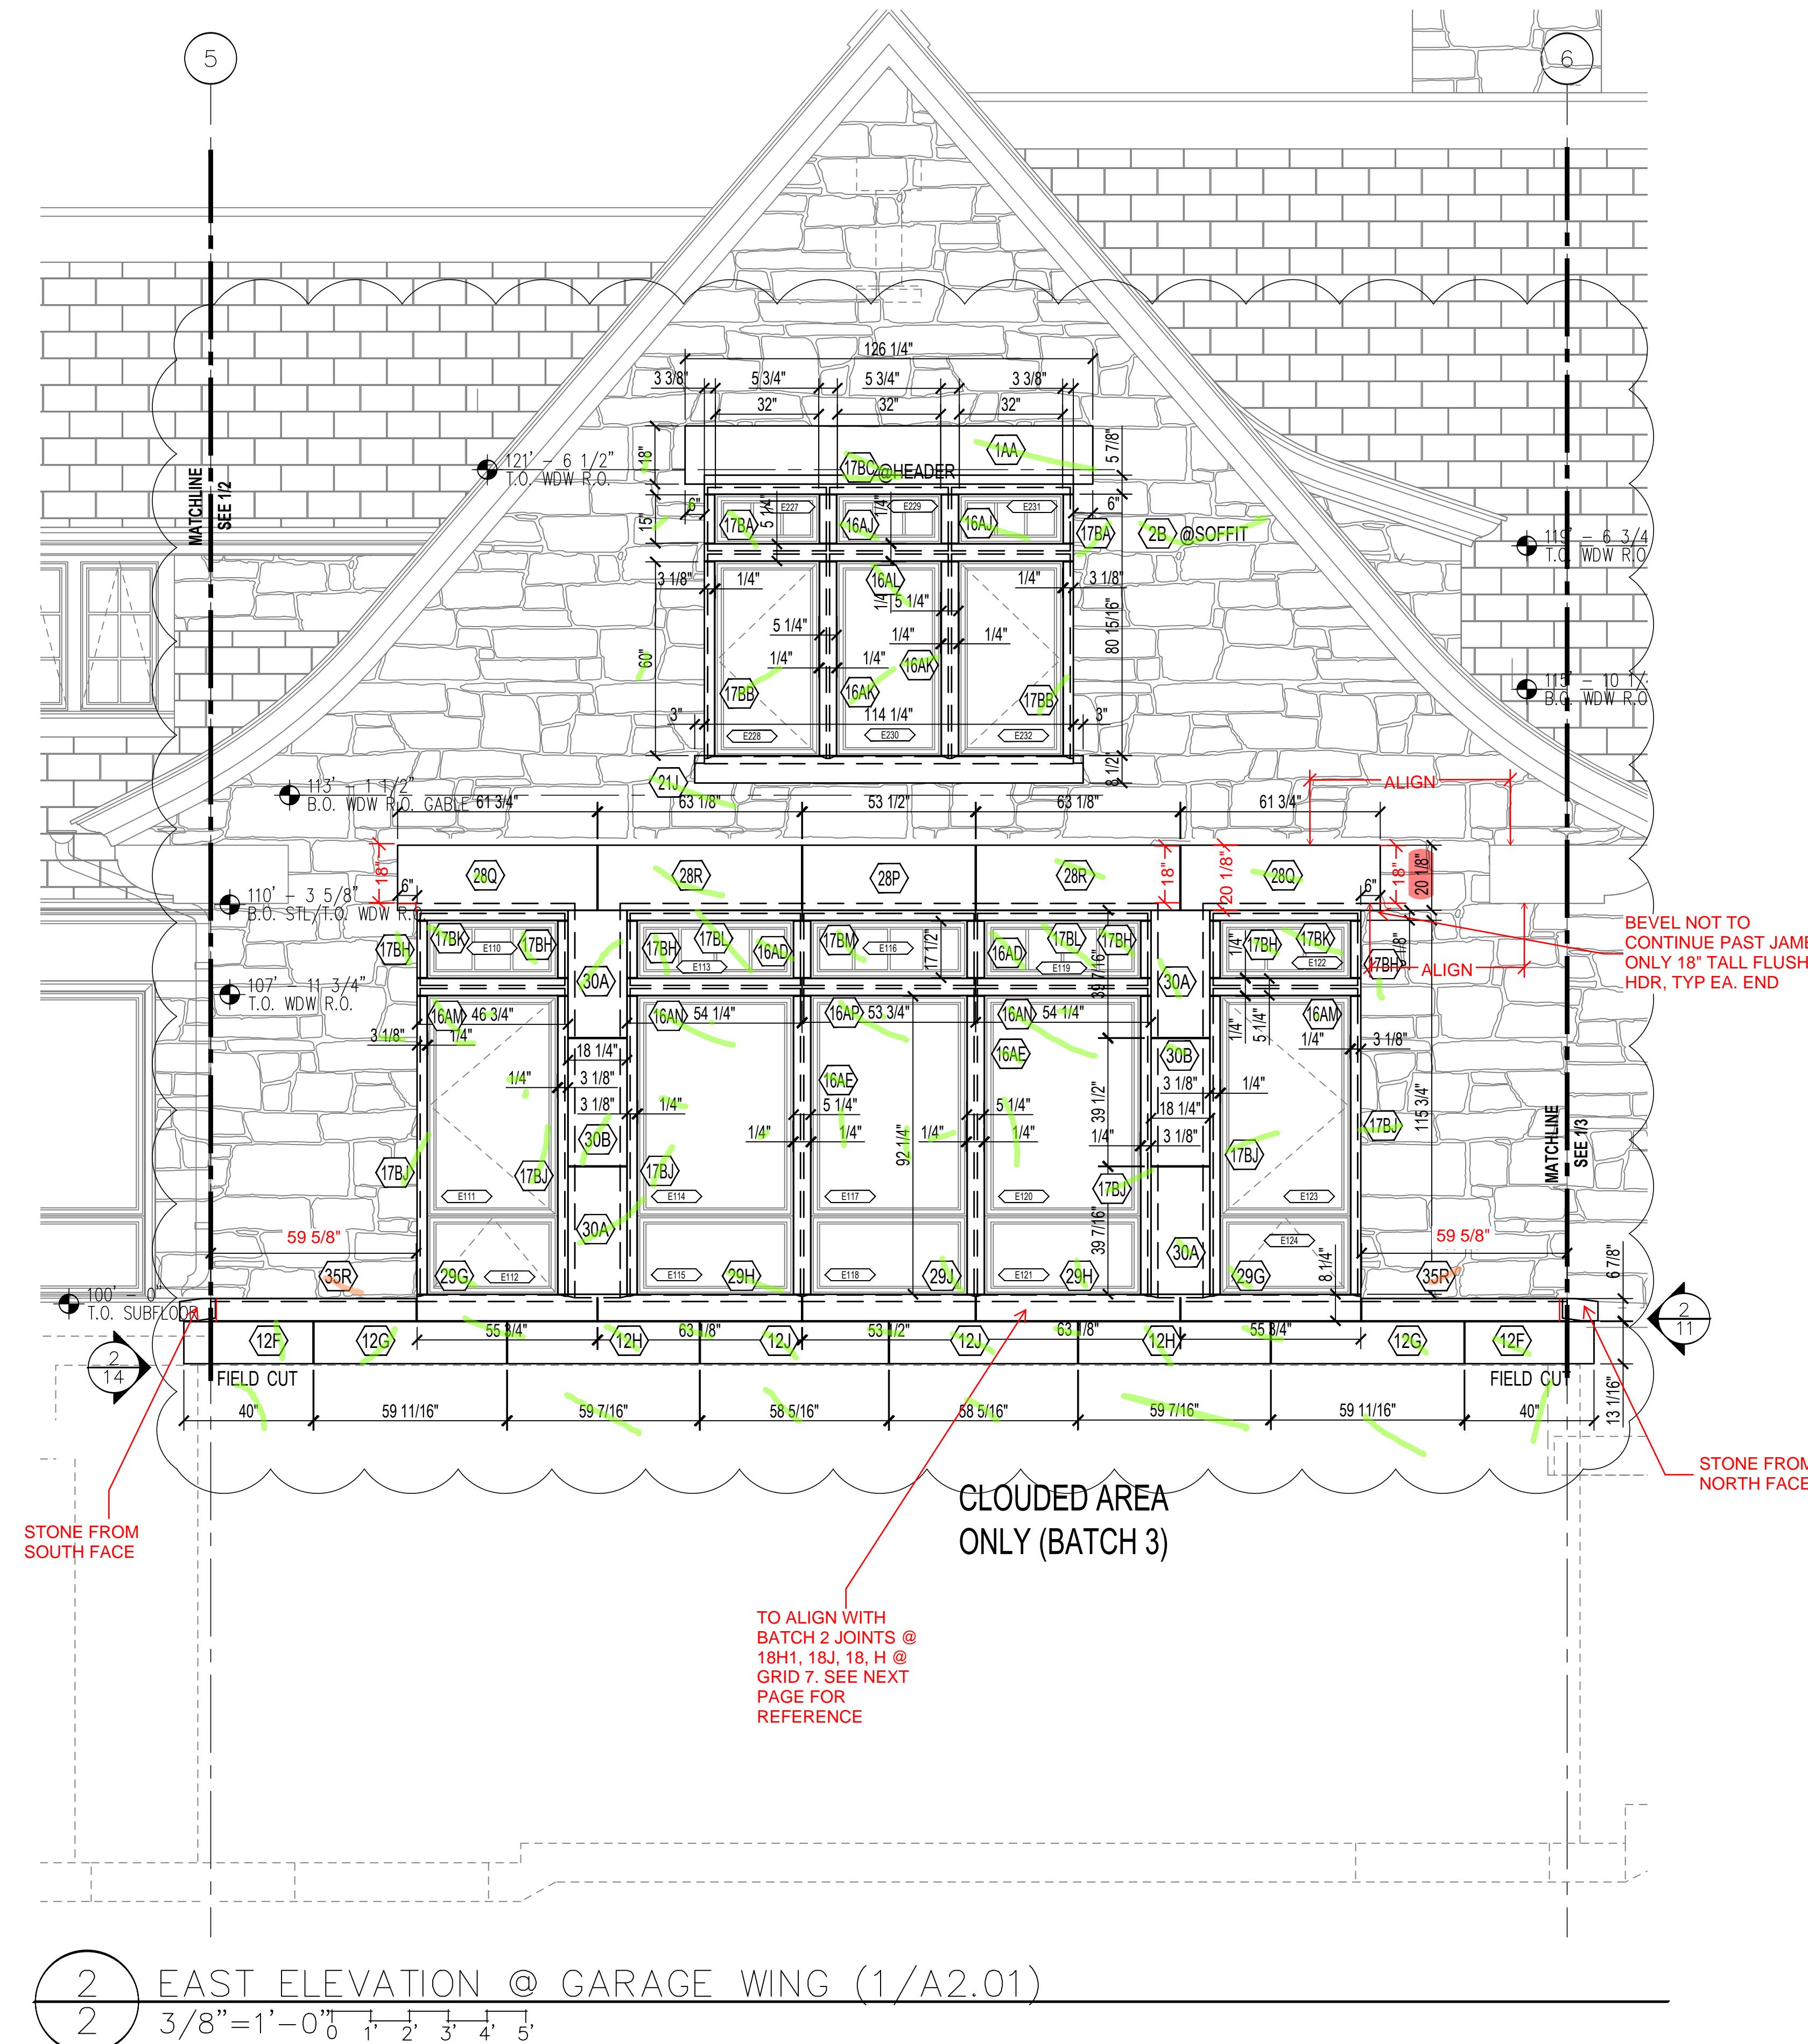


2 EAST ELEVATION @ GARAGE WING (1/A2.01)
2 3/8" = 1'-0" 0' 1' 2' 3' 4' 5'

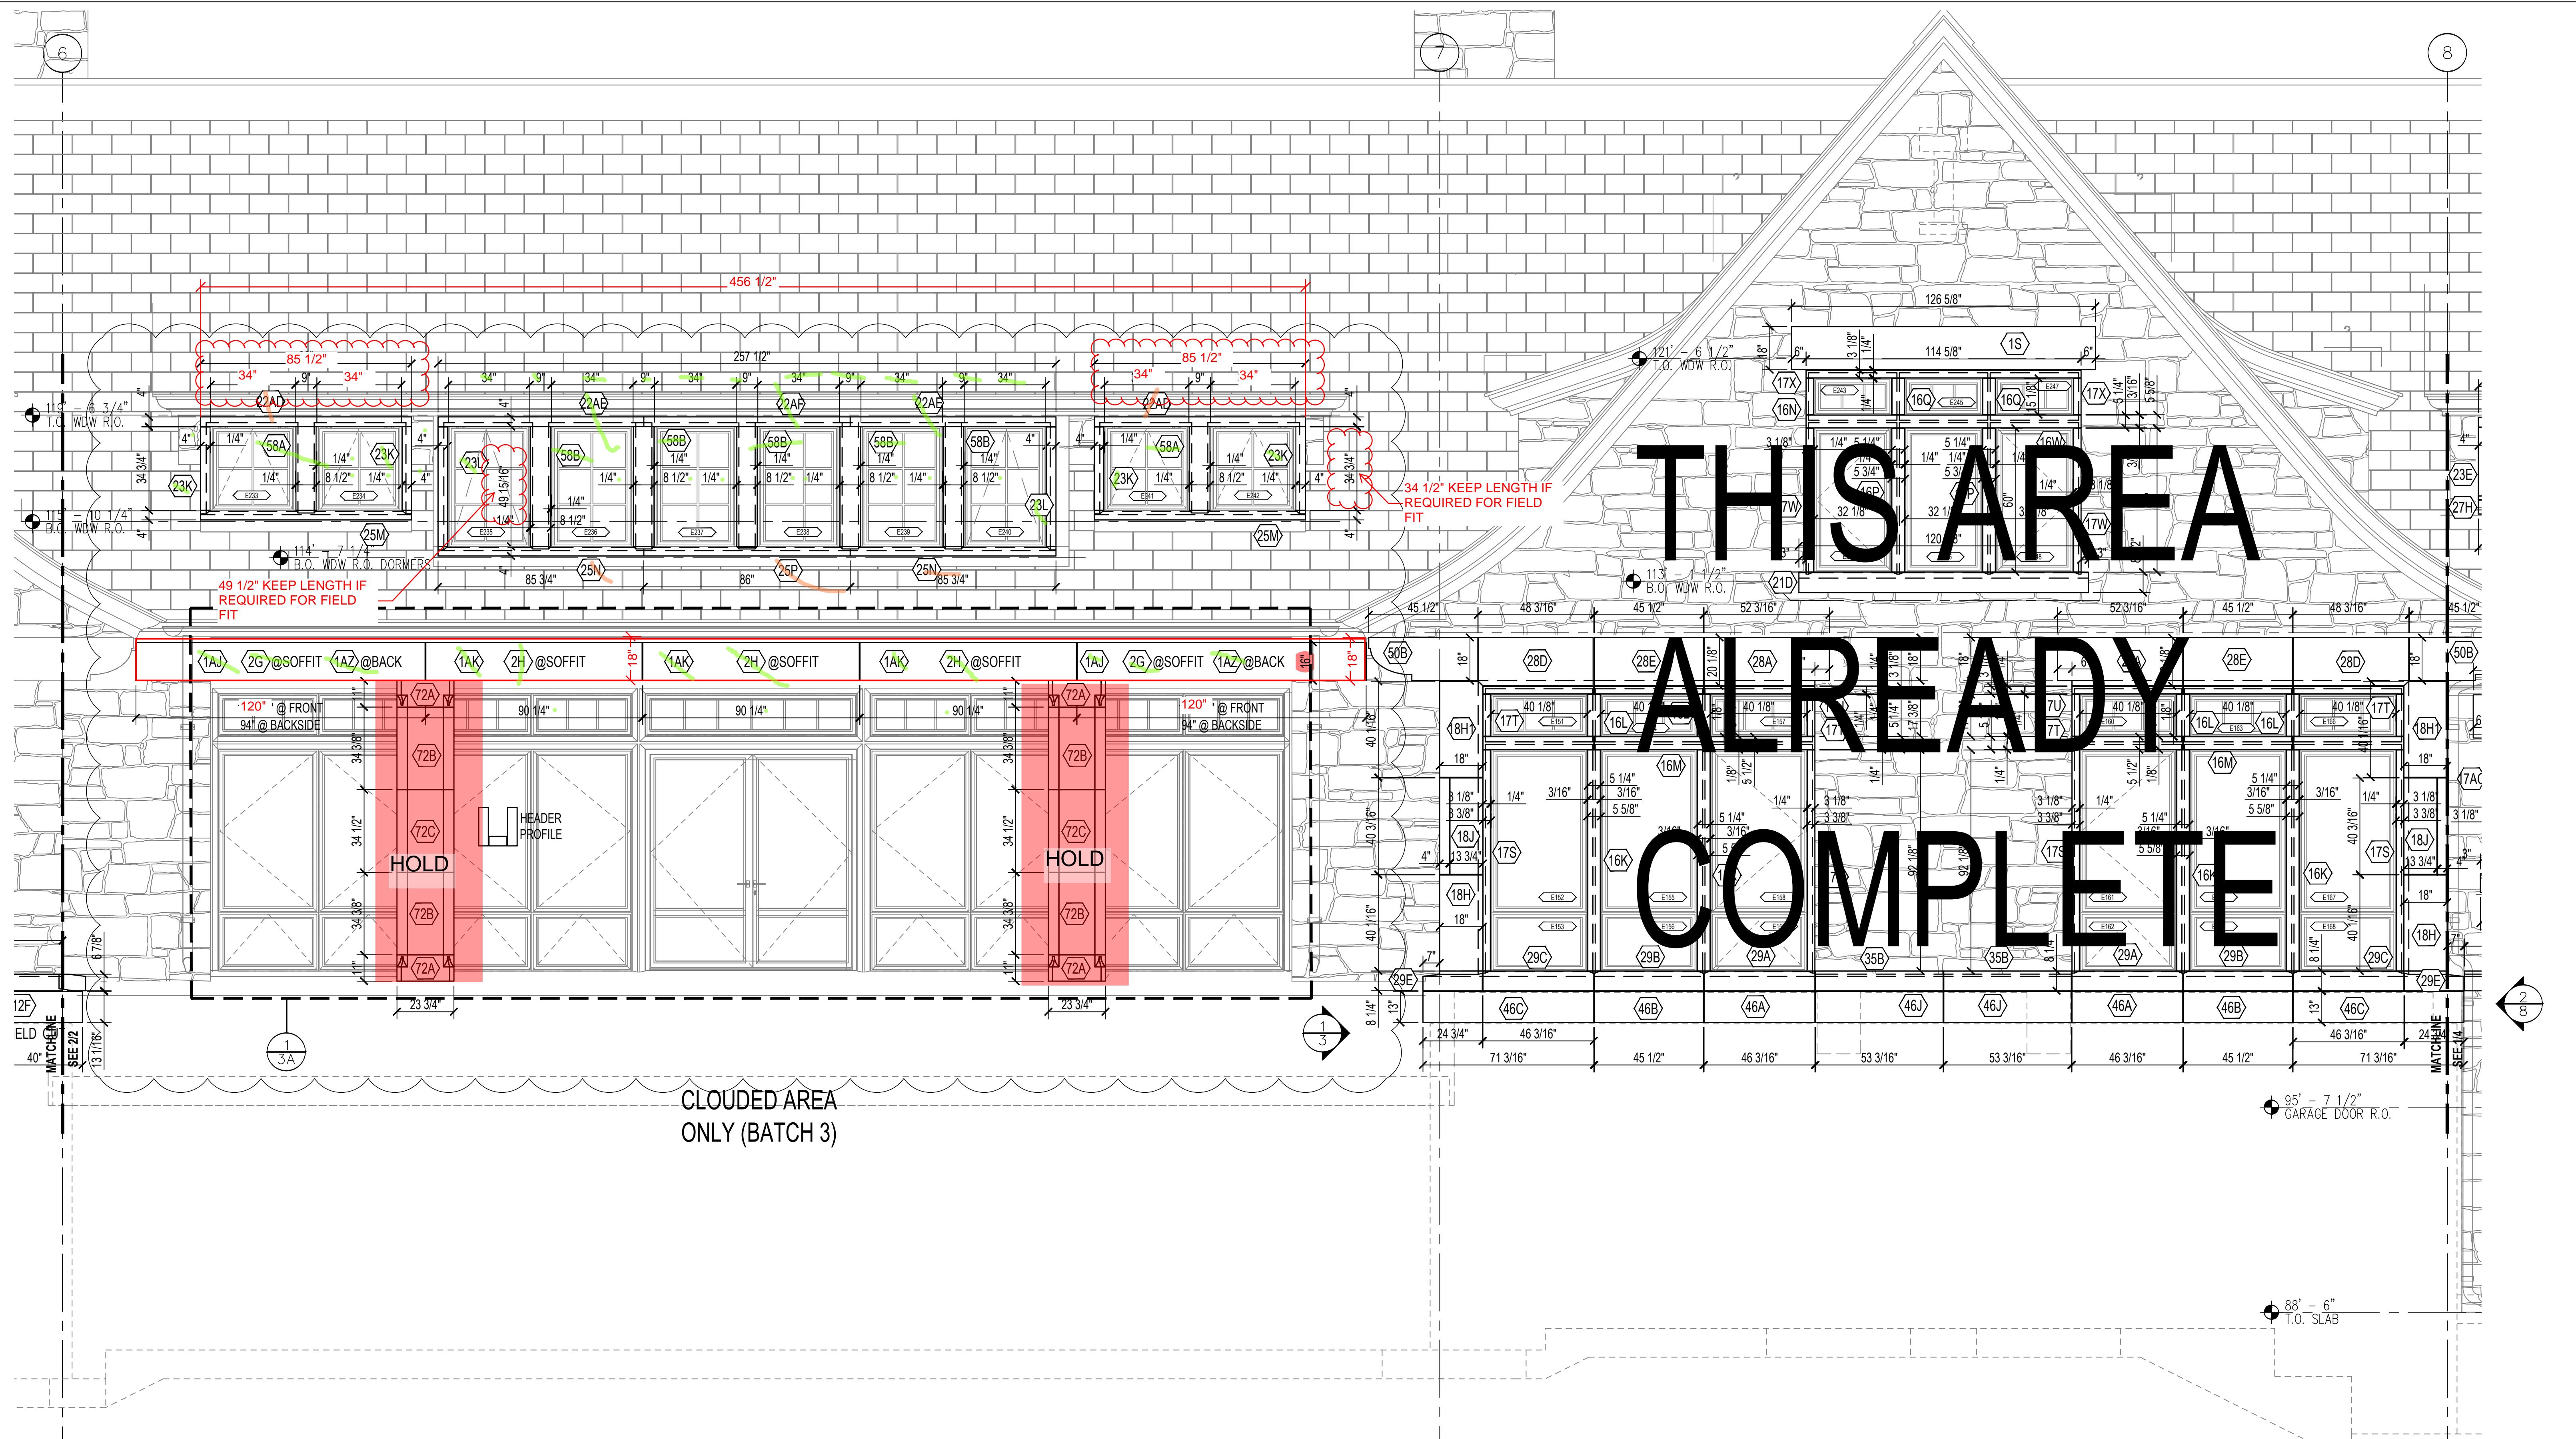


1
3 PARTIAL EAST ELEVATION (1/A2.01)
3/8" = 1'-0"




		KASOTA STONE	
		820 WILLOW STREET MANKATO MN, 56001 (507) 508-0684	
Drawing Title:	Elevations		
Project:	GALE ROAD		
7/29/20	1-Arch Redlines	Architect:	TEA2 ARCHITECTS
Date	Description	General Contractor:	XX
Revisions	Drawn By: PDD	Date:	03/10/2021
	Scale:	3/8" = 1'-0"	Drawing Number: 3 of 14

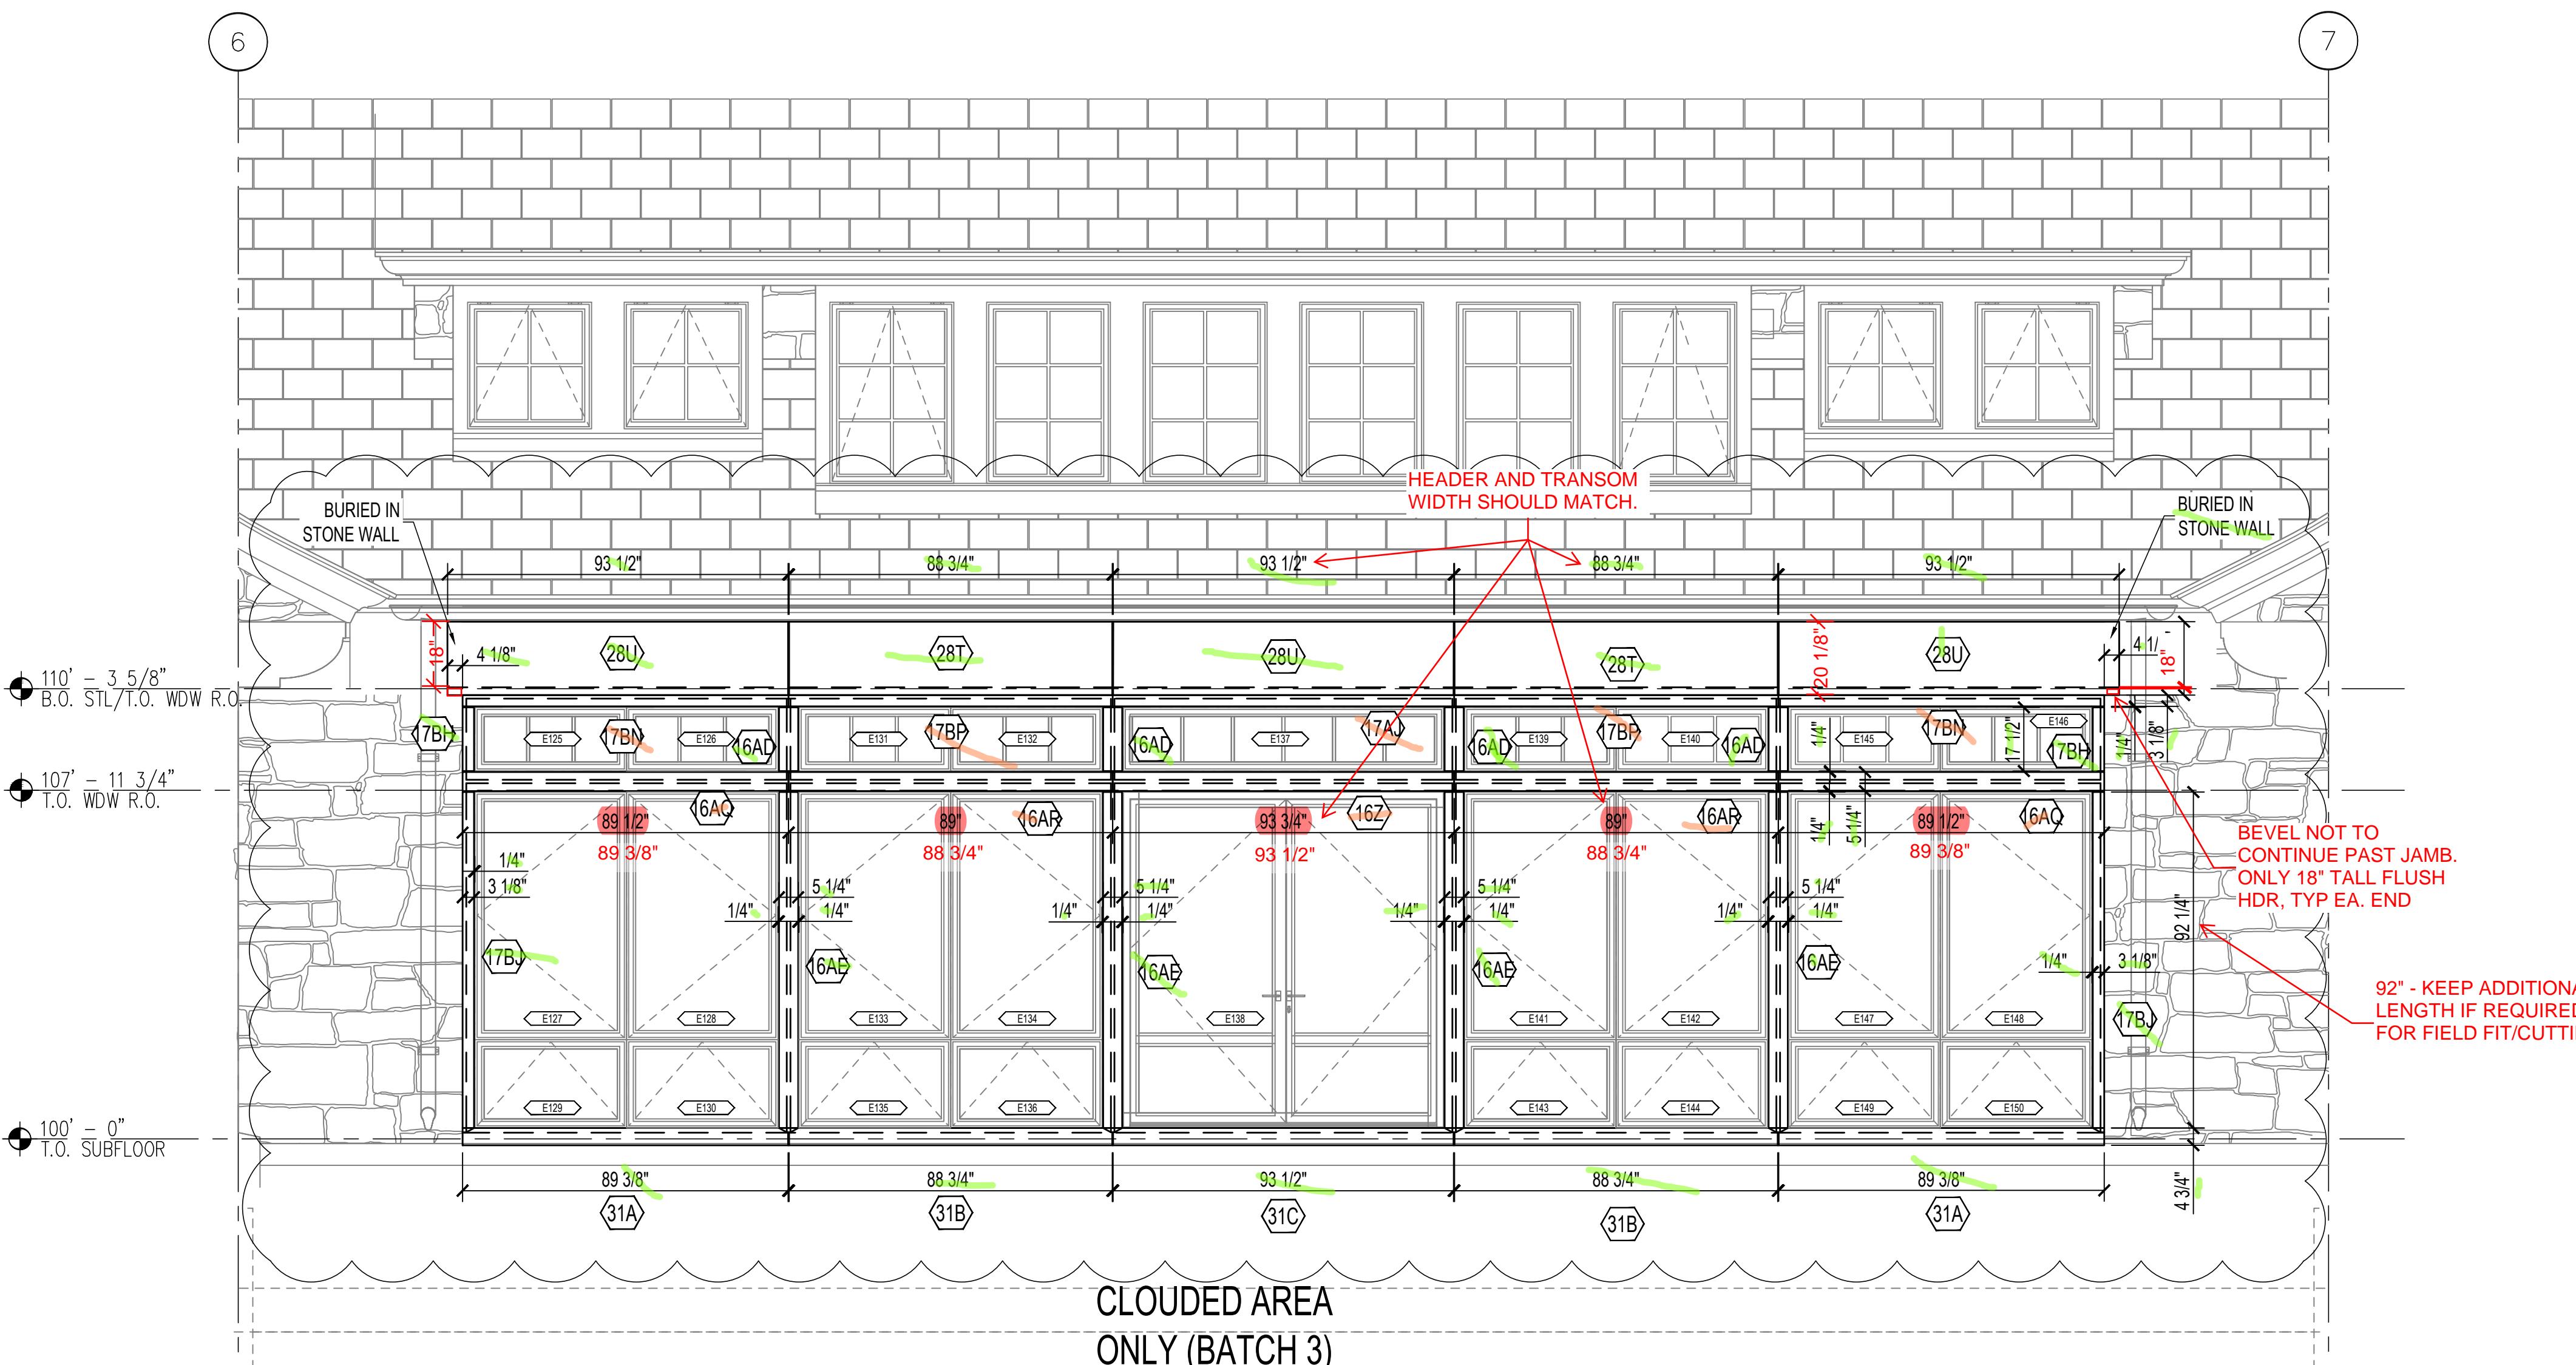

1
3a PARTIAL EAST ELEVATION (1/A2.01a)
3/8" = 1'-0" 0' 1' 2' 3' 4' 5'

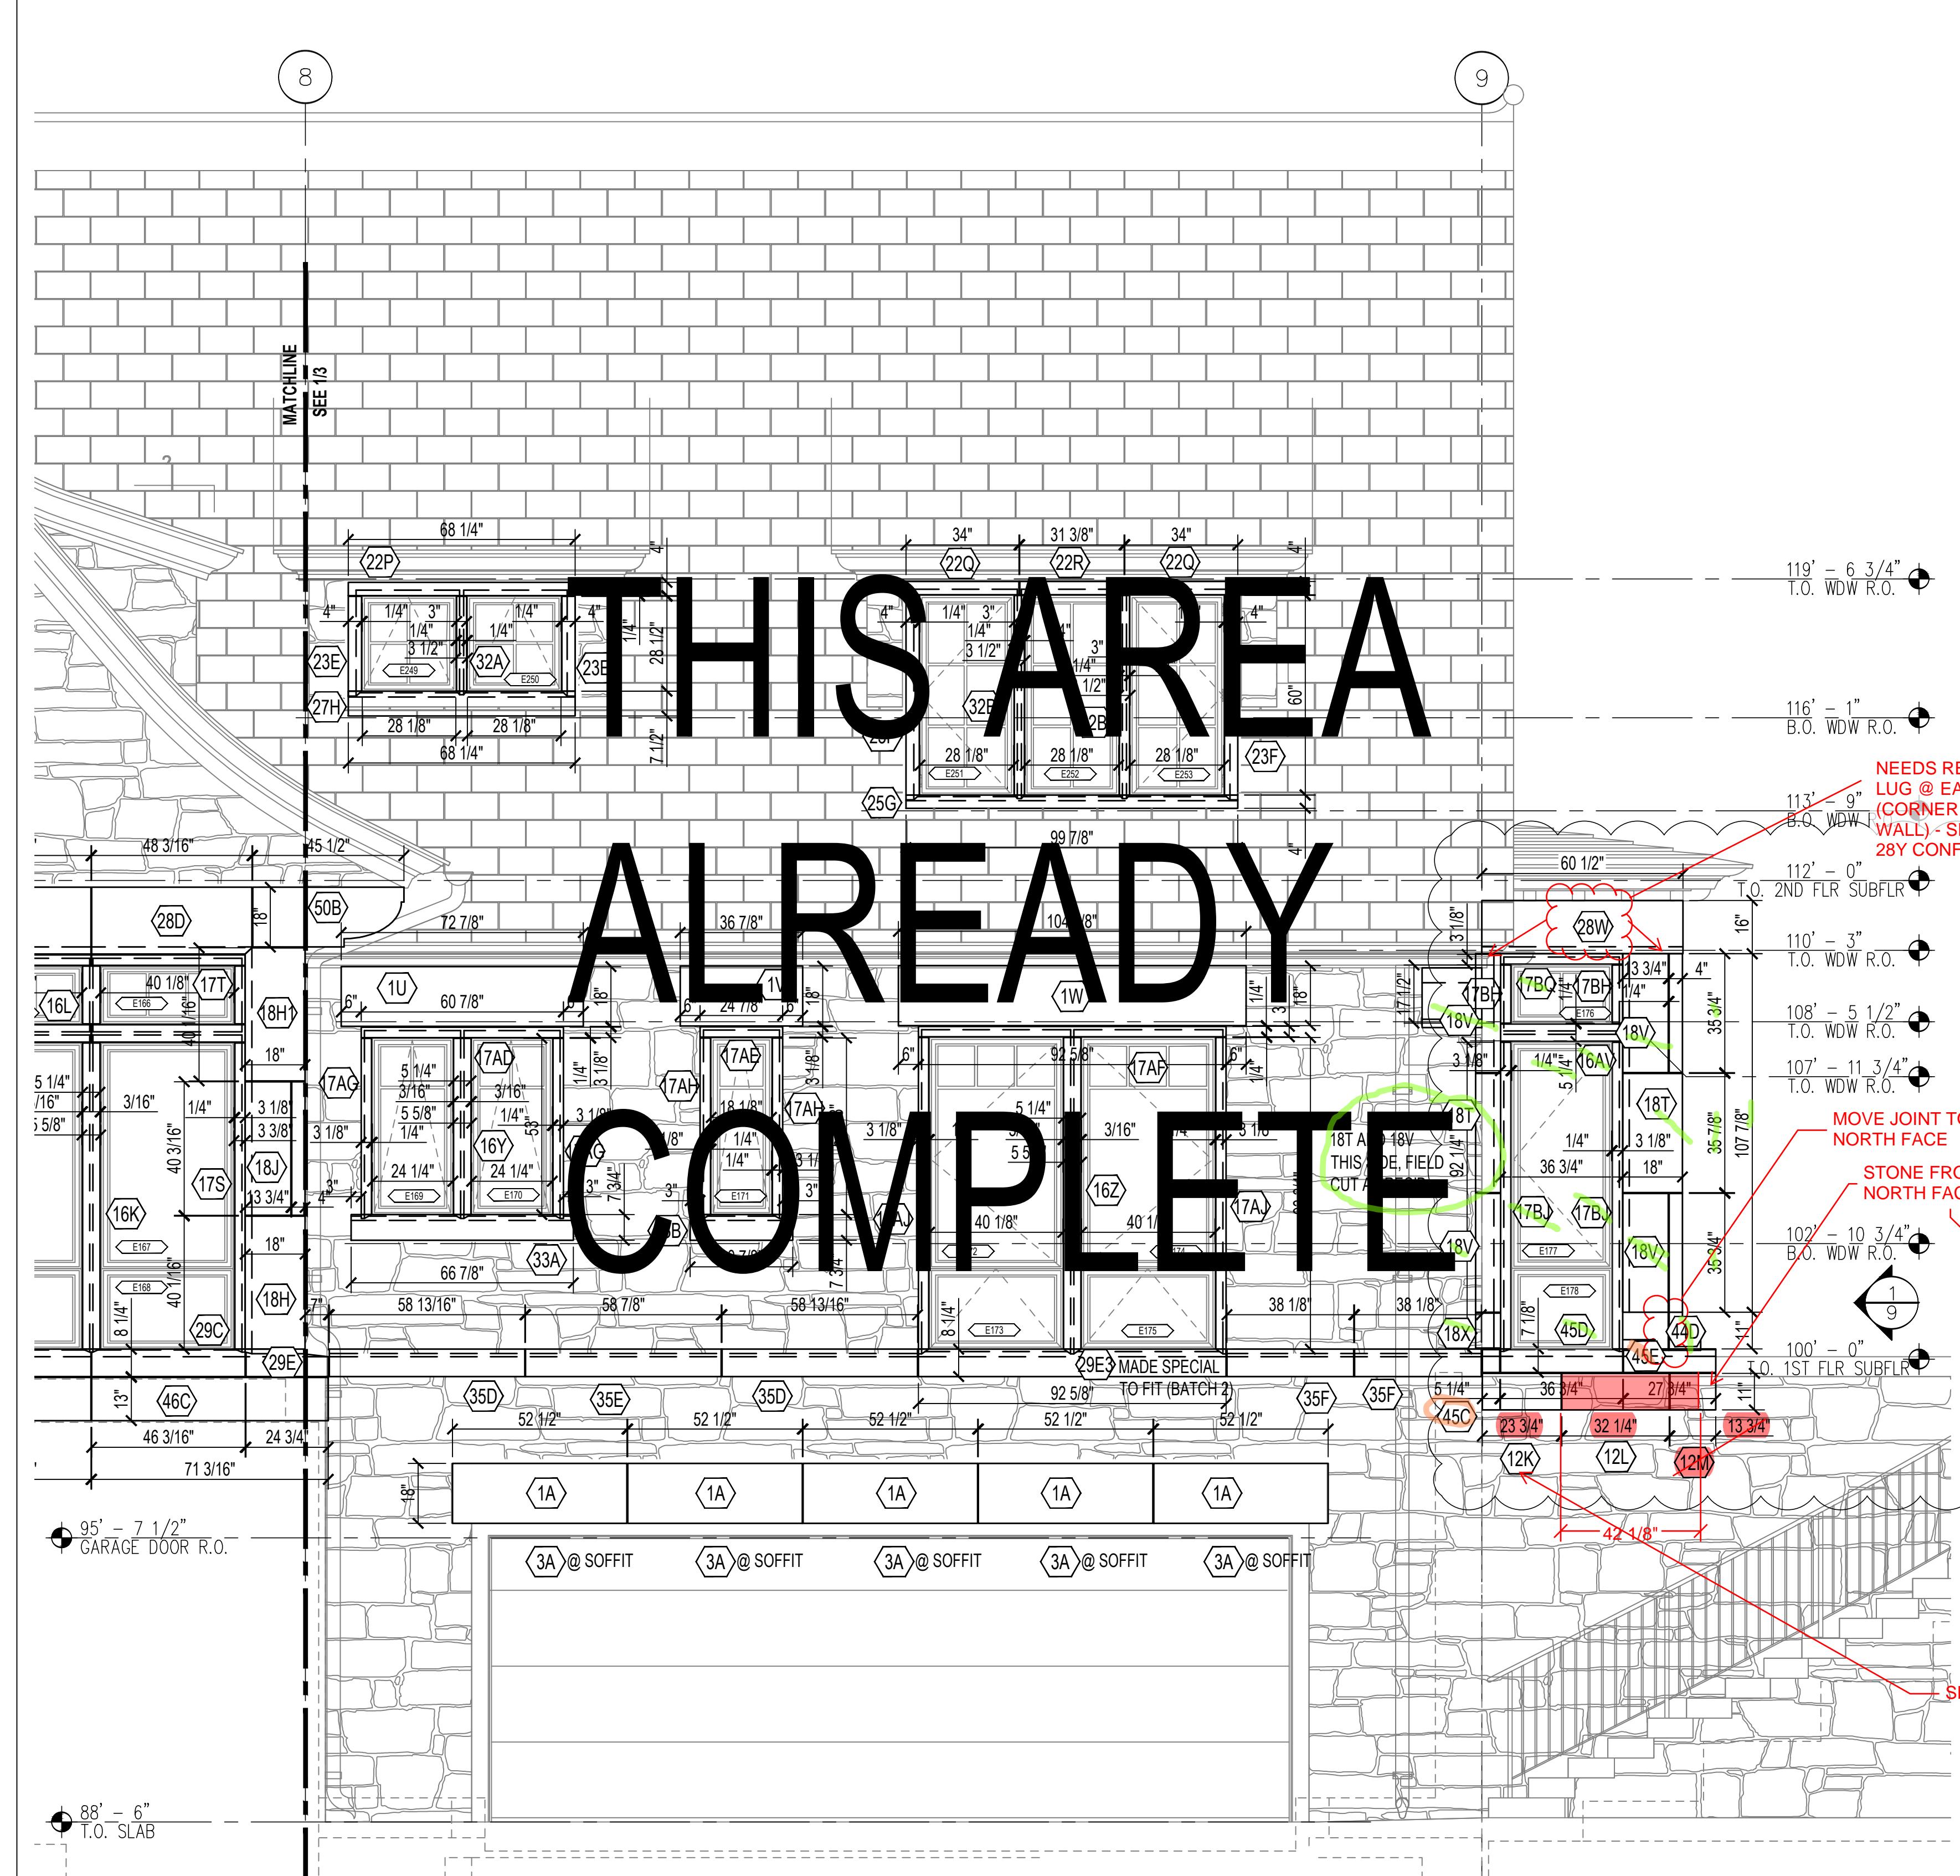

1 PARTIAL EAST ELEVATION (1/A2.01)
4 3/8" = 1'-0" 0' 1' 2' 3' 4' 5'


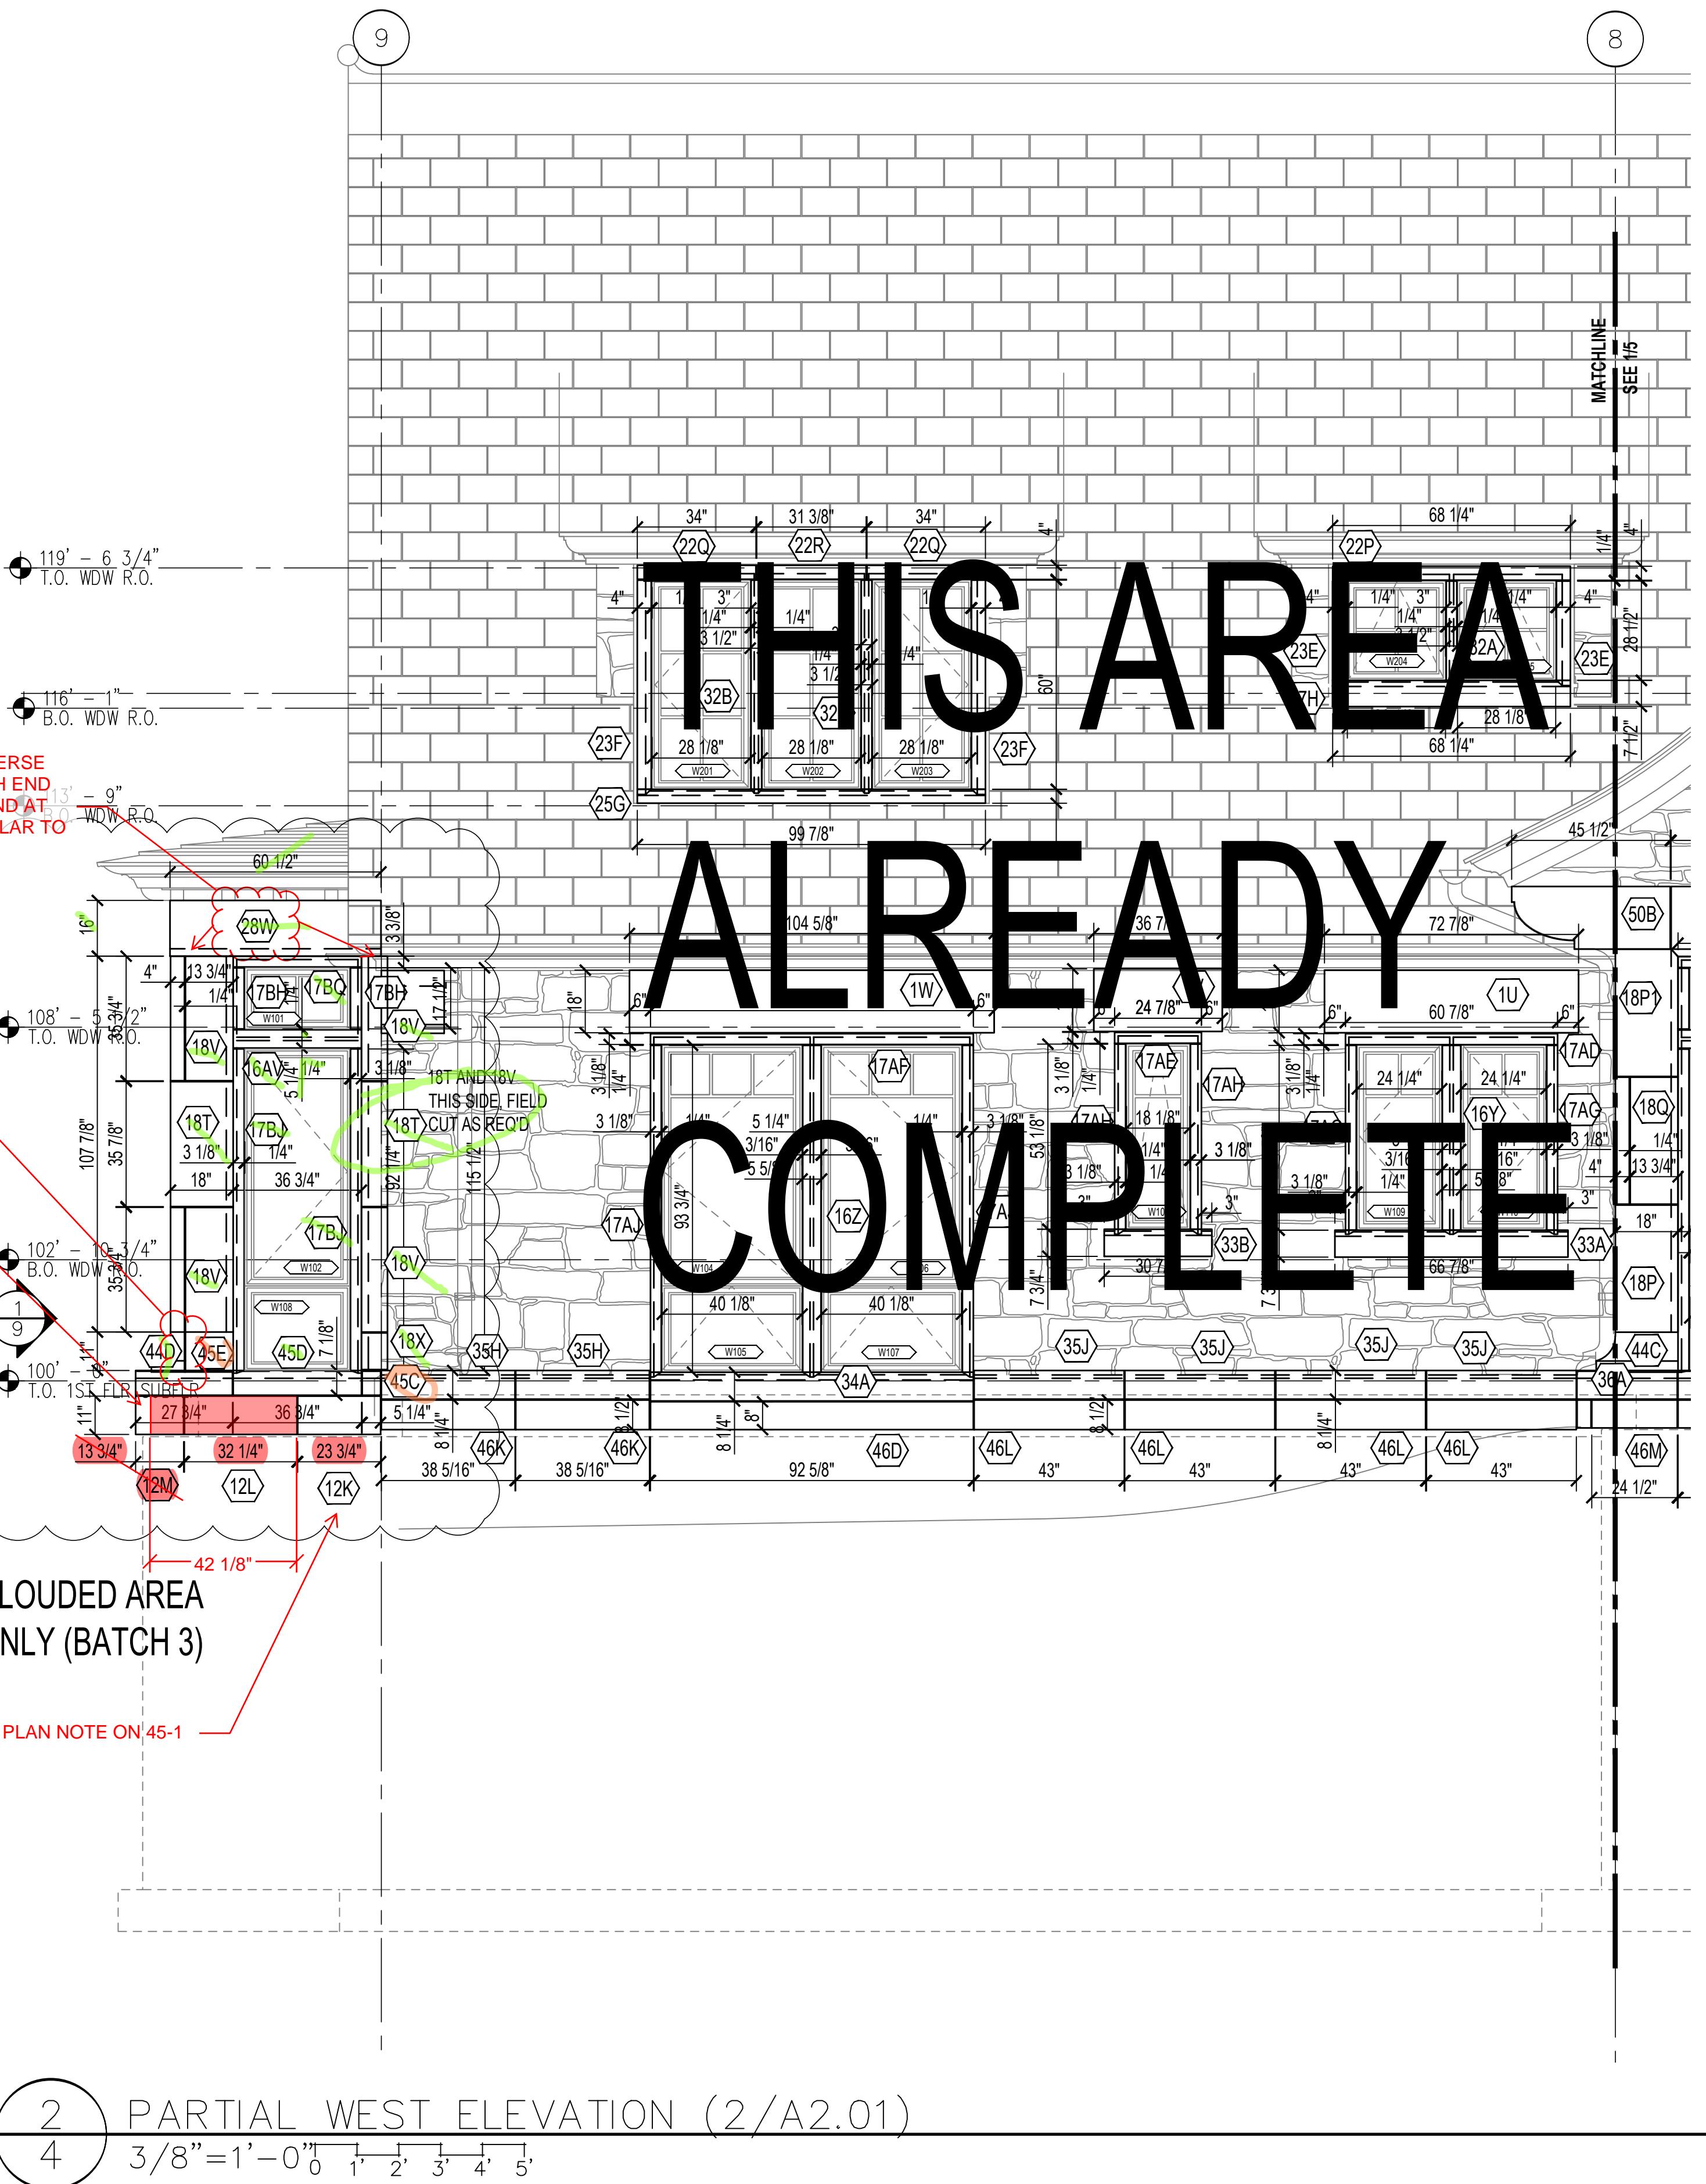


2 PARTIAL WEST ELEVATION (2/A2.01)
4 3/8" = 1'-0" 0' 1' 2' 3' 4' 5'



		KASOTA STONE 820 WILLOW STREET MANKATO MN, 56001 (507) 508-0684
Drawing Title: Elevations		
Project: GALE ROAD		
Architect: TEA2 ARCHITECTS		
General Contractor: XX		
7/29/20	1-Arch Redlines	Date
Description	Revisions	Drawn By:
General Contractor: XX	Revisions	PDD
7/29/20	Date	03/10/2021
General Contractor: XX	Scale:	3/8" = 1'-0"
7/29/20	Drawing Number:	4 of 14



An architectural blueprint of a building's floor plan and structural details serves as the background for this image. The blueprint includes various rooms, door locations, window sizes, and structural dimensions. Overlaid on this blueprint are the words "THIS AREA IS ALREADY COMPLETE" in large, bold, black capital letters. The word "THIS" is positioned at the top left, "AREA" is at the top right, "IS" is in the middle left, "ALREADY" is in the middle right, and "COMPLETE" is at the bottom center.

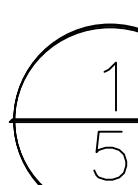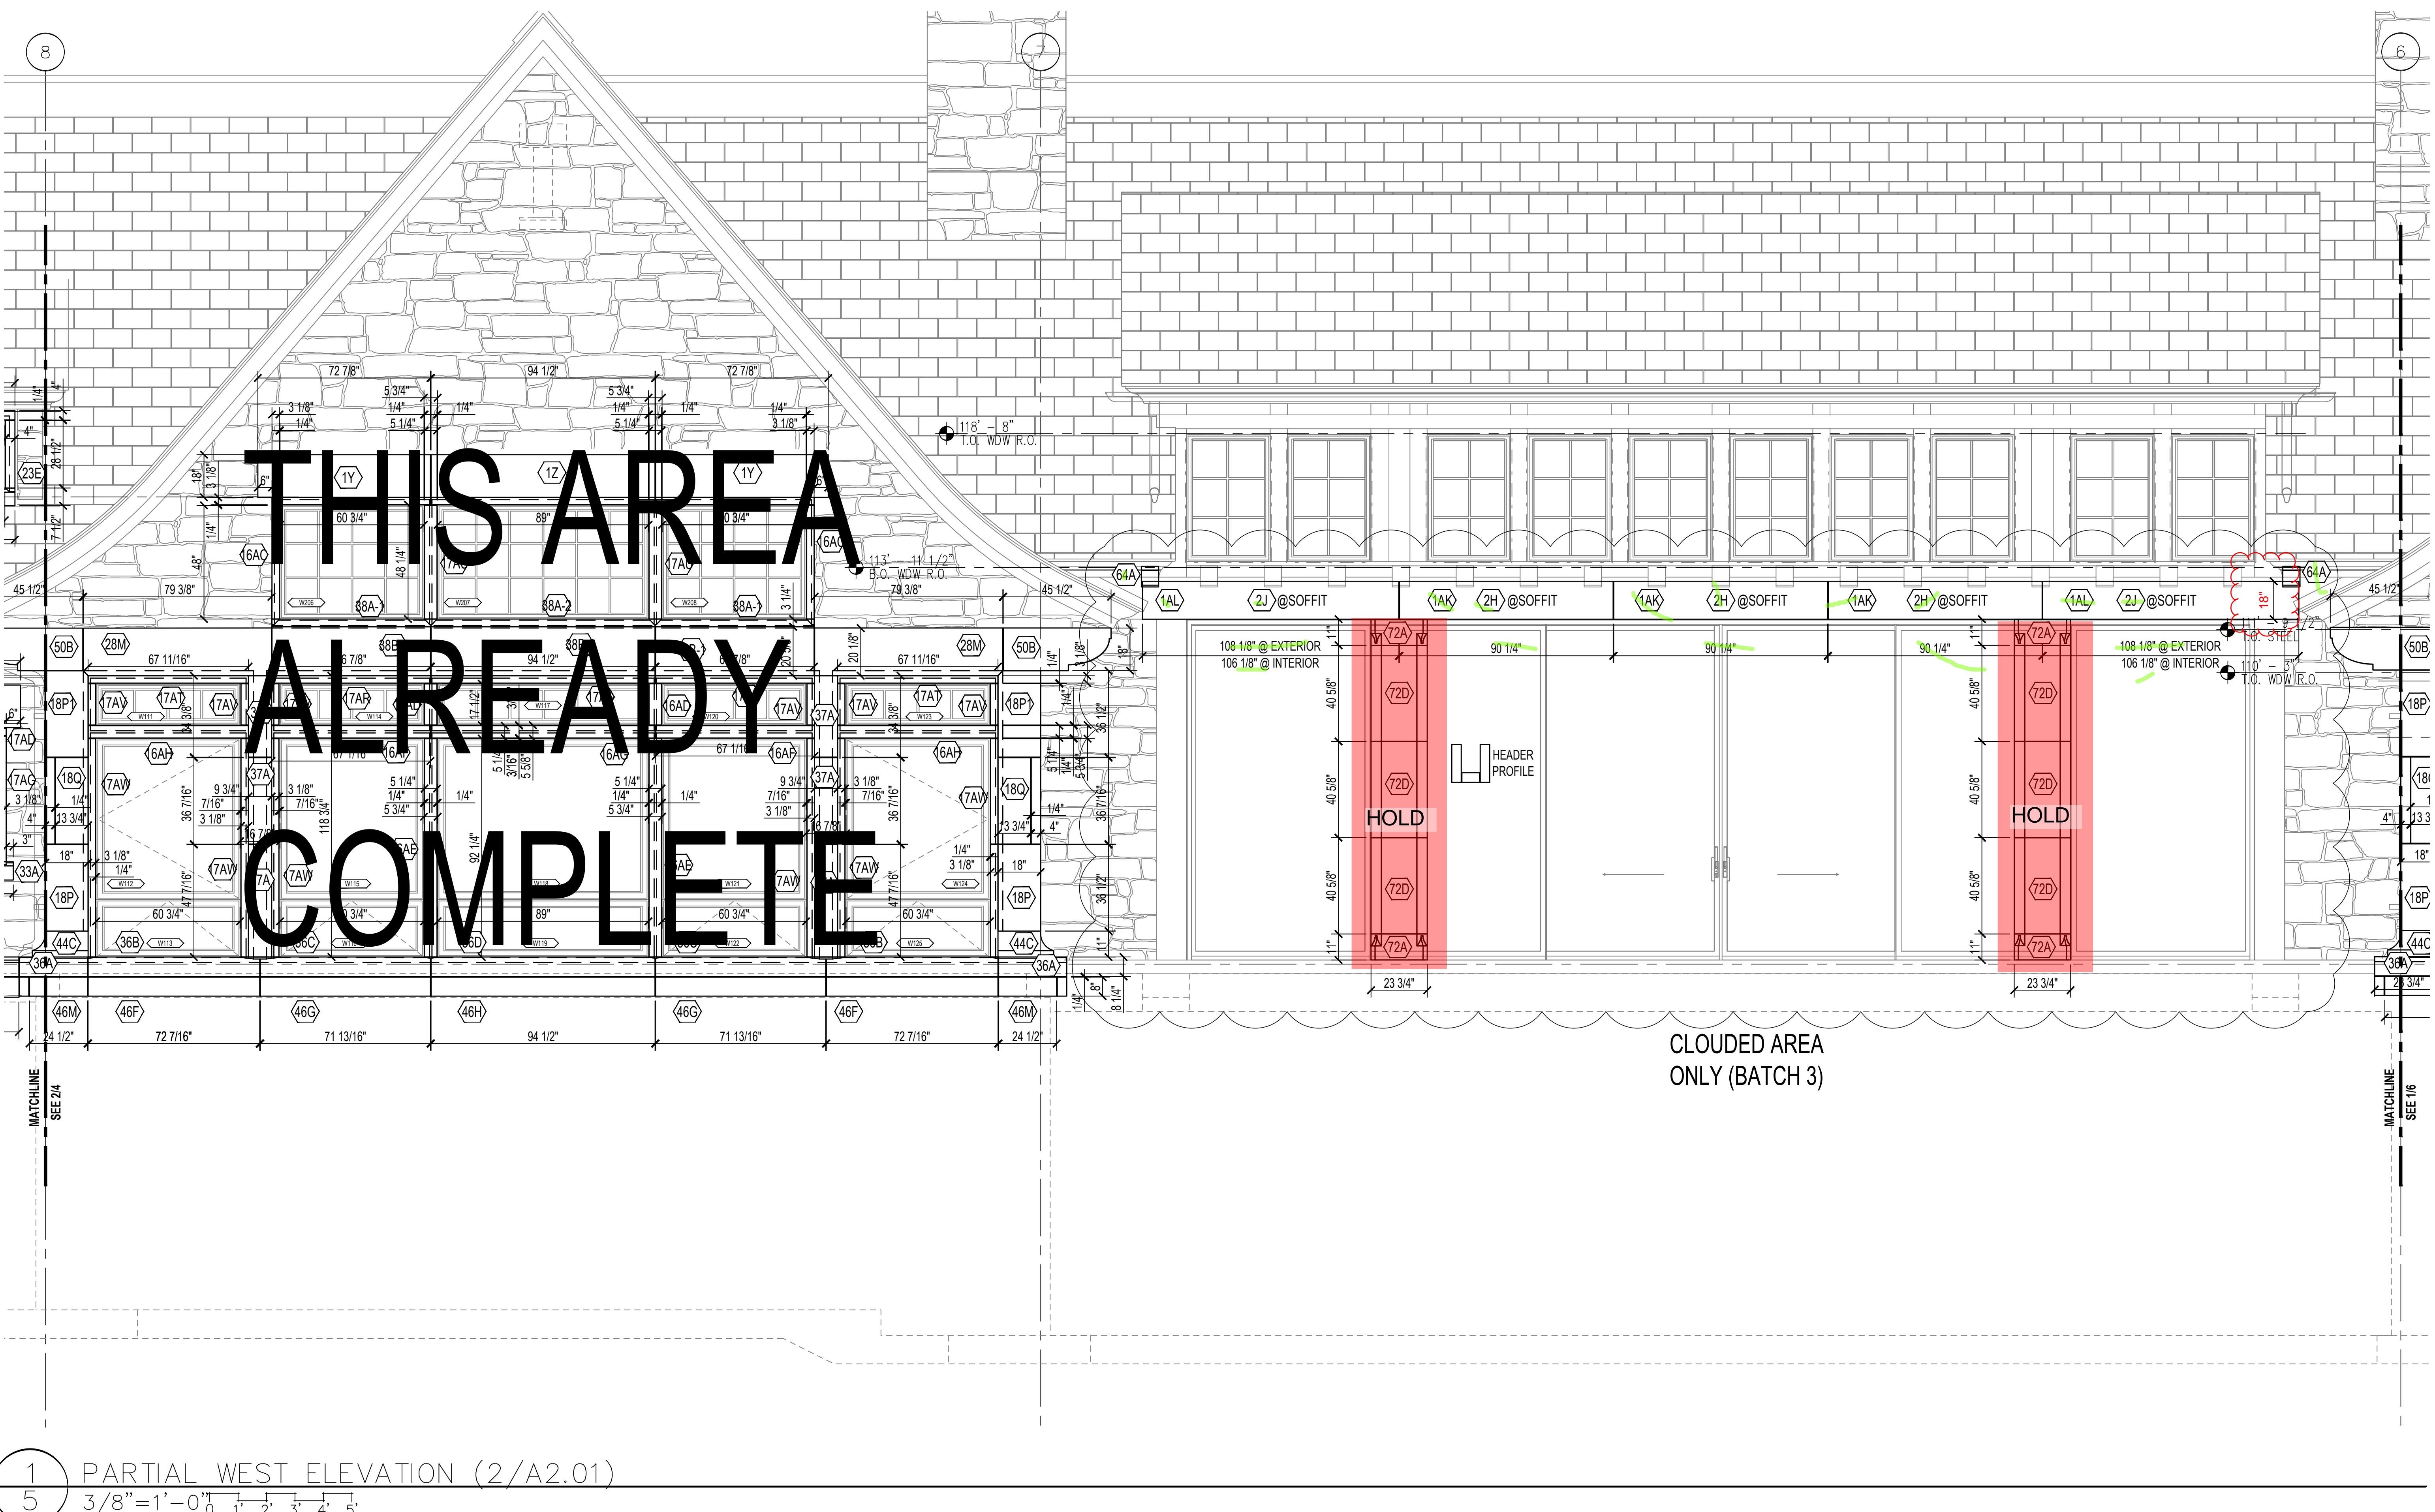



PARTIAL WEST ELEVATION (2/A2.01)




	KASOTA STONE	KASOTA STONE 820 WILLOW STREET MANKATO MN, 56001 (507) 508-0684
		Drawing Title: Elevations
		Project: GALE ROAD
7/29/20	1-Arch Redlines	Architect: TEA2 ARCHITECTS
Date	Description	General Contractor: XX
		Drawn By: PDD Date: 03/10/2021 Scale: 3/8" = 1'-0" Drawing Number: 5 of 14
Revisions		

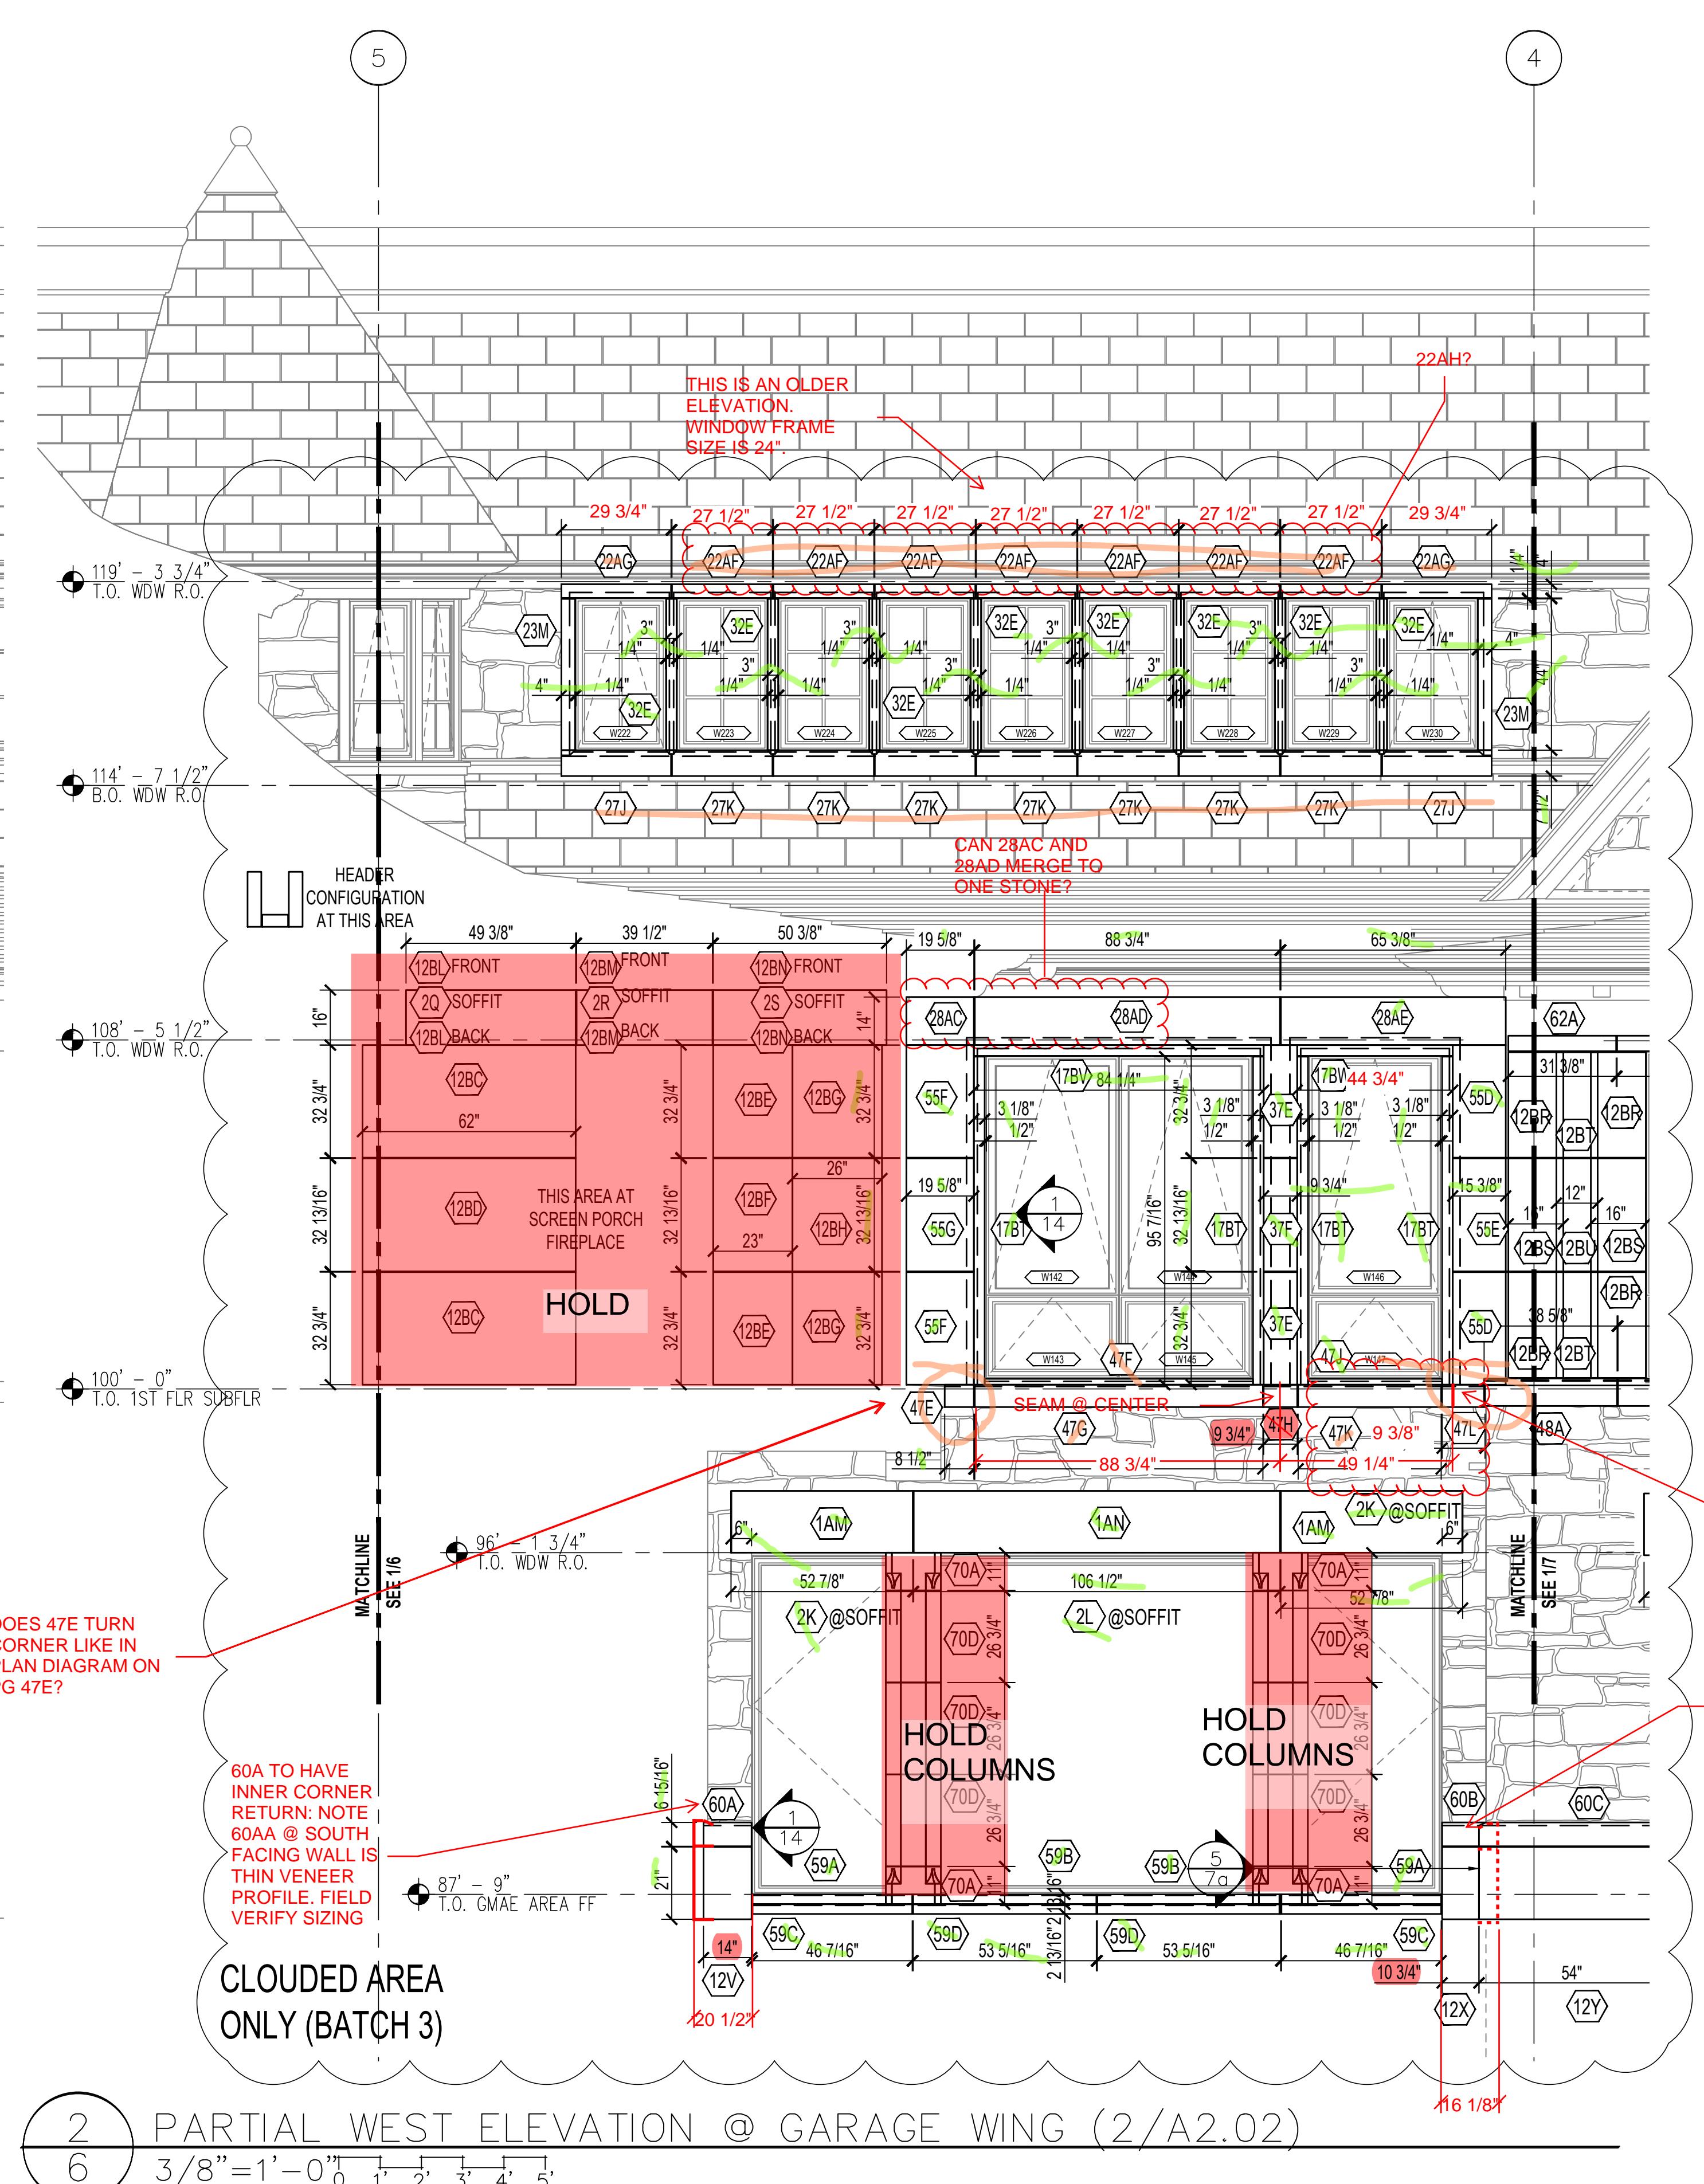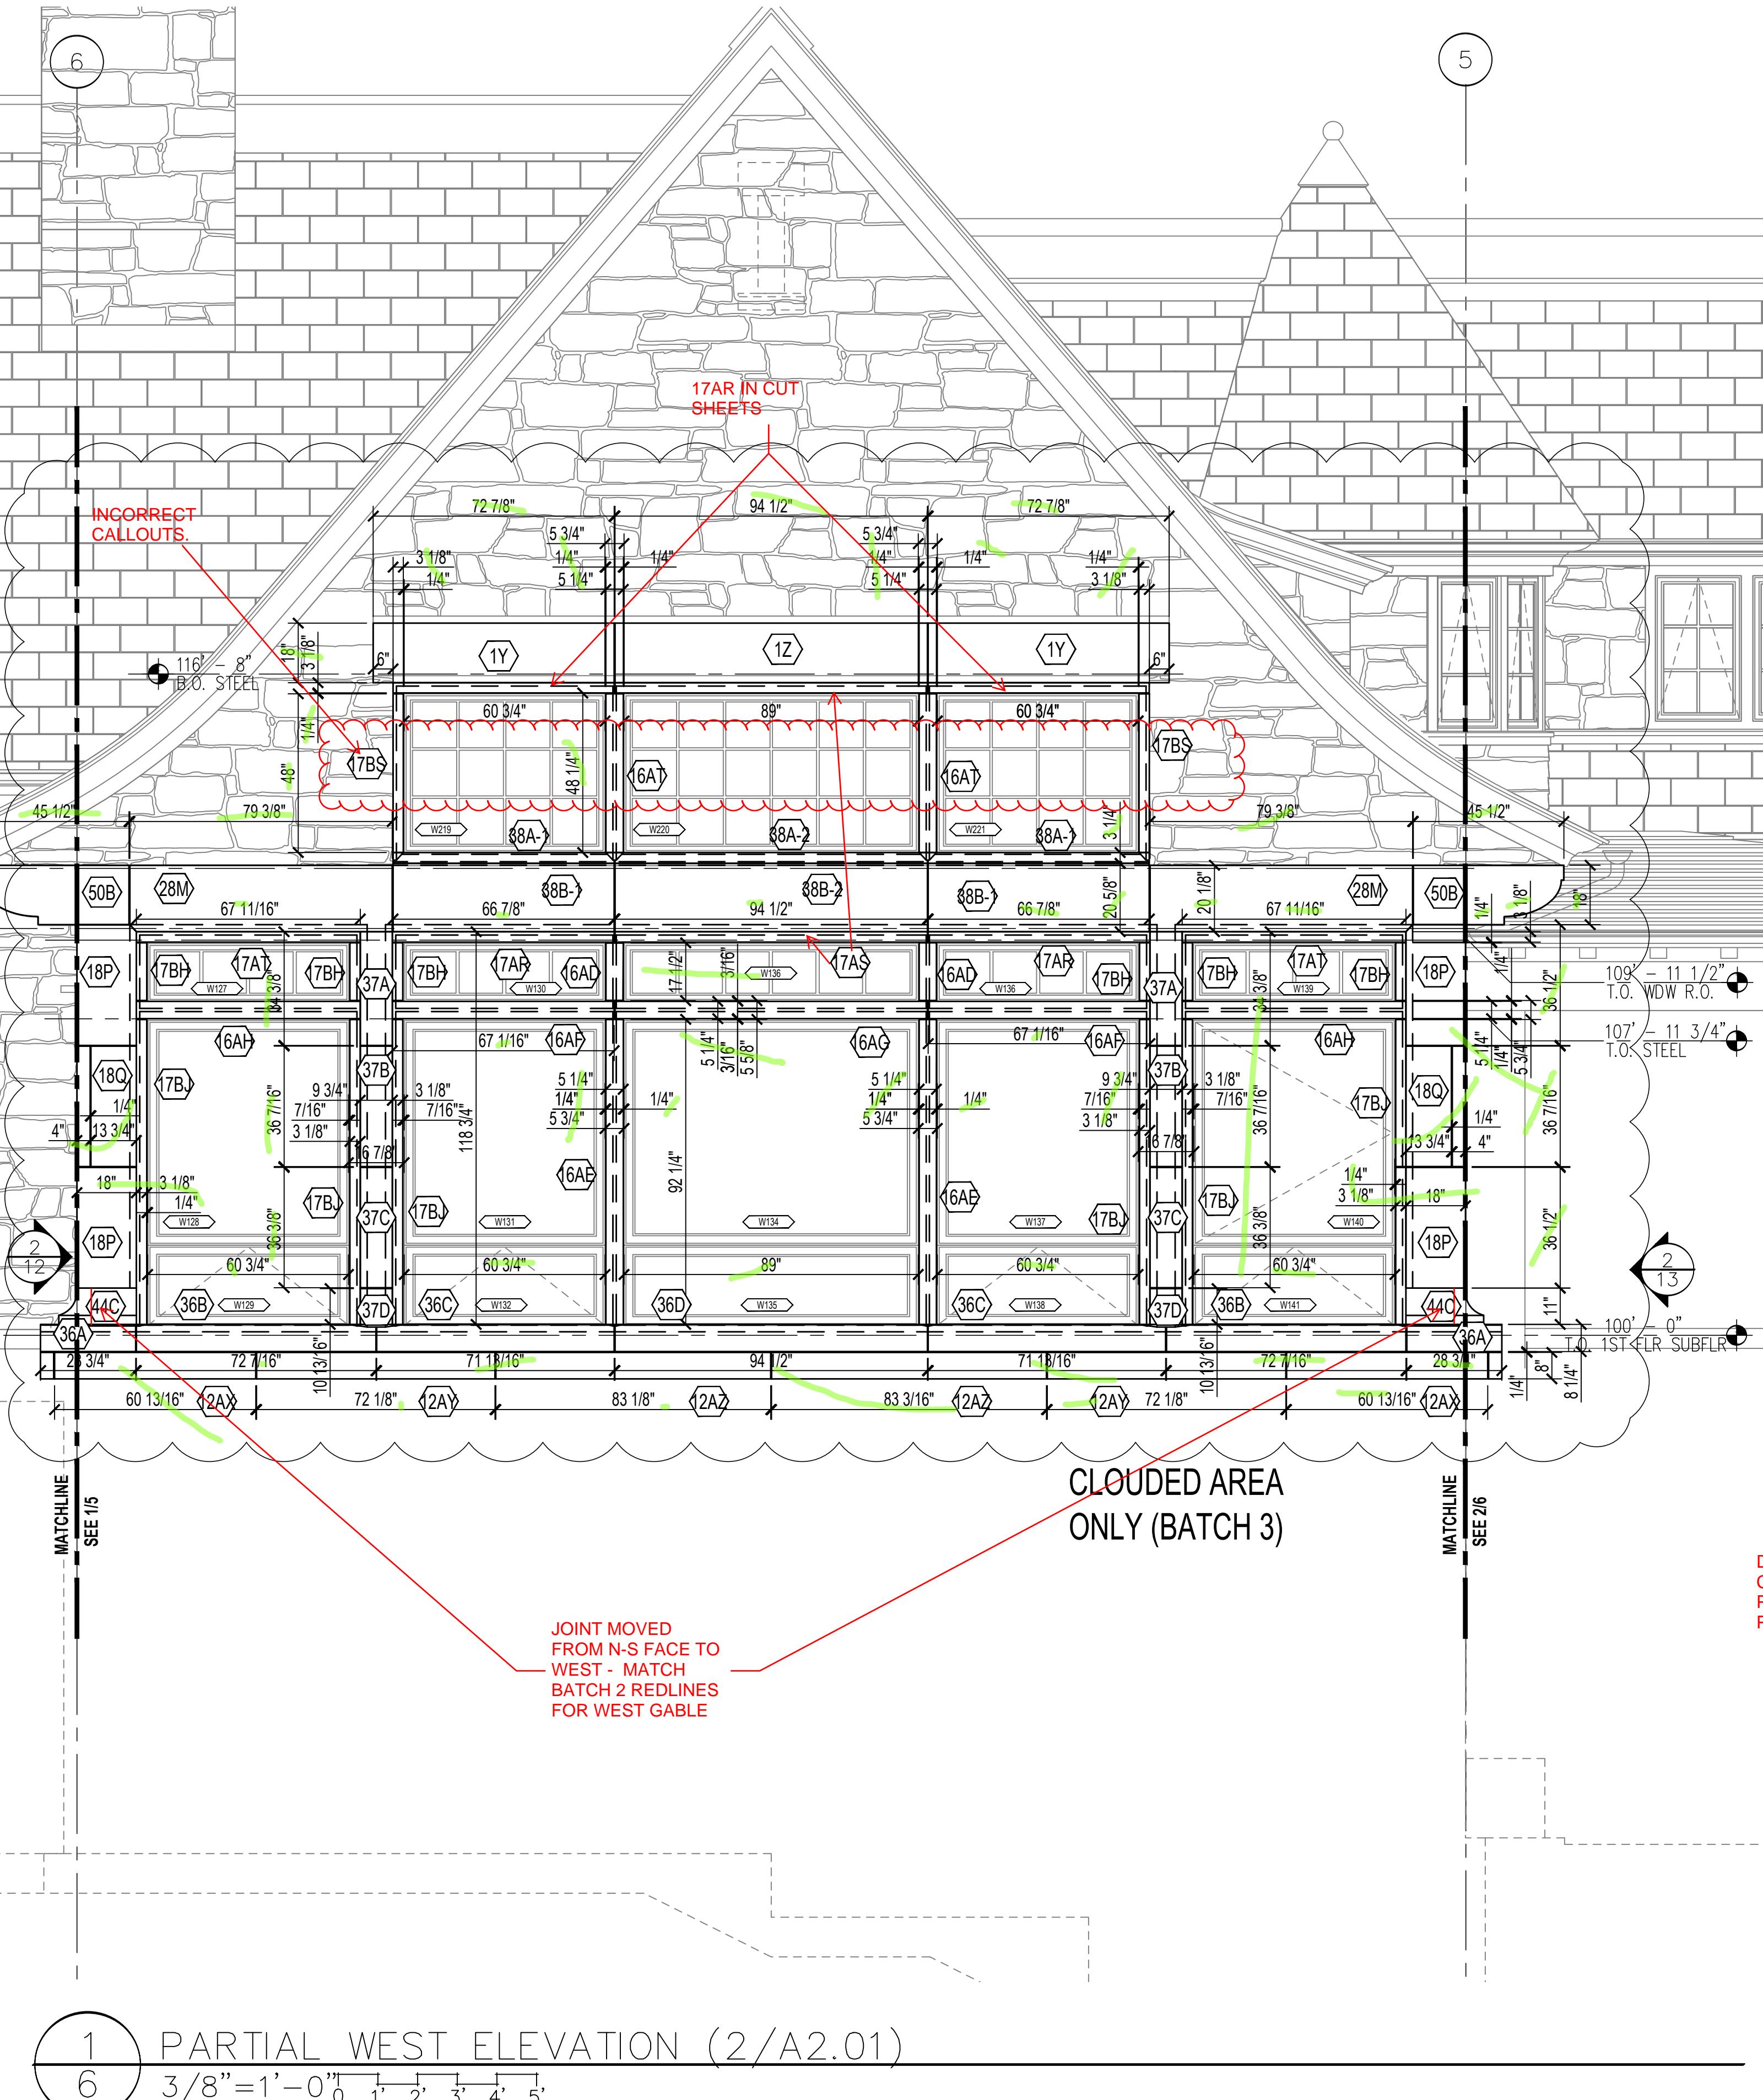

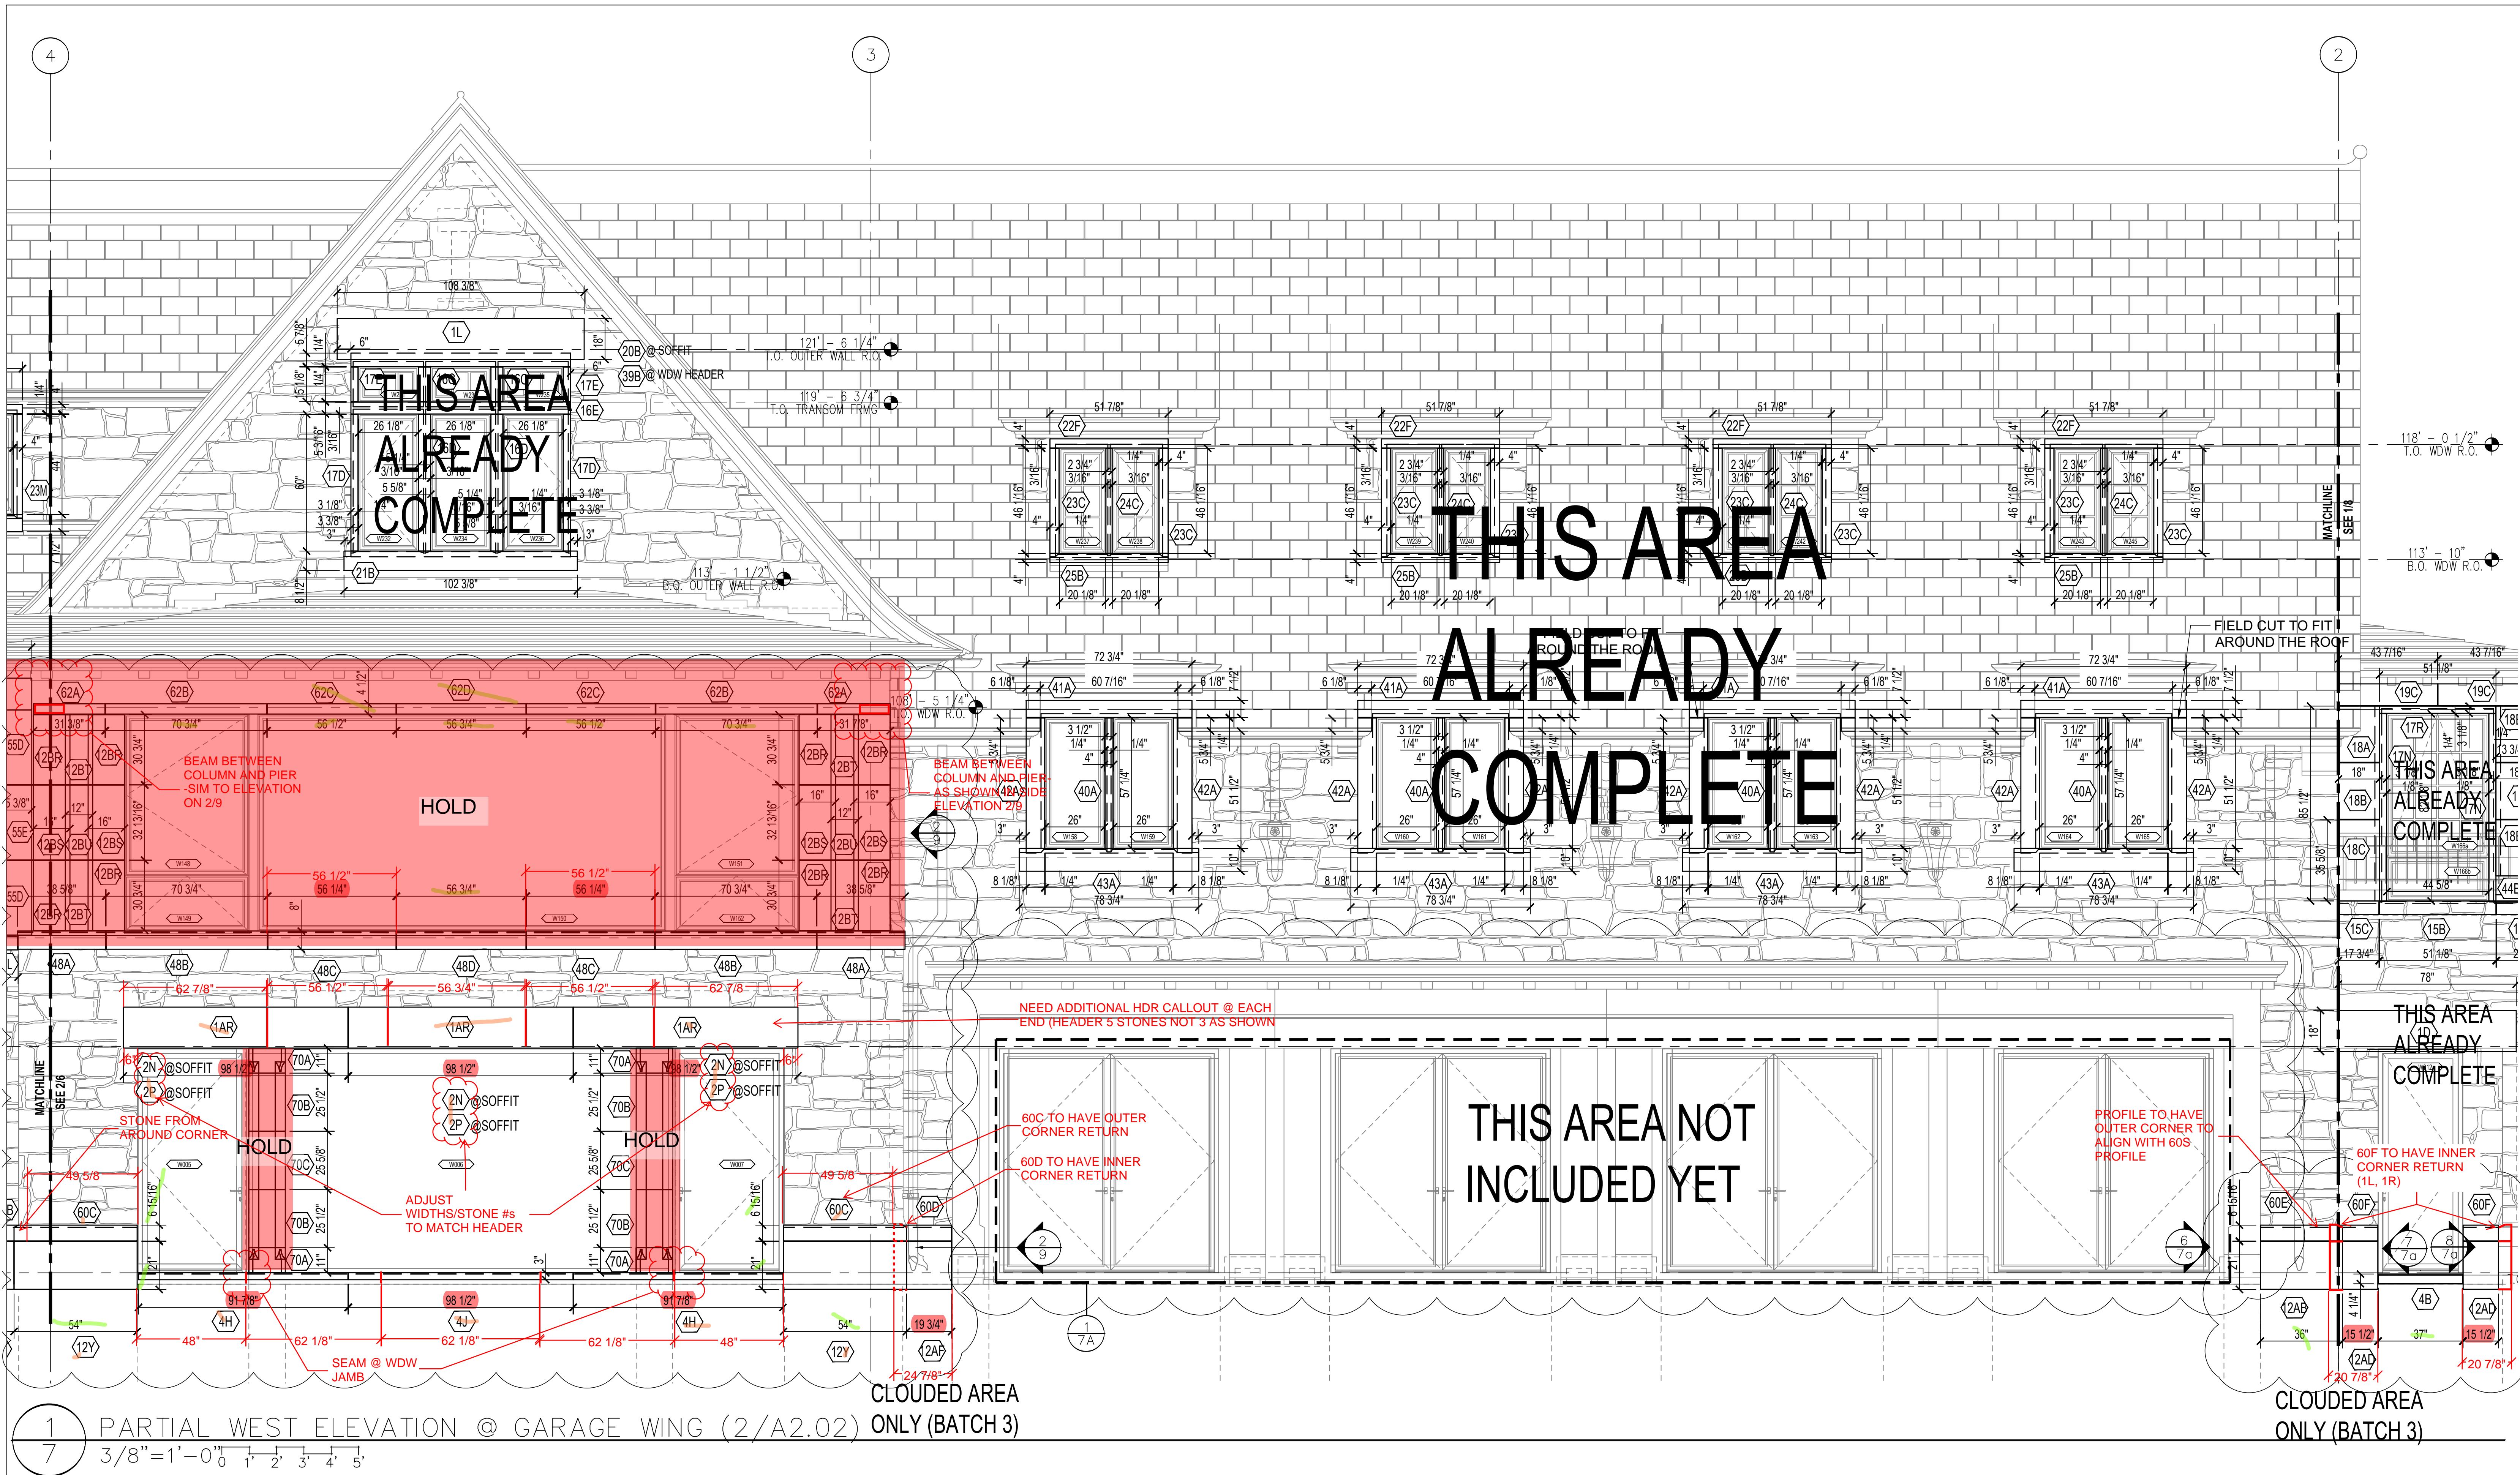


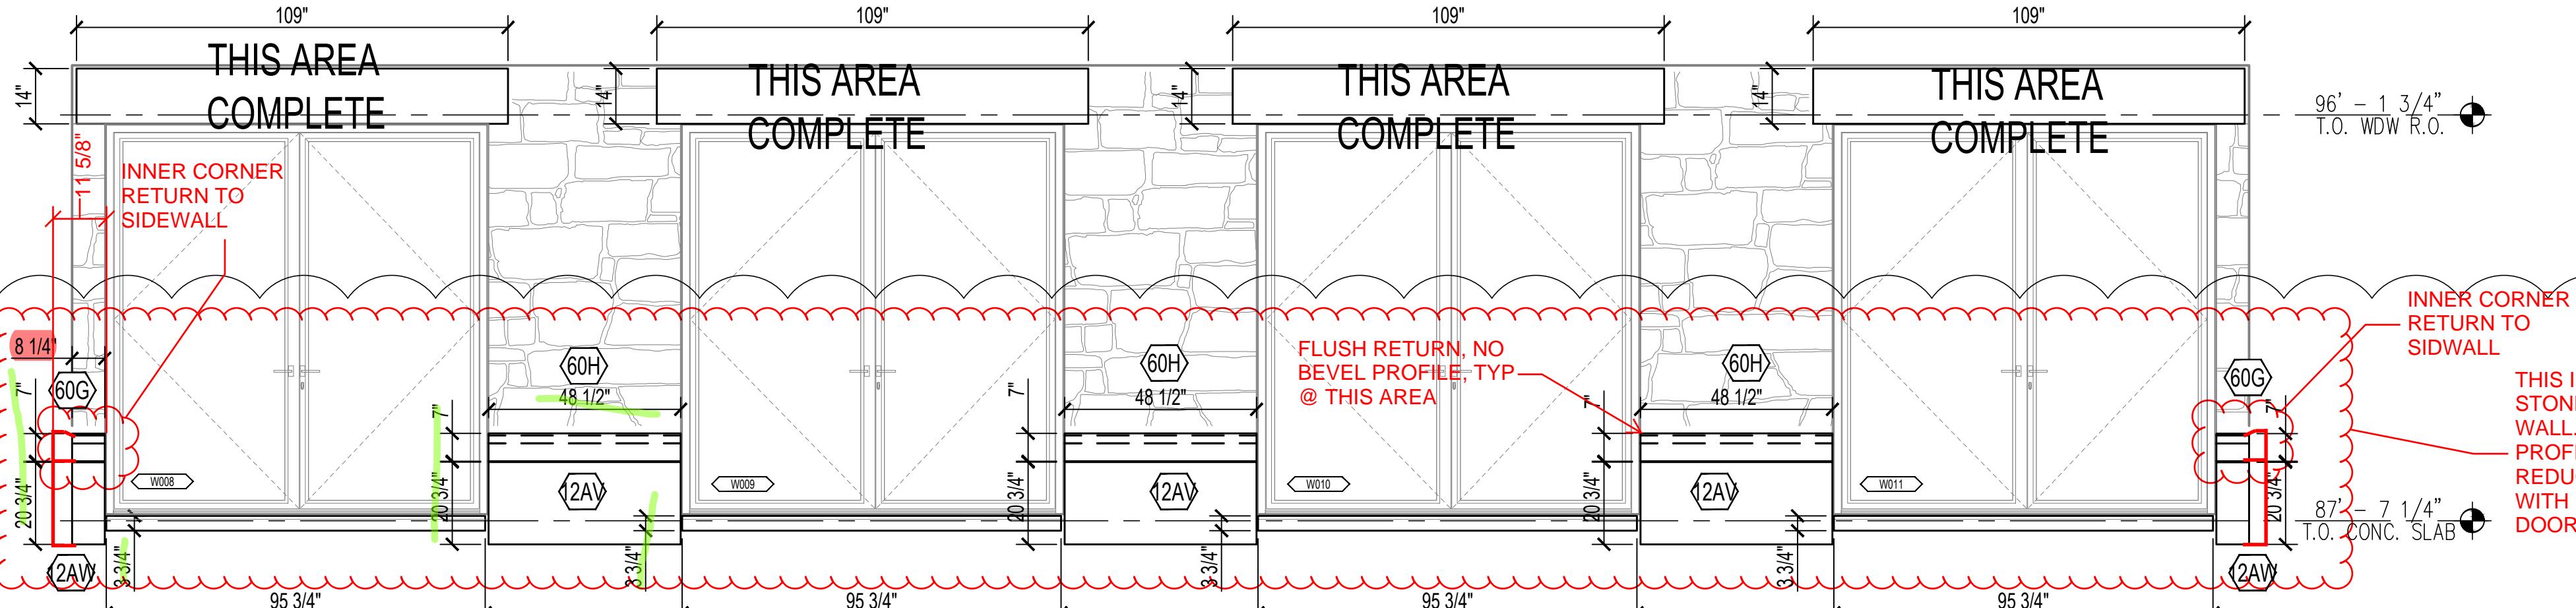


1
7a PARTIAL WEST ELEVATION @ GARAGE WING (2/A2.02)
3/8" = 1'-0" 0' 1' 2' 3' 4' 5'

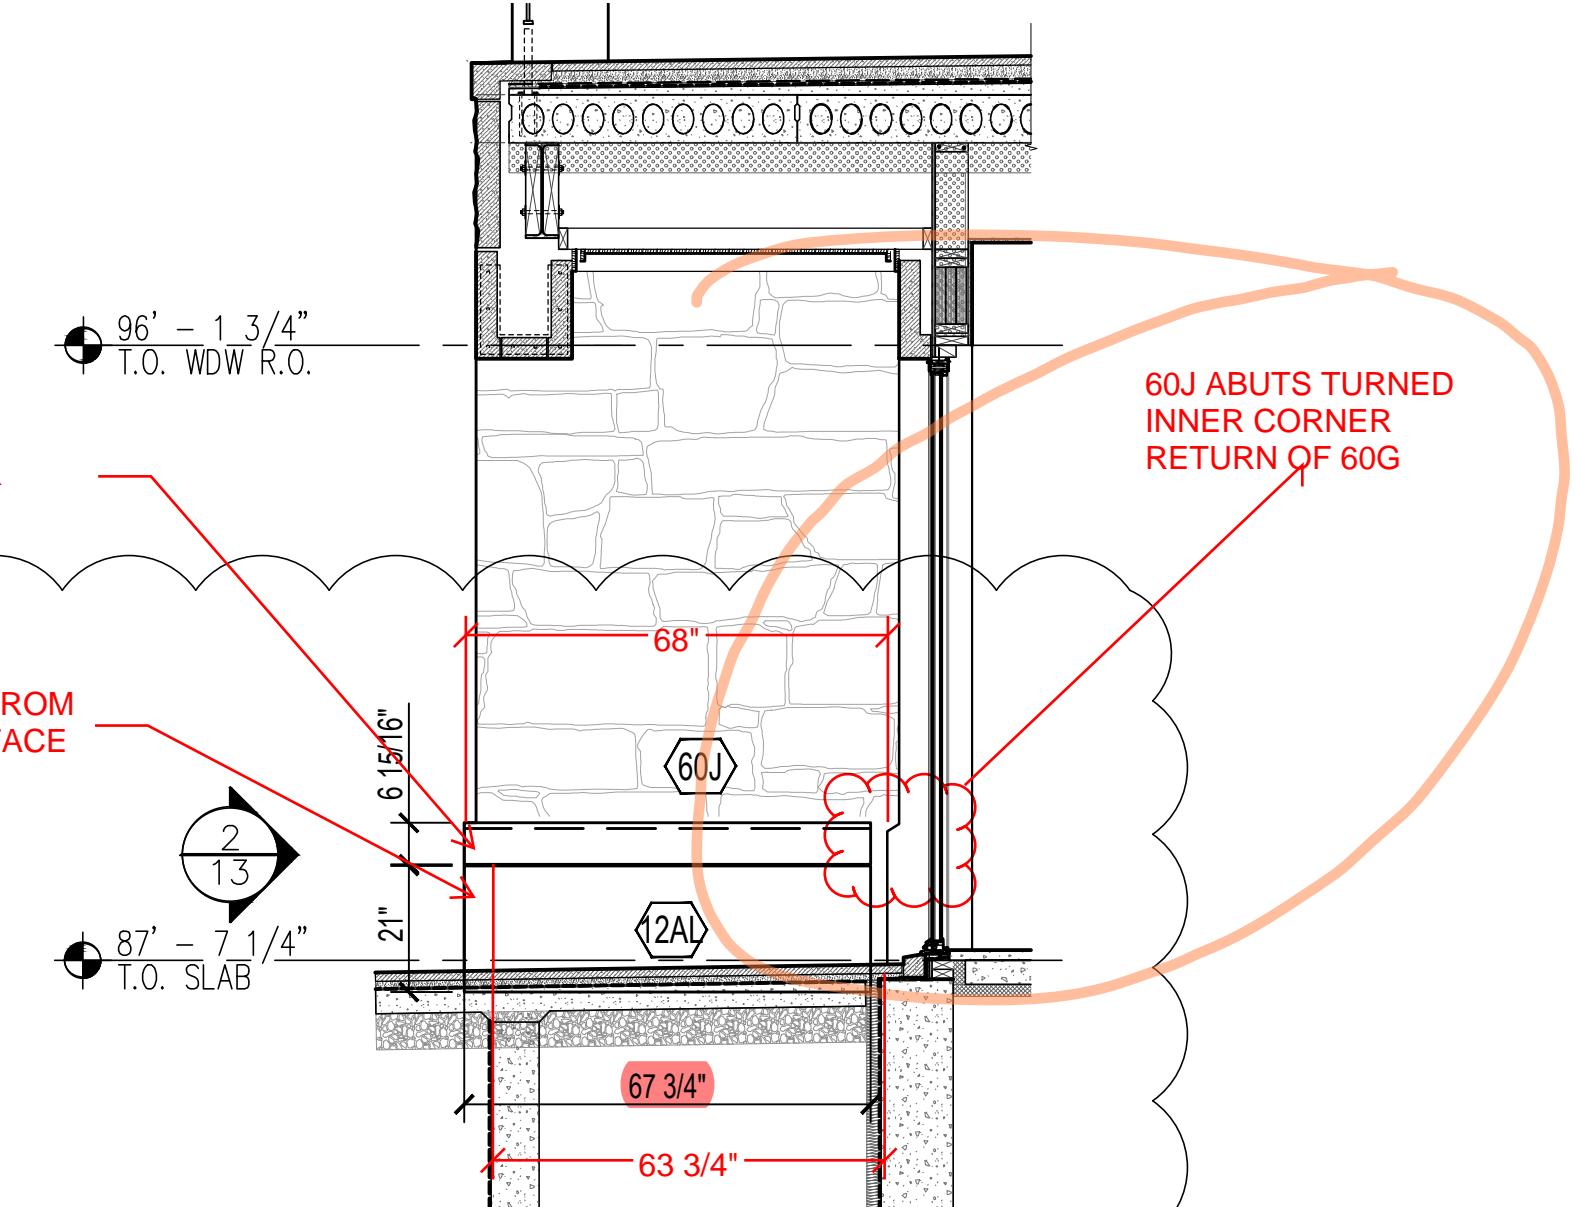


2
7a RTN @ POOL STORAGE (2/A4.5)
3/8" = 1'-0" 0' 1' 2' 3' 4' 5'

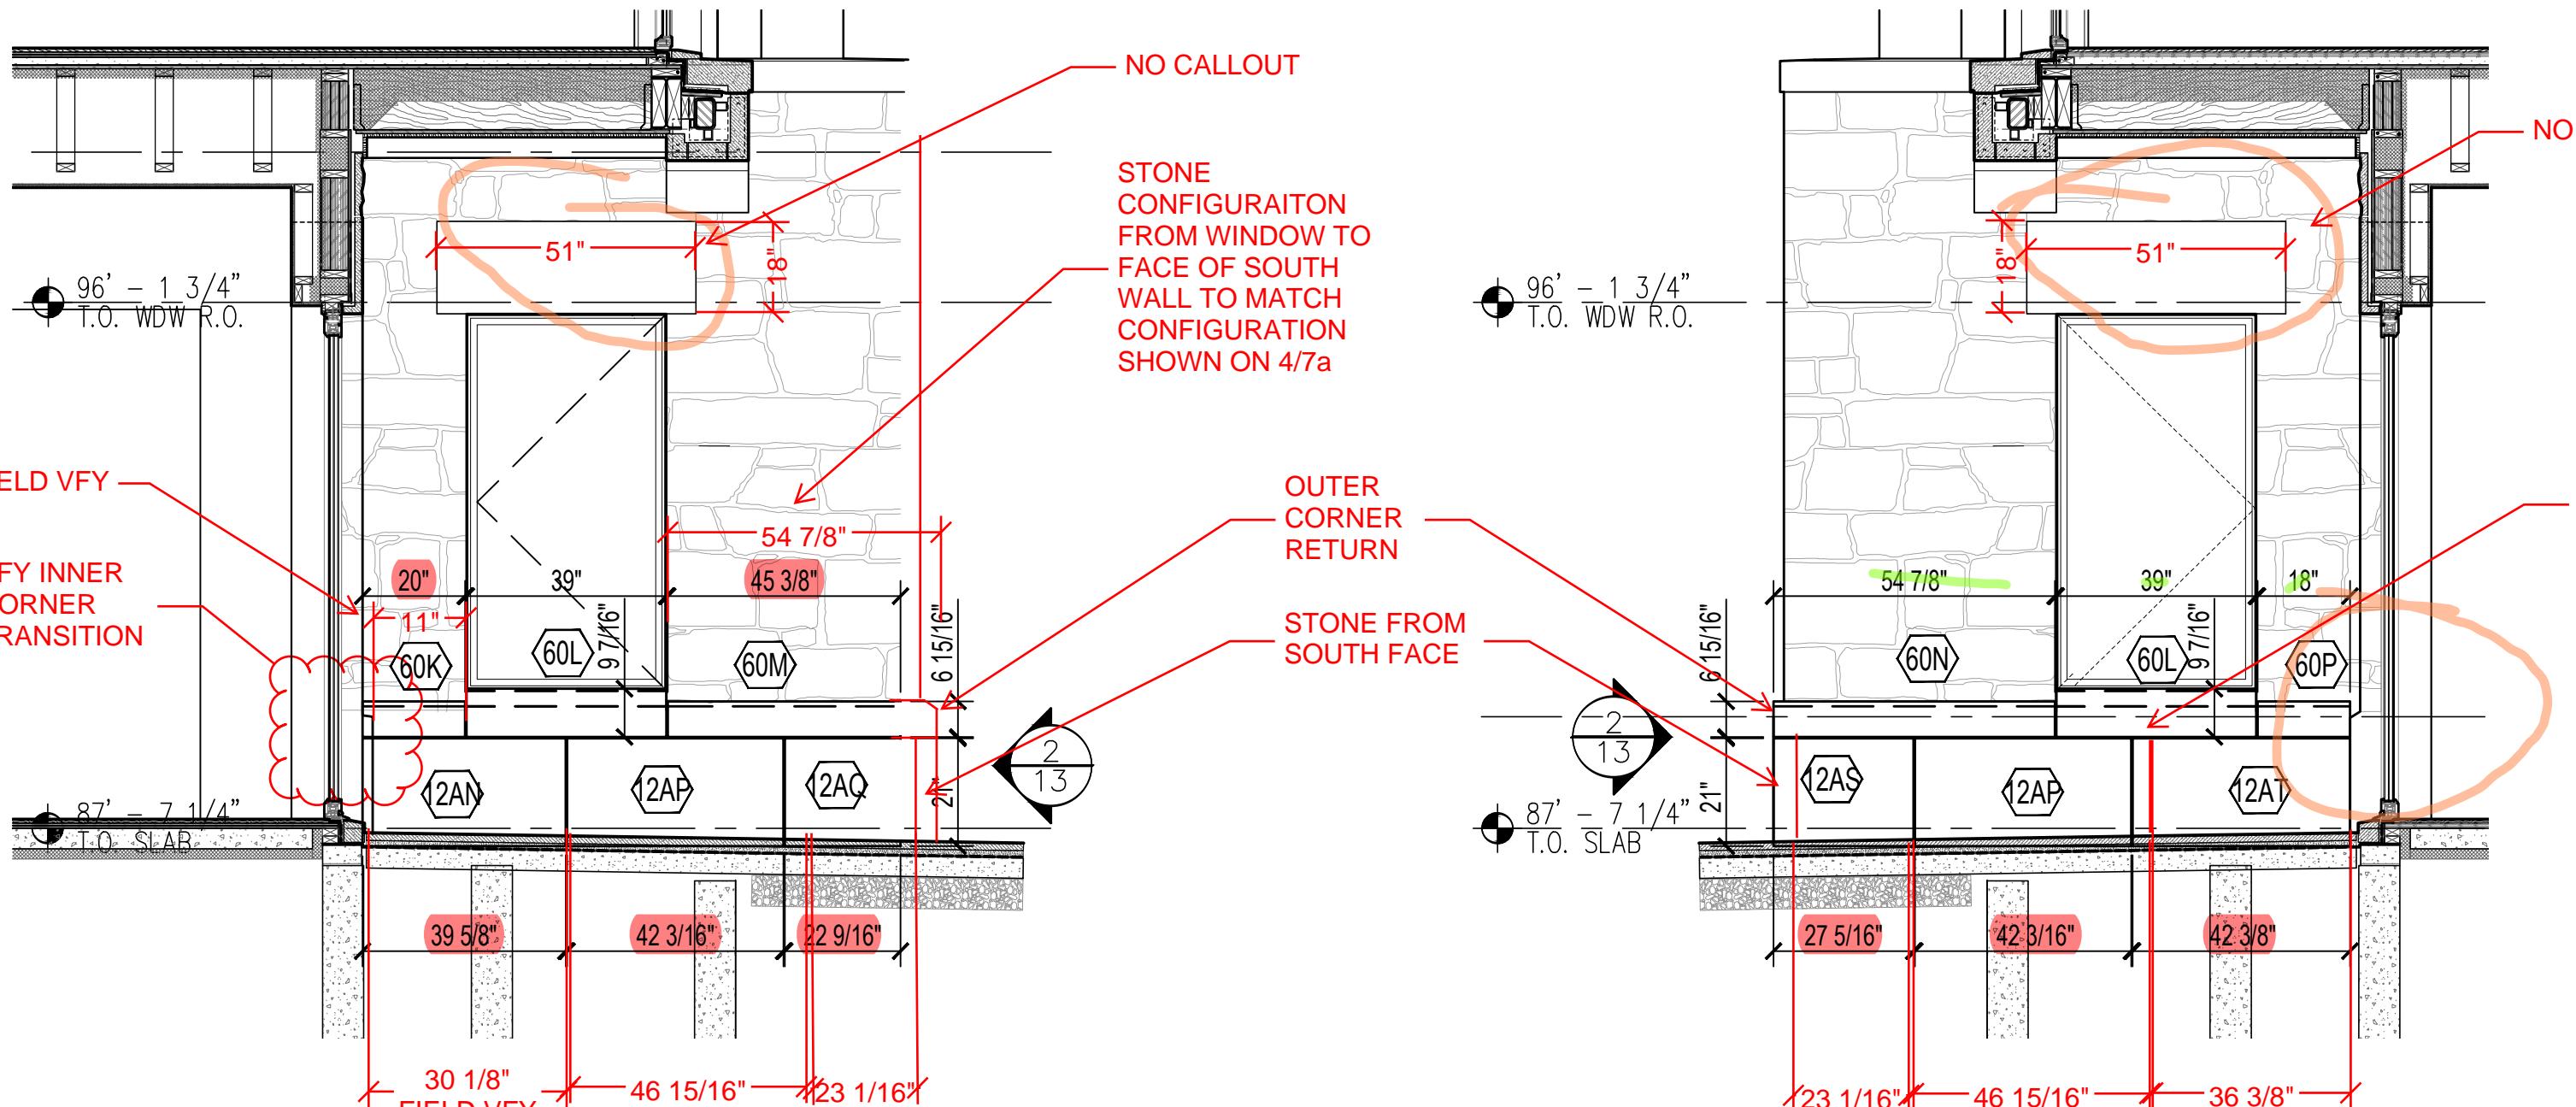


3
7a RTN @ POOL STORAGE (1/A4.5 SIM)
3/8" = 1'-0" 0' 1' 2' 3' 4' 5'

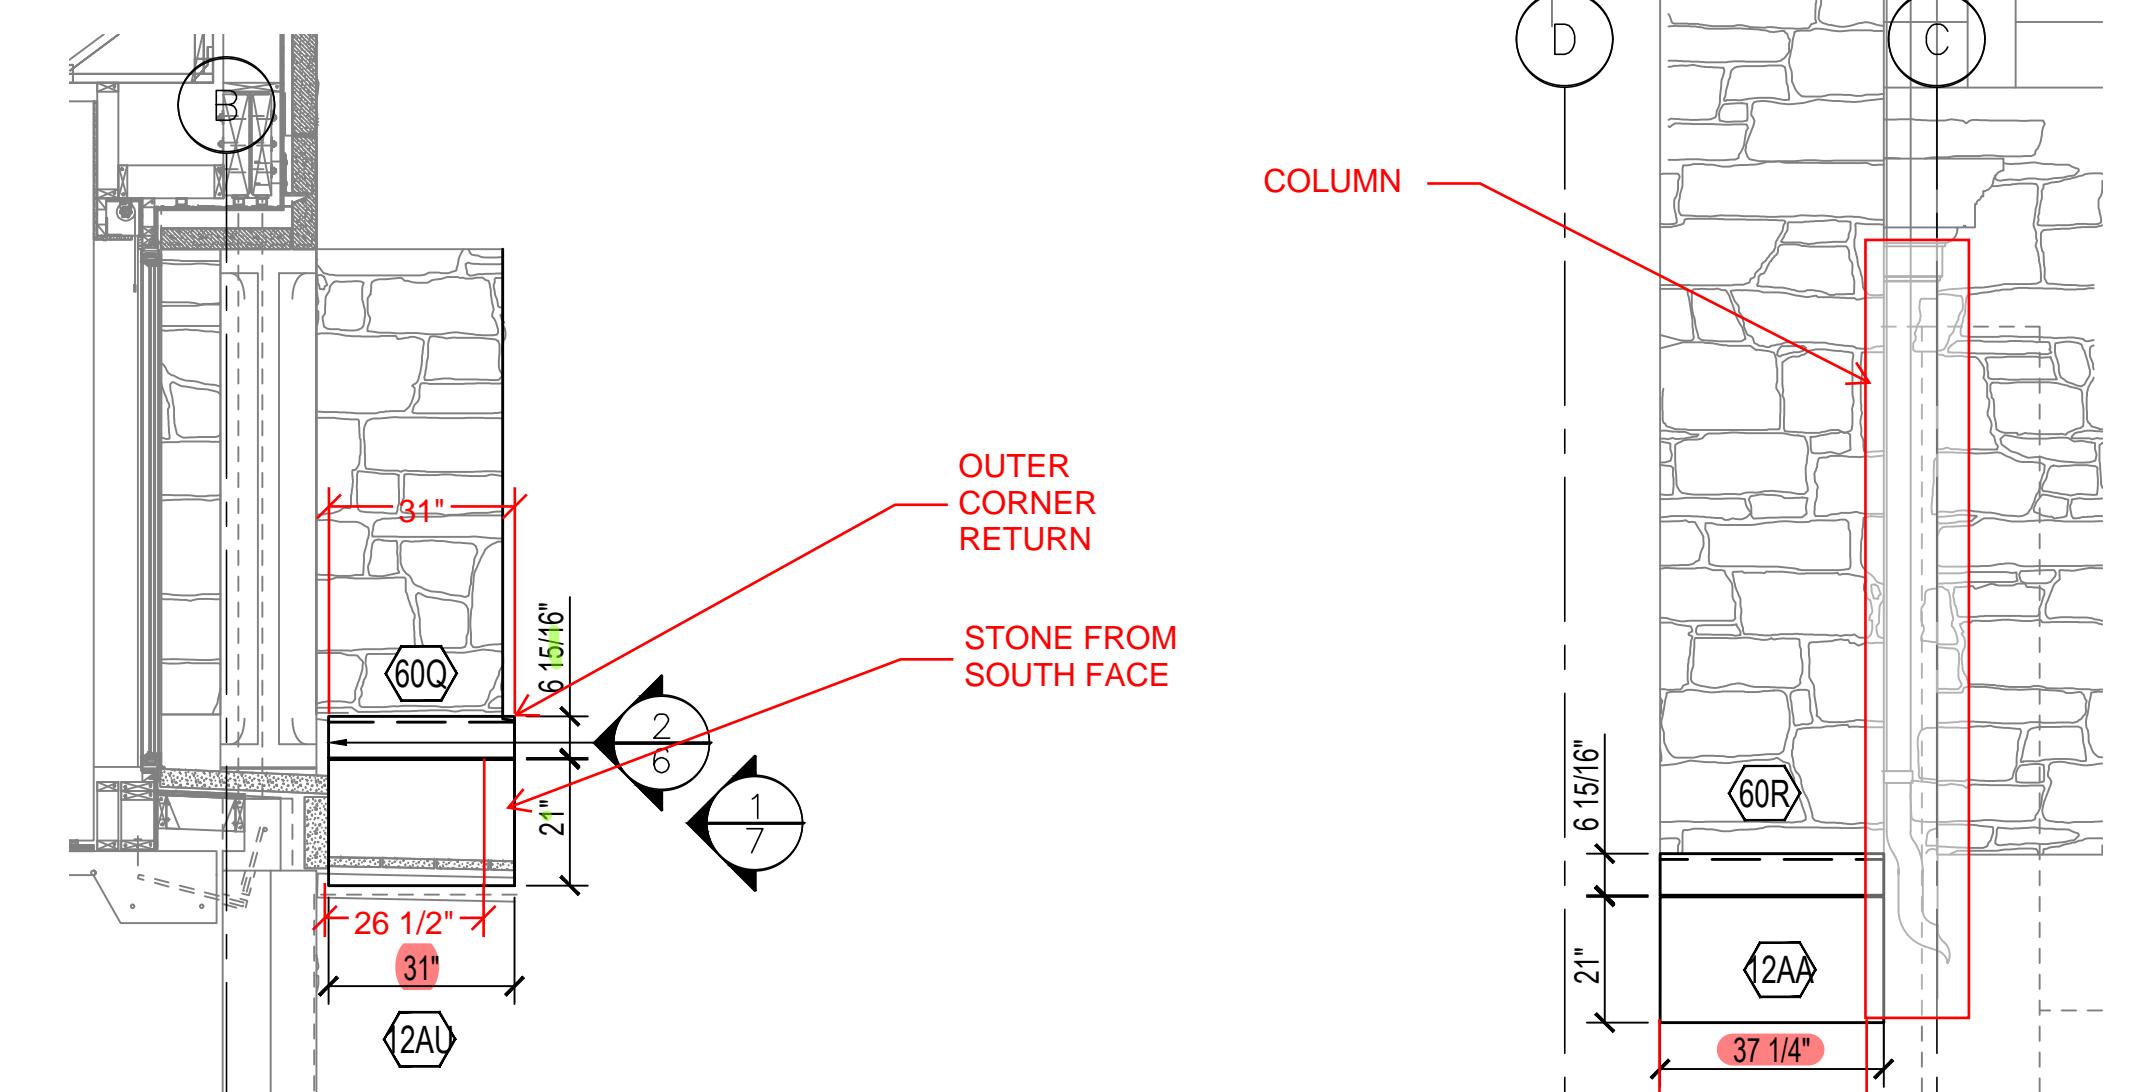

4
7a RTN @ EXERCISE VEST. (1/A4.5)
3/8" = 1'-0" 0' 1' 2' 3' 4' 5'

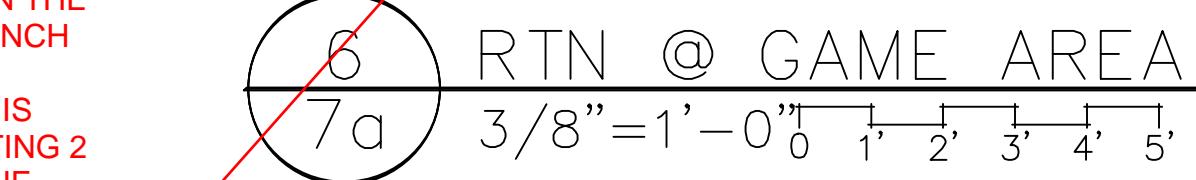



5
7a RTN @ EATING (1/A2.04)
3/8" = 1'-0" 0' 1' 2' 3' 4' 5'

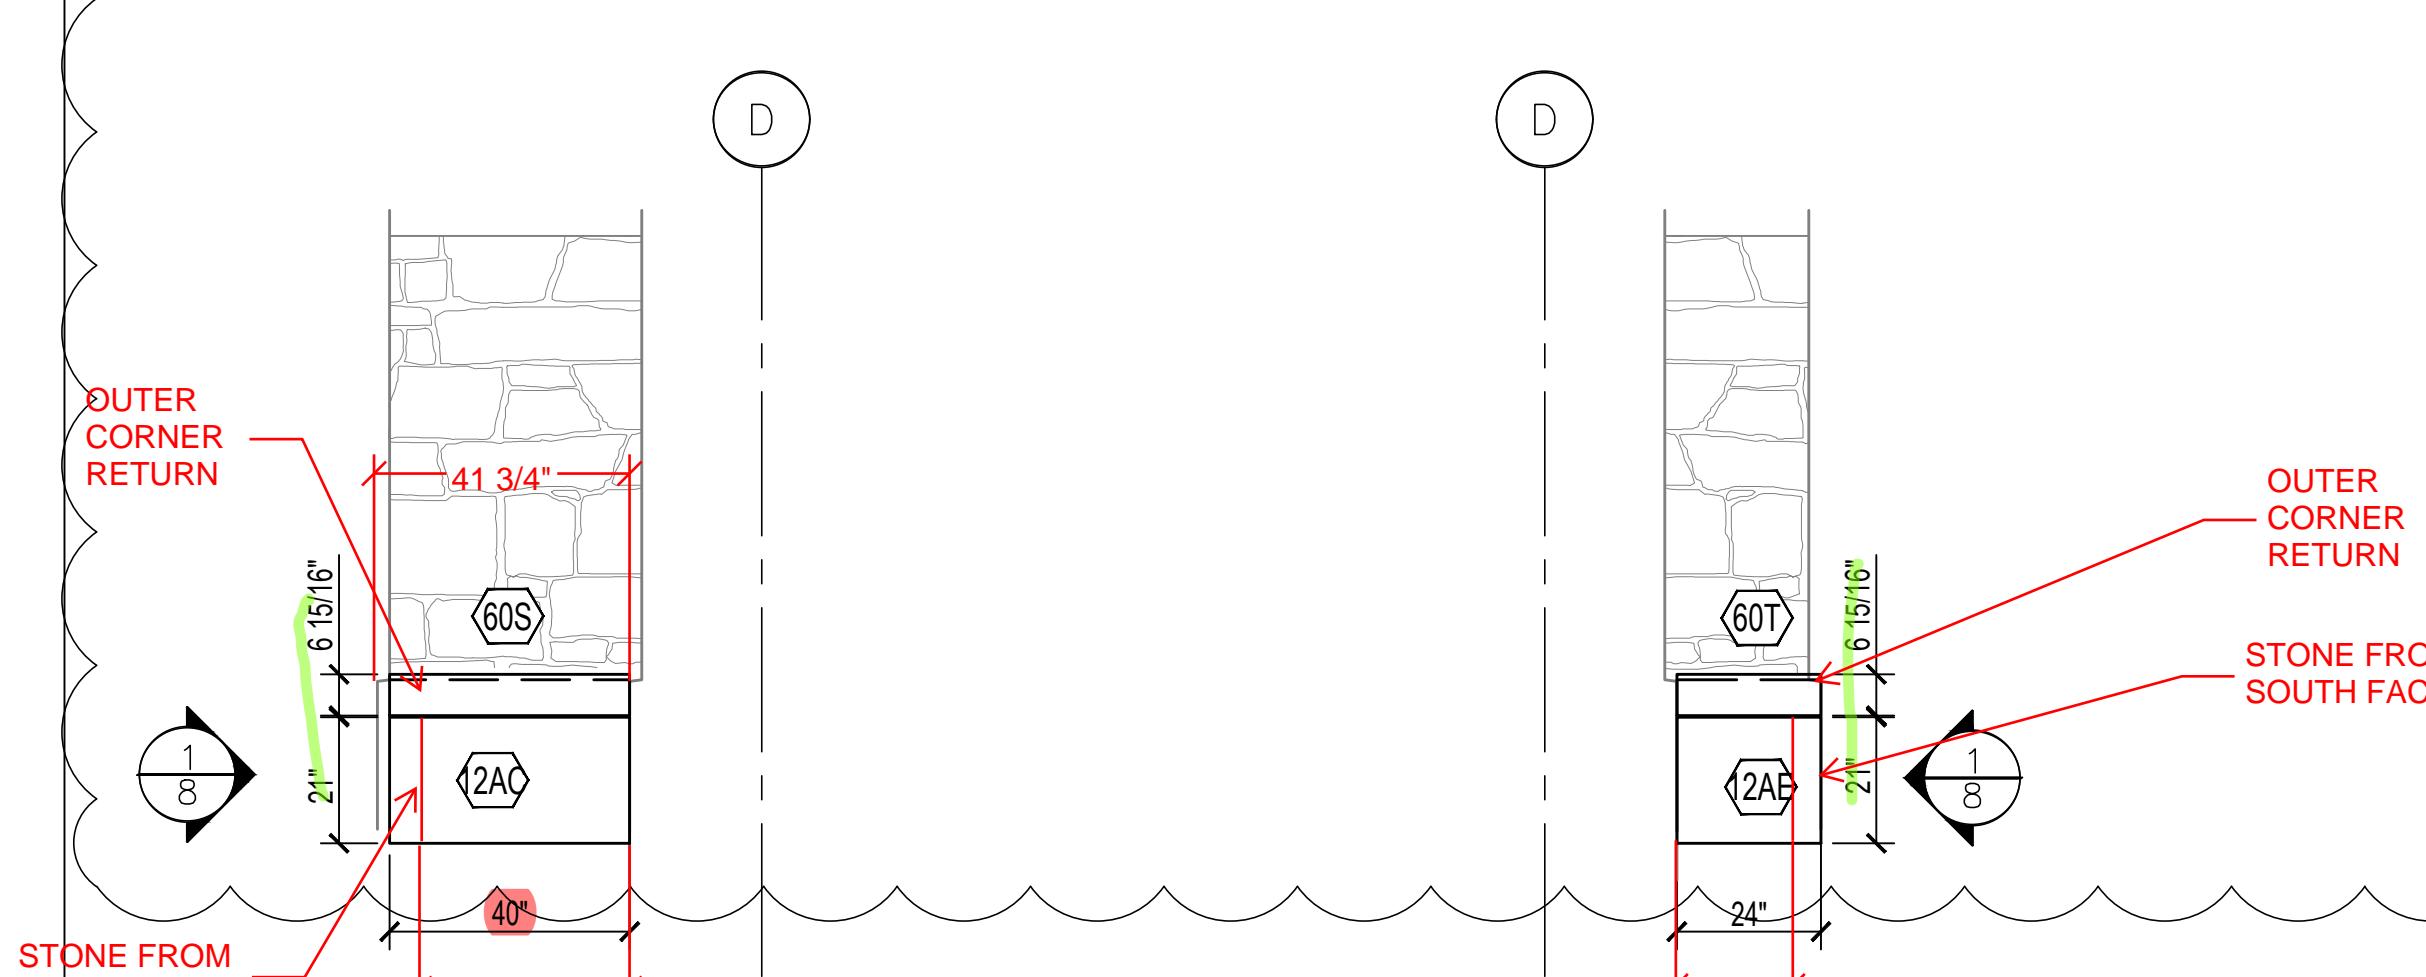

6
7a RTN @ GAME AREA
3/8" = 1'-0" 0' 1' 2' 3' 4' 5'

7
7a RTN @ GAME AREA
3/8" = 1'-0" 0' 1' 2' 3' 4' 5'

CLOUDED AREA
ONLY (BATCH 3)

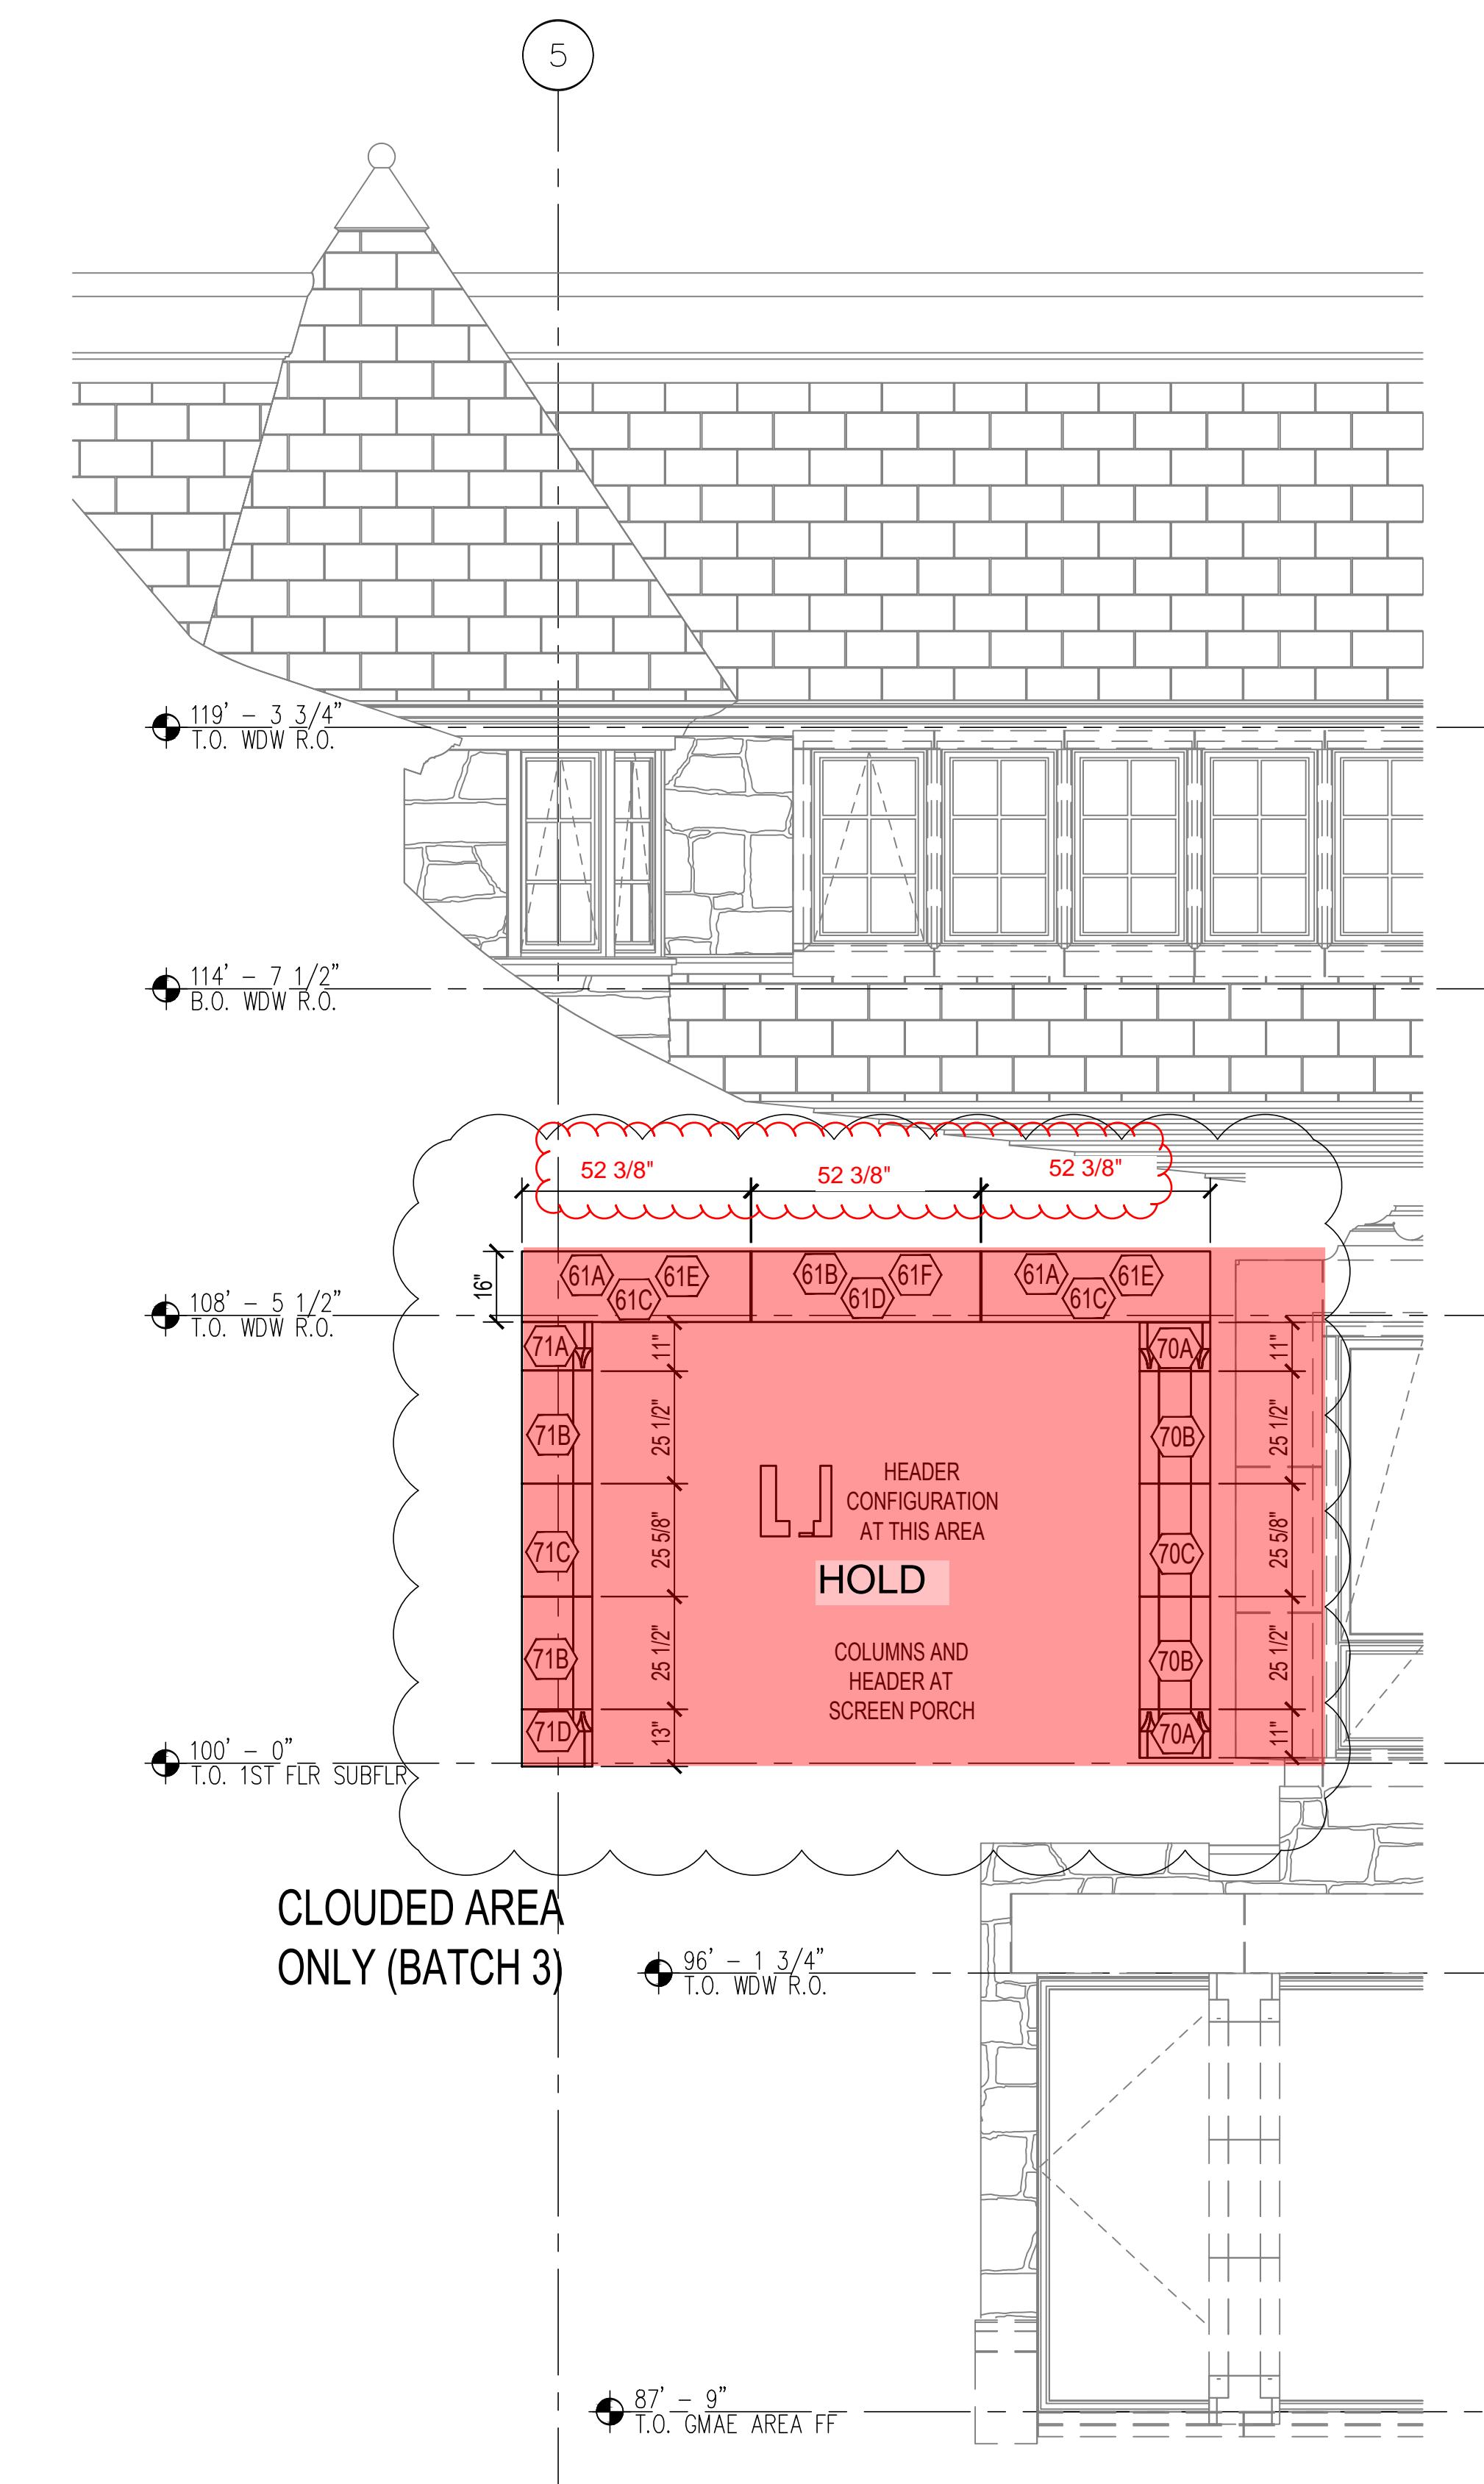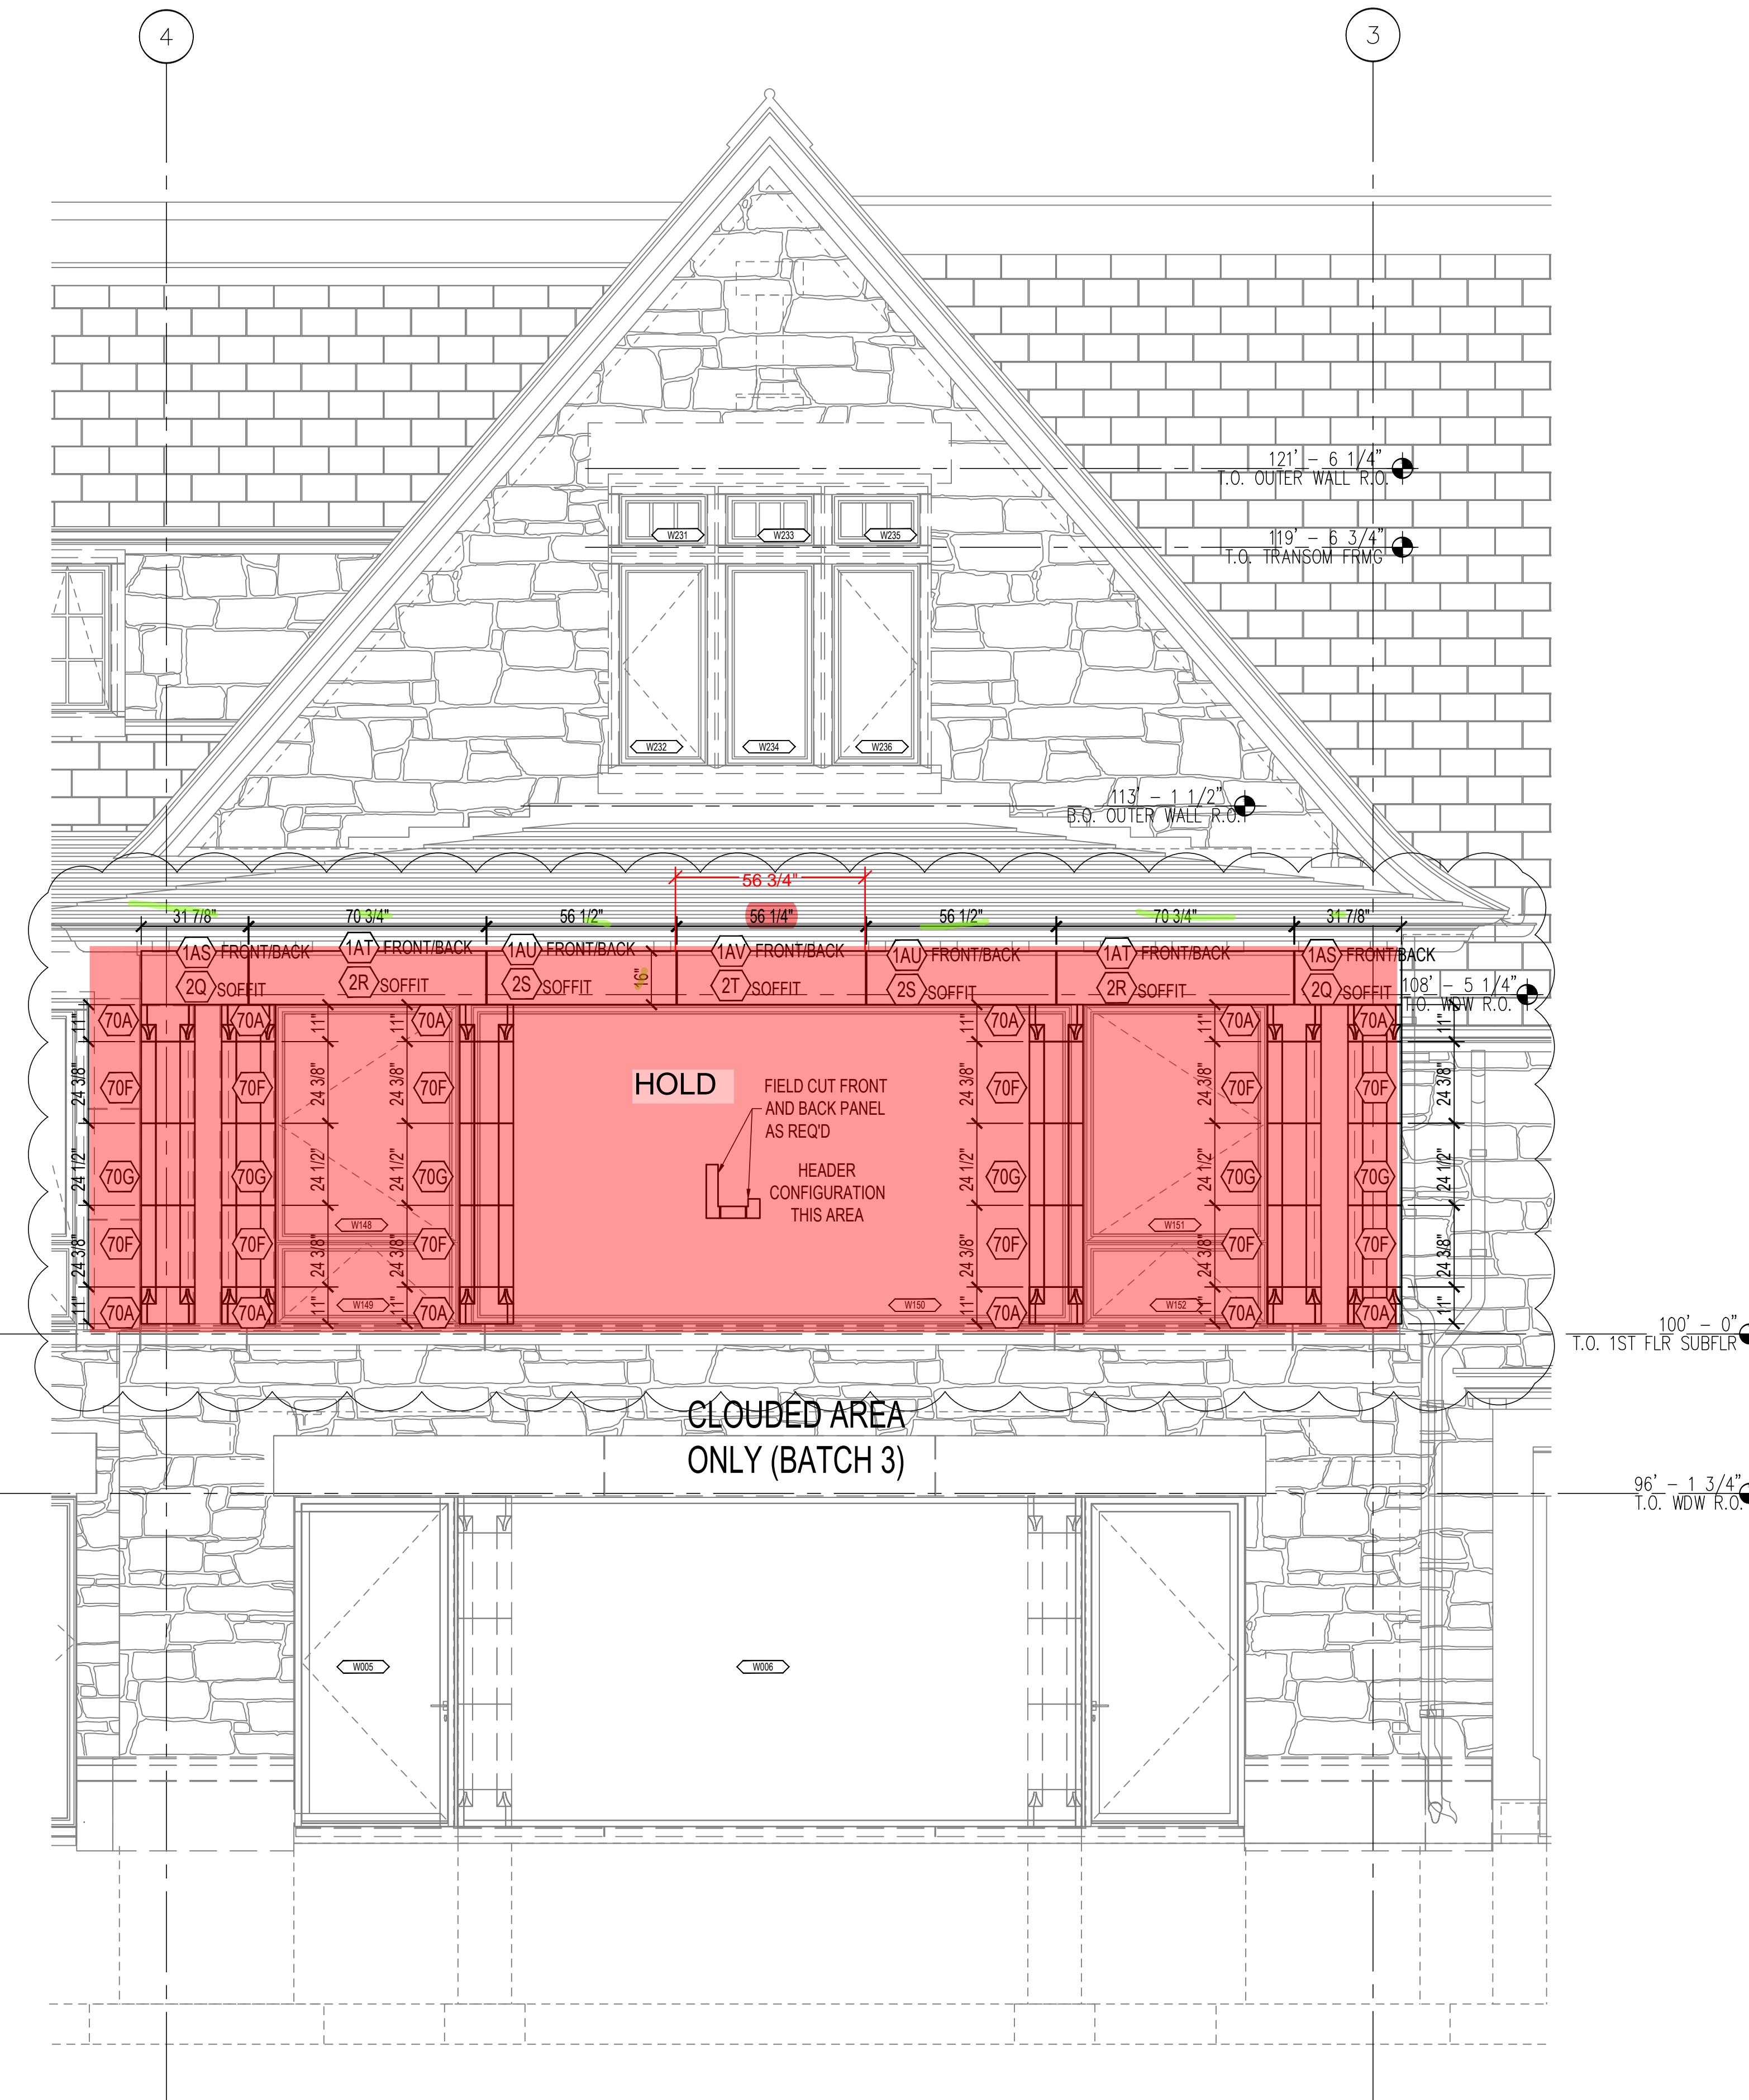

2
7b PART. WEST ELEV. @ GARAGE WING (2/A2.02) (HEADER AND COLUMNS)
3/8"=1'-0" 0 1' 2' 3' 4' 5'

1
7b PARTIAL WEST ELEVATION @ GARAGE WING (2/A2.02) (HEADER AND COLUMNS)
3/8"=1'-0" 0 1' 2' 3' 4' 5'

**THIS AREA
COMPLETE**

**CLOUDED AREA
ONLY (BATCH 3)**

**SEE 1/7 FOR
NOTES. THIS IS
DUPLICATE**

1 PARTIAL WEST ELEVATION @ GARAGE WING (2/A2.02)

$$8 \qquad 3/8" = 1' - 0''_0 \quad | \quad 1' \quad 2' \quad 3' \quad 4' \quad 5'$$



An architectural line drawing of a building's exterior facade. The facade features a grid of windows and doors, some with decorative frames. Large, bold, black letters spell out "THIS AREA IS COMPLETE" across the center of the drawing. The letters are thick and have a slight drop shadow. The background contains various dimensions, labels like "N118", "16V", "16U", "16W", "7AA", "7AC", and "1T", and hexagonal callouts with numbers such as 28C, 28F, 219, 25E, 48 3/16", 5 1/16", 41 15/16", 52 6/16", 80 5/8", 88 5/8", 13 3/4", 40 1/16", 40 3/16", 18", 3 3/8", 3 1/8", 5 1/4", 3/16", 5 5/8", 3/16", 5 1/4", 3/16", 5 5/8", 3/16", 3 1/8", 1/4", 3 3/8", 1/4", 121", 40 1/8", 53 1/2", and 53 1/2". A small arrow points to the left at the bottom left corner.

2 PARTIAL NORTH ELEVATION (1/A2.03)


$$8 \quad 3/8'' = 1' - 0''_0 \quad | \quad 1' \quad 2' \quad 3' \quad 4'$$



		KASOTA STONE 820 WILLOW STREET MANKATO MN, 56001	(507) 508-0684		
		Drawing Title: Elevations			
		Project: GALE ROAD			
7/29/20	1-Arch Redlines	Architect: TEA2 ARCHITECTS			
Date	Description	General Contractor: XX			
	Revisions	Drawn By: PDD	Date: 03/10/2021	Scale: 3/8" = 1'-0"	Drawing Number: 8 of 14

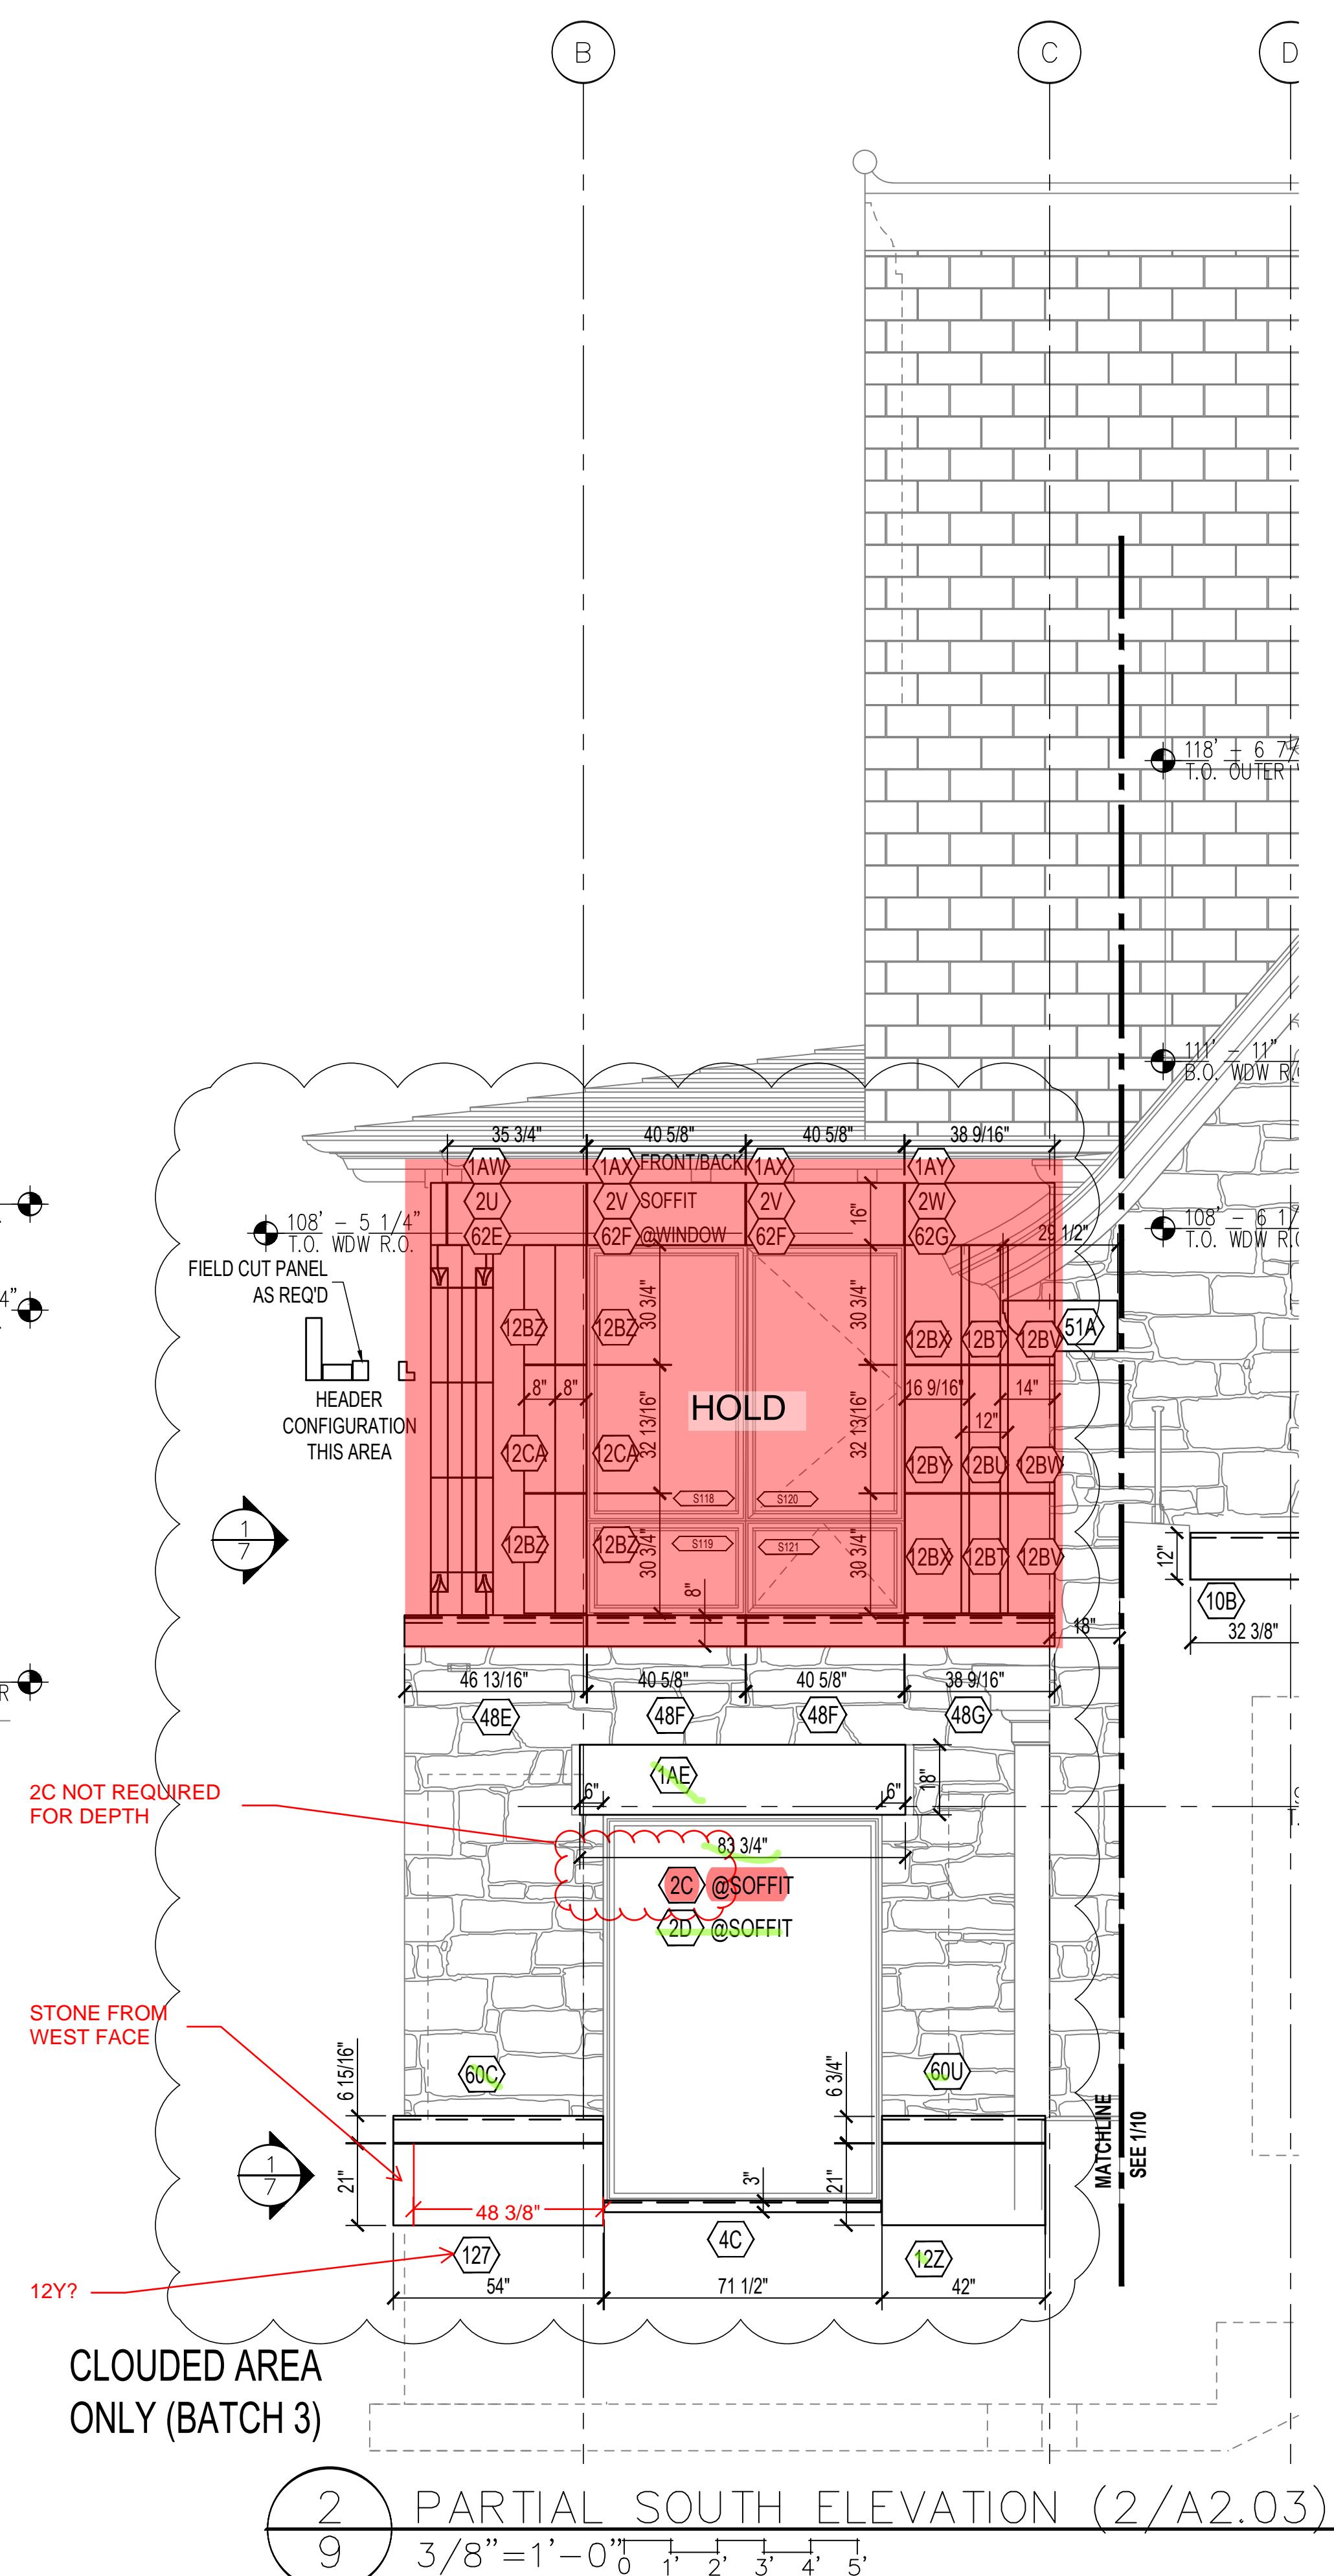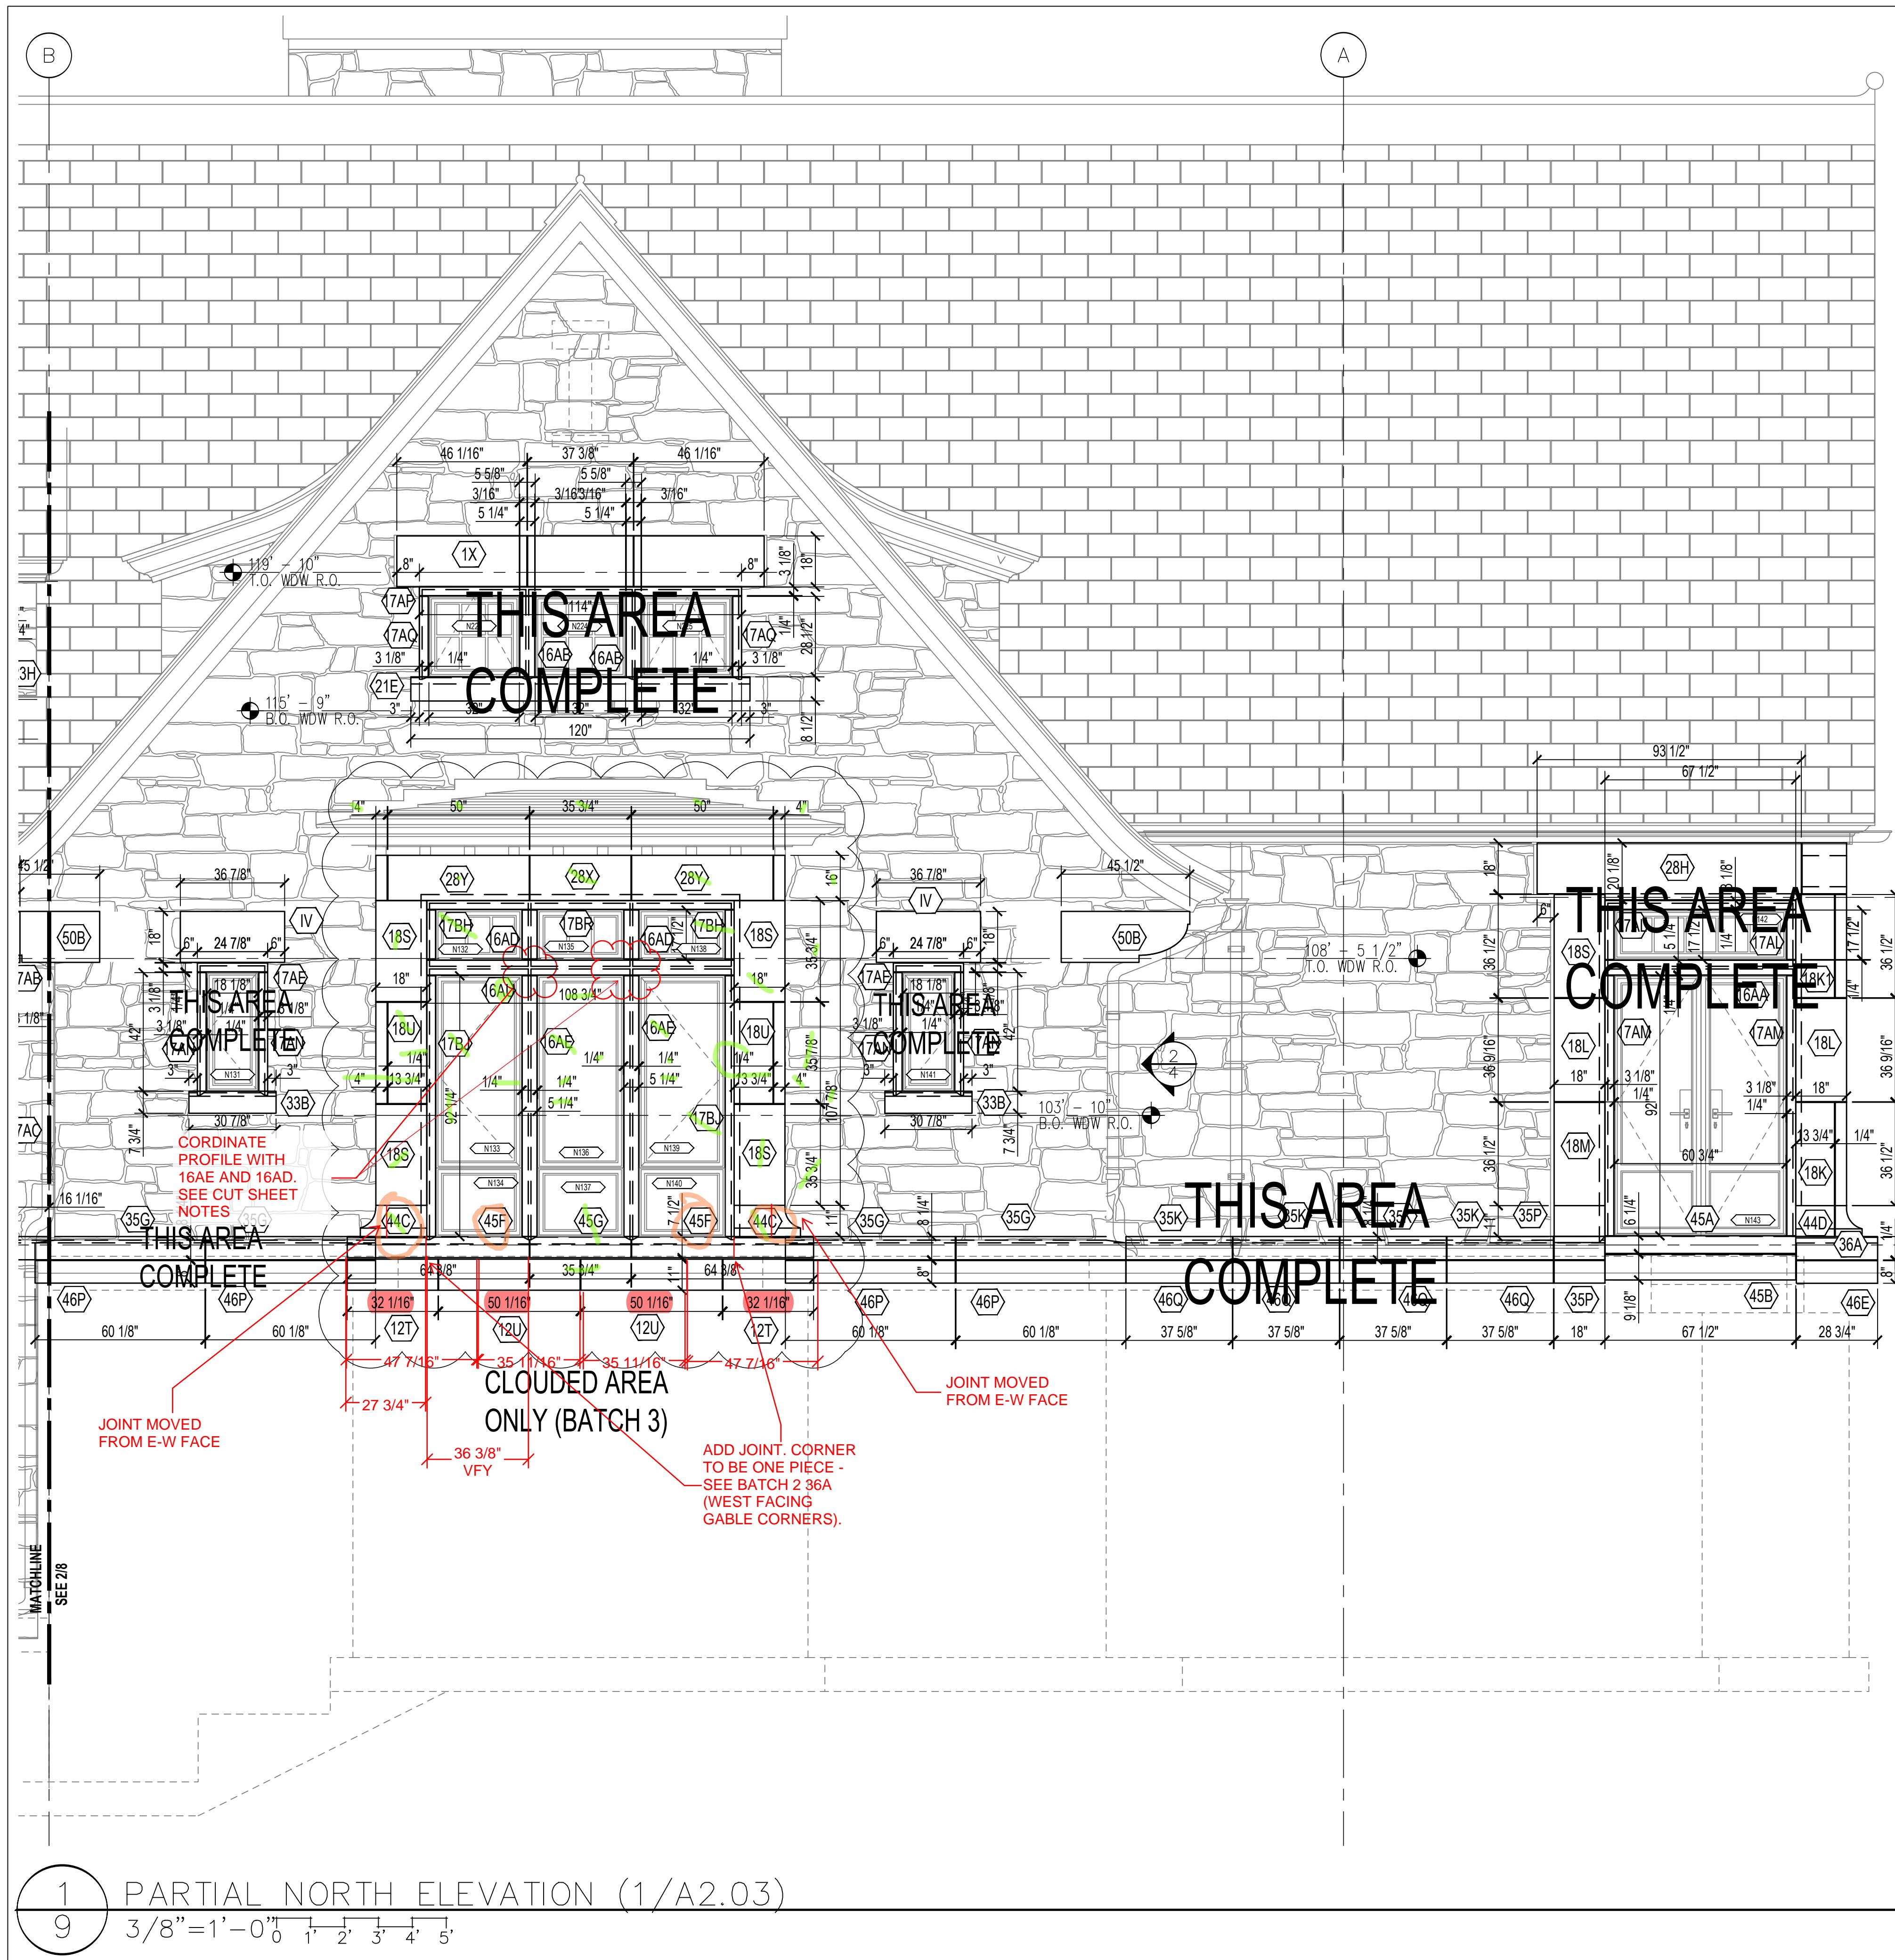

**THIS AREA
COMPLETE**

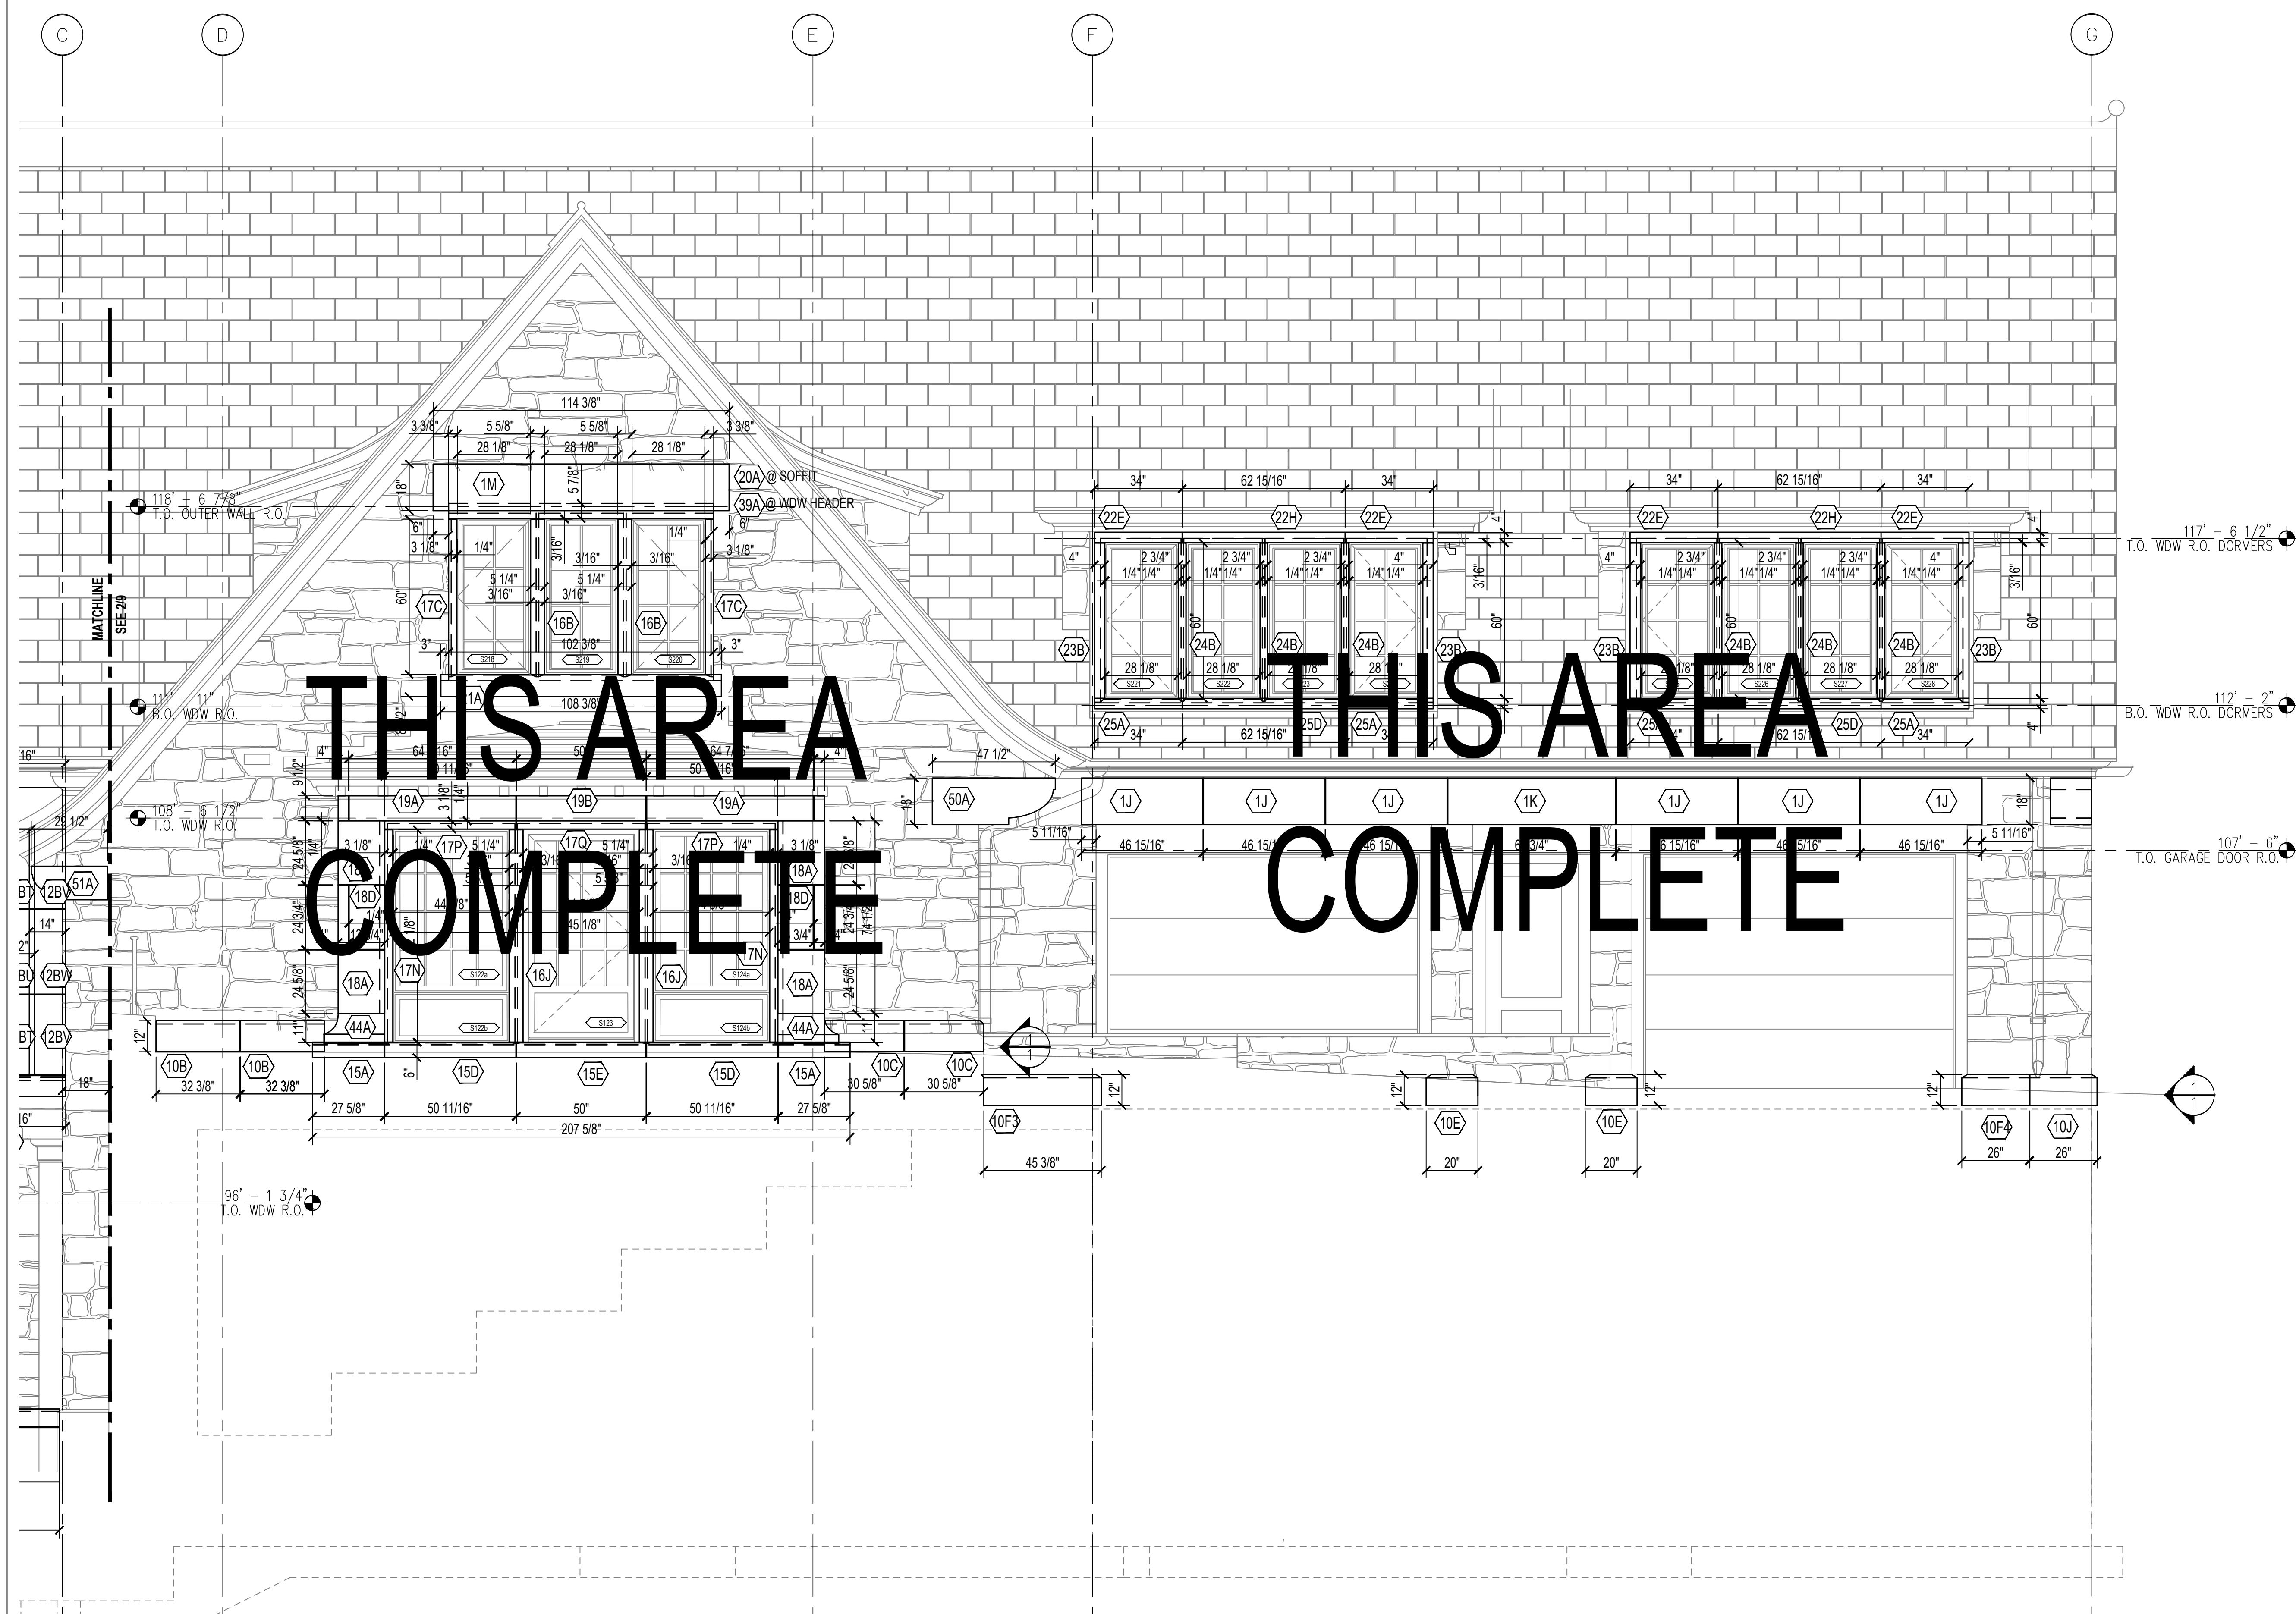


1 PARTIAL SOUTH ELEVATION (2/A2.03)


10 3/8"=1'-0" 0 1' 2' 3' 4' 5'




		KASOTA STONE 820 WILLOW STREET MANKATO MN, 56001 (507) 508-0684	
Drawing Title: Elevations			
Project: GALE ROAD			
7/29/20	1-Arch Redlines	Architect: TEA2 ARCHITECTS	
Date	Description	General Contractor: XX	
Revisions		Drawn By: PDD	Date: 03/10/2021
Scale: 3/8" = 1'-0"		Drawing Number:	10 of 14

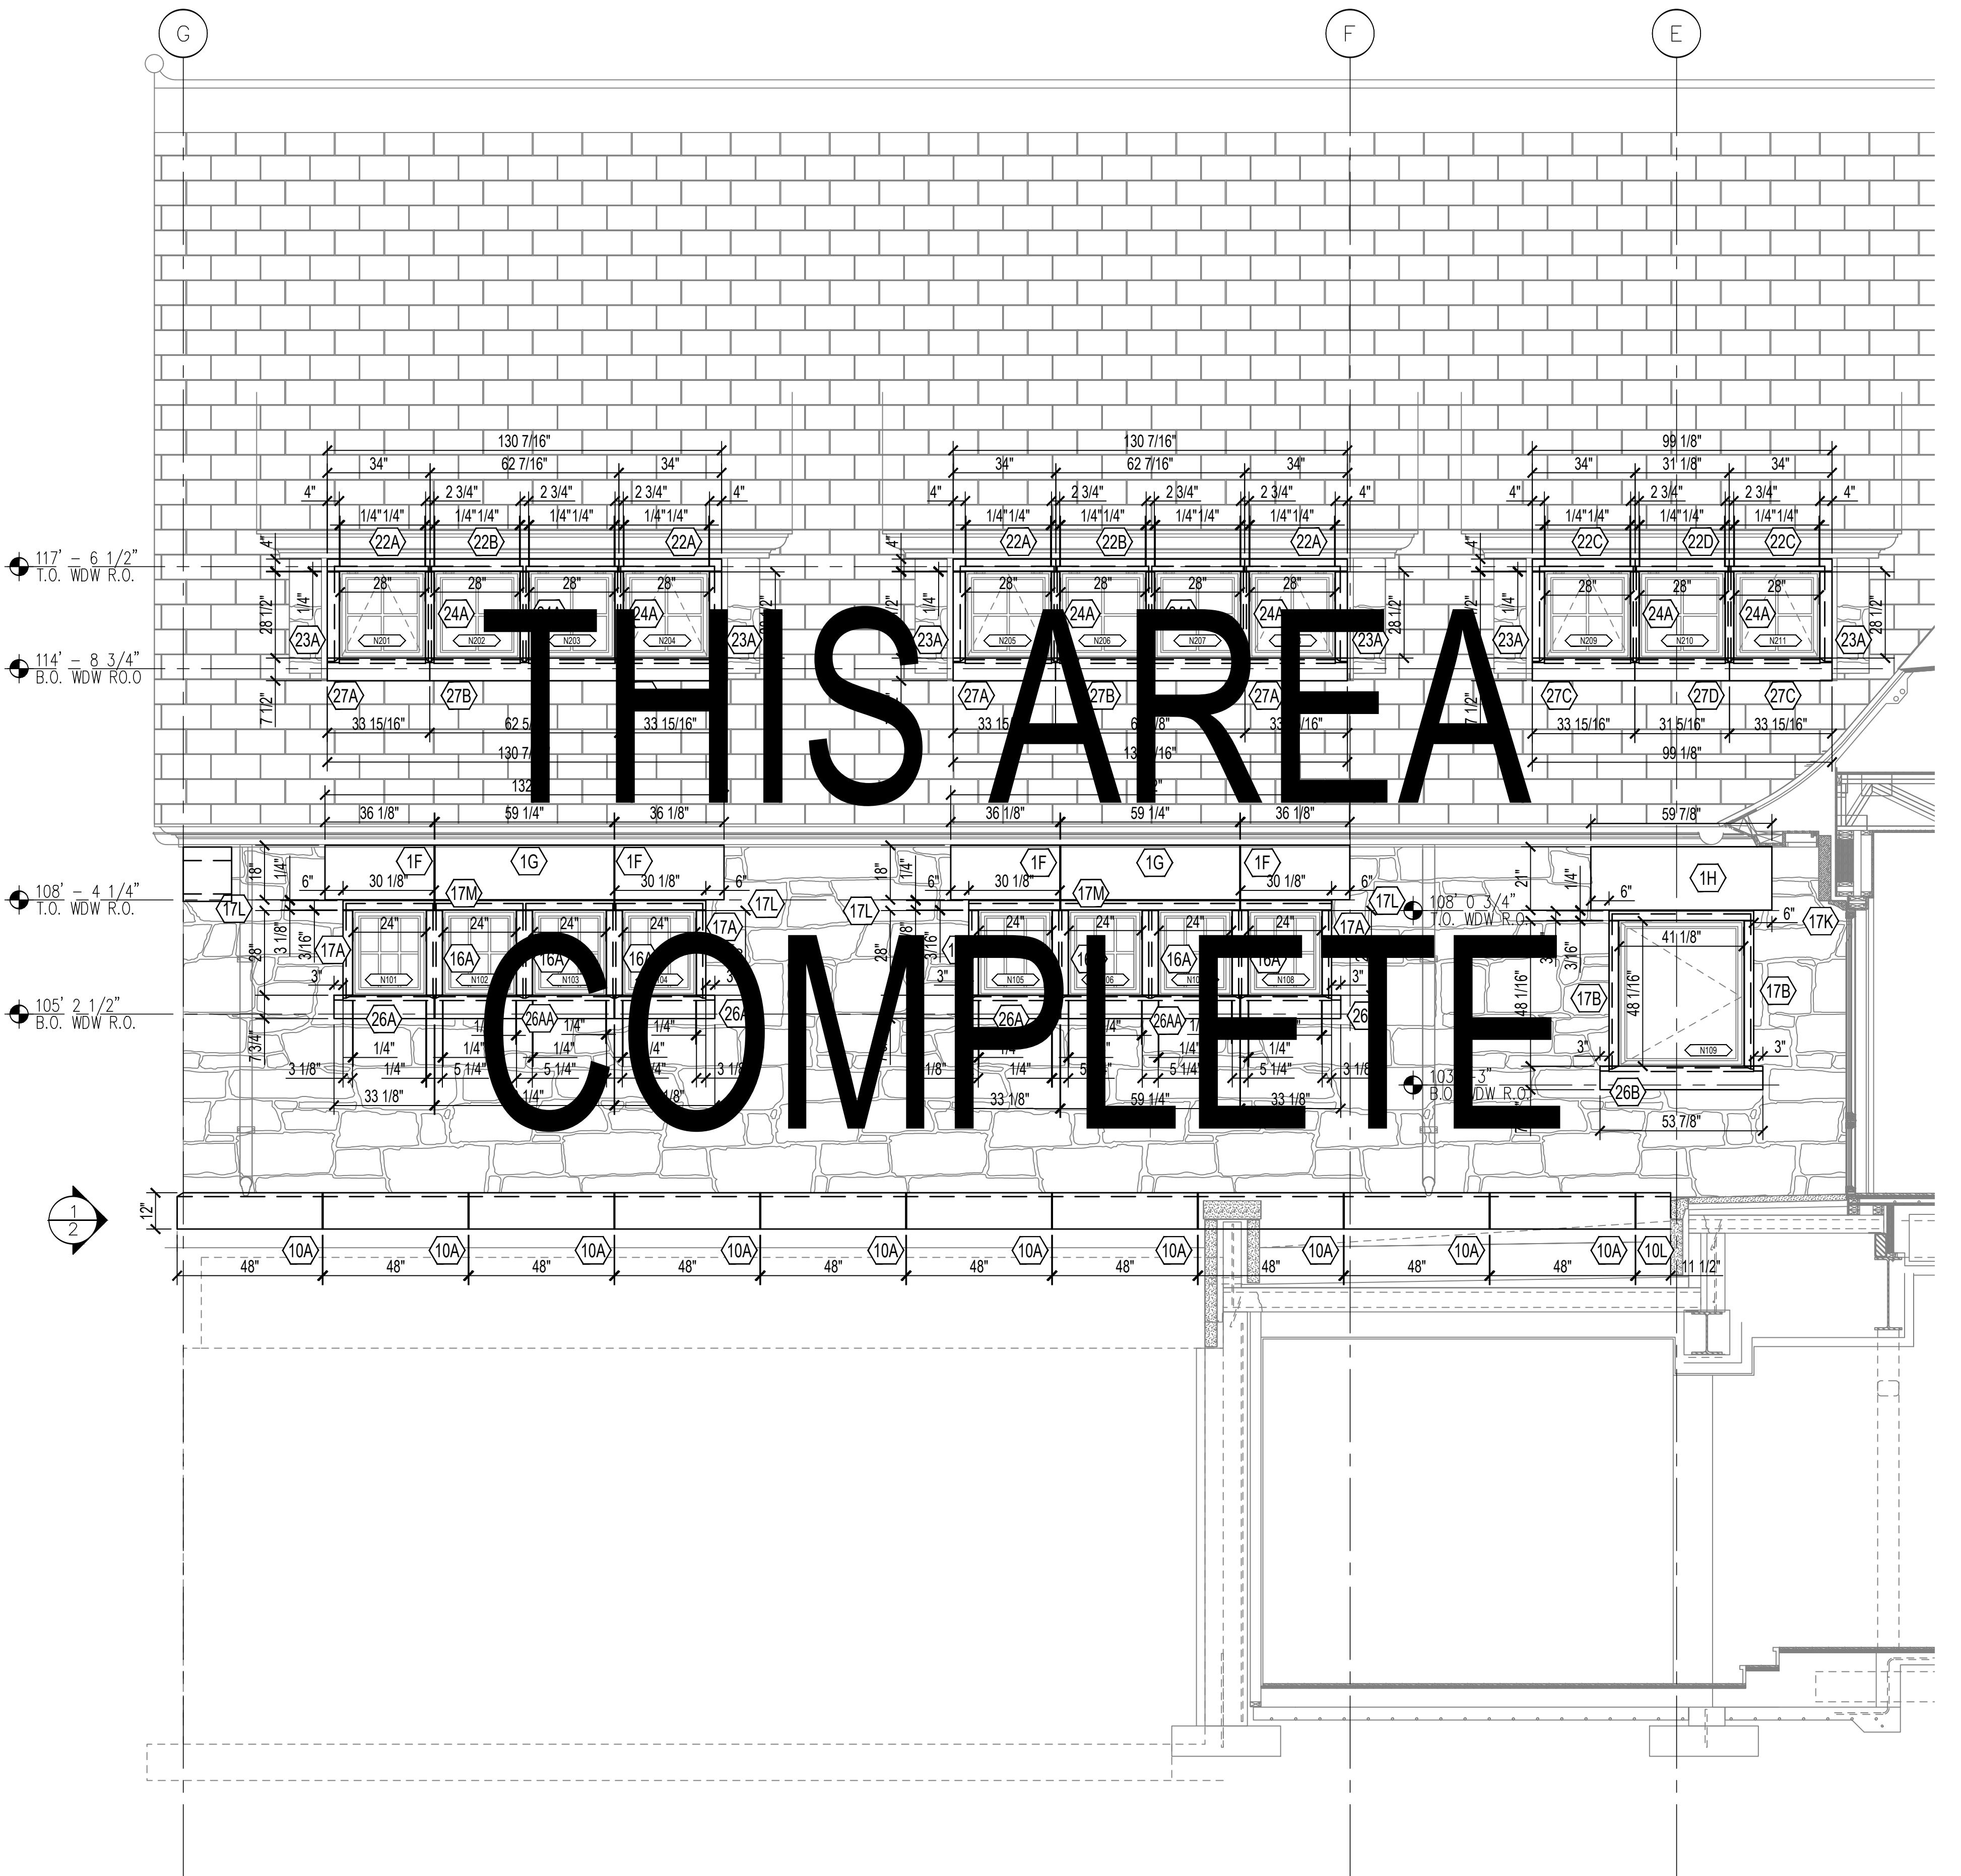

1
11 NORTH GARAGE ELEVATION (1/A2.04)
 $3/8'' = 1'-0''$ 0 1' 2' 3' 4' 5'

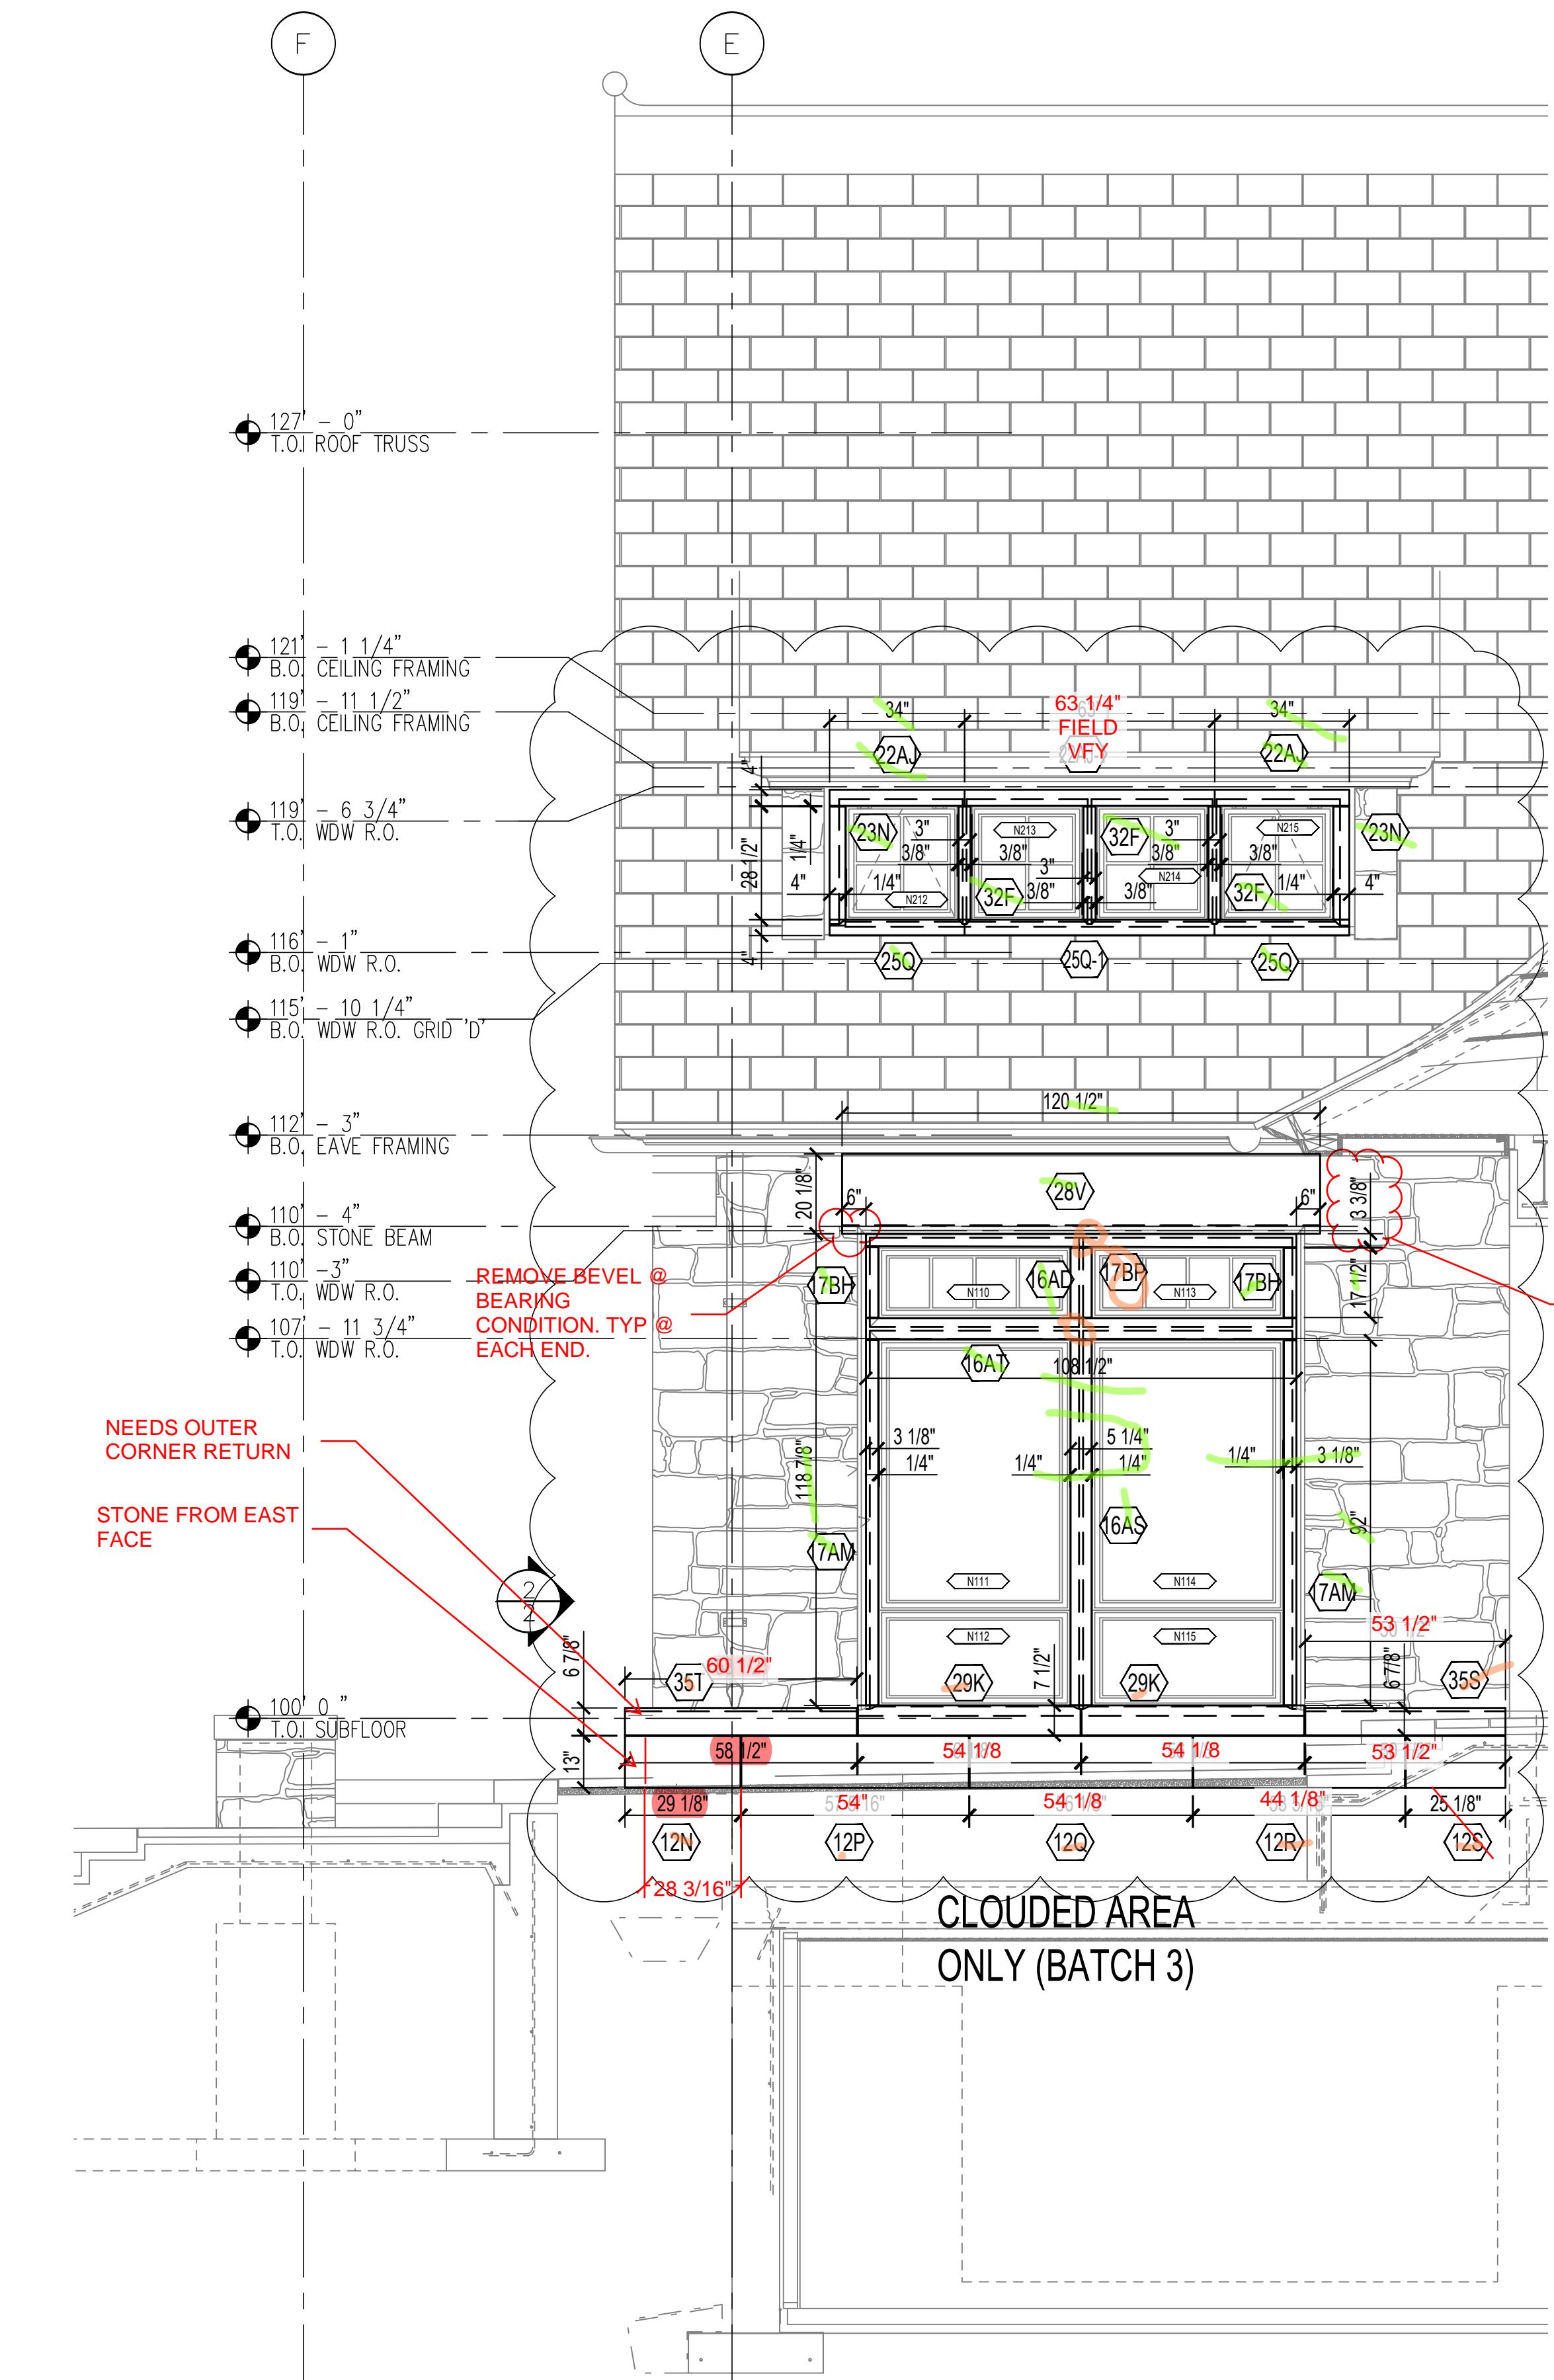


2
11 PARTIAL ENTRY NORTH ELEVATION (2/A2.04)
 $3/8'' = 1'-0''$ 0 1' 2' 3' 4' 5'

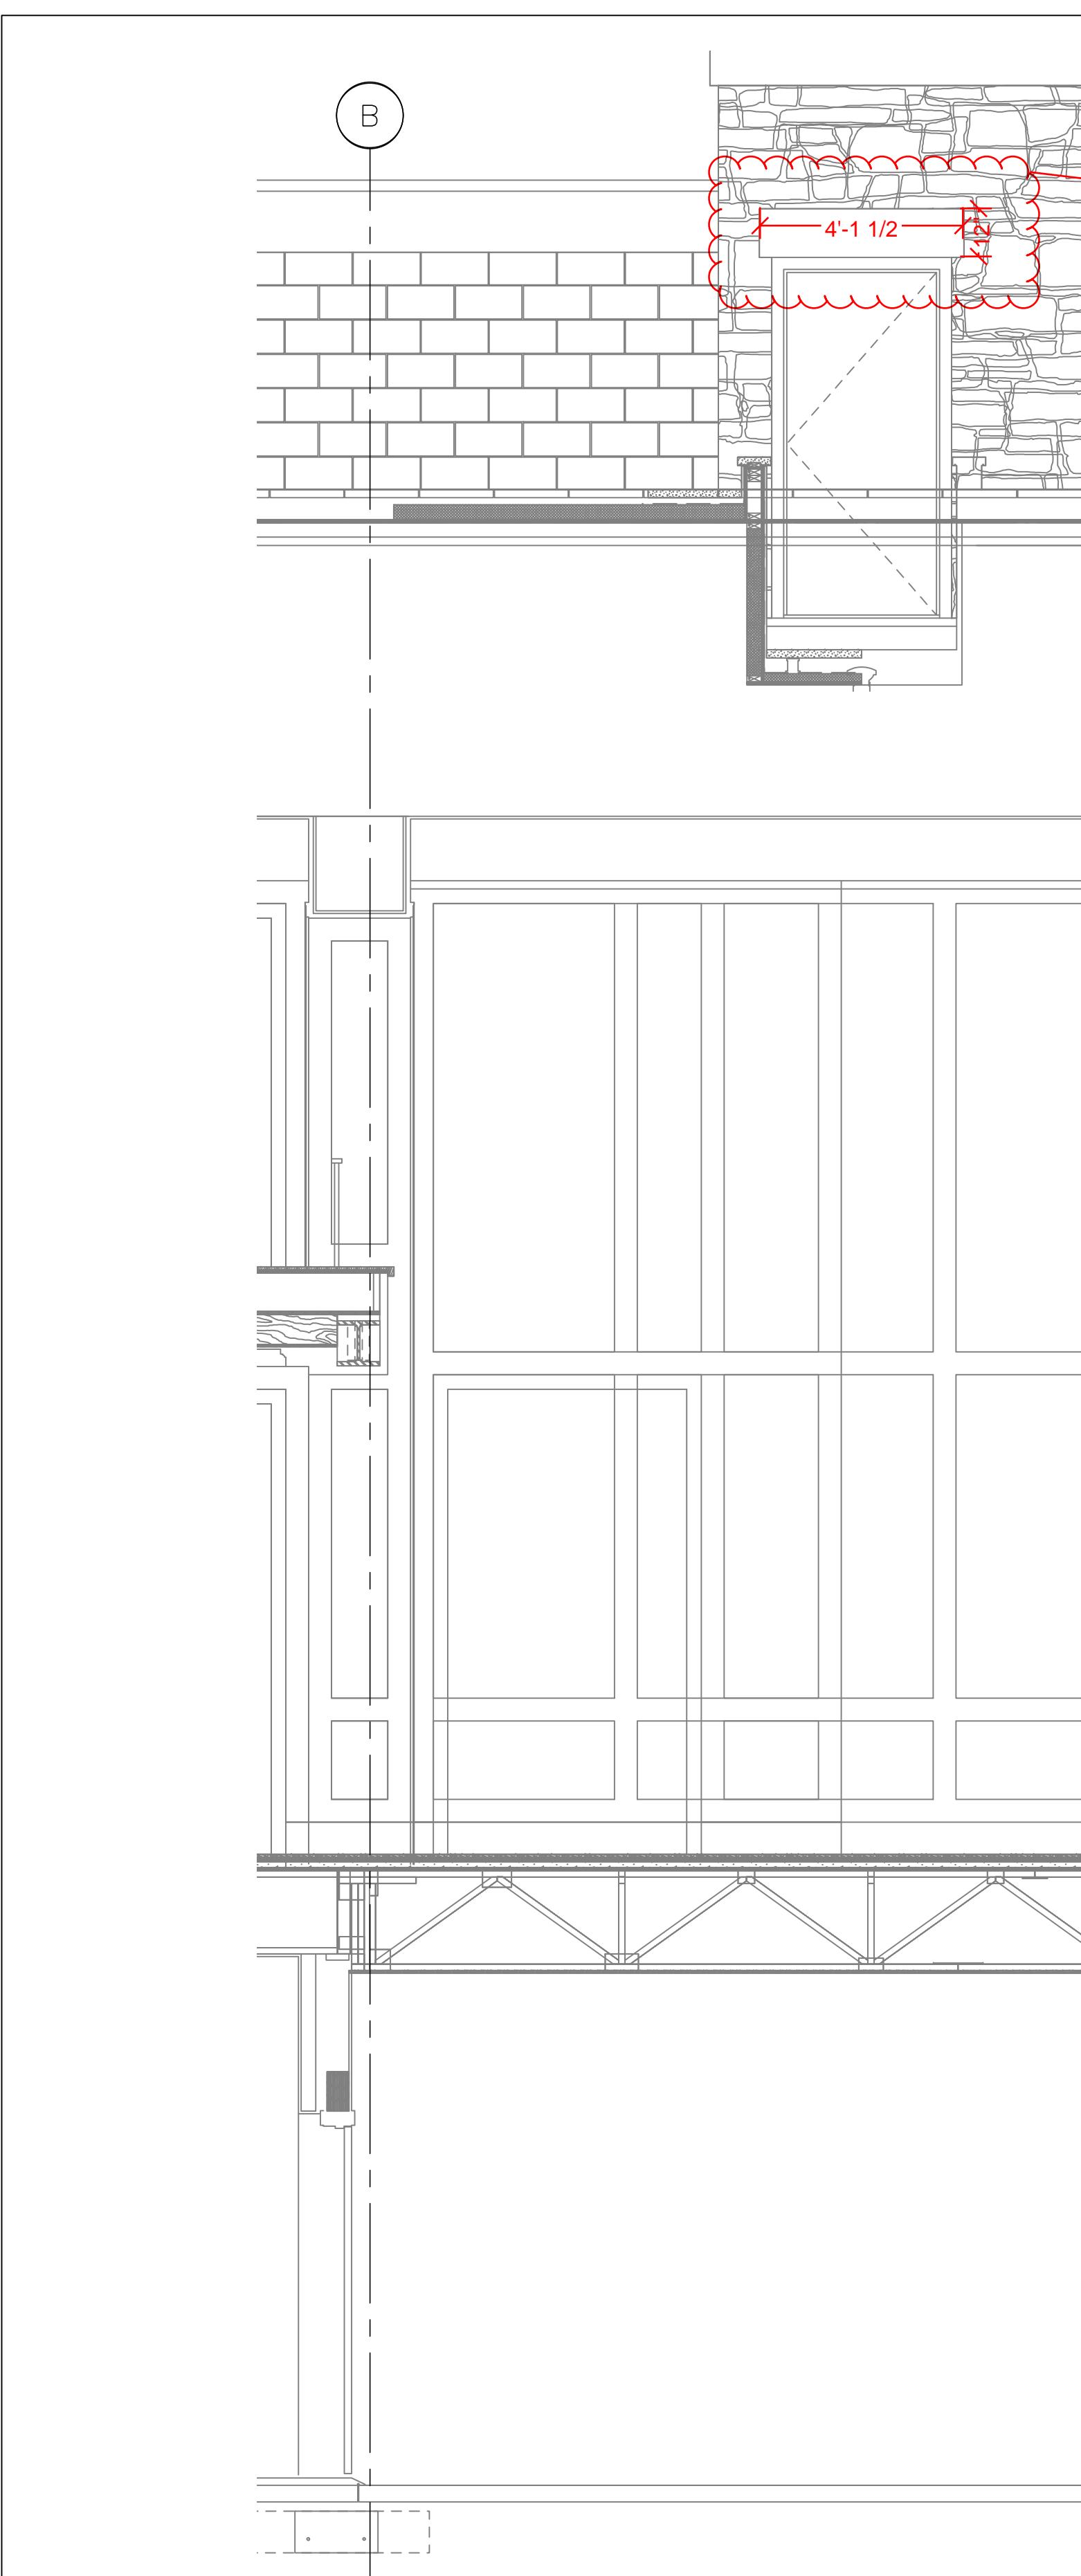

An architectural floor plan featuring a grid of rooms and various structural details like walls, windows, and doors. The entire image is overlaid with large, bold, black text that reads "THIS AREA IS COMPLETE".

2
12 PARTIAL ENTRY NORTH ELEVATION (2/A2.04)
 $3/8'' = 1'-0''$ 1' 2' 3' 4' 5'

PARTIAL ENTRY NORTH ELEVATION (2/A2.04)

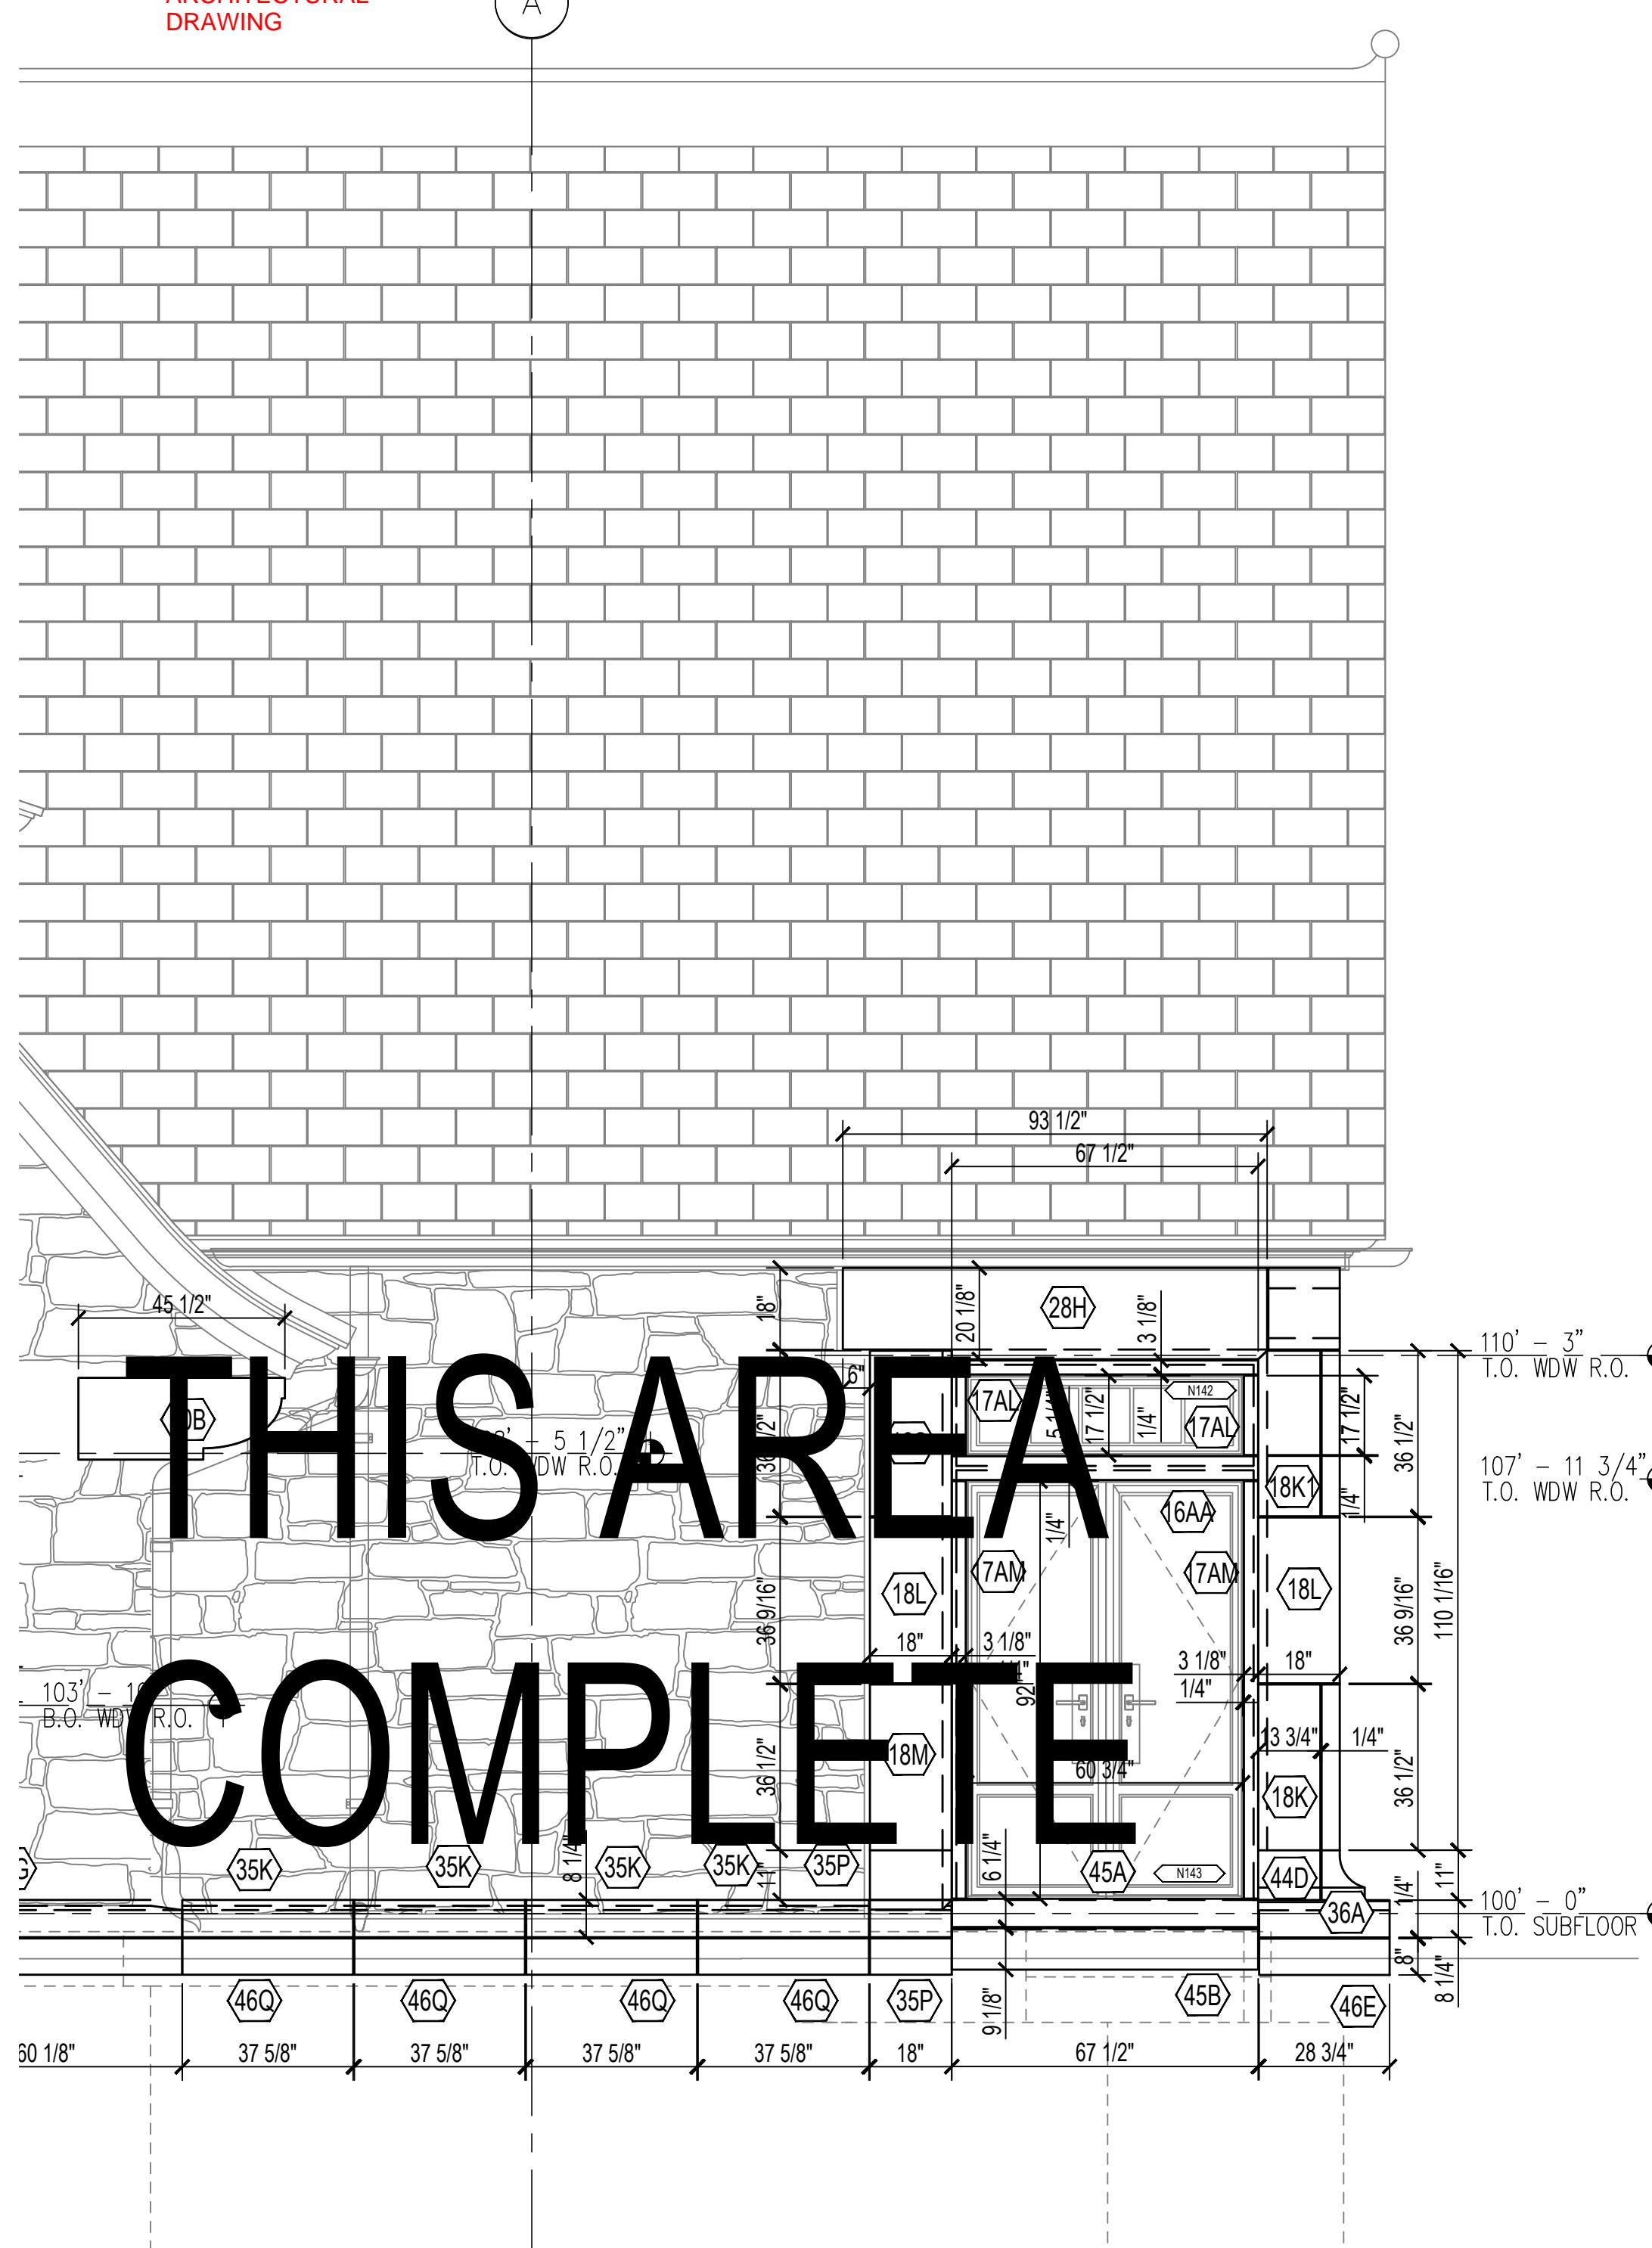


PARTIAL BLDG SECTION @ ENTRY (1/A3.1)

MIRROR OF THIS ELEVATION NOT ACCOUNTED FOR
-SEE ARCHITECTURAL DRAWINGS 2/A2.04 FOR
REFERENCE.

**NOTE: THIS WAS
APPROVED FOR
RUNNING BOND
PATTERN.
OFFSET/CENTER
STONE BELOW CAP**



	KASOTA STONE	KASOTA STONE 820 WILLOW STREET MANKATO MN, 56001 (507) 508-0684			
		Drawing Title: Elevations			
		Project: GALE ROAD			
7/29/20	1-Arch Redlines	Architect: TEA2 ARCHITECTS			
Date	Description	General Contractor: XX			
	Revisions	Drawn By: PDD	Date: 03/10/2021	Scale: 3/8" = 1'-0"	Drawing Number: 12 of 14

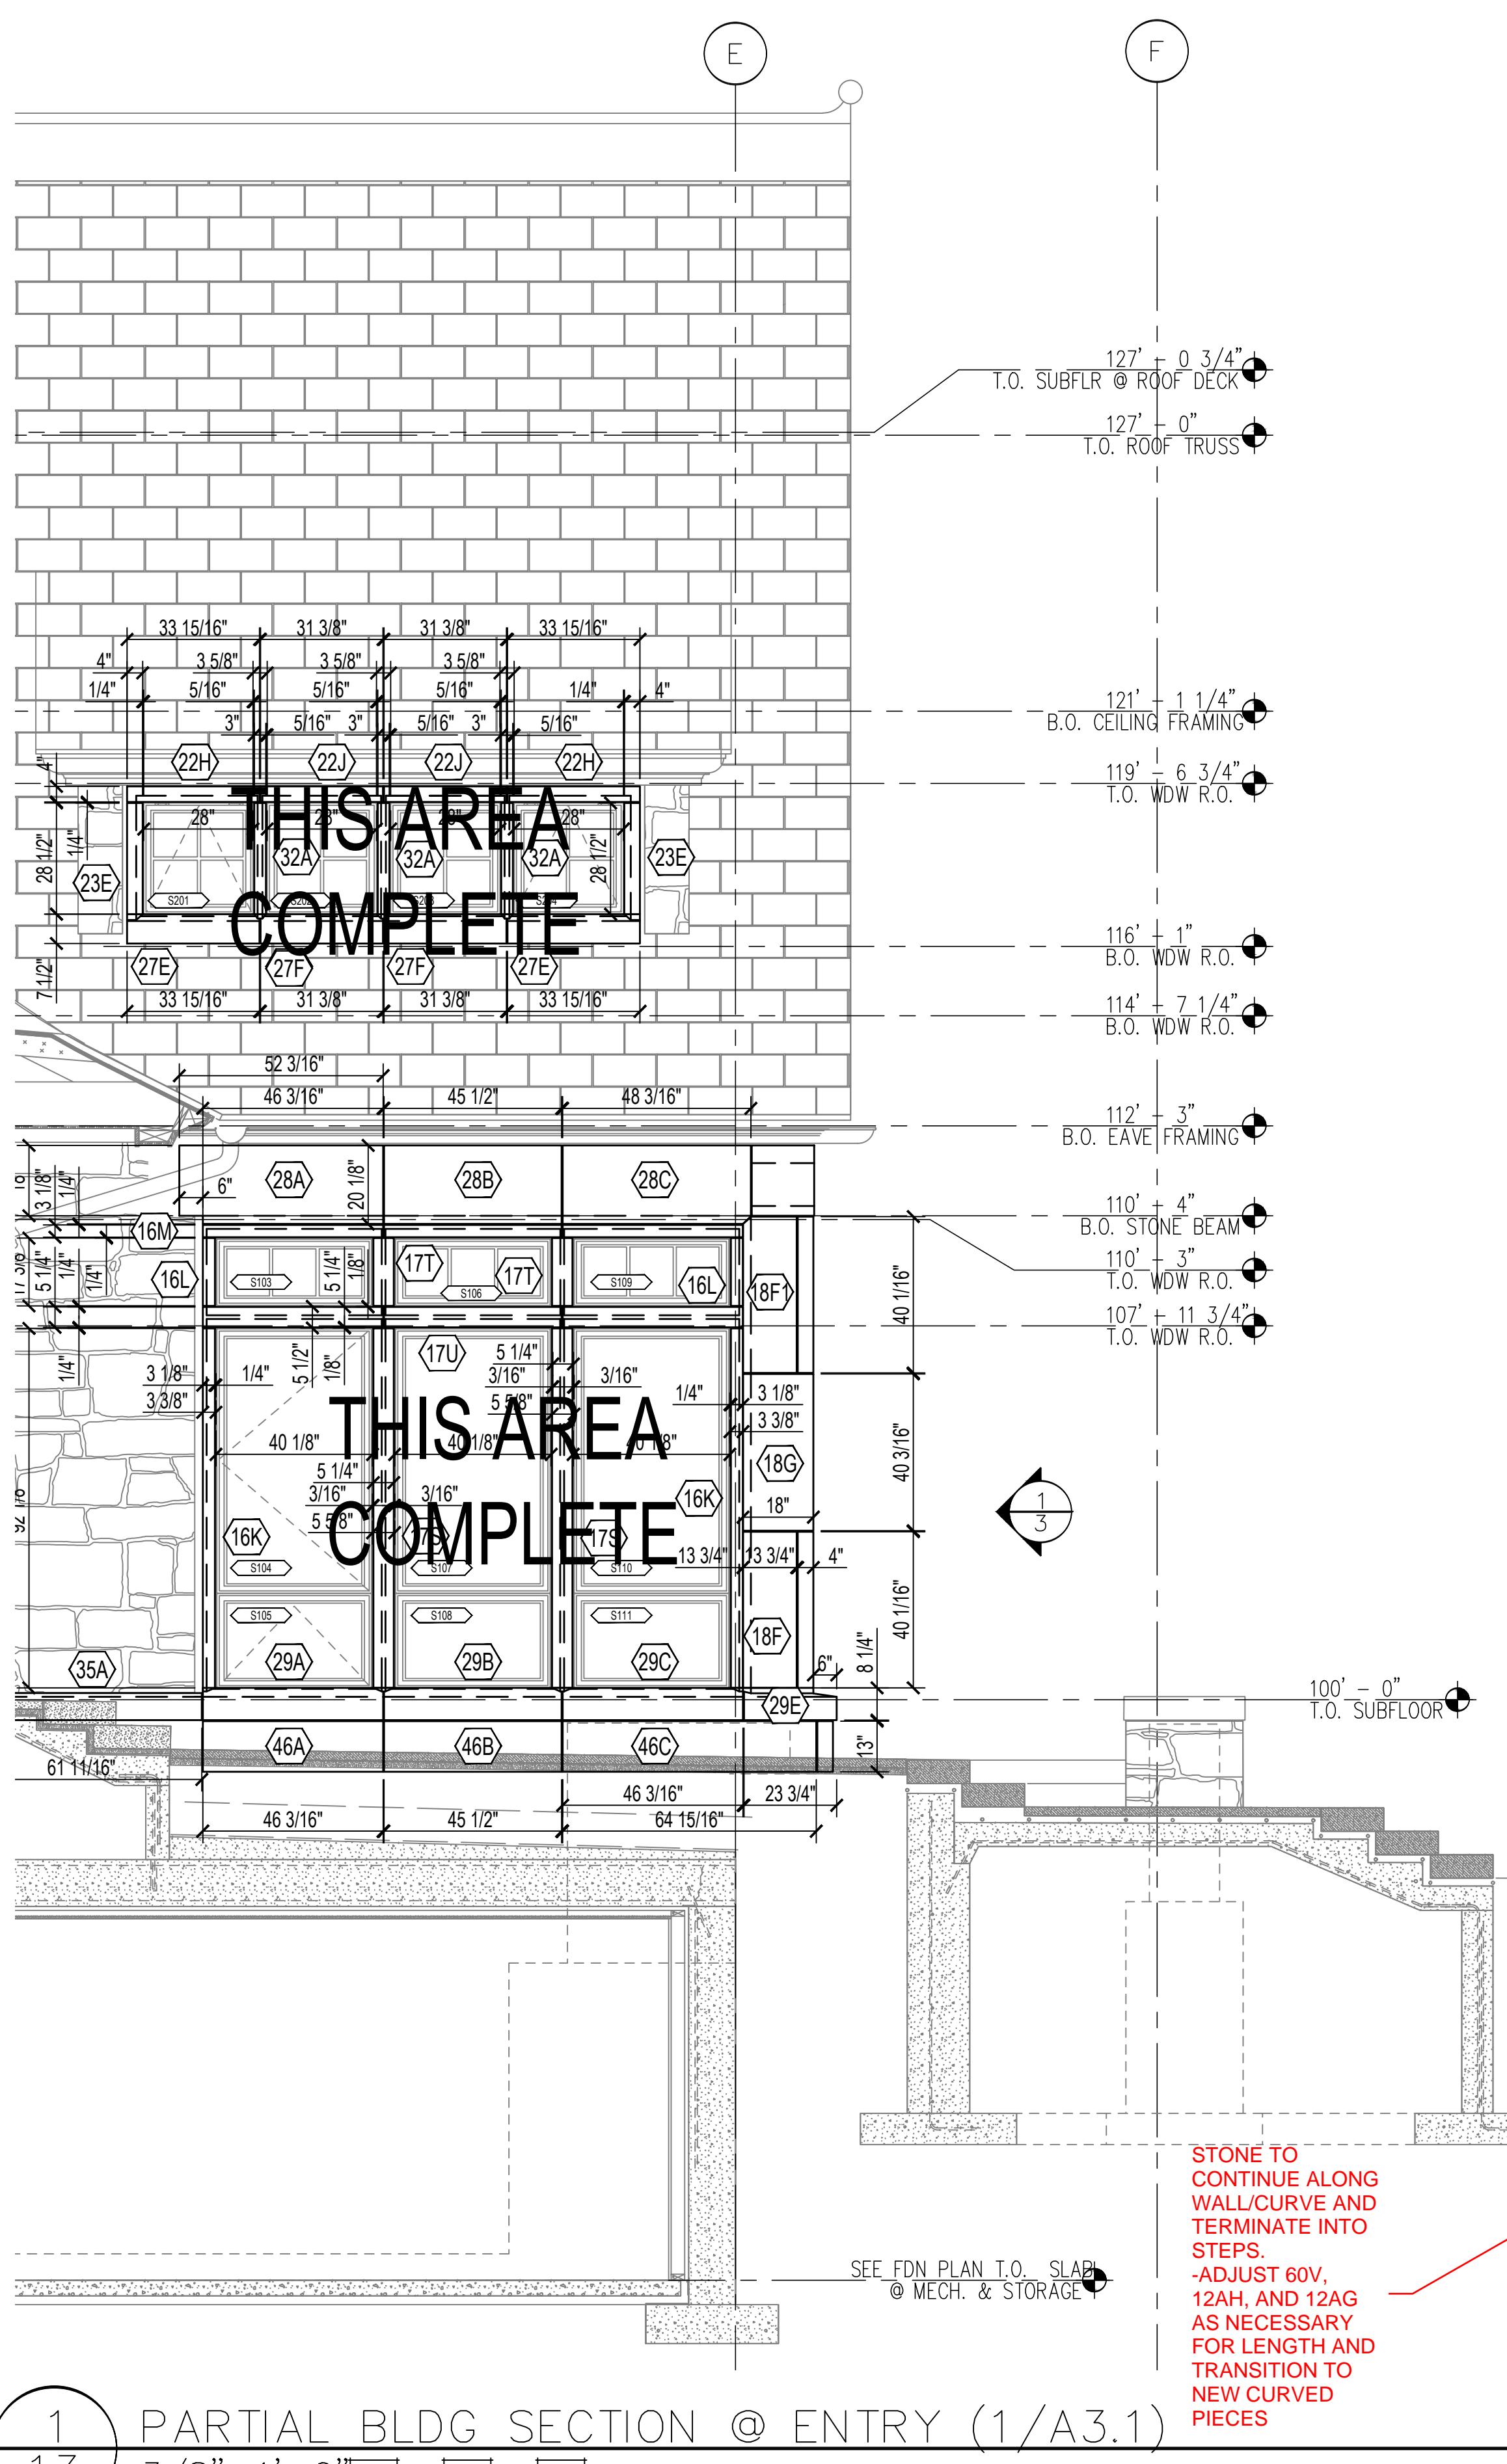

1 PARTIAL BLDG SECTION @ ENTRY (1/A3.1)
13 3/8"-1' 0" H H H

$$13 \quad 3/8'' = 1' - 0''_0 \quad 1' \quad 2' \quad 3' \quad 4' \quad 5'$$

SEE FDN PLAN T.O. SLAB
@ MECH. & STORAGE

2 1/3 PARTIAL BLDG SECTION @ GARAGE LINK (2/A3.1)
3/8" 1' 0" 1' 0" 1' 0"

$$13) \quad 3/8" = 1' - 0''$$

STONE TO H

STONE FROM
AROUND CORN

AROUND CORN

[View all posts](#) | [View all categories](#)

For more information about the study, please contact Dr. John Smith at (555) 123-4567 or via email at john.smith@researchinstitute.org.

www.sciencedirect.com

DATA

7/29

Da

© 2010 by the author; licensee MDPI, Basel, Switzerland. This article is an open access article distributed under the terms and conditions of the Creative Commons Attribution license (<http://creativecommons.org/licenses/by/3.0/>).

1000

KASOTA STONE

820 WILLOW STREET **KASUTA STONE**
MANKATO MN, 56001 (507) 508-0684

Drawing Title: Elevations

Project: GALE ROAD


0 | **1-Arch Redlines** | **Architect:** TEA2 ARCHITECTS

Description	General Contractor: XX
-------------	------------------------

Revisions	Drawn By: PDD	Date: 03/10/2021	Scale: 3/8" = 1'-0"	Drawing Number: 13 of 14
------------------	------------------	---------------------	------------------------	-----------------------------

TBD 08/16/2021 0:00 AM 100%



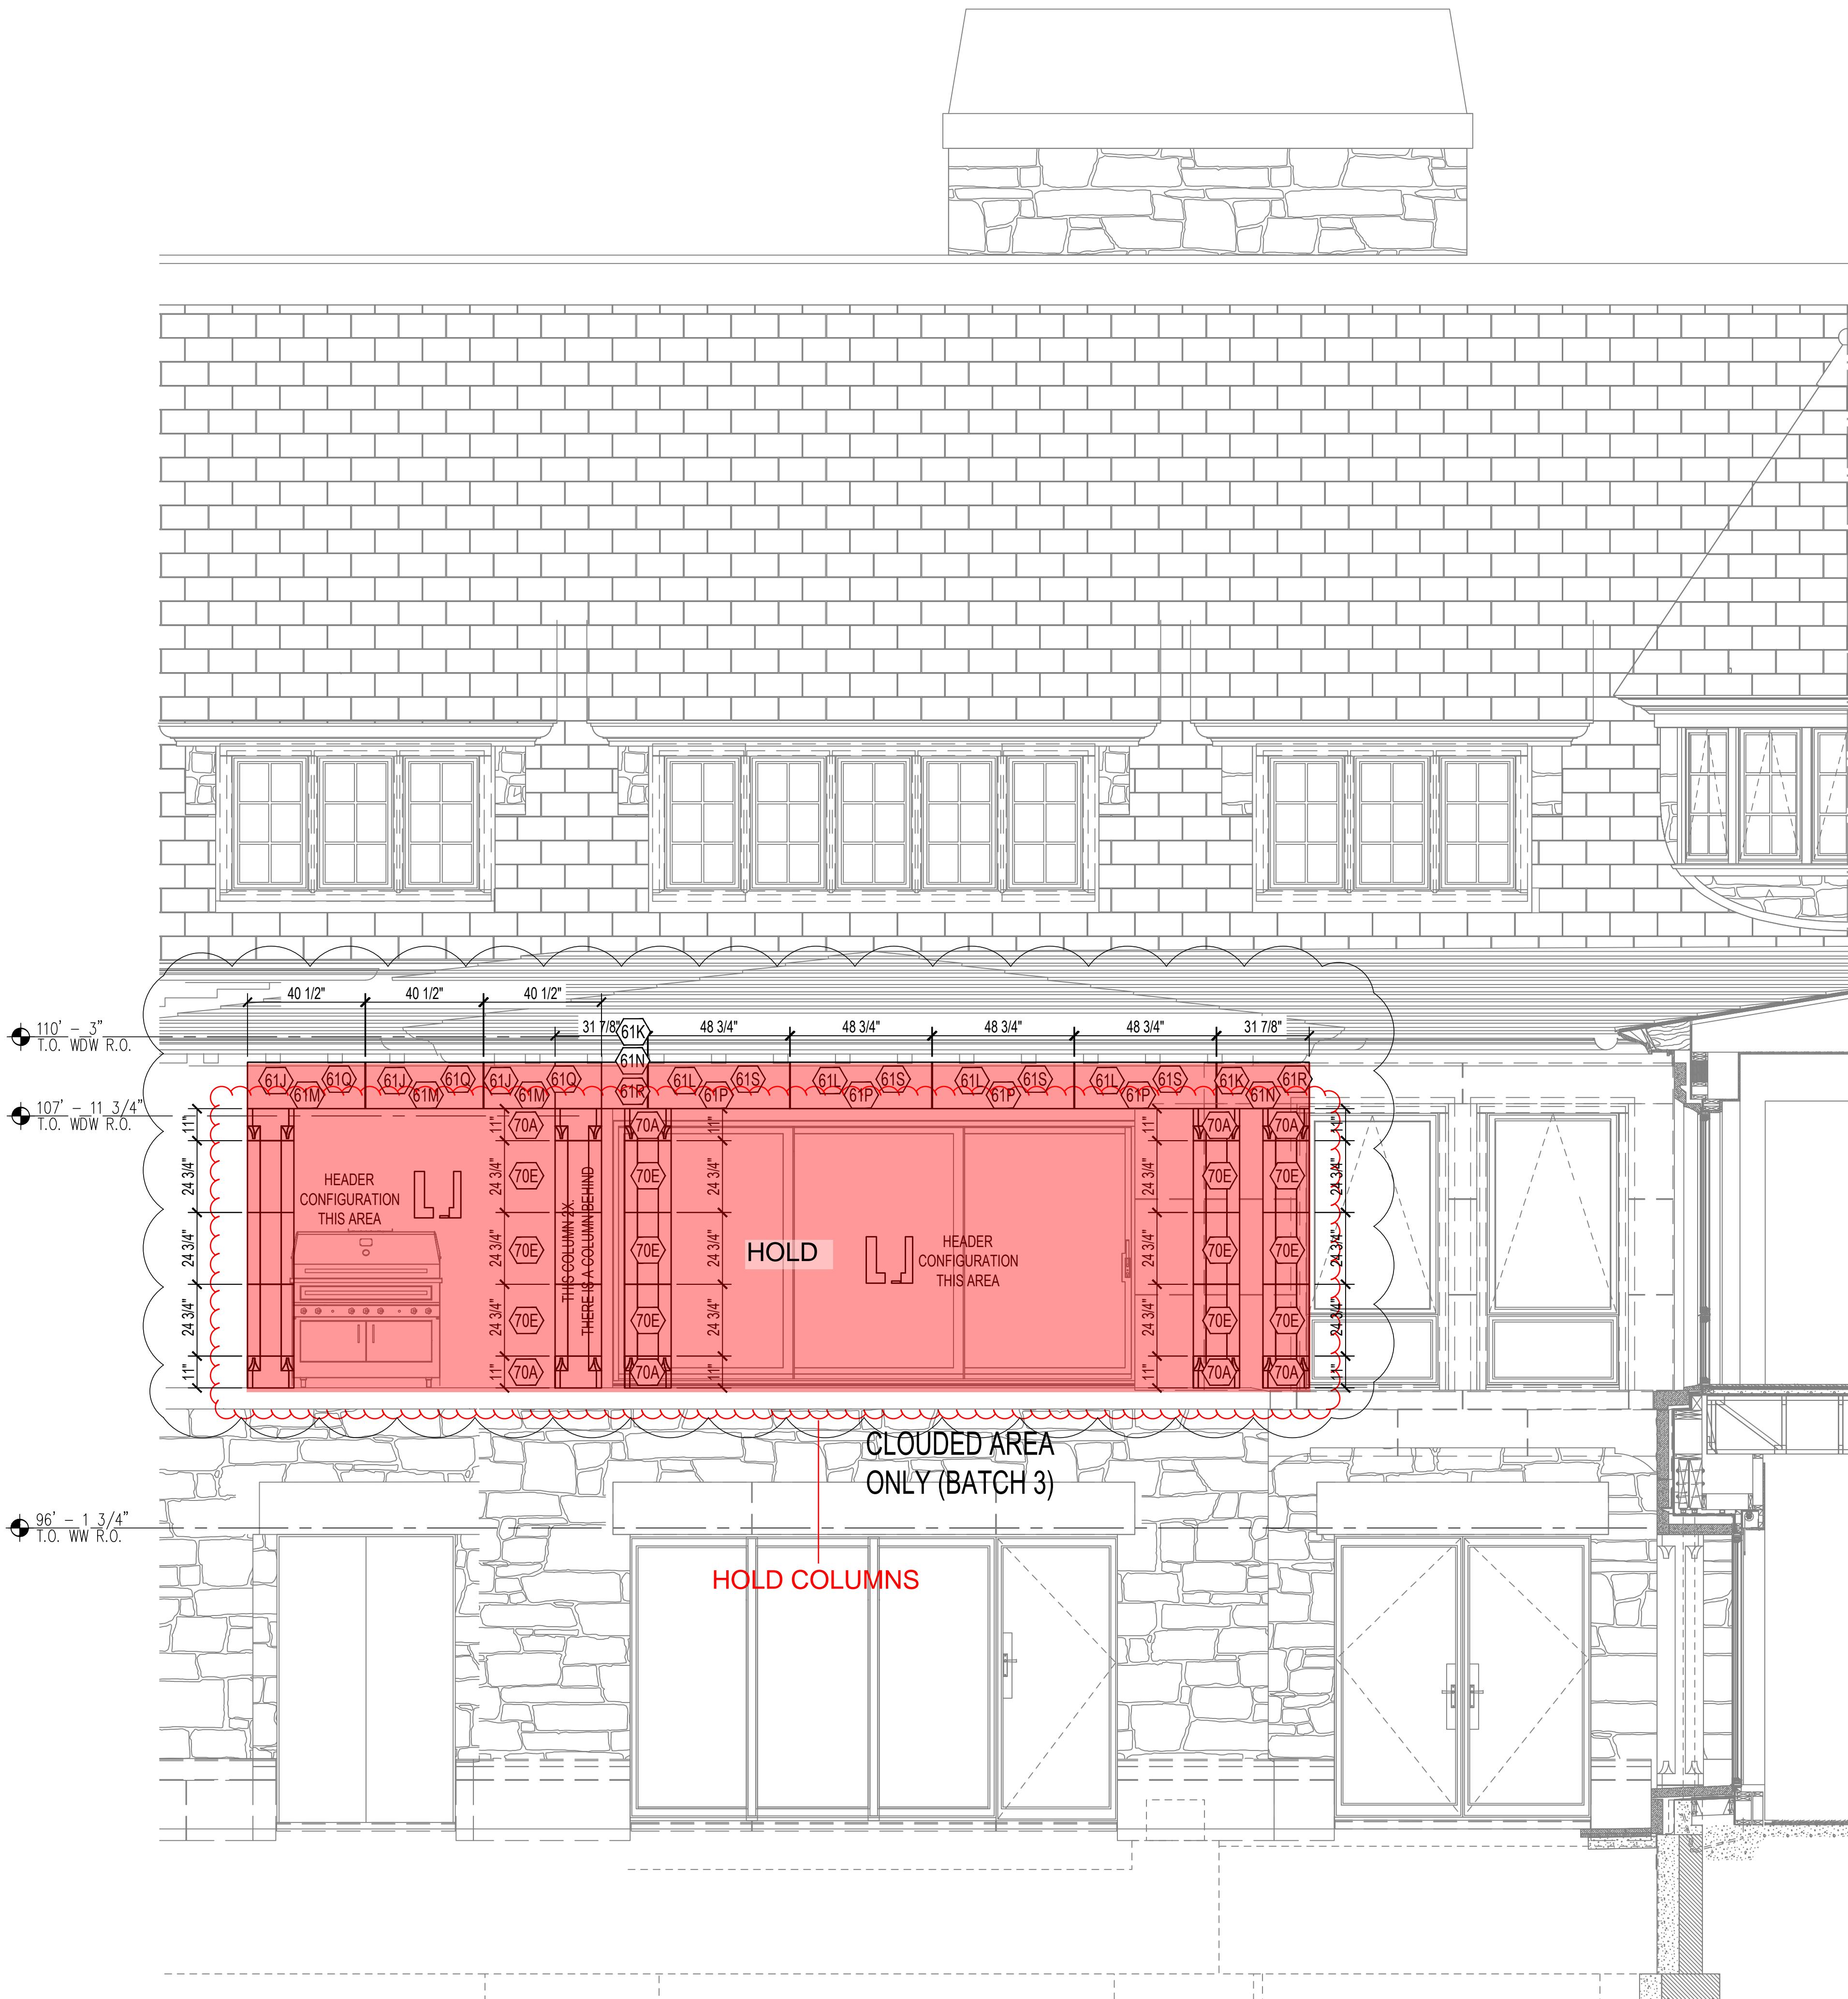


A circle containing the number 2 above a horizontal line, and the numbers 13 and A below it.

PARTIAL BLDG SECTION @ GARAGE LINK (2/A3.1)(HEADERS AND COLUMNS)




	KASOTA STONE	KASOTA STONE 820 WILLOW STREET MANKATO MN, 56001 (507) 508-0684			
		Drawing Title: Elevations			
		Project: GALE ROAD			
Date	Description	Architect: TEA2 ARCHITECTS			
7/29/20	1-Arch Redlines	General Contractor: XX			
Revisions		Drawn By: PDD	Date: 03/10/2021	Scale: 3/8" = 1'-0"	Drawing Number: 13a of 14

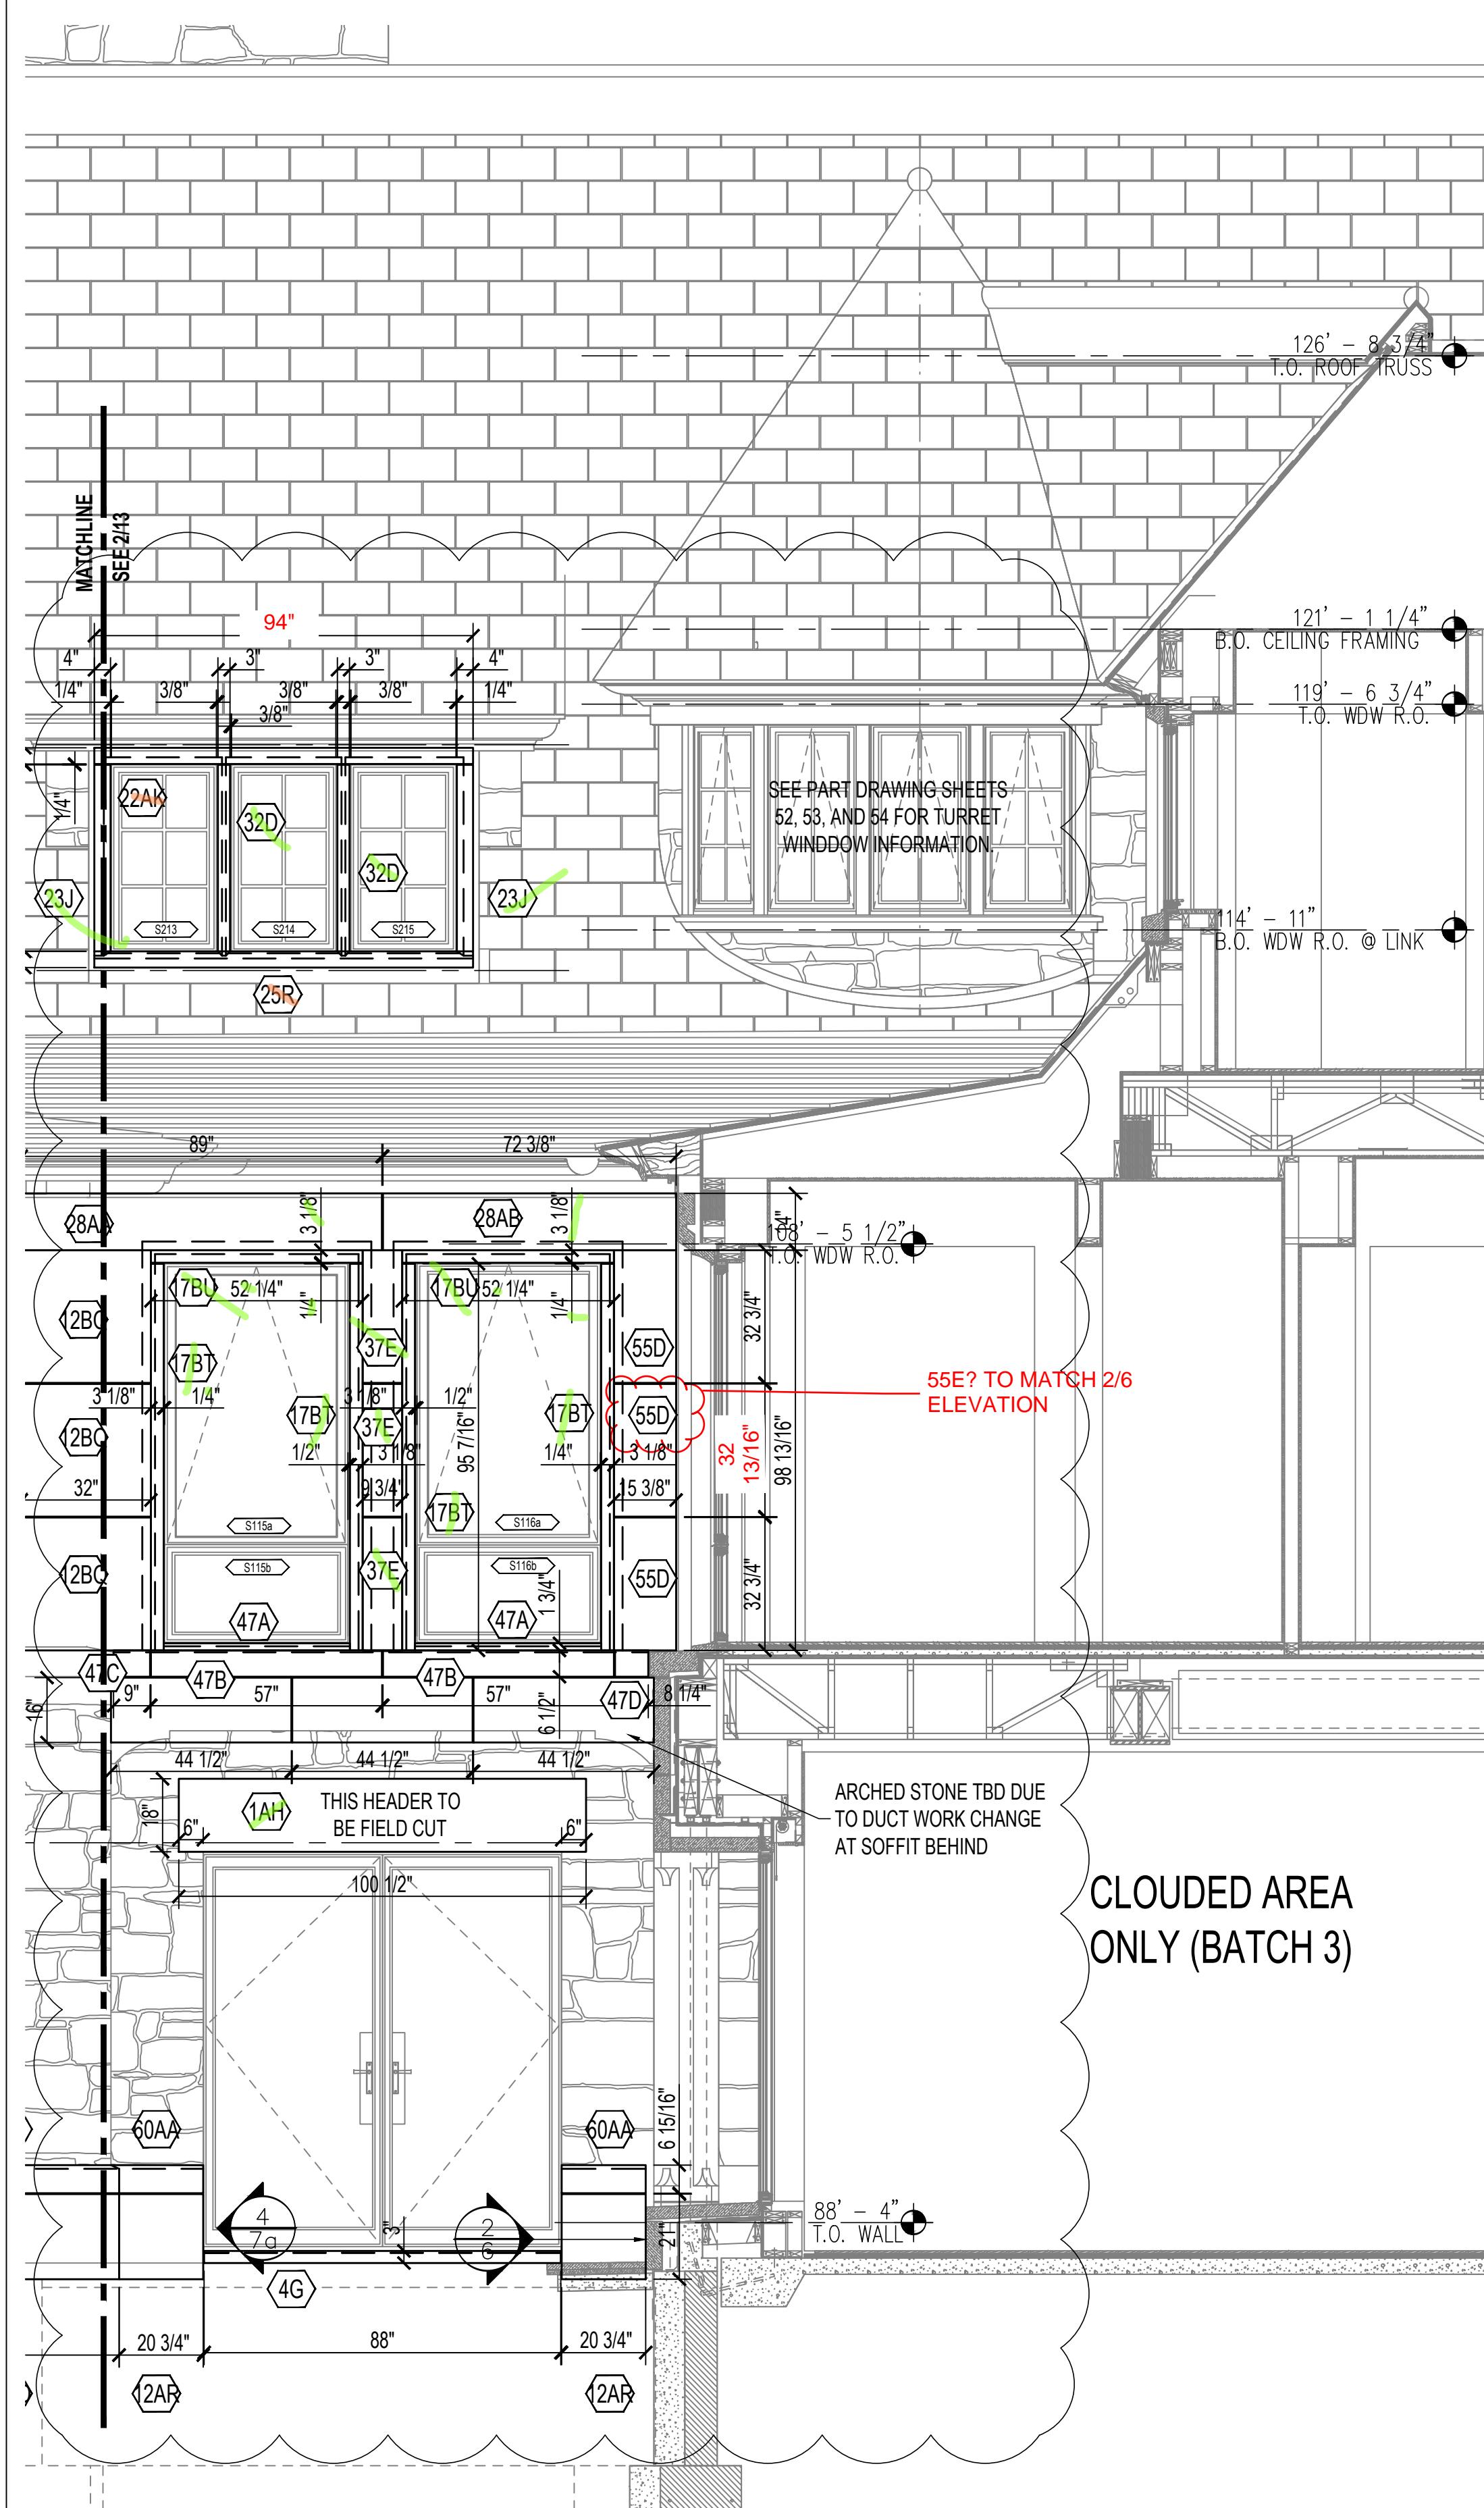

2
14

PARTIAL BLDG SECTION @ GARAGE LINK (2/A3.1)

$3/8'' = 1'-0''$

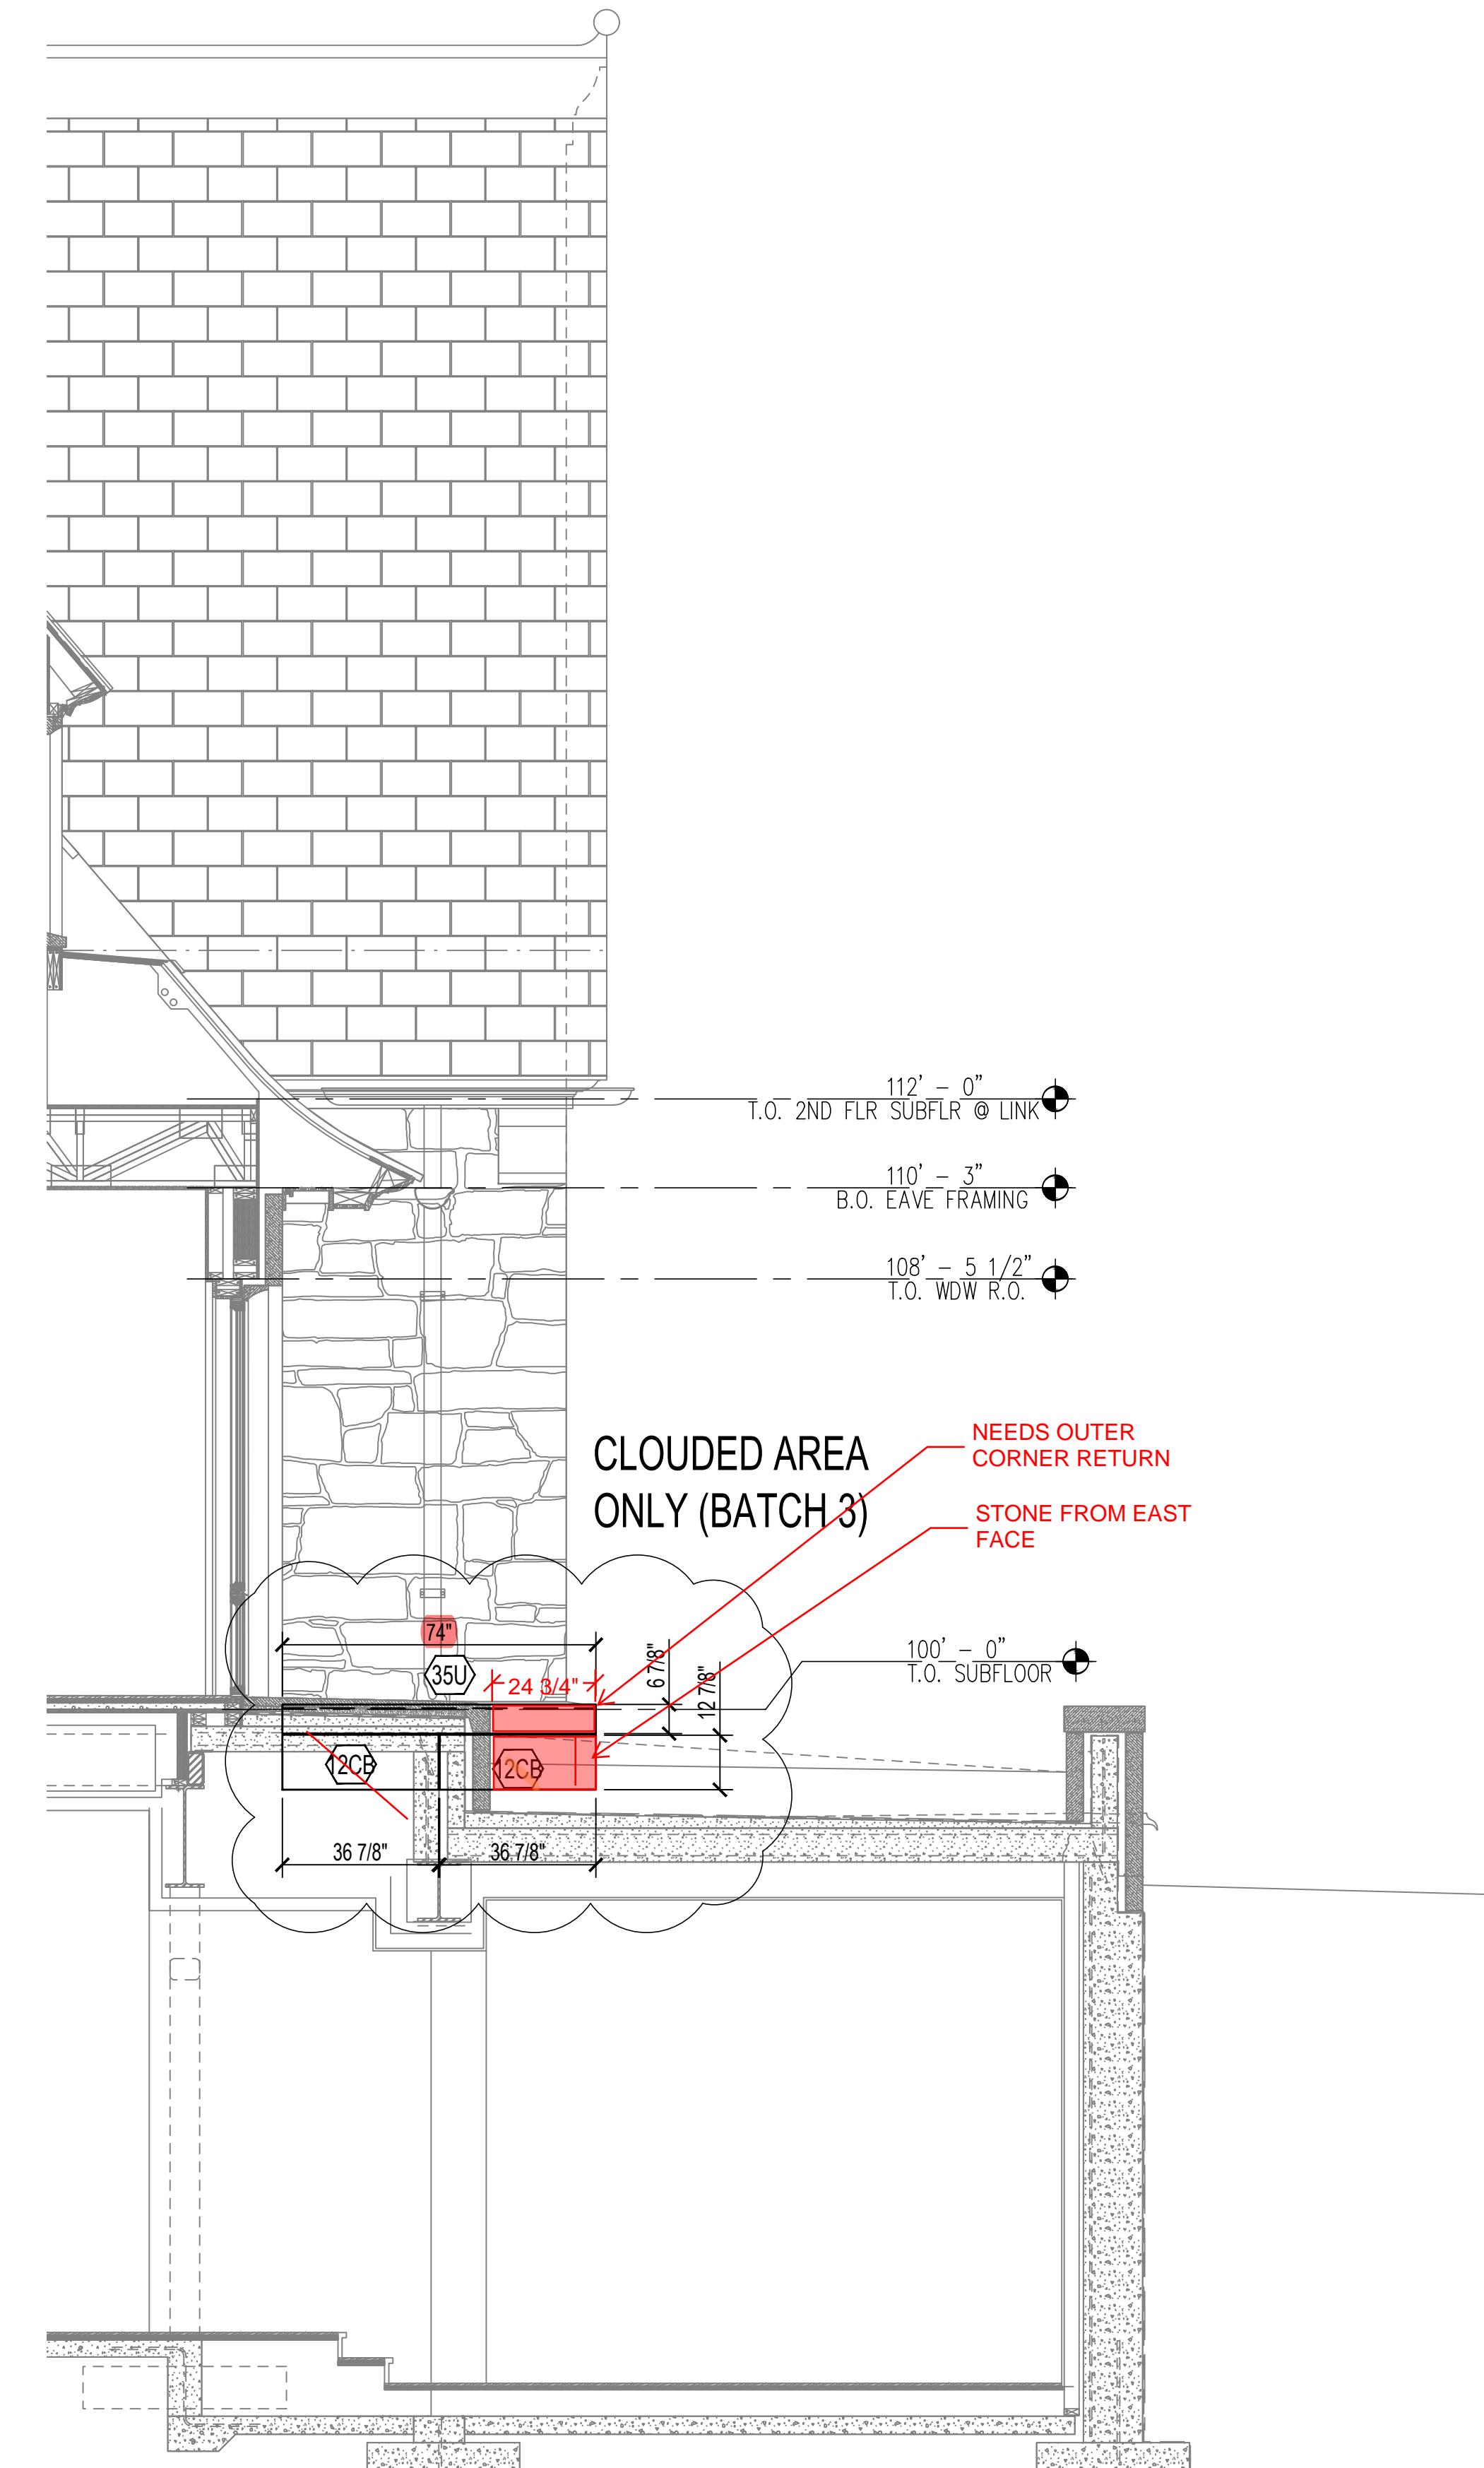

		KASOTA STONE	
		820 WILLOW STREET MANKATO MN, 56001 (507) 508-0684	
Drawing Title:	Elevations		
Project:	GALE ROAD		
Architect:	TEA2 ARCHITECTS		
Date	Description		
Revisions			
Drawn By: PDD	Date: 03/10/2021	Scale: $3/8'' = 1'-0''$	Drawing Number: 14 of 14



820 WILLOW STREET
MANKATO MN, 56001
507-508-0684

PAGE

JOB #: _____

DATE: 03/10/2021

SOLD TO:

STOCK: LIMESTONE

JOB NAME: GALE ROAD

FINISH: HONED

LOCATION: WOODLAND, MN

PRIMER: HIREED

SECTION: WOODWARD, MN

SECTION OR DETAIL DRAWING:

SECTION OR DETAIL DRAWING: _____





820 WILLOW STREET
MANKATO MN, 56001
507-508-0684

PAGE 1

JOB #: _____
SOLD TO: _____
JOB NAME: GALE ROAD
LOCATION: WOODLAND, MN
SECTION OR DETAIL DRAWING: 2/A4.1

DATE: 03/10/2021
STOCK: LIMESTONE
FINISH: HONED

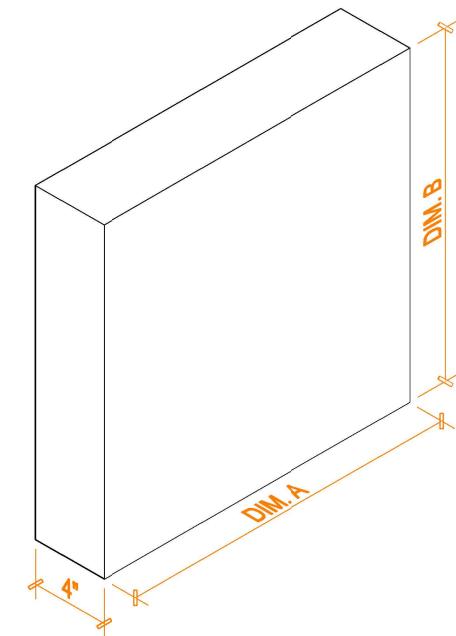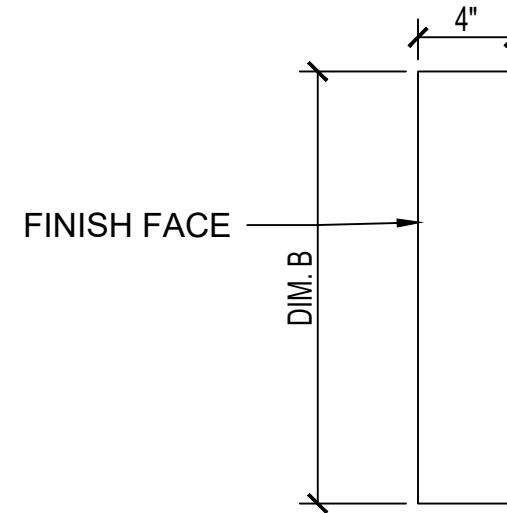

PART DESCRIPTION	DIM. A.	WIDE	DIM. B.	QTY	CUBIC FT	ARCH. SHEET	WDW / DR #	ROOM #	GRID LINE(S)	KEY #
HEADER - TYPE 2A	126 1/4"	4"	18"	1	5.26	1/2.01	E227-231	212	5-6	1AA
HEADER - TYPE 2A	70 1/4"	4"	18"	2	5.29	1/2.02	E104a, e109a	106, 109	4-5	1AB
HEADER - TYPE 2A	40 1/2"	4"	18"	3	4.77	1/2.02	E106a-E107a	108	4-5	1AC
HEADER - TYPE 2A	83 3/4"	4"	18"	1	3.49	2/2.03	S005	102	B-C	1AE
HEADER - TYPE 2A	83 7/8"	4"	18"	1	3.49	2/3.1	S002	018		1AF
HEADER - TYPE 2A	47 3/4"	4"	18"	2	3.98	2/3.1	S002	018		1AG
HEADER - TYPE 2A	100 1/2"	4"	18"	1	4.19	2/3.1	S00:	THIN VENEER WALL WITH RETURN TO DOOR -CUT AS REQUIRED		



820 WILLOW STREET
MANKATO MN, 56001
507-508-0684

PAGE 1a

JOB #:

DATE: 03/10/2021

SOLD TO:

STOCK· LIMESTONE

JOB NAME: GALE ROAD

STOCK: LIMESTONE

SECTION OR DETAIL DRAWING: 2/A1.1: 1/A1.10: 2/A1.10: 1/A6.4

a, l/A0.5, t/A0.5

PART DESCRIPTION	DIM A	WIRE	DIM B	CTV	CUP
------------------	-------	------	-------	-----	-----

CON'T FROM PAGE 1



820 WILLOW STREET
MANKATO MN, 56001
507-508-0684

PAGE 2

JOB #: _____

DATE: 03/10/2021

SOLD TO: _____

STOCK: LIMESTONE


JOB NAME: GALE ROAD

FINISH: HONED

LOCATION: WOODLAND, MN

SECTION OR DETAIL DRAWING: 2/A4.1

PART DESCRIPTION	DIM. A	DIM. B	DIM. C	QTY	CUBIC FT	ARCH. SHEET	WDW / DR #	ROOM #	GRID LINE(S)	KEY #
SOFFIT STONE	126 1/4"	10 1/2"	2 3/4"	1	2.11	1/2.01	E227-231	212	5-7	2B
SOFFIT STONE	83 3/4"	17 3/4"	3 1/2"	1	3.01	2/2.03	S005	102	B-C	2C
SOFFIT STONE	83 3/4"	11 3/4"	3 1/2"	1	1.99	2/2.03	S005	102	B-C	2D
SOFFIT STONE	47 3/4"	22 1/8"	3 1/2"	2	4.93	2/3.1	S002	018		2E
SOFFIT STONE	83 7/8"	22 1/8"	3 1/2"	1	4.33	2/3.1	S002	018		2F
SOFFIT STONE	94"	7 1/2"	2"	2	1.63	1/2.01		119a	6-7	2G
SOFFIT STONE	90 1/4"	7 1/2"	2"	6	4.70	1/2.01, 2/2.01		119a, 117	6-7, 7-6	2H
SOFFIT STONE	106"	7 1/2"	4"	2	3.68	2/2.01		117	7-6	2J
SOFFIT STONE	52 7/8"	21 1/2"	4"	2	5.26	2/2.02	W001, W003	006	5-4	2K
SOFFIT STONE	106 1/2"	21 1/2"	4"	1	5.3	2/2.02	W002	006	5-4	2L
SOFFIT STONE	88"	7 1/2"	3 1/2"	1	1.18	2/3.1	S001	024		2M
SOFFIT STONE	98 1/2"	11 3/4"	3 1/2"	3	15.07	2/2.02	W005-007	006	4-3	2N
SOFFIT STONE	98 1/2"	17 3/4"	3 1/2"	3	22.76	2/2.02	W005-007	006	4-3	2P

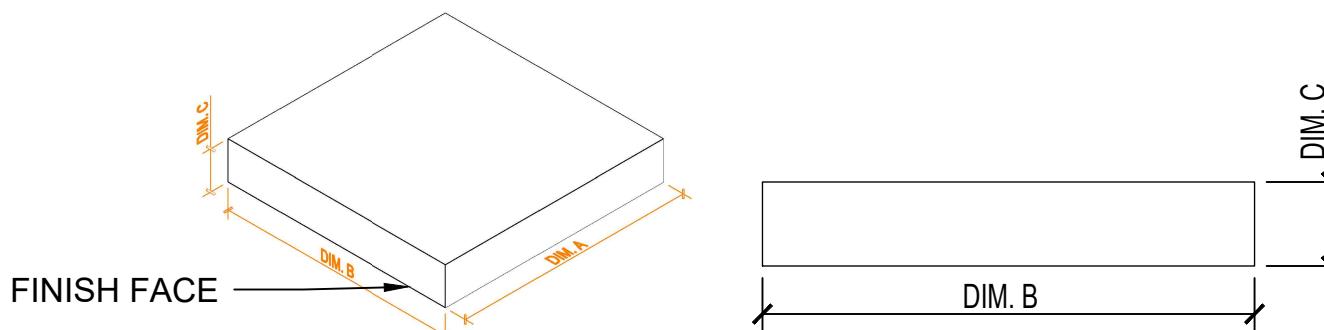



820 WILLOW STREET
MANKATO MN, 56001
507-508-0684

PAGE 2-1

JOB #: _____

DATE: 03/10/2021

SOLD TO: _____

STOCK: LIMESTONE

JOB NAME: GALE ROAD

FINISH: HONED

LOCATION: WOODLAND, MN

SECTION OR DETAIL DRAWING: 2/A4.1

PART DESCRIPTION	DIM. A	DIM. B	DIM. C	QTY	CUBIC FT	ARCH. SHEET	WDW / DR #	ROOM #	GRID LINE(S)	KEY #
SOFFIT STONE	49 3/8"	7 1/2"	3 1/2"	1	.75	2/2.02	FIREPLACE	SC. PORCH	5-4	2Q
SOFFIT STONE	39 1/2"	7 1/2"	3 1/2"	1	.60	2/2.02	FIREPLACE	SC. PORCH	5-4	2R
SOFFIT STONE	50 3/8"	7 1/2"	3 1/2"	1	.77	2/2.02	FIREPLACE	SC. PORCH	5-4	2S
SOFFIT STONE	47 3/4"	25 1/2"	3 1/2"	2	4.93	2/3.1	S002	018		2E
SOFFIT STONE	83 7/8"	25 1/2"	3 1/2"	1	4.33	2/3.1	S002	018		2F
SOFFIT STONE	89 1/2"	7 1/2"	4"	2	3.10	1/2.01		119a	6-7	2G
SOFFIT STONE	90 1/4"	7 1/2"	4"	6	9.4	1/2.01, 2/2.01		119a, 117	6-7, 7-6	2H
SOFFIT STONE	102 1/8"	7 1/2"	4"	2	3.55	2/2.01		117	7-6	2J
SOFFIT STONE	52 7/8"	21 1/2"	4"	2	5.26	2/2.02	W001, W003	006	5-4	2K
SOFFIT STONE	106 1/2"	21 1/2"	4"	1	5.3	2/2.02	W002	006	5-4	2L
SOFFIT STONE	78"	7 1/2"	3 1/2"	1	1.18	2/3.1	S001	024		2M
SOFFIT STONE	98 1/2"	11 3/4"	3 1/2"	3	15.07	2/ ADJUST WIDTHS TO MATCH HEADER,		006	4-3	2N
SOFFIT STONE	98 1/2"	17 3/4"	3 1/2"	3	22.76	2/ SEE 1/7		006	4-3	2P
SOFFIT STONE	31 7/8"	7 1/2"	3 1/2"	2	.97	2/2.02	W148-152	102	4-3	2Q
SOFFIT STONE	70 3/4"	7 1/2"	3 1/2"	2	2.15	2/2.02	W148-152	102	4-3	2R
SOFFIT STONE	56 1/2"	7 1/2"	3 1/2"	2	1.72	2/2.02	W148-152	102	4-3	2S
SOFFIT STONE	56 3/4"	7 1/2"	3 1/2"	1	.85	2/2.02	W148-152	102	4-3	2T
SOFFIT STONE	35 3/4"	7 1/2"	4"	1	.62	2/2.03	S118-121	102	B	2U
SOFFIT STONE	40 5/8"	7 1/2"	4"	2	1.41	2/2.03	S118-121	102	B	2V
SOFFIT STONE	38 9/16"	7 1/2"	4"	1	.67	2/2.3	S118-121	102	B	2W



820 WILLOW STREET
MANKATO MN, 56001
507-508-0684

PAGE 4

JOB #: _____

SOLD TO: _____

DATE: 03/10/2021

JOB NAME: GALE ROAD


STOCK: LIMESTONE

LOCATION: WOODLAND, MN

FINISH: HONED

SECTION OR DETAIL DRAWING: 6/A6.1, 10/A8.2

PART DESCRIPTION	DIM. A.	WIDE	HEIGHT	QTY	CUBIC FT	ARCH. SHEET	WDW / DR #	ROOM #	GRID LINE(S)	KEY #
CUT STONE SILL LL	71 1/2"	4"	3"	1	.49	2/2.03	S005	006	B	4C
CUT STONE SILL LL	61 5/16"	4"	3"	1	.43	2/3.1	S001	024		4D
CUT STONE SILL LL	41 1/2"	4"	3"	2	.58	2/3.1	S002	018		4E
CUT STONE SILL LL	83 7/8"	4"	3"	1	.58	2/3.1	S002	018		4F
CUT STONE SILL LL	88"	4"	3"	1	.61	2/3.1	S3	012		4G
CUT STONE SILL LL	91 7/8"	4"	3"	2	1.28	2/2.02	W005-007	006		4H
CUT STONE SILL LL	98 1/2"	4"	3"	1	.68	2/2.02	W005-007	006		4J
CUT STONE SILL LL										
CUT STONE SILL LL										
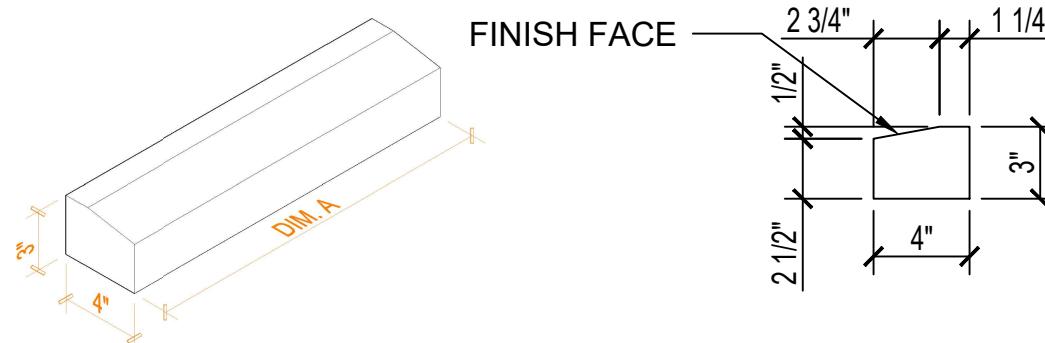



820 WILLOW STREET
MANKATO MN, 56001
507-508-0684

PAGE 08

JOB #:

DATE: 03/10/2021



STOCK: LIMESTONE

FINISH: HONED

SOLD TO:

FINISH: HONED

JOB NAME: GALE ROAD

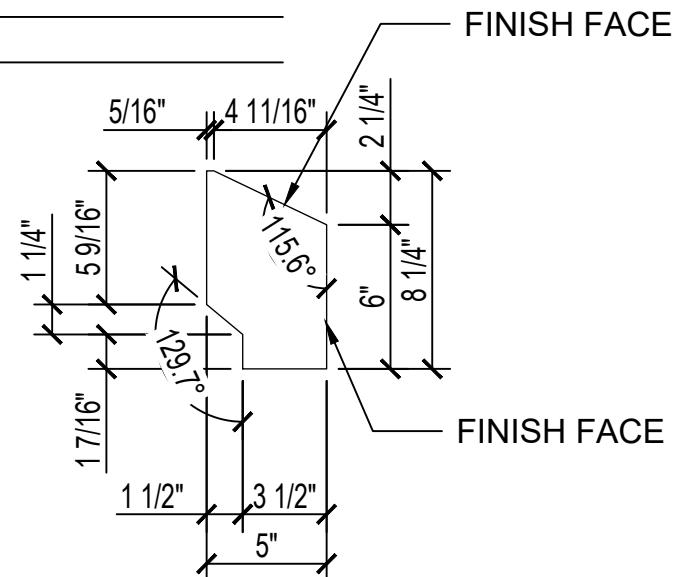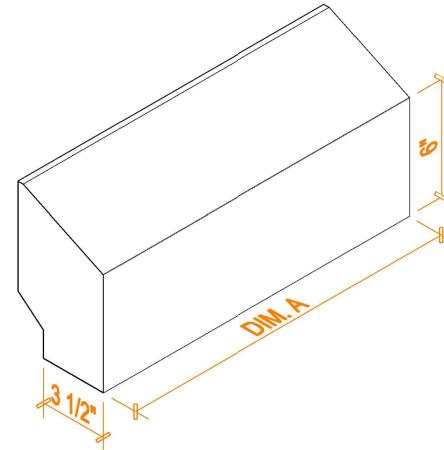



820 WILLOW STREET
MANKATO MN, 56001
507-508-0684

PAGE 09

JOB #:

DATE: 03/10/2021

STOCK: LIMESTONE



FINISH: HONED

SOLD TO:

JOB NAME: GALE ROAD

LOCATION: WOODLAND, MN

SECTION OR DETAIL DRAWING: 3/A6.1

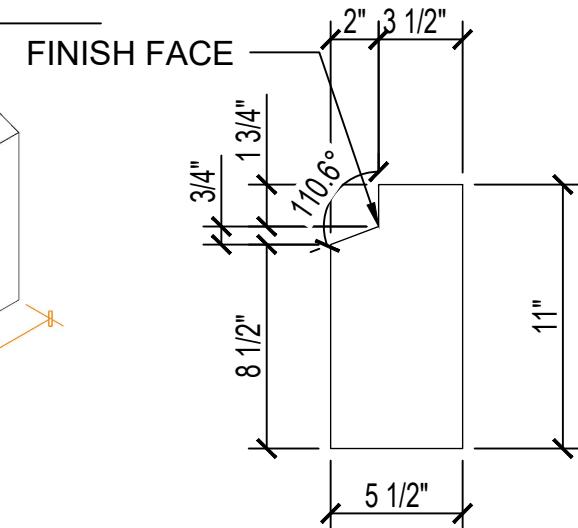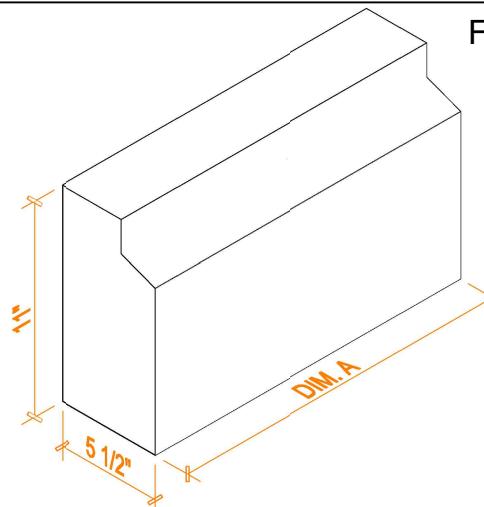



820 WILLOW STREET
MANKATO MN, 56001
507-508-0684

PAGE 10

JOB #:

SOLD TO:

JOB NAME: GALE ROAD

LOCATION: WOODLAND MN

SECTION OR DETAIL DRAWING: A/A4 3a: 23a/A


DATE: 03/10/2021

STOCK LIMESTONE

FINISH: HONED

A technical drawing of a rectangular block. The front vertical edge has a dimension line with arrows at both ends, labeled "5 3/8". The top horizontal edge has a dimension line with arrows at both ends, labeled "12". A diagonal dimension line extends from the bottom-left corner to the top-right corner, labeled "DIM. A".

WATERTABLE LINE:
101' - 6" FOR 10B/10C @ SOUTH ELEV.
TO BE CAPTURED BY DOG ROOM JAMB
STONE SWEEP AND SITE WALL.
100' - 0 3/4" TYPICAL
MAIN LEVEL

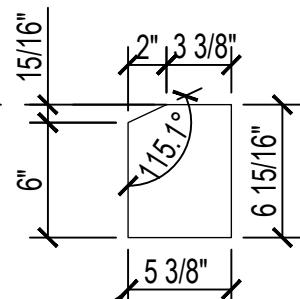

FINISH FACE



820 WILLOW STREET
MANKATO MN, 56001
507-508-0684

PAGE 11

JOB #: _____

DATE: 03/10/2021

SOLD TO: _____

STOCK: LIMESTONE


JOB NAME: GALE ROAD

FINISH: HONED

LOCATION: WOODLAND, MN

SECTION OR DETAIL DRAWING: 11/A8.2

PART DESCRIPTION	DIM. A.	WIDE	HIGH	QTY	CUBIC FT	ARCH. SHEET	WDW / DR #	ROOM #	GRID LINE(S)	KEY #
CUT STONE SILL	39"	7"	9 7/16"	2	2.98	1/4.5		018	5-4	11A

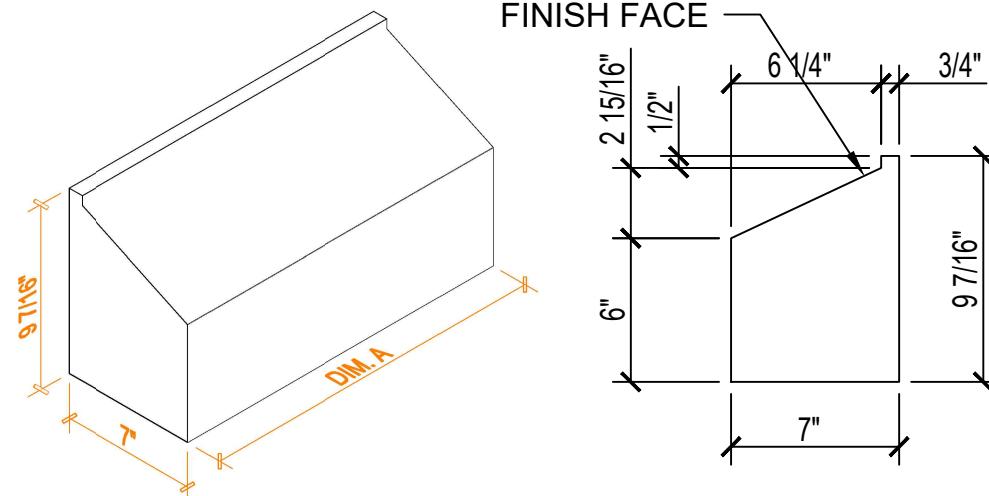




820 WILLOW STREET
MANKATO MN, 56001
507-508-0684

PAGE 12

JOB #: _____
SOLD TO: _____
JOB NAME: GALE ROAD
LOCATION: WOODLAND, MN
SECTION OR DETAIL DRAWING: 4/A4.3a; 23a/A8.3

DATE: 03/08/2021
STOCK: LIMESTONE
FINISH: HONED

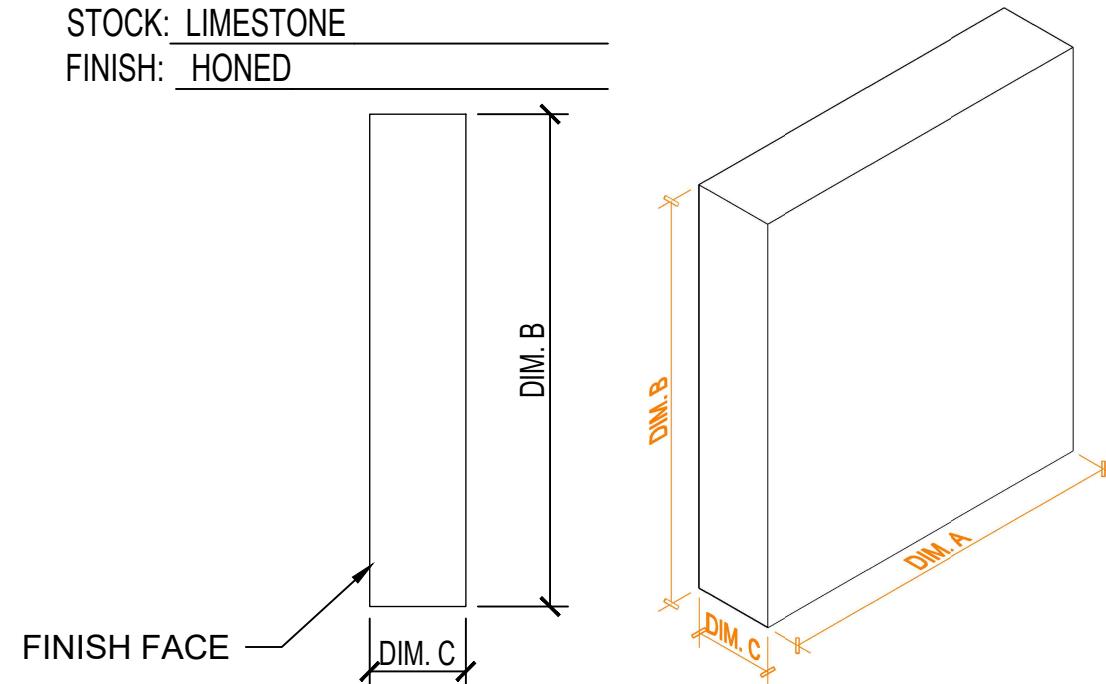

PART DESCRIPTION	DIM. A	DIM. B	DIM. C	QTY	CUBIC FT	ARCH. SHEET	WDW / DR #	ROOM #	GRID LINE(S)	KEY #
CUT STONE	43 7/8"	18 1/4"	4"	1	1.85	1/2.02	E104a-E109a	106,108,109	4-5	12A
CUT STONE	47 3/4"	18 1/4"	4"	2	4.03	1/2.02	E104a-E109a	106,108,109	4-5	12B
CUT STONE	46"	18 1/4"	4"	2	3.89	1/2.02	E104a-E109a	106,108,109	4-5	12C
CUT STONE	54 3/4"	18 1/4"	4"	1	2.31	1/2.02	E104a-E109a	106,108,109	4-5	12D
CUT STONE	45 7/8"	18 1/4"	4"	1	1.94	1/2.02	E104a-E109a	106,108,109	4-5	12E
CUT STONE	40"	13"	4"	2	2.41	1/2.01			5-6	12F
CUT STONE	59 11/16"	13"	4"	2	2.09	1/2.01			5-6	12G
CUT STONE	59 7/16"	13"	4"	2	2.07	1/2.01			5-6	12H
CUT STONE	58 5/16"	13"	4"	2	2.04	1/2.01			5-6	12J



820 WILLOW STREET
MANKATO MN, 56001
507-508-0684

PAGE 12-1

JOB #: _____

SOLD TO: _____

JOB NAME: GALE ROAD

LOCATION: WOODLAND, MN

SECTION OR DETAIL DRAWING: 4/A4.3a; 23a/A8.3

DATE: 03/10/2021

STOCK: LIMESTONE

FINISH: HONED

PART DESCRIPTION	DIM. A	DIM. B	DIM. C	QTY	CUBIC FT	ARCH. SHEET	WDW / DR #	ROOM #	GRID LINE(S)	KEY #
CUT STONE	23 3/4"	11"	4"	2	1.21	1/2.01, 1/2.01a		131a	9	12K
CUT STONE	32 1/4"	11"	4"	2	1.64	1/2.01, 1/2.01a		131a	9	12L
CUT STONE	13 3/4"	11"	4"	2	.70	1/2.01, 1/2.01a		131a	9	12M
CUT STONE	28 3/16"	13"	4"	1	.74	2/2.04		116	E	12N
CUT STONE	54"	13"	4"	1	1.46	2/2.04		116	E	12P
CUT STONE	54 1/8"	13"	4"	1	1.43	2/2.04		116	E	12Q
CUT STONE	44 1/8"	13"	4"	1	1.36	2/2.04		116	E	12R
CUT STONE	25 1/8"	13"	4"	1	.64	2/2.04		116	E	12S
CUT STONE	47 7/16"	11"	4"	2	1.63	1/2.03		131a	B-A	12T
CUT STONE	35 11/16"	11"	4"	2	2.55	1/2.03		131a	B-A	12U
CUT STONE	20 1/2"	21"	4"	1	.68	2/2.02		009	5-4	12V
CUT STONE	16 1/8"	21"	4"	1	.52	2/2.02		009	5-4	12X
CUT STONE	54"	21"	4"	5	13.13	2/2.02		006	4-3	12Y
CUT STONE	42"	21"	4"	1	2.04	2/2.03		006	B	12Z
CUT STONE	35"	21"	4"	2	1.81			003		12AA
CUT STONE	36"	21"	4"	1	1.75	2/2.02			2	12AB
CUT STONE	37 1/2"	21"	4"	1	1.94			003		12AC
CUT STONE	20 7/8"	21"	4"	2	1.51	2/2.02				12AD
CUT STONE	19 3/4"	21"	4"	1	1.17			003		12AE
CUT STONE	24 7/8"	21"	4"	1	.96	2/2.02				12AF



820 WILLOW STREET
MANKATO MN, 56001
507-508-0684

PAGE 12-2

JOB #: _____

DATE: 03/10/2021

SOLD TO: _____

STOCK: LIMESTONE

JOB NAME: GALE ROAD

FINISH: HONED

LOCATION: WOODLAND, MN

SECTION OR DETAIL DRAWING: 4/A4.3a; 23a/A8.3

PART DESCRIPTION	DIM. A	DIM. B	DIM. C	QTY	CUBIC FT	ARCH. SHEET	WDW / DR #	ROOM #	GRID LINE(S)	KEY #
CUT STONE	21 3/8"	21"	4"	2	2.08	1/2.01, 1/2.1 SEE NOTE ON 2/13		131a	9	12AG
CUT STONE	45 1/2"	21"	4"	2	4.42	1/2.01, 1/2.1 SEE NOTE ON 2/13		131a	9	12AH
CUT STONE	48"	21"	4"	3	7.00	1/2.01, 1/2.01a		131a	9	12AJ
CUT STONE	21 7/8"	21"	4"	1	1.06	2/2.04		116	E	12AK
CUT STONE	63 3/4"	21"	4"	1	3.30	2/4.5		024	E	12AL
CUT STONE	11 5/8"	21"	4"	2? SEE 2/13		2/2.04		116	E	12AM
CUT STONE	30 1/8"	21"	4"	1	1.93			024	E	12AN
CUT STONE	46 15/16"	21"	4"	2	4.10	1/4.5		012,024		12AP
CUT STONE	23 1/16"	21"	4"	1	1.09			024		12AQ
CUT STONE	21 15/16"	21"	4"	2	2.66	1/2.03		131a	B-A	12AR
CUT STONE	23 1/16"	21"	4"	1	2.67	1/4.5		012		12AS
CUT STONE	36 3/8"	21"	4"	1	2.06	1/4.5		012		12AT
CUT STONE	26 1/2"	21"	4"	1	1.51	1/2.04		009	B	12AU
CUT STONE	48 1/2"	21"	4"	3	7.07			003		12AV
CUT STONE	11 5/8"	21"	4"	2	.40			003		12AW
CUT STONE	60 13/16"	8"	4"	2	2.25	2/2.01		112	6-5	12AX
CUT STONE	72 1/8"	8"	4"	2	2.67	2/2.01		112	6-5	12AY
CUT STONE	83 1/8"	8"	4"	2	3.08	2/2.01		112	6-5	12AZ
CUT STONE	28 3/4"	6 13/16"	4"	1	.45	2/3.1		112		12BA
CUT STONE	21 3/8"	6 13/16 "	4"	1	.49	2/3.1 FIELD CUT AS REQ'D	112			12BB



JOB #: _____
 SOLD TO: _____
 JOB NAME: GALE ROAD
 LOCATION: WOODLAND, MN
 SECTION OR DETAIL DRAWING: 4/A4.3a; 23a/A8.3

PAGE 12-3

DATE: 03/10/2021
 STOCK: LIMESTONE
 FINISH: HONED

820 WILLOW STREET
 MANKATO MN, 56001
 507-508-0684

PART DESCRIPTION	DIM. A	DIM. B	DIM. C	QTY	CUBIC FT	ARCH. SHEET	WDW / DR #	ROOM #	GRID LINE(S)	KEY #
CUT STONE	62"	32 3/4"	4"	2	9.4	2/2.02	FIREPLACE	SC. PORCH	5-4	12BC
CUT STONE	62"	32 13/16"	4"	1	4.71	2/2.02	FIREPLACE	SC. PORCH	5-4	12BD
CUT STONE	23"	32 3/4"	4"	2	3.49	2/2.02	FIREPLACE	SC. PORCH	5-4	12BE
CUT STONE	23"	32 13/16"	4"	1	1.75	2/2.02	FIREPLACE	SC. PORCH	5-4	12BF
CUT STONE	26"	32 3/4"	4"	2	3.94	2/2.02	FIREPLACE	SC. PORCH	5-4	12BG
CUT STONE	26"	32 13/16"	4"	1	1.98	2/2.02	FIREPLACE	SC. PORCH	5-4	12BH
CUT STONE	49 3/8"	16"	4"	2	2.18	2/2.02	FIREPLACE	SC. PORCH	5-4	12BL
CUT STONE	39 1/2"	16"	4"	2	2.92	2/2.02	FIREPLACE	SC. PORCH	5-4	12BM
CUT STONE	50 3/8"	16"	4"	2	3.74	2/2.02	FIREPLACE	SC.. PORCH	5-4	12BN
CUT STONE	23 7/8"	32 3/4"	4"	3	5.43	2/3.1	S115a	111		12BP
CUT STONE	32"	32 3/4"	4"	3	7.28	2/3.1	S115a	111		12BQ
CUT STONE	16"	30 3/4"	2"	8	2.28	2/2.02	W148-152	102	4-3	12BR
CUT STONE	16"	32 13/16"	2"	4	2.43	2/2.02	W148-152	102	4-3	12BS
CUT STONE	12"	30 3/4"	2"	4	1.71	2/2.02	W148-152	102	4-3	12BT
CUT STONE	12"	32 13/16"	2"	2	.91	2/2.02	W148-152	102	4-3	12BU
CUT STONE	14"	30 3/4"	2"	2	.99	2/2.03	S118-121	102	B	12BV
CUT STONE	14"	32 13/16"	2"	1	.53	2/2.03	S118-121	102	B	12BW
CUT STONE	16 9/16"	30 3/4"	2"	2	1.17	2/2.03	S118-121	102	B	12BX
CUT STONE	16 9/16"	32 13/16"	2"	1	.63	2/2.03	S118-121	102	B	12BY
CUT STONE	8"	30 3/4 "	2"	4	1.14	2/2.03	S118-121	102	B	12BZ
CUT STONE	8"	32 13/16"	2"	2	.61	2/2.03	S118-121	102	B	12CA
CUT STONE	24 3/4	12 7/8"	4"	1	2.20					12CB

JOB #: _____

SOLD TO: _____

DATE: 03/10/2021


JOB NAME: GALE ROAD

STOCK: LIMESTONE

LOCATION: WOODLAND, MN

FINISH: HONED

SECTION OR DETAIL DRAWING: 2/A6.2; 1/A8.3; 1/A6.5; 2/A6.5; 1/A6.8; 3/A6.8

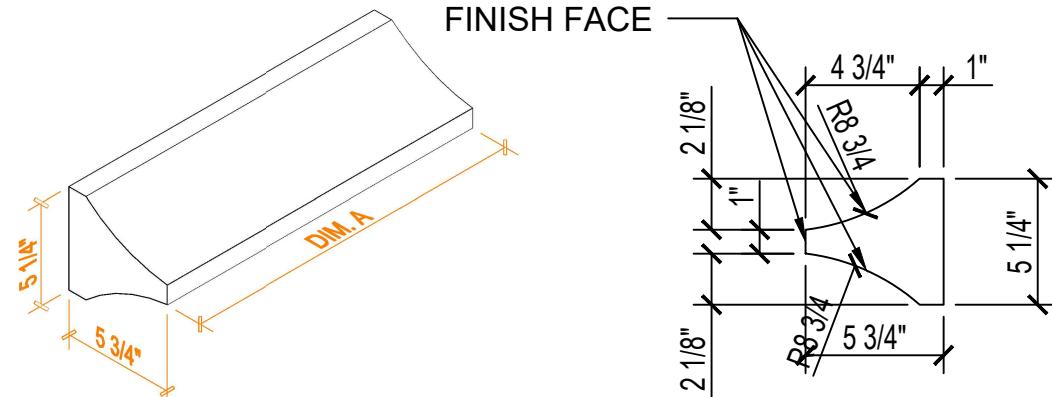

PART DESCRIPTION	DIM. A.	WIDE	HEIGHT	QTY	CUBIC FT	ARCH. SHEET	WDW / DR #	ROOM #	GRID LINE(S)	KEY #
MULLION	15"	5 3/4"	5 1/4"	2	.52	1/2.01	E229	212	5-6	16AJ
MULLION	60"	5 3/4"	5 1/4"	2	2.09	1/2.01	E230	212	5-6	16AK
MULLION	17 1/2"	5 3/4"	5 1/4"	5	1.53	1-2/2.01,2/2.04	E116, N110,W136	116,112	5-6, E,6-5	16AD
MULLION	92 1/4"	5 3/4"	5 1/4"	4	6.44	1-2/2.01	E117, W134	116,12	5-6,6-5	16AE
MULLION	17 1/2"	5 3/4"	5 1/4"	4	1.22	1/2.01a, 1/2.03	E125, E146;N135	119a, 131a	6-7, B-A	16AD
MULLION	92 1/4"	5 3/4"	5 1/4"	4	6.44	1/2.01a, 1/2.03	E127, E148;N136	119a, 131a	6-7, B-A	16AE
MULLION	92"	5 3/4"	5 1/4"	1	1.61	2/2.04	N111, N114	116	E	16AS
MULLION	48"	5 3/4"	5 1/4"	2	16AE AND 16AD. I COUNT 10 TOTAL FOR EACH.					
MULLION								112	6-5	16AT
MULLION										
MULLION										
MULLION										

- 2 ON 2/2 EAST GABLE
- 4 ON 1/3a ENTRY EAST ELEVATION
- 2 ON 1/6 WEST GABLE
- 2 ON 1/9 NORTH BATHROOM BAY



820 WILLOW STREET
MANKATO MN, 56001
507-508-0684

PAGE 16AF
PAGE 16AG
PAGE 16AH

JOB #: _____

SOLD TO: _____

JOB NAME: GALE ROAD




LOCATION: WOODLAND, MN

SECTION OR DETAIL DRAWING: 2/A6.2; 1/A8.3; 1/A6.5; 2/A6.5; 1/A6.8; 3/A6.8

DATE: 03/10/2021

STOCK: LIMESTONE

FINISH: HONED

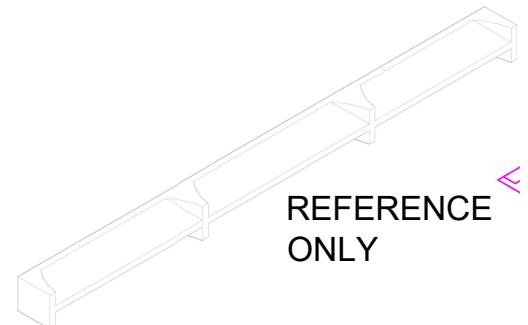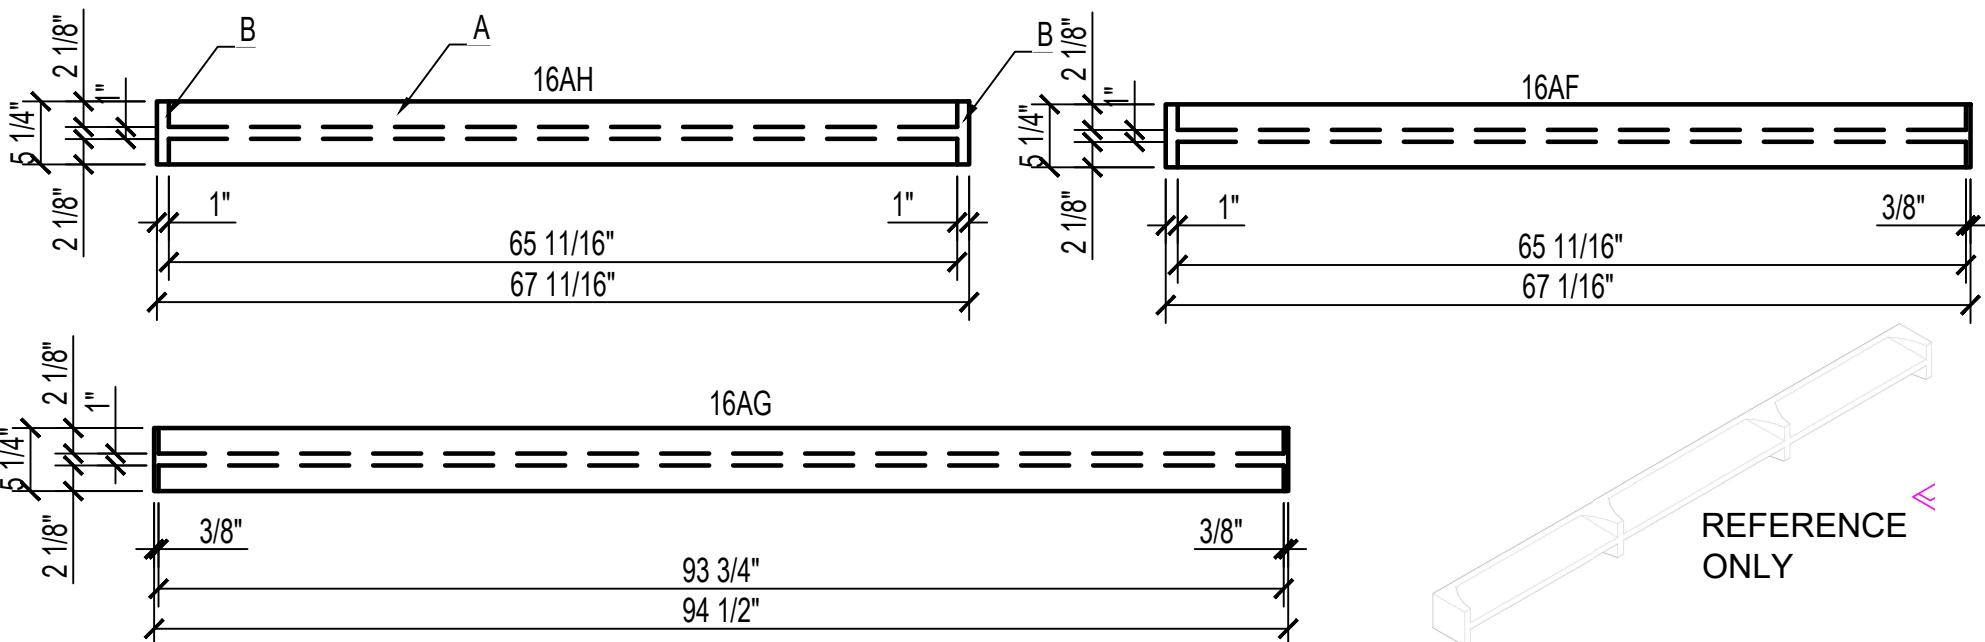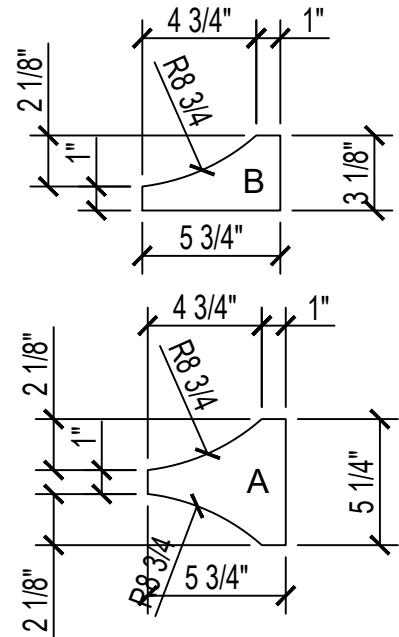

PART DESCRIPTION	DIM. A.	WIDE	DIM. B.	QTY	CUBIC FT	ARCH. SHEET	WDW / DR #	ROOM #	GRID LINE(S)	KEY #
MULLION	67 1/16"	5 1/4"	5 3/4"	1(L)1(R)	2.34	2/A2.01	W111-125	126	8-7	16AF
MULLION	94 1/2"	5 1/4"	5 3/4"	1	1.65	2/A2.01	W111-125	126	8-7	16AG
MULLION	67 11/16"	5 1/4"	5 3/4"	2	2.36	2/A2.01	W111-125	126	8-7	16AH



820 WILLOW STREET
MANKATO MN, 56001
507-508-0684

PAGE 16AL

JOB #: _____

SOLD TO: _____

JOB NAME: GALE ROAD





LOCATION: WOODLAND, MN

DATE: 03/10/2021

STOCK: LIMESTONE

FINISH: HONED

SECTION OR DETAIL DRAWING: 2/A6.2; 1/A8.3; 1/A6.5; 2/A6.5; 1/A6.8; 3/A6.8

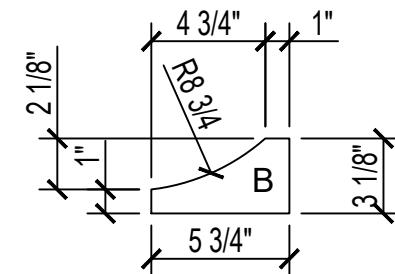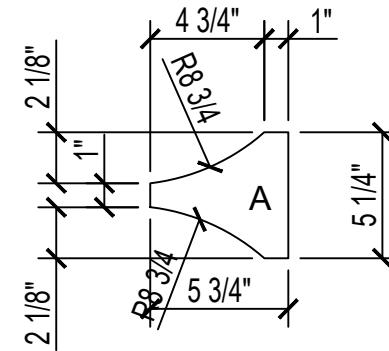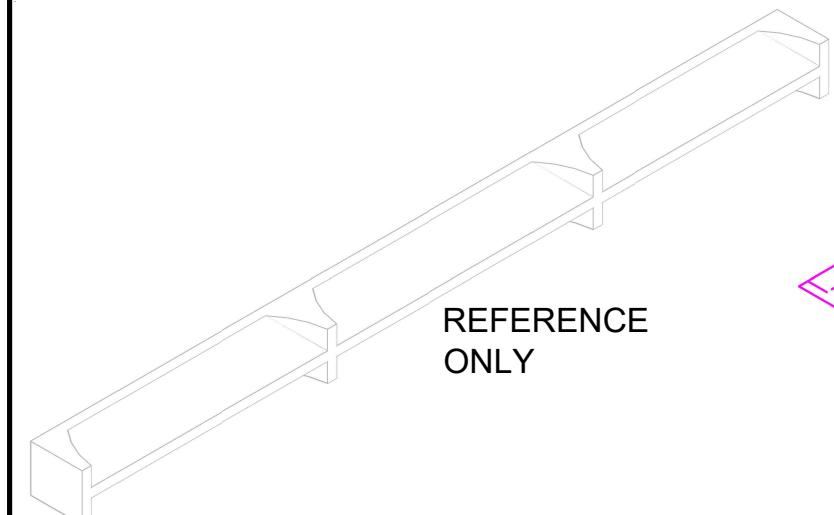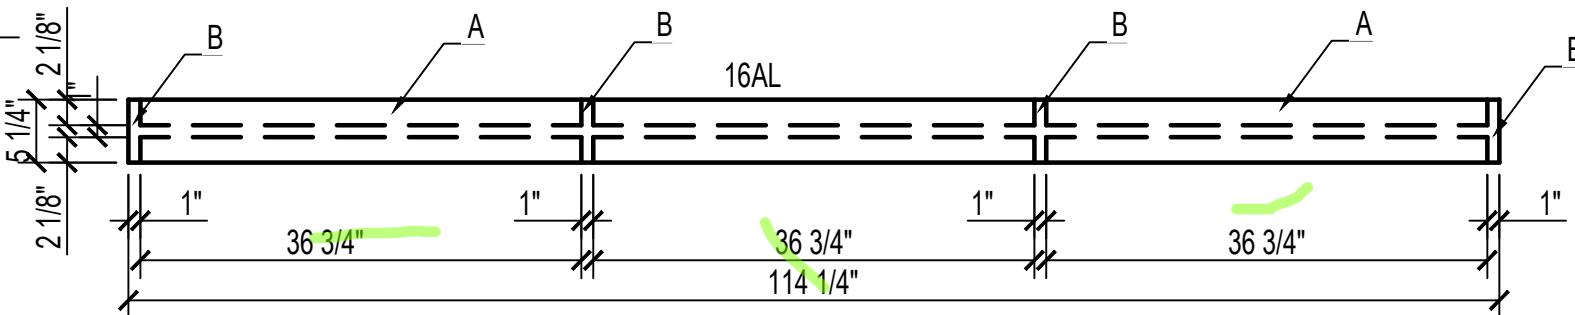

PART DESCRIPTION	DIM. A.	WIDE	DIM. B.	QTY	CUBIC FT	ARCH. SHEET	WDW / DR #	ROOM #	GRID LINE(S)	KEY #
MULLION	114 1/4"	5 3/4"	5 1/4"	1		1/2.01	E228-232	212	5-6	16AL



820 WILLOW STREET
MANKATO MN, 56001
507-508-0684

PAGE 16AM

JOB #: _____

SOLD TO: _____

DATE: 03/10/2021





JOB NAME: GALE ROAD

STOCK: LIMESTONE

LOCATION: WOODLAND, MN

FINISH: HONED

SECTION OR DETAIL DRAWING: 2/A6.2; 1/A8.3; 1/A6.5; 2/A6.5; 1/A6.8; 3/A6.8

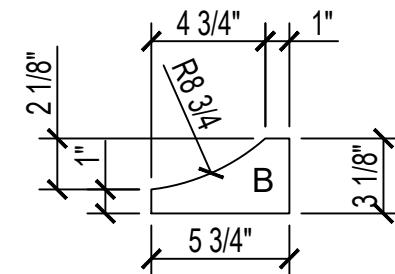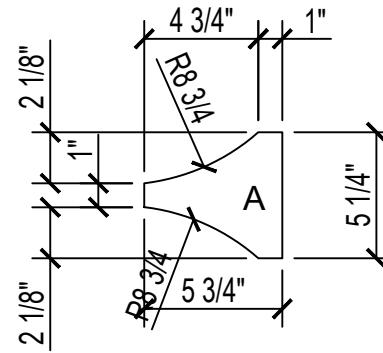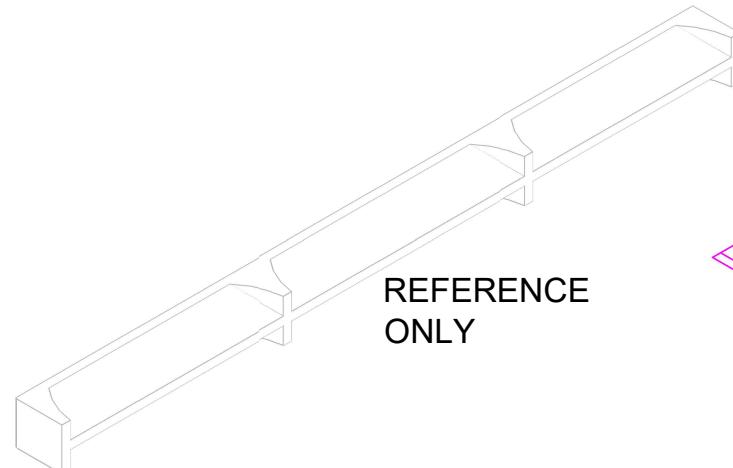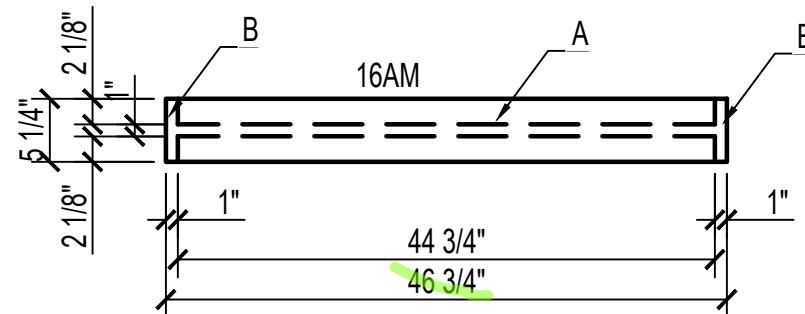

PART DESCRIPTION	DIM. A.	WIDE	DIM. B.	QTY	CUBIC FT	ARCH. SHEET	WDW / DR #	ROOM #	GRID LINE(S)	KEY #
MULLION	46 3/4"	5 3/4"	5 1/4"	2	1.63	1/2.01	E111, E123	116	5-6	16AM



820 WILLOW STREET
MANKATO MN, 56001
507-508-0684

PAGE 16AN
PAGE 16AP

JOB #: _____

DATE: 03/10/2021

SOLD TO: _____





STOCK: LIMESTONE

JOB NAME: GALE ROAD

FINISH: HONED

LOCATION: WOODLAND, MN

SECTION OR DETAIL DRAWING: 2/A6.2; 1/A8.3; 1/A6.5; 2/A6.5; 1/A6.8; 3/A6.8

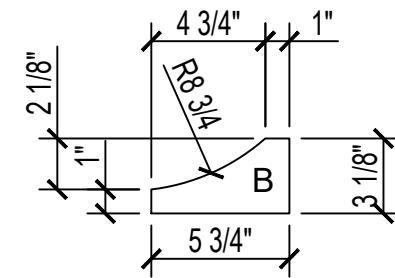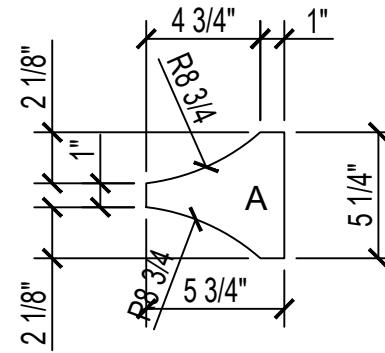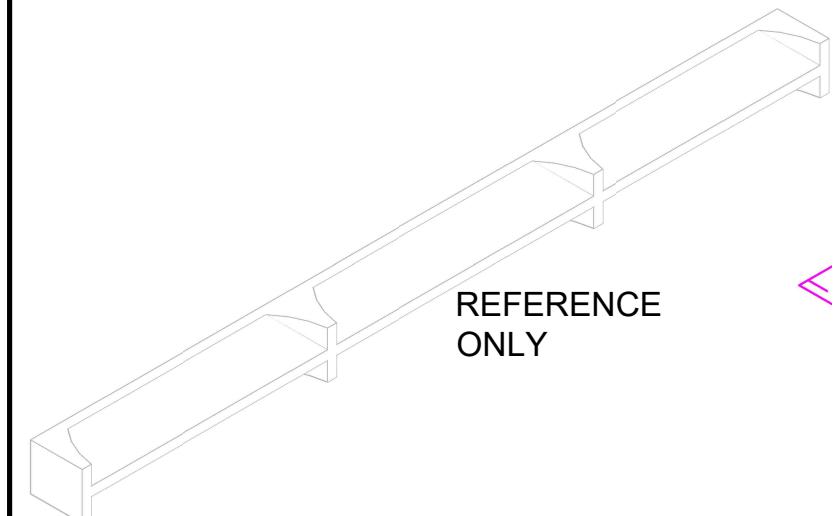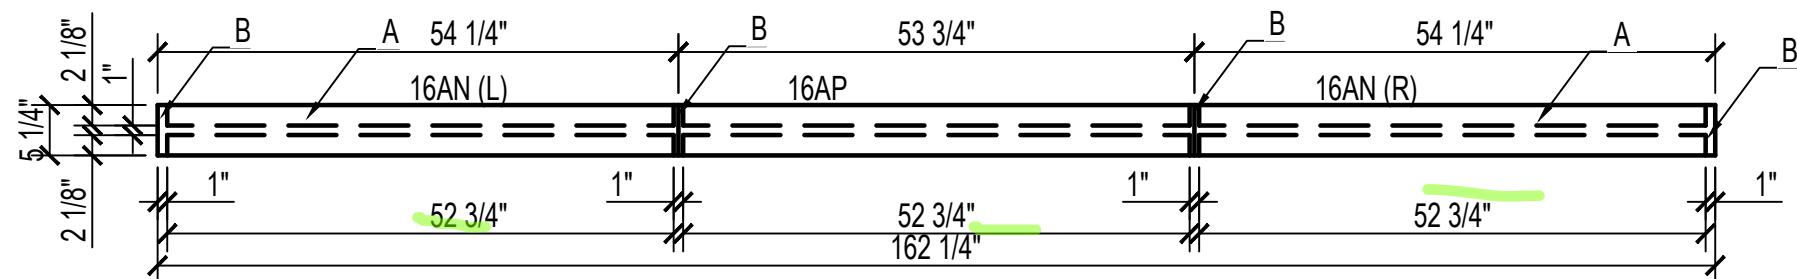

PART DESCRIPTION	DIM. A.	WIDE	DIM. B.	QTY	CUBIC FT	ARCH. SHEET	WDW / DR #	ROOM #	GRID LINE(S)	KEY #
MULLION	54 1/4"	5 3/4"	5 1/4"	1(R) L(L)	1.89	1/2.01	E113, E119	116	5-6	16AN
MULLION	53 3/4"	5 3/4"	5 1/4"	1	.94	1/2.01	E116	116	5-6	16AP



820 WILLOW STREET
MANKATO MN, 56001
507-508-0684

PAGE 16AQ
PAGE 16AR
PAGE 16Z

JOB #: _____

DATE: 03/10/2021

SOLD TO: _____





STOCK: LIMESTONE

JOB NAME: GALE ROAD

FINISH: HONED

LOCATION: WOODLAND, MN

SECTION OR DETAIL DRAWING: 2/A6.2; 1/A8.3; 1/A6.5; 2/A6.5; 1/A6.8; 3/A6.8

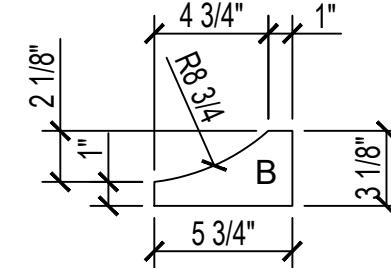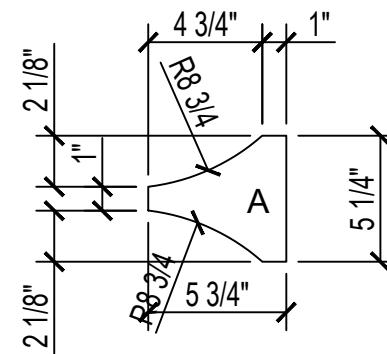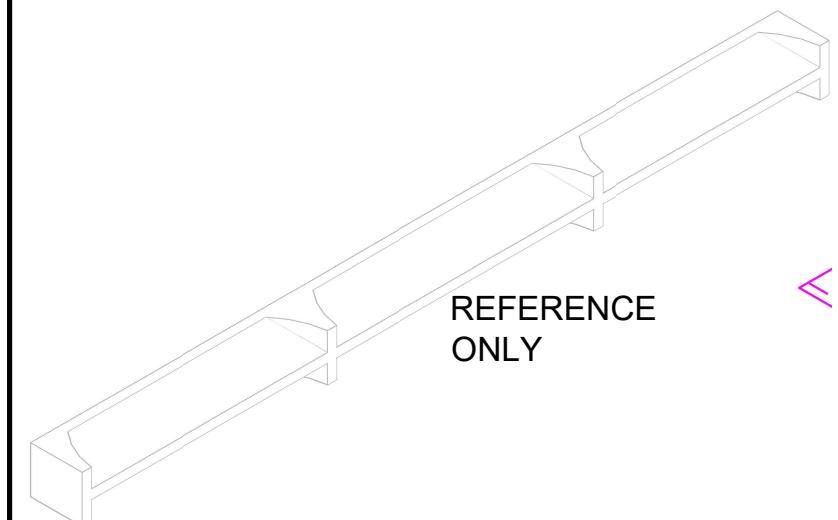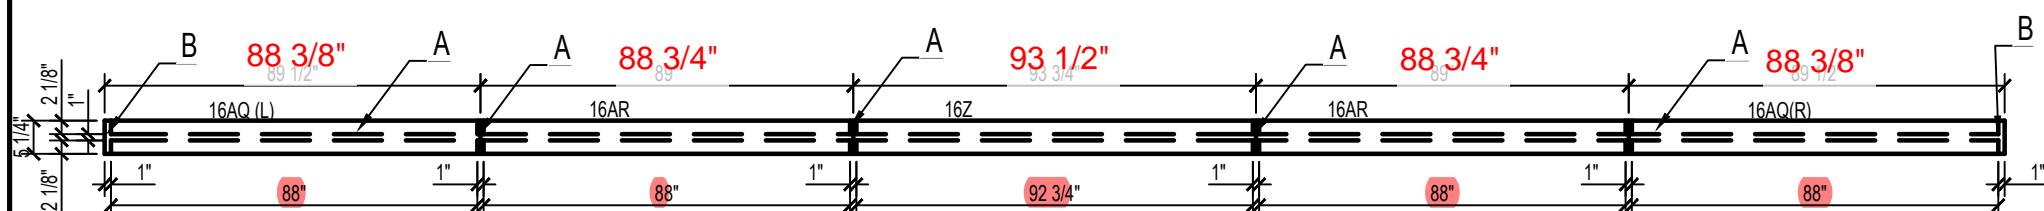

PART DESCRIPTION	DIM. A.	WIDE	DIM. B.	QTY	CUBIC FT	ARCH. SHEET	WDW / DR #	ROOM #	GRID LINE(S)	KEY #
MULLION	88 3/8"	5 3/4"	5 1/4"	1(R) L(L)	3.13	1/2.01a	E125-126, E145-146	119a	6-7	16AQ
MULLION	88 3/4"	5 3/4"	5 1/4"	2	3.11	1/2.01a	E131-132, E139-140	119a	6-7	16AR
MULLION	93 1/2"	5 3/4"	5 1/4"	1	1.64	1/2.01a	E137	119a	6-7	16Z



820 WILLOW STREET
MANKATO MN, 56001
507-508-0684

PAGE 16AT

JOB #: _____

SOLD TO: _____

DATE: 03/10/2021


JOB NAME: GALE ROAD

STOCK: LIMESTONE

LOCATION: WOODLAND, MN




FINISH: HONED

SECTION OR DETAIL DRAWING: 2/A6.2; 1/A8.3; 1/A6.5; 2/A6.5; 1/A6.8; 3/A6.8

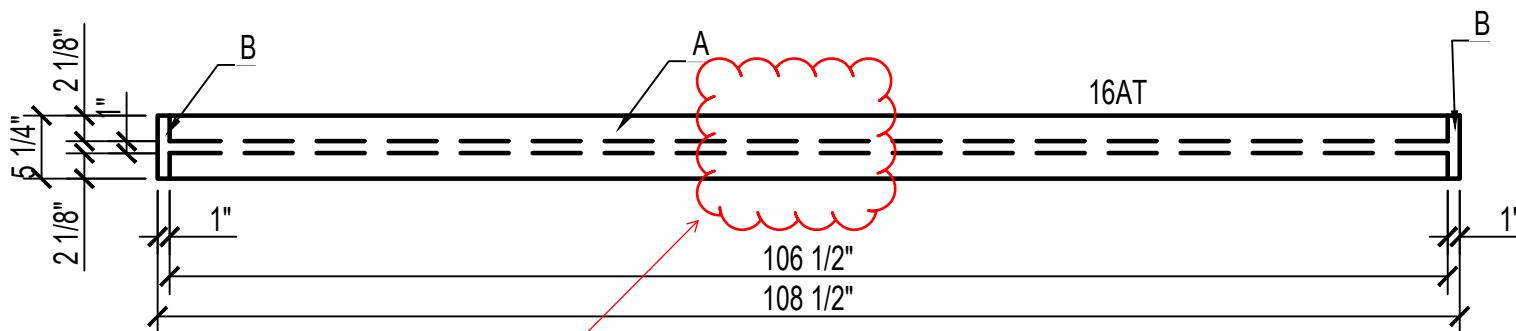

PROFILE
MISSING

REFERENCE
ONLY

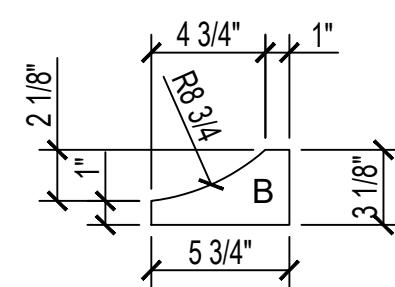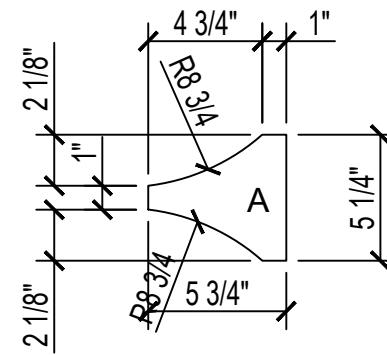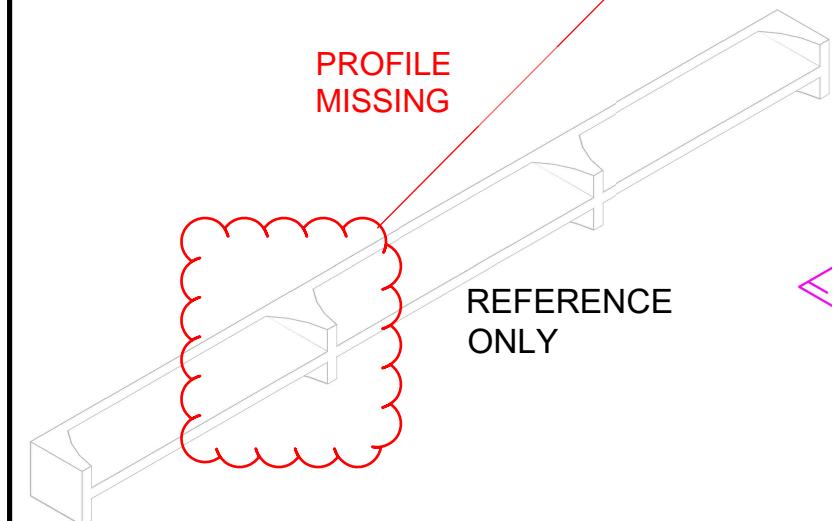

PART DESCRIPTION	DIM. A.	WIDE	DIM. B.	QTY	CUBIC FT	ARCH. SHEET	WDW / DR #	ROOM #	GRID LINE(S)	KEY #
MULLION	108 1/2"	5 3/4"	5 1/4"	1	1.86	1/2.04	N111, N114	116	E	16AT

JOB #: _____

SOLD TO: _____

DATE: 03/10/2021


JOB NAME: GALE ROAD

STOCK: LIMESTONE

LOCATION: WOODLAND, MN

FINISH: HONED

SECTION OR DETAIL DRAWING: 2/A6.2; 1/A8.3; 1/A6.5; 2/A6.5; 1/A6.8; 3/A6.8

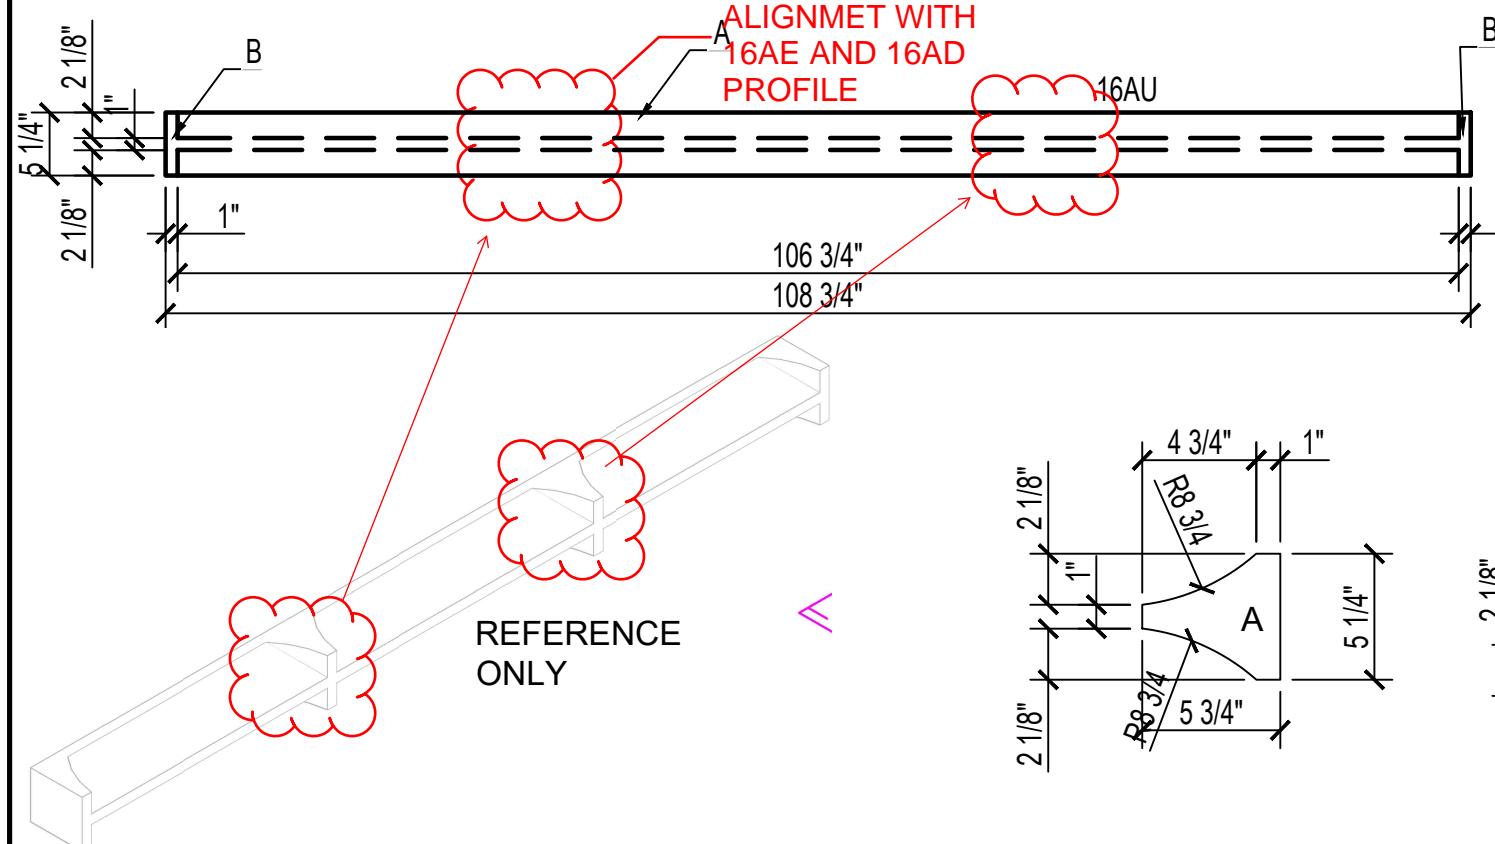

PART DESCRIPTION	DIM. A.	WIDE	DIM. B.	QTY	CUBIC FT	ARCH. SHEET	WDW / DR #	ROOM #	GRID LINE(S)	KEY #
MULLION	108 3/4"	5 3/4"	5 1/4"	1	1.9	1/2.03	N136	131a	B-A	16AU



820 WILLOW STREET
MANKATO MN, 56001
507-508-0684

PAGE 16AV

JOB #: _____

SOLD TO: _____

DATE: 03/10/2021





JOB NAME: GALE ROAD

STOCK: LIMESTONE

LOCATION: WOODLAND, MN

FINISH: HONED

SECTION OR DETAIL DRAWING: 2/A6.2; 1/A8.3; 1/A6.5; 2/A6.5; 1/A6.8; 3/A6.8

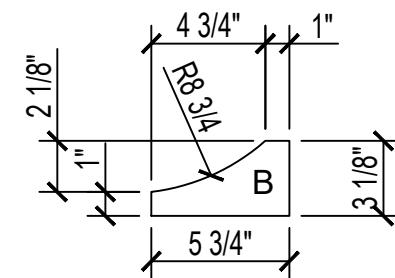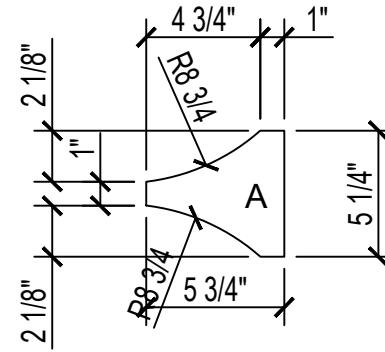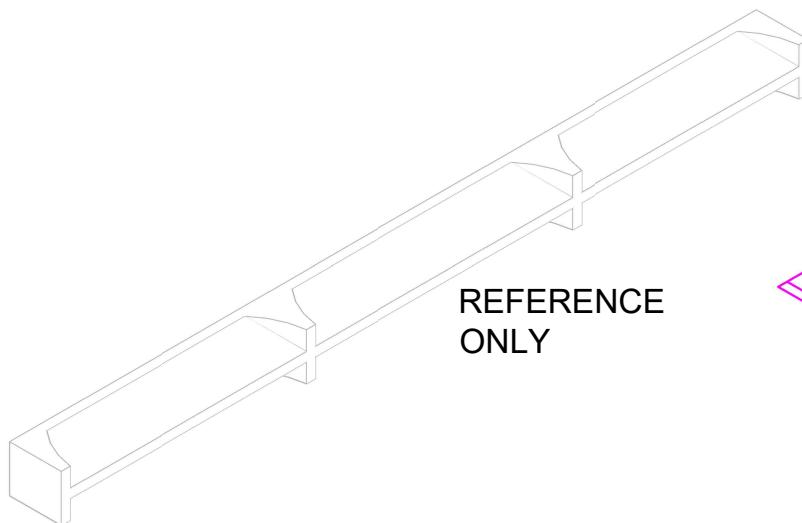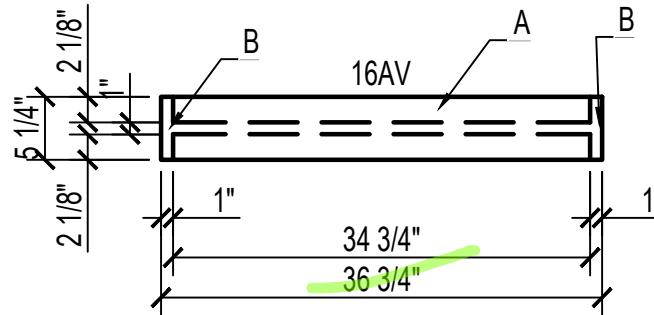

PART DESCRIPTION	DIM. A.	WIDE	DIM. B.	QTY	CUBIC FT	ARCH. SHEET	WDW / DR #	ROOM #	GRID LINE(S)	KEY #
MULLION	36 3/4"	5 3/4"	5 1/4"	2	1.28	1/2.01, 2/2.01	E177, W102	131a	9	16AV



820 WILLOW STREET
MANKATO MN, 56001
507-508-0684

PAGE 16AW

JOB #: _____

SOLD TO: _____

DATE: 03/10/2021

JOB NAME: GALE ROAD




STOCK: LIMESTONE

LOCATION: WOODLAND, MN

FINISH: HONED

SECTION OR DETAIL DRAWING: 2/A6.2; 1/A8.3; 1/A6.5; 2/A6.5; 1/A6.8; 3/A6.8

PART DESCRIPTION	DIM. A.	WIDE	DIM. B.	QTY	CUBIC FT	ARCH. SHEET	WDW / DR #	ROOM #	GRID LINE(S)	KEY #
MULLION	60 3/4"	5 1/4"	5 3/4"	1	1.06	2/3.1	S113	112		16AW

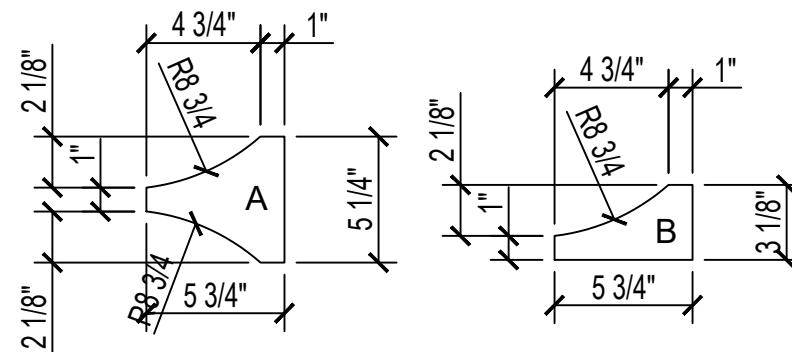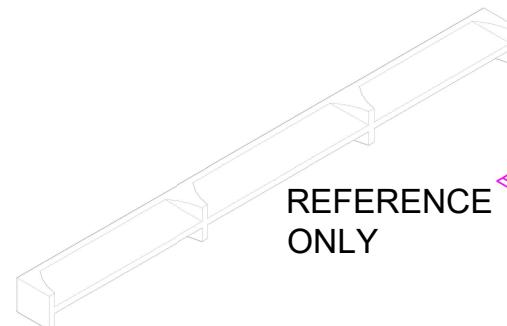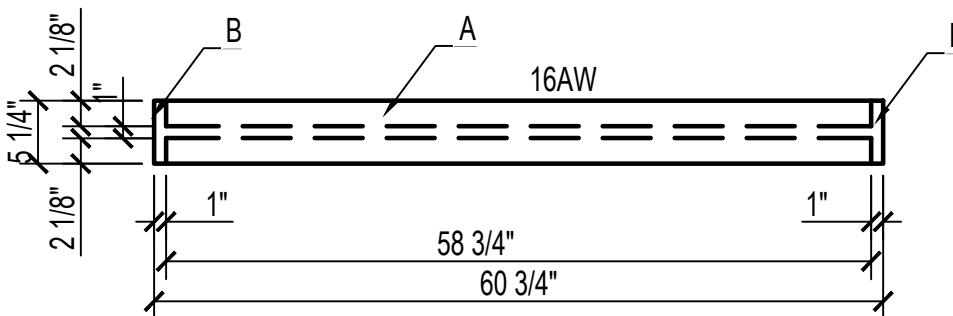



820 WILLOW STREET
MANKATO MN, 56001
507-508-0684

PAGE 17

JOB #: _____

SOLD TO: _____

DATE: 03/10/2021

JOB NAME: GALE ROAD



STOCK: LIMESTONE

LOCATION: WOODLAND, MN

FINISH: HONED

SECTION OR DETAIL DRAWING: 1/A6.2; 2/A6.2; 2/A8.3; 1/A6.5; 2/A6.5; 1/A6.8; 3/A68

FINISH FACE

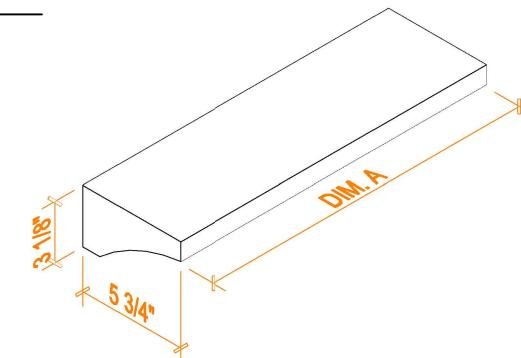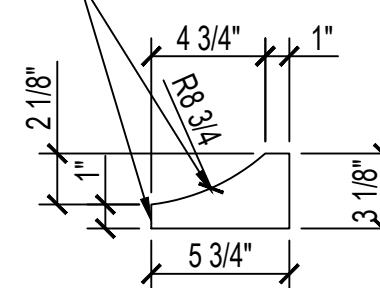

PART DESCRIPTION	DIM. A.	WIDE	HEIGHT	QTY	CUBIC FT	ARCH. SHEET	WDW / DR #	ROOM #	GRID LINE(S)	KEY #
STONE SURROUND	15"	5 3/4"	3 1/8"	2	.32	1/2.01	E227, E231	212	5-6	17BA
STONE SURROUND	60"	5 3/4"	3 1/8"	2	1.25	1/2.01	E228, E232	212	5-6	17BB
STONE SURROUND	94 3/16"	5 3/4"	3 1/8"	6	5.88	1/2.02	E104a-E109a	106,108,109	4-5	17BD
STONE SURROUND	17 1/2"	5 3/4"	3 1/8"	6	1.09	1/2.01	E111, 114,120,123	116	5-6	17BH
STONE SURROUND	92 1/4"	5 3/4"	3 1/8"	6	5.76	1/2.01	E111, 114, 120, 123	116	5-6	17BJ
STONE SURROUND	17 1/2"	5 3/4"	3 1/8"	8	1.44	1/2.01a, 1/2.01	E125,E146,W127-139	119a, 112	6-7, 6-5	17BH
STONE SURROUND	92 1/4"	5 3/4"	3 1/8"	8	7.68	1/2.01a, 1/2.01	E127,E148,W137-139	119a, 112	6-7,6-5	17BJ
STONE SURROUND	17 1/2"	5 3/4"	3 1/8"	4	.72	2/2.04, 2/3.1	N110, N113, S113	116, 112	E	17BH
STONE SURROUND	92"	5 3/4"	3 1/8"	4	3.82	2/2.04, 2/3.1	N111, N114, S113	116, 112	E	17AM
STONE SURROUND	17 1/2"	5 3/4"	3 1/8"	6	1.08	1/2.03,1/2.01,2/2.01	N132,138, E176,W101	131a	B-A, 9	17BH
STONE SURROUND	92 1/4"	5 3/4"	3 1/8"	6	5.76	1/2.03,1/2.01,2/2.01	N133,139,E177,W102	131a	B-A, 9	17BJ
STONE SURROUND	48"	5 3/4"	3 1/8"	2	.99	2/2.01	W219, W221	112	6-5	17BS
STONE SURROUND	93 1/2"	5 3/4"	3 1/8"	8	7.94	2	TO LAND ON 47A/F/J LUG SILL	111,115	5-4	17BT



820 WILLOW STREET
MANKATO MN, 56001
507-508-0684

PAGE 17AR
PAGE 17AS
PAGE 17AT

JOB #: _____

SOLD TO: _____

DATE: 03/10/2021






JOB NAME: GALE ROAD

STOCK: LIMESTONE

LOCATION: WOODLAND, MN

FINISH: HONED

SECTION OR DETAIL DRAWING: 1/A6.2; 2/A6.2; 2/A8.3; 1/A6.5; 2/A6.5; 1/A6.8; 3/A68

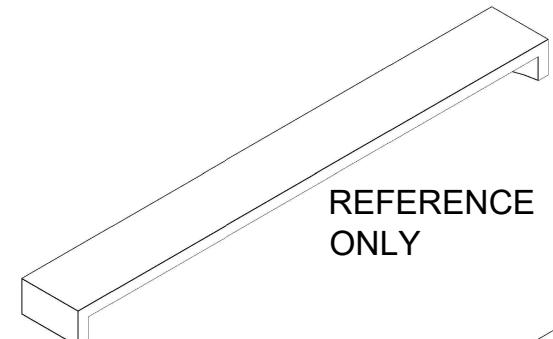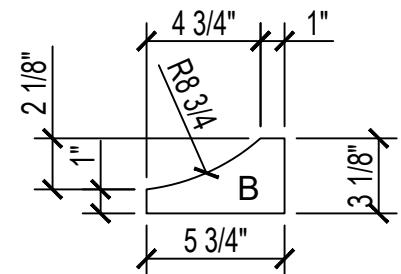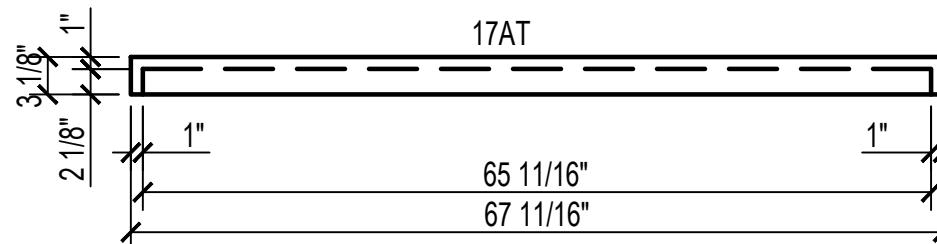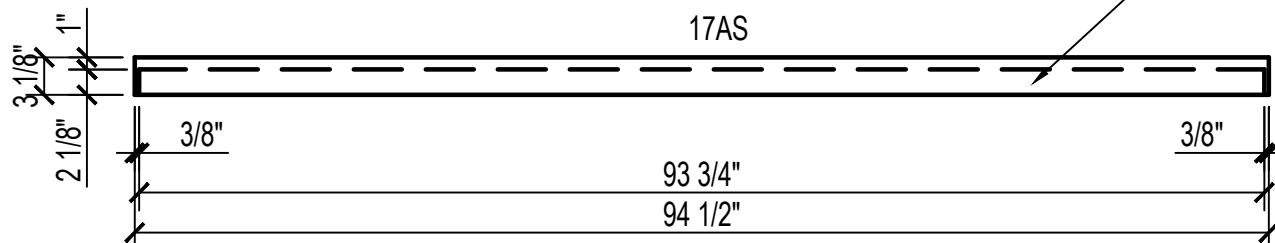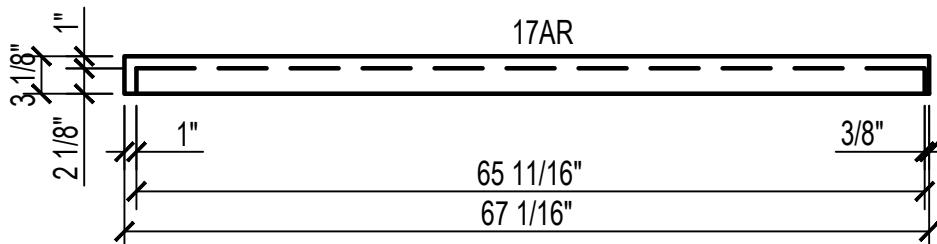

REFERENCE
ONLY

PART DESCRIPTION	DIM. A.	WIDE	DIM. B.	QTY	CUBIC FT	ARCH. SHEET	WDW / DR #	ROOM #	GRID LINE(S)	KEY #
STONE SURROUND	67 1/16"	3 1/8"	5 3/4"	2(L)2(R)	2.79	2/A2.01	W114, W120	112	6-5	17AR
STONE SURROUND	94 1/2"	3 1/8"	5 3/4"	1	.985	2/A2.01	W136	112	6-5	17AS
STONE SURROUND	67 11/16"	3 1/8"	5 3/4"	2	1.41	2/A2.01	W127, W139	112	6-5	17AT



820 WILLOW STREET
MANKATO MN, 56001
507-508-0684

PAGE 17BC

JOB #: _____

SOLD TO: _____

DATE: 03/10/2021





JOB NAME: GALE ROAD

STOCK: LIMESTONE

LOCATION: WOODLAND, MN

FINISH: HONED

SECTION OR DETAIL DRAWING: 1/A6.2; 2/A6.2; 2/A8.3; 1/A6.5; 2/A6.5; 1/A6.8; 3/A68

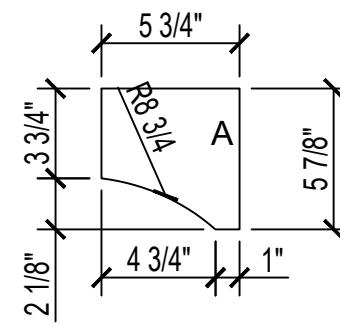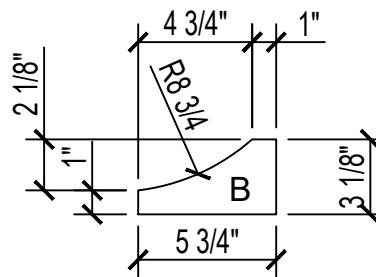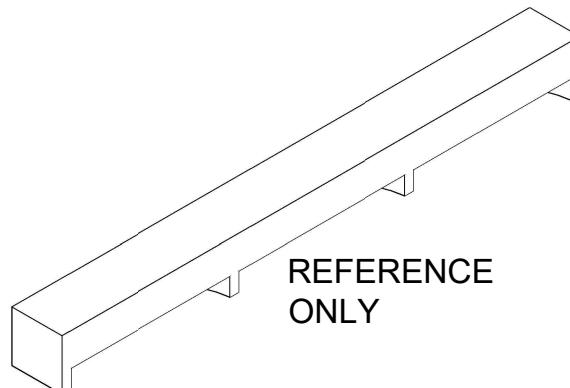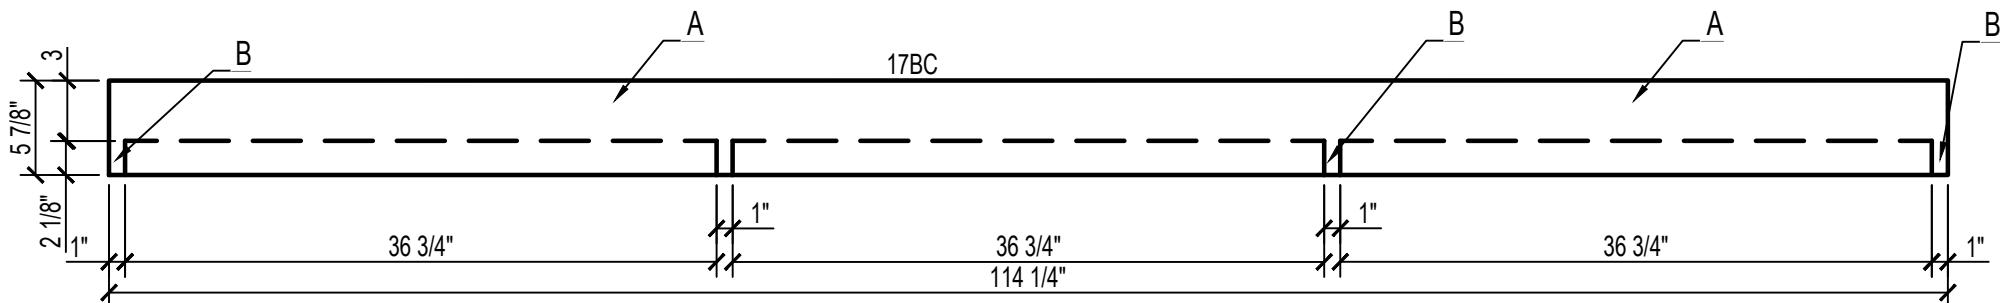

PART DESCRIPTION	DIM. A.	WIDE	DIM. B.	QTY	CUBIC FT	ARCH. SHEET	WDW / DR #	ROOM #	GRID LINE(S)	KEY #
STONE SURROUND	114 1/4"	5 3/4"	5 7/8"	1	2.23	1/A2.01	E227-231	212	5-6	17BC



820 WILLOW STREET
MANKATO MN, 56001
507-508-0684

PAGE 17BE

JOB #: _____

SOLD TO: _____

DATE: 03/10/2021




JOB NAME: GALE ROAD

STOCK: LIMESTONE

LOCATION: WOODLAND, MN

FINISH: HONED

SECTION OR DETAIL DRAWING: 1/A6.2; 2/A6.2; 2/A8.3; 1/A6.5; 2/A6.5; 1/A6.8; 3/A68

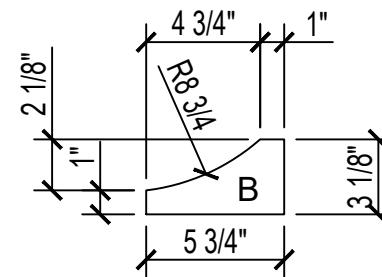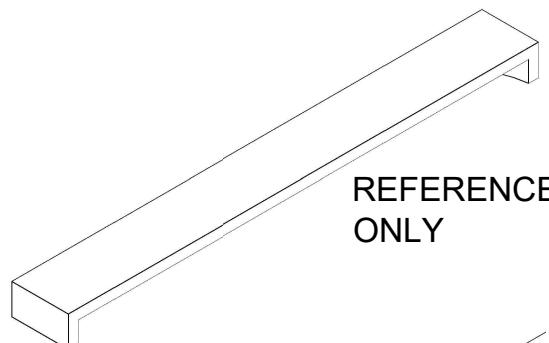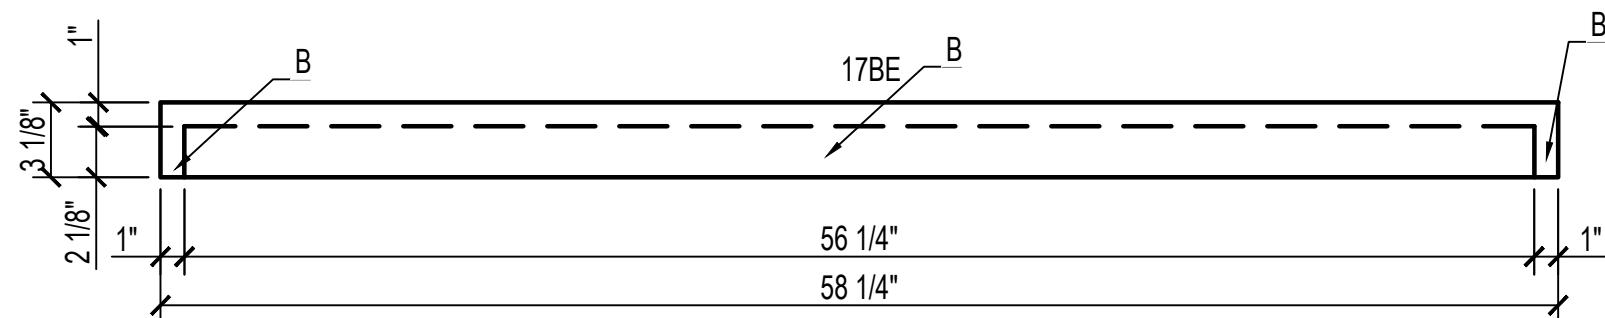

PART DESCRIPTION	DIM. A.	WIDE	DIM. B.	QTY	CUBIC FT	ARCH. SHEET	WDW / DR #	ROOM #	GRID LINE(S)	KEY #
STONE SURROUND	58 1/4"	5 3/4"	3 1/8"	2	1.21	1/2.02	E104a, E109a	106, 109	4-5	17BE



820 WILLOW STREET
MANKATO MN, 56001
507-508-0684

PAGE 17BF
PAGE 17BG

JOB #: _____

SOLD TO: _____

DATE: 03/10/2021




JOB NAME: GALE ROAD

STOCK: LIMESTONE

LOCATION: WOODLAND, MN

FINISH: HONED

SECTION OR DETAIL DRAWING: 1/A6.2; 2/A6.2; 2/A8.3; 1/A6.5; 2/A6.5; 1/A6.8; 3/A68

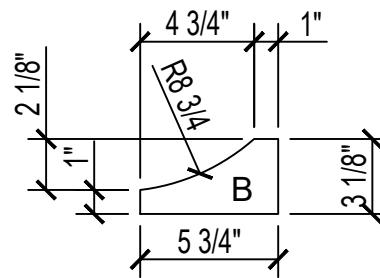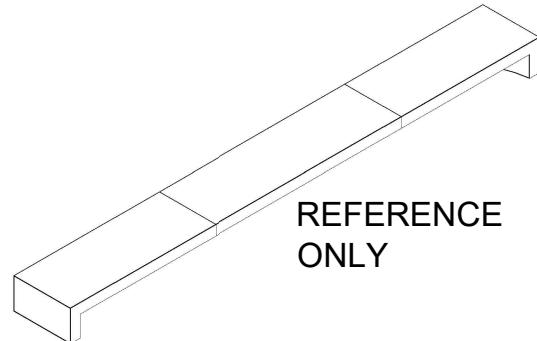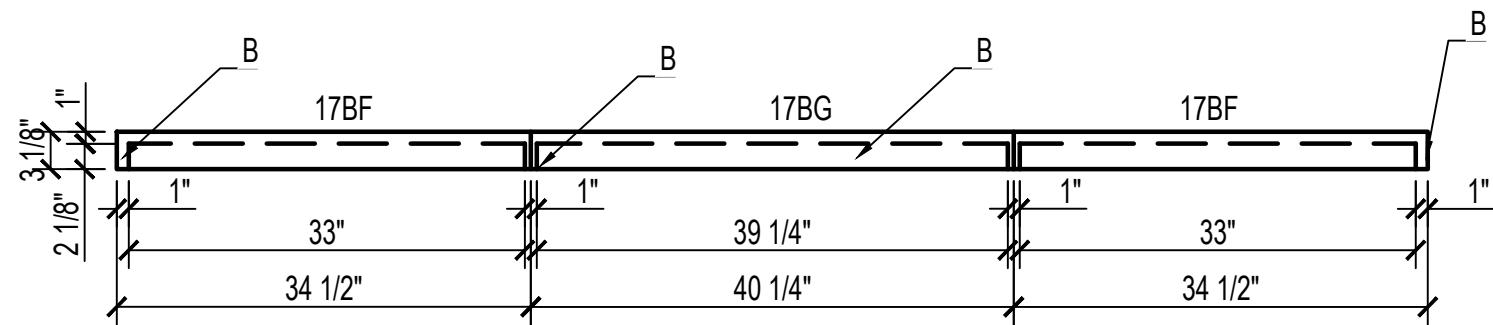

REFERENCE
ONLY

PART DESCRIPTION	DIM. A.	WIDE	DIM. B.	QTY	CUBIC FT	ARCH. SHEET	WDW / DR #	ROOM #	GRID LINE(S)	KEY #
STONE SURROUND	35 1/2"	5 3/4"	3 1/8"	1(R)1(L)	.74	1/2.02	E106a-E107a	108	4-5	17BF
STONE SURROUND	38 1/4"	5 3/4"	3 1/8"	1	.4	1/2.02	E106a, E109a	108	4-5	17BG



820 WILLOW STREET
MANKATO MN, 56001
507-508-0684

PAGE 17BK

JOB #: _____

DATE: 03/10/2021

SOLD TO: _____




STOCK: LIMESTONE

JOB NAME: GALE ROAD

FINISH: HONED

LOCATION: WOODLAND, MN

SECTION OR DETAIL DRAWING: 1/A6.2; 2/A6.2; 2/A8.3; 1/A6.5; 2/A6.5; 1/A6.8; 3/A68

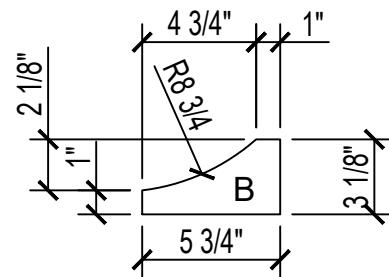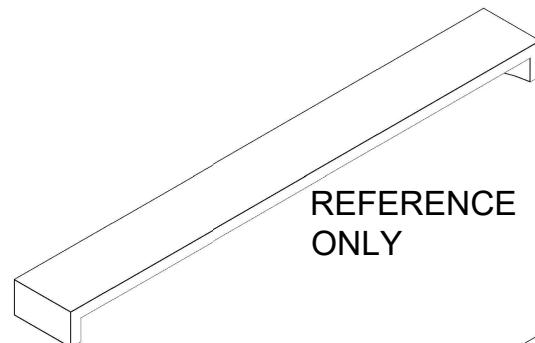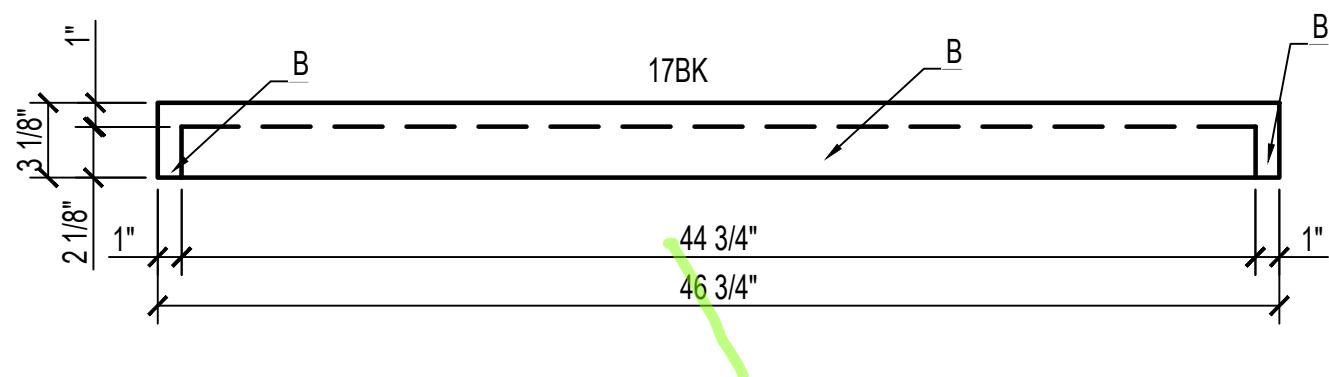

REFERENCE
ONLY

PART DESCRIPTION	DIM. A.	WIDE	DIM. B.	QTY	CUBIC FT	ARCH. SHEET	WDW / DR #	ROOM #	GRID LINE(S)	KEY #
STONE SURROUND	46 3/4"	3 1/8"	5 3/4"	2	.97	1/2.01	E111, E123	116	5-6	17BK



820 WILLOW STREET
MANKATO MN, 56001
507-508-0684

PAGE 17BL

PAGE 17BM

JOB #: _____

SOLD TO: _____

DATE: 03/10/2021




JOB NAME: GALE ROAD

STOCK: LIMESTONE

LOCATION: WOODLAND, MN

FINISH: HONED

SECTION OR DETAIL DRAWING: 1/A6.2; 2/A6.2; 2/A8.3; 1/A6.5; 2/A6.5; 1/A6.8; 3/A68

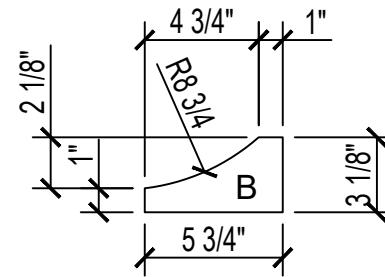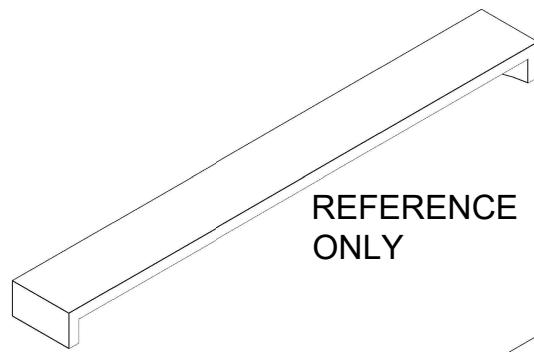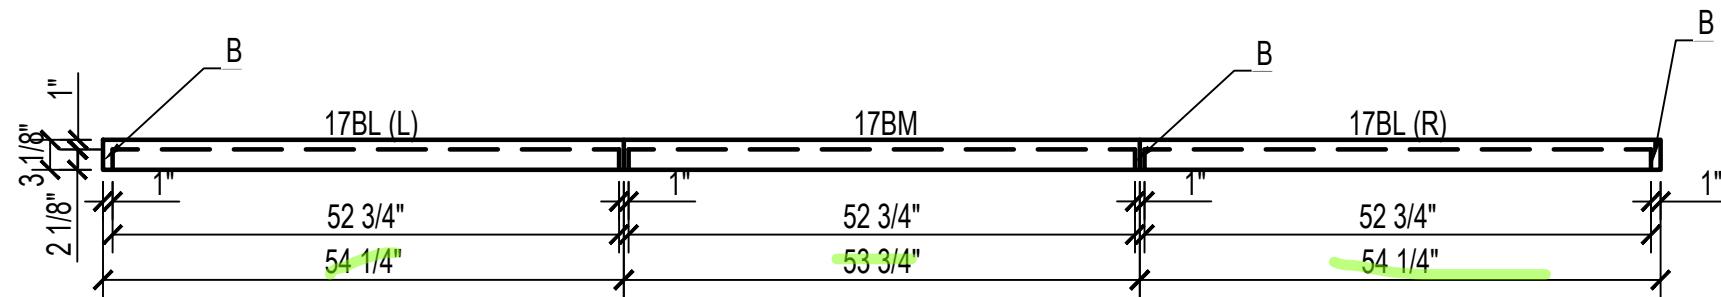

PART DESCRIPTION	DIM. A.	WIDE	DIM. B.	QTY	CUBIC FT	ARCH. SHEET	WDW / DR #	ROOM #	GRID LINE(S)	KEY #
STONE SURROUND	54 1/4"	3 1/8"	5 3/4"	1(L)1(R)	1.13	1/2.01	E114, E120	116	5-6	17BL
STONE SURROUND	53 3/4"	3 1/8"	5 3/4"	• 1	.56	1/2.01	E117	116	5-6	17BM



820 WILLOW STREET
MANKATO MN, 56001
507-508-0684

PAGE 17BN
PAGE 17BP
PAGE 17AJ

JOB #: _____

SOLD TO: _____

DATE: 03/10/2021




JOB NAME: GALE ROAD

STOCK: LIMESTONE

LOCATION: WOODLAND, MN

FINISH: HONED

SECTION OR DETAIL DRAWING: 1/A6.2; 2/A6.2; 2/A8.3; 1/A6.5; 2/A6.5; 1/A6.8; 3/A68

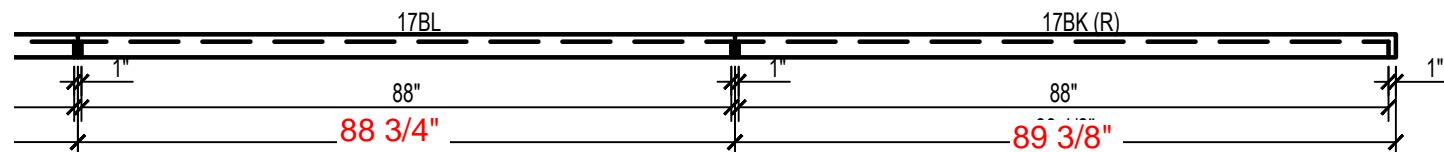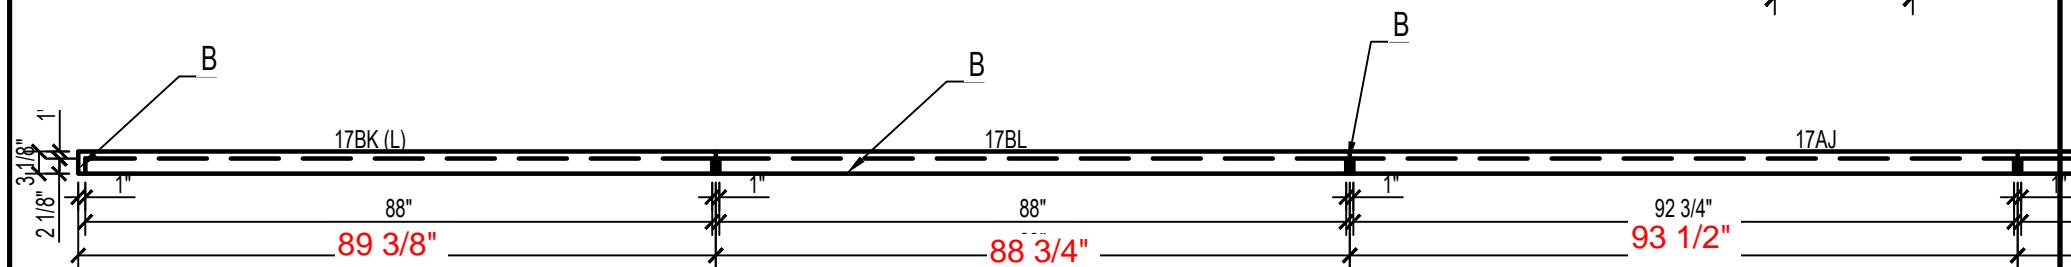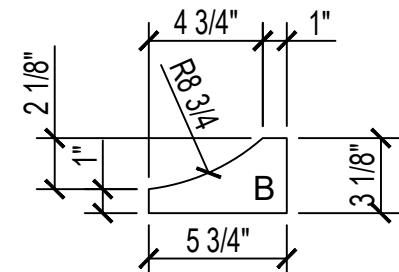

PART DESCRIPTION	DIM. A.	WIDE	DIM. B.	QTY	CUBIC FT	ARCH. SHEET	WDW / DR #	ROOM #	GRID LINE(S)	KEY #
STONE SURROUND	89 3/8"	3 1/8"	5 3/4"	1(L)1(R)	1.86	1/2.01a	E125-126, E145-146	119a	6-7	17BN
STONE SURROUND	88 3/4"	3 1/8"	5 3/4"	2	1.85	1/2.01a	E131-132, E139-140	119a	6-7	17BP
STONE SURROUND	93 1/2"	3 1/8"	5 3/4"	1	.97	1/2.01a	E137	119a	6/7/2021	17AJ



820 WILLOW STREET
MANKATO MN, 56001
507-508-0684

PAGE 17BP

JOB #: _____

DATE: 03/10/2021

SOLD TO: _____


STOCK: LIMESTONE

JOB NAME: GALE ROAD


FINISH: HONED

LOCATION: WOODLAND, MN


SECTION OR DETAIL DRAWING: 1/A6.2; 2/A6.2; 2/A8.3; 1/A6.5; 2/A6.5; 1/A6.8; 3/A68

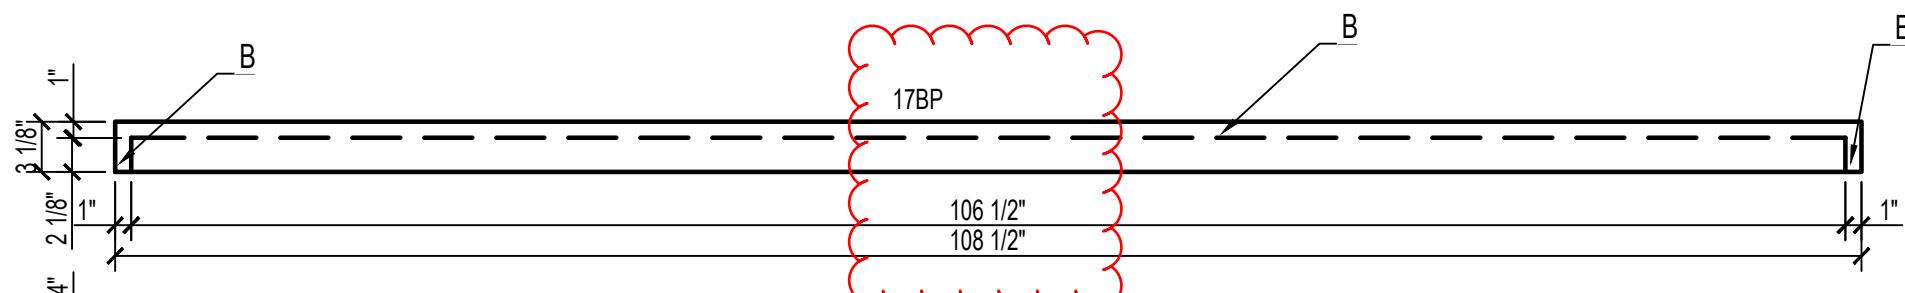

MISSING PROFILE
AT CENTER

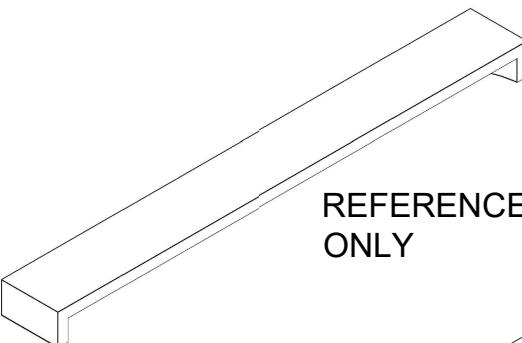

REFERENCE
ONLY

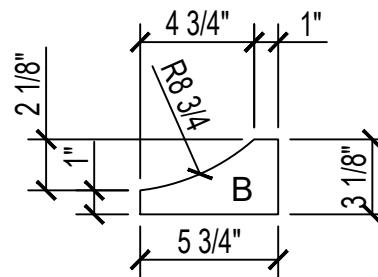

PART DESCRIPTION	DIM. A.	WIDE	DIM. B.	QTY	CUBIC FT	ARCH. SHEET	WDW / DR #	ROOM #	GRID LINE(S)	KEY #
STONE SURROUND	108 1/2"	5 3/4"	3 1/8"	1	1.13	2/2.04	N110, N113	116	E	17BP



820 WILLOW STREET
MANKATO MN, 56001
507-508-0684

PAGE 17BQ

JOB #: _____

SOLD TO: _____

DATE: 03/10/2021




JOB NAME: GALE ROAD

STOCK: LIMESTONE

LOCATION: WOODLAND, MN

FINISH: HONED

SECTION OR DETAIL DRAWING: 1/A6.2; 2/A6.2; 2/A8.3; 1/A6.5; 2/A6.5; 1/A6.8; 3/A68

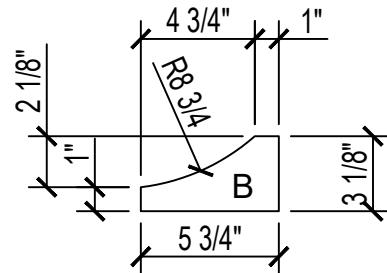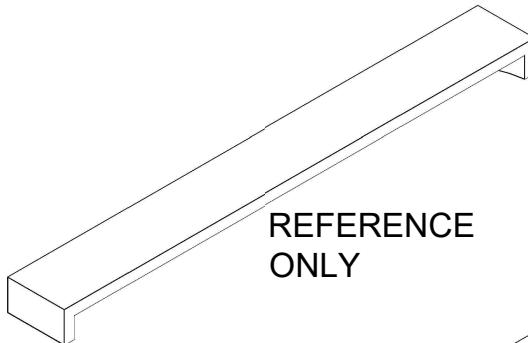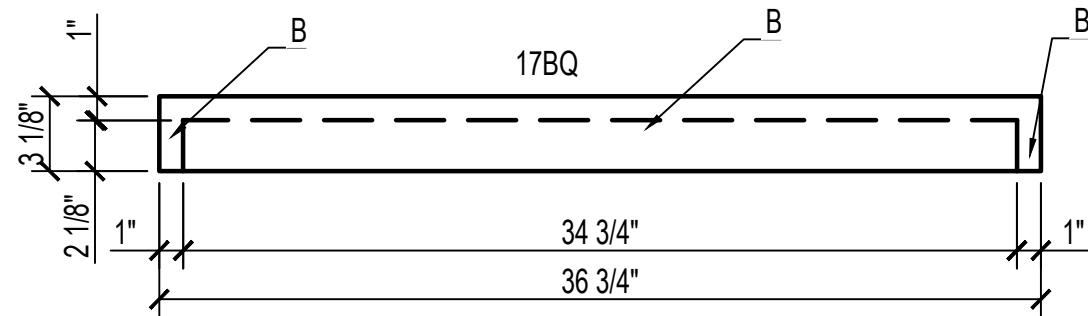

PART DESCRIPTION	DIM. A.	WIDE	DIM. B.	QTY	CUBIC FT	ARCH. SHEET	WDW / DR #	ROOM #	GRID LINE(S)	KEY #
STONE SURROUND	36 3/4"	5 3/4"	3 1/8"	2	.76	1/2.01, 2/2.01	E176, W101	131a	9	17BQ



820 WILLOW STREET
MANKATO MN, 56001
507-508-0684

PAGE 17BR

JOB #: _____

SOLD TO: _____

DATE: 03/10/2021


JOB NAME: GALE ROAD

STOCK: LIMESTONE

LOCATION: WOODLAND, MN

FINISH: HONED

SECTION OR DETAIL DRAWING: 1/A6.2; 2/A6.2; 2/A8.3; 1/A6.5; 2/A6.5; 1/A6.8; 3/A68

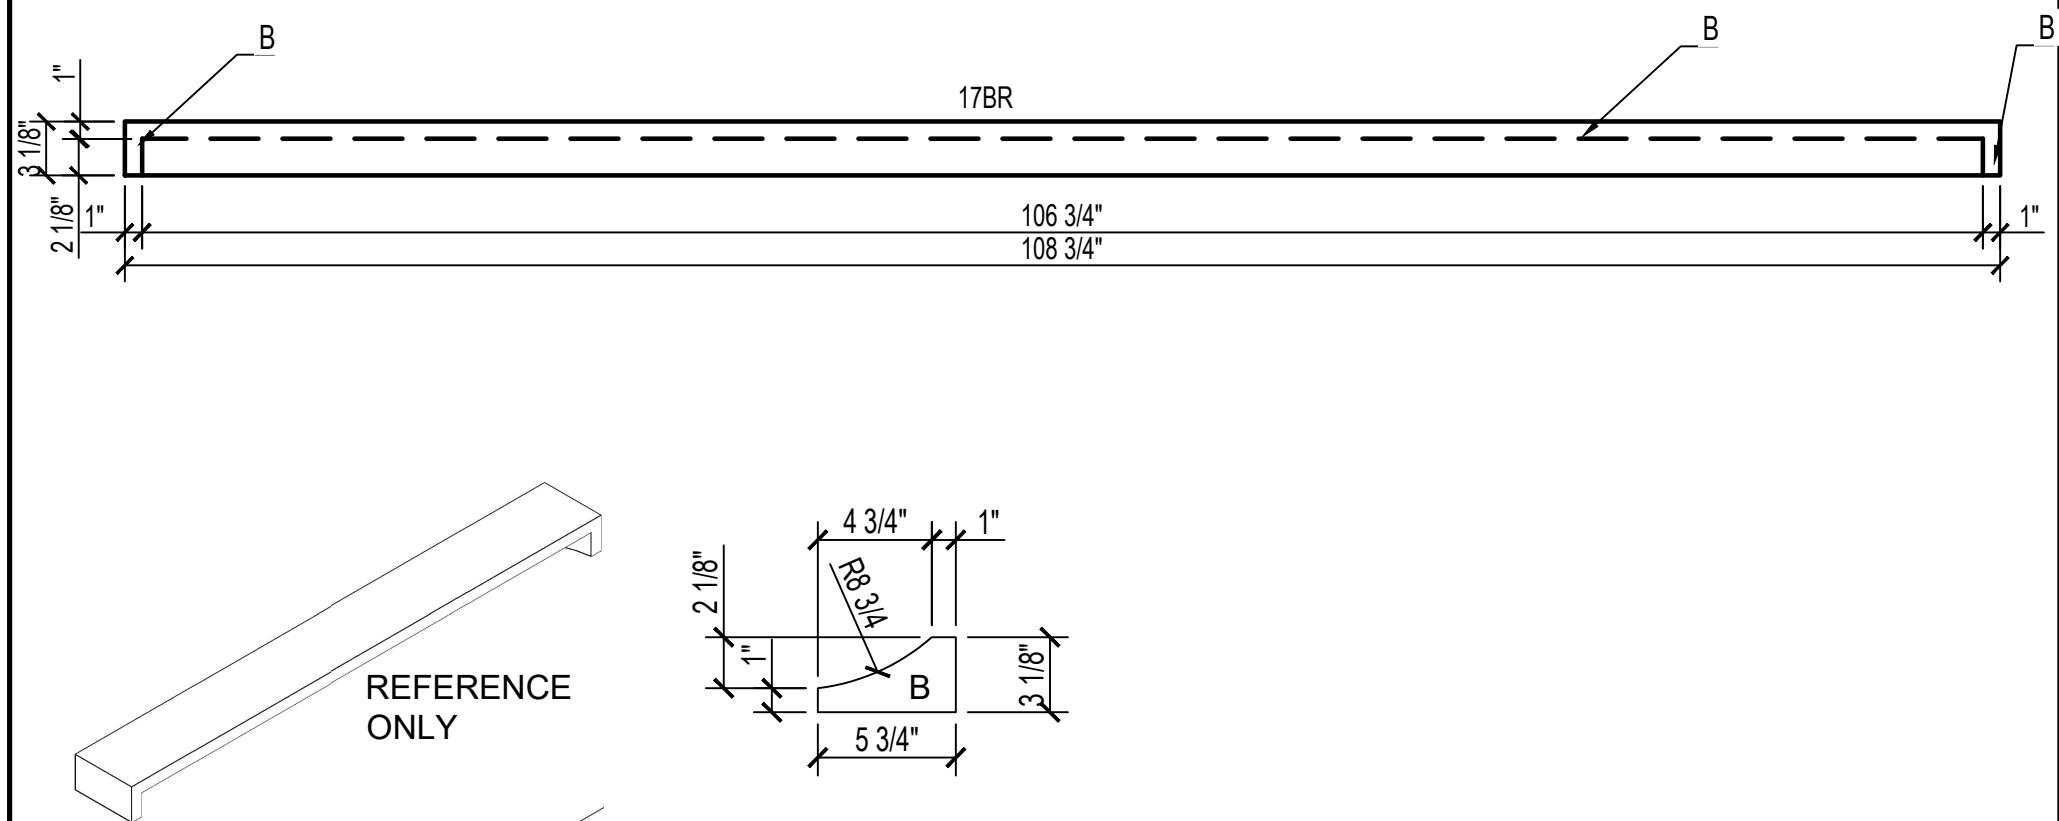

PART DESCRIPTION	DIM. A.	WIDE	DIM. B.	QTY	CUBIC FT	ARCH. SHEET	WDW / DR #	ROOM #	GRID LINE(S)	KEY #
STONE SURROUND	108 3/4"	5 3/4"	3 1/8"	1	1.31	1/2.03	W132-138	131a	B-A	17BR



820 WILLOW STREET
MANKATO MN, 56001
507-508-0684

PAGE 17BS
PAGE 17BU

JOB #: _____

SOLD TO: _____

DATE: 03/10/2021





JOB NAME: GALE ROAD

STOCK: LIMESTONE

LOCATION: WOODLAND, MN

FINISH: HONED

SECTION OR DETAIL DRAWING: 1/A6.2; 2/A6.2; 2/A8.3; 1/A6.5; 2/A6.5; 1/A6.8; 3/A68

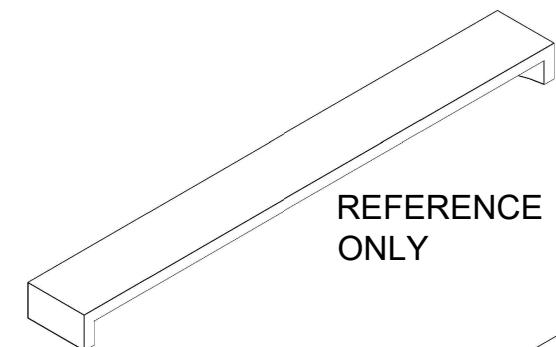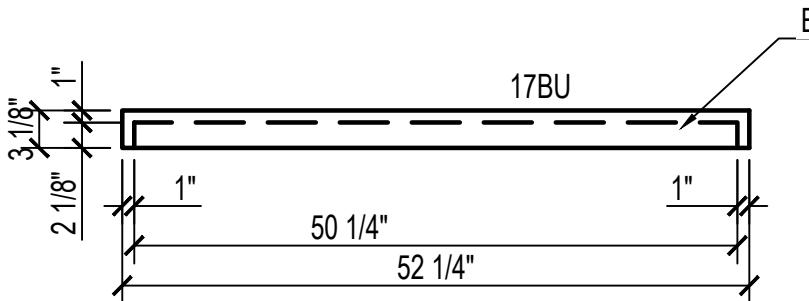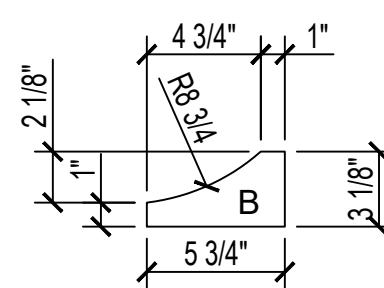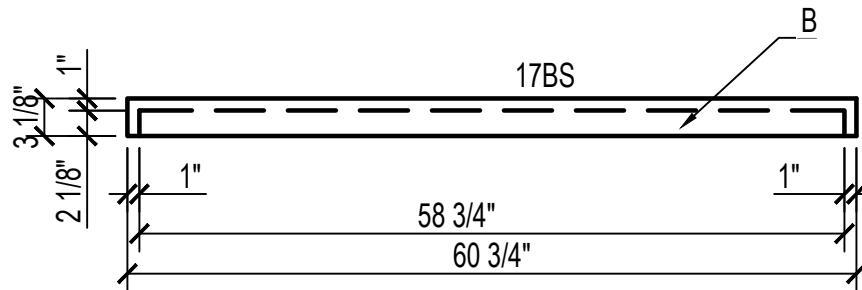

REFERENCE
ONLY

PART DESCRIPTION	DIM. A.	WIDE	DIM. B.	QTY	CUBIC FT	ARCH. SHEET	WDW / DR #	ROOM #	GRID LINE(S)	KEY #
STONE SURROUND	60 3/4"	3 1/8"	5 3/4"	1	.63	2/3.1	S113	112		17BS
STONE SURROUND	52 1/4"	3 1/8"	5 3/4"	2	1.09	2/3.1	S115a, S116a	111		17BU



820 WILLOW STREET
MANKATO MN, 56001
507-508-0684

PAGE 17BV
PAGE 17BW

JOB #: _____

SOLD TO: _____

DATE: 03/10/2021





JOB NAME: GALE ROAD

STOCK: LIMESTONE

LOCATION: WOODLAND, MN

FINISH: HONED

SECTION OR DETAIL DRAWING: 1/A6.2; 2/A6.2; 2/A8.3; 1/A6.5; 2/A6.5; 1/A6.8; 3/A68

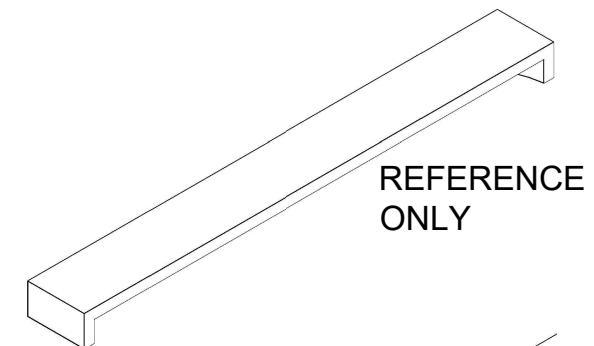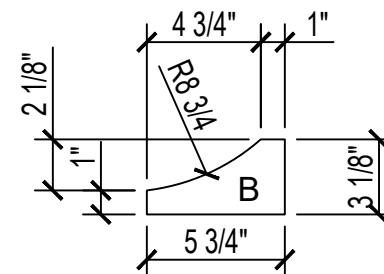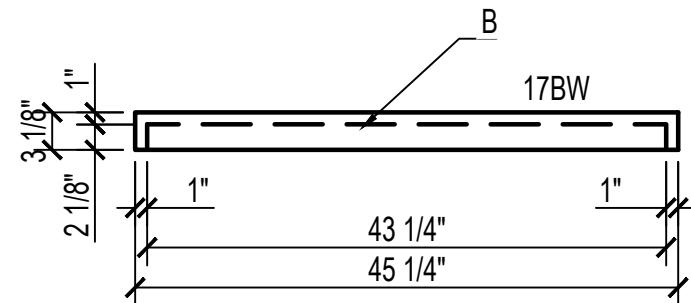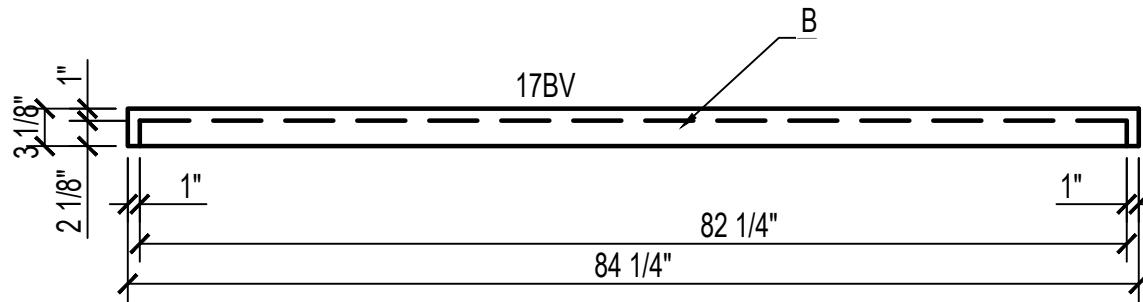

PART DESCRIPTION	DIM. A.	WIDE	DIM. B.	QTY	CUBIC FT	ARCH. SHEET	WDW / DR #	ROOM #	GRID LINE(S)	KEY #
STONE SURROUND	84 1/4"	3 1/8"	5 3/4"	1	.87	2/2.02	W142,144	115	5-4	17BV
STONE SURROUND	44 3/4"	3 1/8"	5 3/4"	1	.47	2/2.02	W146	115	5-4	17BW

JOB #: _____

SOLD TO: _____

JOB NAME: GALE ROAD



LOCATION: WOODLAND, MN

SECTION OR DETAIL DRAWING: 2/A6.2; 5/A8.3a

DATE: 03/10/2021

STOCK: LIMESTONE

FINISH: HONED

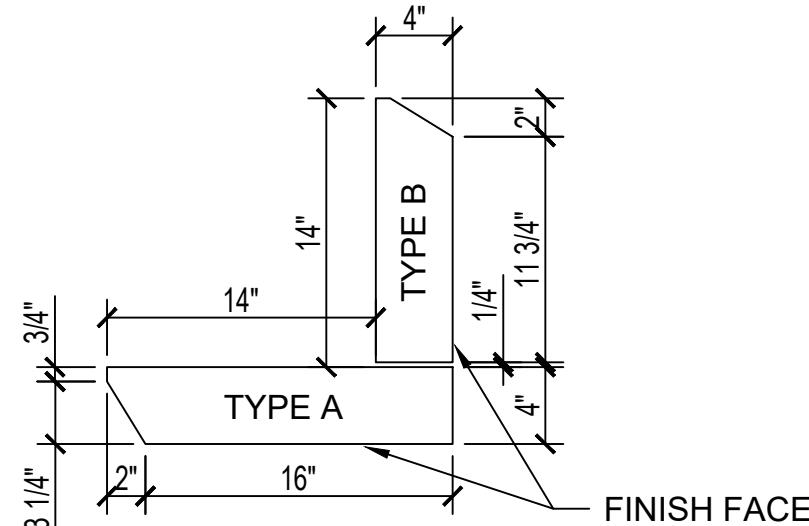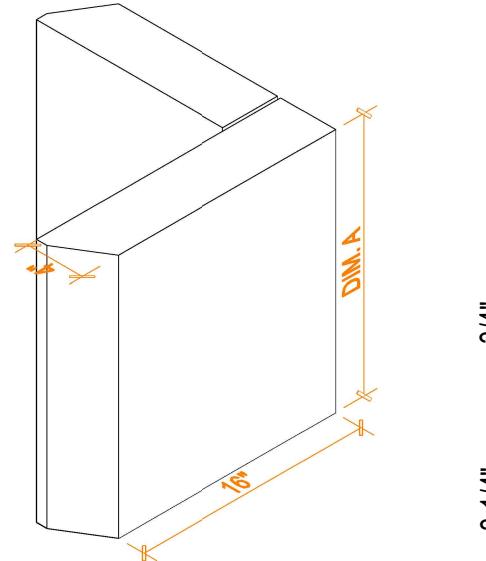

**FIELD CUT AS REQ'D
REQ'D AT CORNERS

PART DESCRIPTION	DIM. A.	WIDE	LENGTH	QTY	CUBIC FT	ARCH. SHEET	WDW / DR #	ROOM #	GRID LINE(S)	KEY #
CORNER PIECES-TYPE A	36 9/16"	4"	18"	1	1.52	2/3.1	S113	112		18L
CORNER PIECES-TYPE A	36 1/2"	4"	18"	4	6.08	2/A2.01	W127-141	112	6-5	18P
CORNER PIECES-TYPE B	36 7/16"	4"	13 3/4"	2	2.32	2/A2.01	W127-141	112	6-5	18Q
CORNER PIECES-TYPE A	35 3/4"	4"	18"	4	5.96	1/2.03	N133, N139	131a	B-A	18S
CORNER PIECES-TYPE A	35 7/8"	4"	18"	4	5.98	1/2.01, 2/2.01	E177, W102	131a	9	18T **
CORNER PIECES-TYPE B	35 7/8"	4"	13 3/4"	2	2.28	1/2.03	N133, N139	131a	B-A	18U
CORNER PIECES-TYPE A	35 3/4"	4"	13 3/4"	8	9.10	1/2.01, 2/2.01	E177, W102	131a	9	18V **
CORNER PIECES-TYPE B	36 1/2"	4"	13 3/4"	2	2.32	2/3.1	S113	112		18W
CORNER PIECES-TYPE A	10 1/2"	4"	7 1/2"	2	.36	1/2.01, 2/2.01	E177, W102	131a	9	18X



820 WILLOW STREET
MANKATO MN, 56001
507-508-0684

PAGE 21

JOB #: _____

SOLD TO: _____

DATE: 03/10/2021

JOB NAME: GALE ROAD


STOCK: LIMESTONE

LOCATION: WOODLAND, MN


FINISH: HONED

SECTION OR DETAIL DRAWING: 3/A6.4; 8/A8.2

PART DESCRIPTION	DIM. A.	WIDE	HEIGHT	QTY	CUBIC FT	ARCH. SHEET	WDW / DR #	ROOM #	GRID LINE(S)	KEY #
CUT STONE SILL	120 1/4"	18 1/2"	8 1/4"	1		1/2.01	E228-232	212	5-6	21J

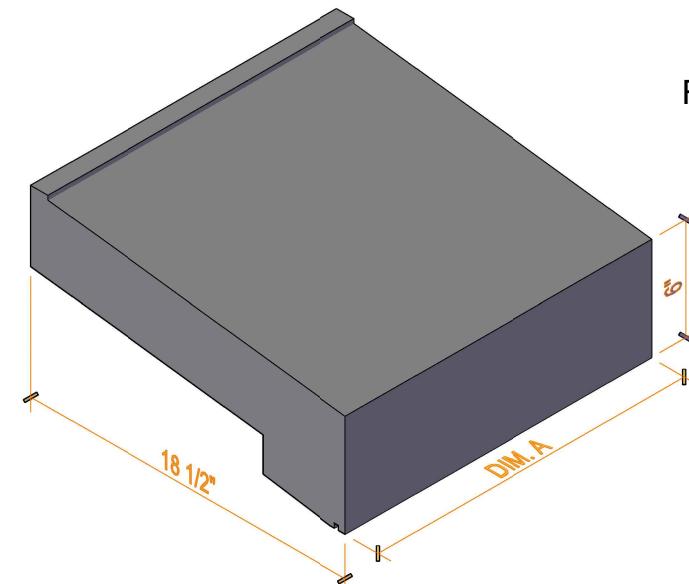

FINISH FACE

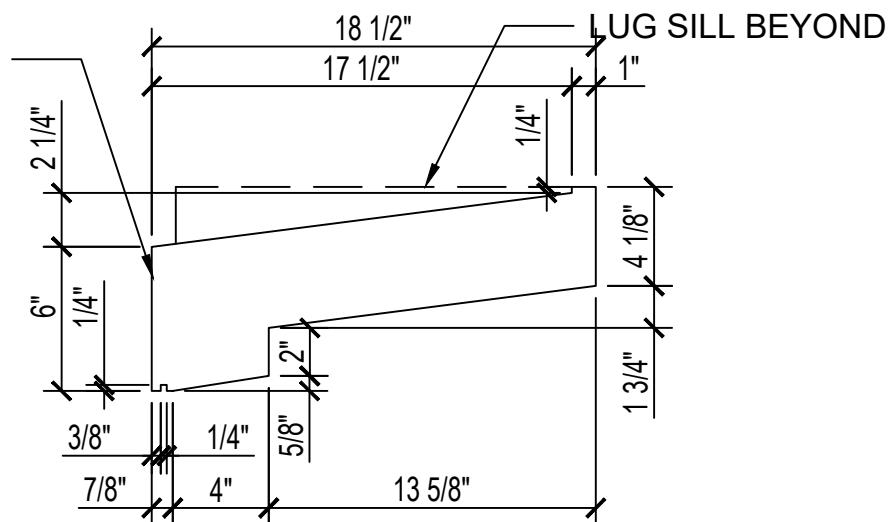






820 WILLOW STREET
MANKATO MN, 56001
507-508-0684

PAGE 21J

JOB #: _____
SOLD TO: _____
JOB NAME: GALE ROAD
LOCATION: WOODLAND, MN
SECTION OR DETAIL DRAWING: 3/A6.4; 8/A8.2

DATE: 03/10/2021
STOCK: LIMESTONE
FINISH: HONED

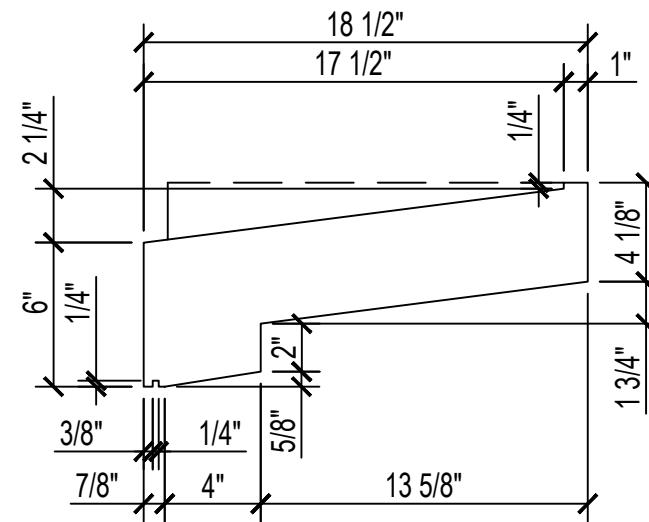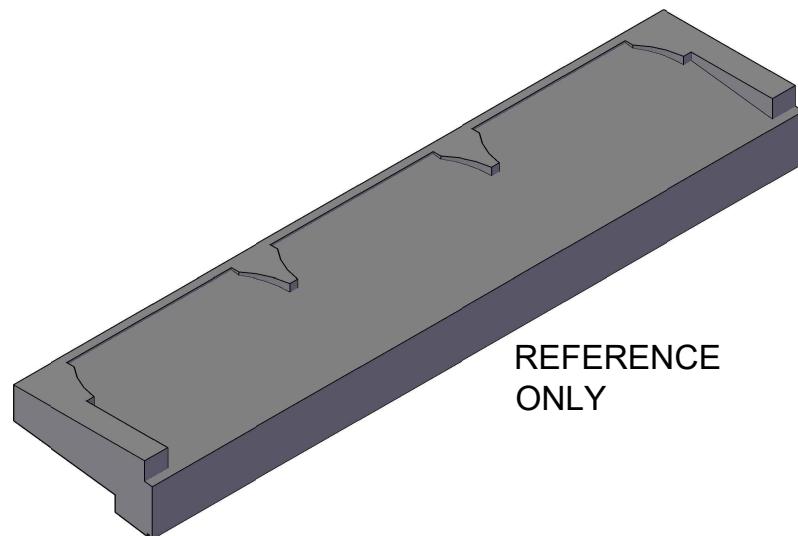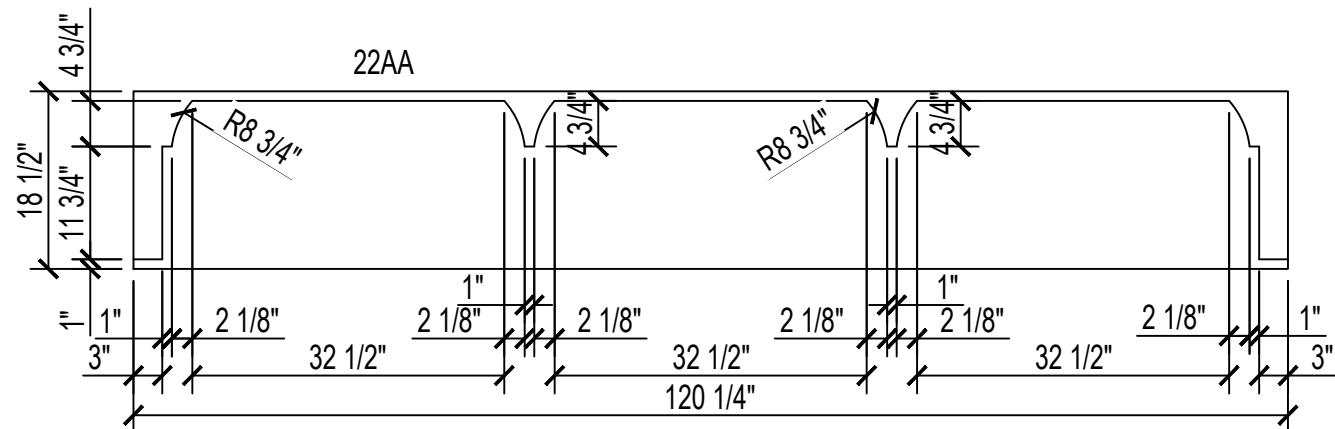

PART DESCRIPTION	DIM. A.	WIDE	HEIGHT	QTY	CUBIC FT	ARCH. SHEET	WDW / DR #	ROOM #	GRID LINE(S)	KEY #
CUT STONE SILL	120 1/4"	18 1/2"	8 1/4"	1		1/2.01	E228-232	212	5-6	21J




820 WILLOW STREET
MANKATO MN, 56001
507-508-0684

PAGE 22


JOB #: _____
SOLD TO: _____
JOB NAME: GALE ROAD
LOCATION: WOODLAND, MN
SECTION OR DETAIL DRAWING: 4/A6.4, 2/A8.2, 7/A6.4

DATE: 03/10/2021
STOCK: LIMESTONE
FINISH: HONED

REFERENCE SHEET
SEE 22AA, 22AB, 22AD, 22AE, 22AG, 22AJ,
22AK, 22AL FOR INDIVIDUAL PARTS

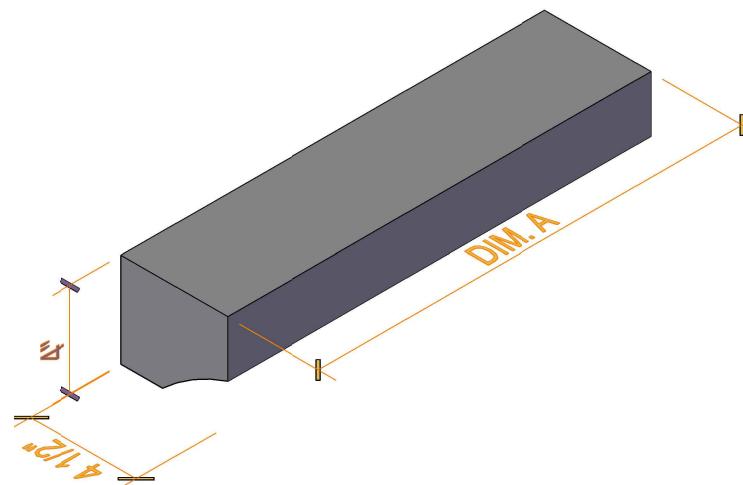

FINISH FACE

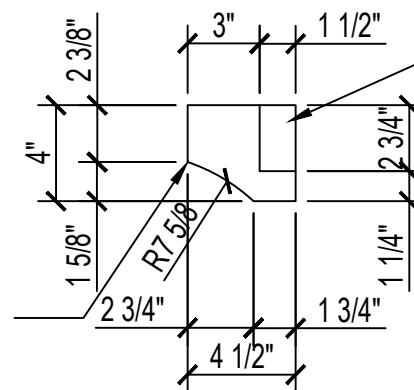

NOTCH TO BE
CUT IN FIELD
AS REQ'D



820 WILLOW STREET
MANKATO MN, 56001
507-508-0684

PAGE 22AA

JOB #: _____

SOLD TO: _____

JOB NAME: GALE ROAD



LOCATION: WOODLAND, MN

SECTION OR DETAIL DRAWING: 4/A6.4, 2/A8.2, 7/A6.4




DATE: 03/10/2021

STOCK: LIMESTONE

FINISH: HONED

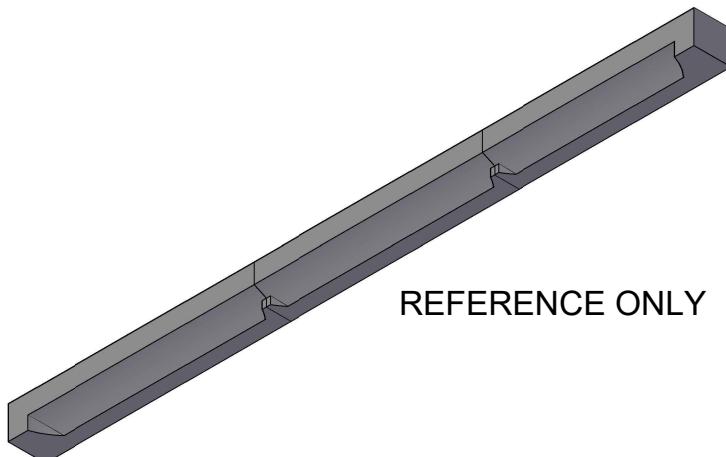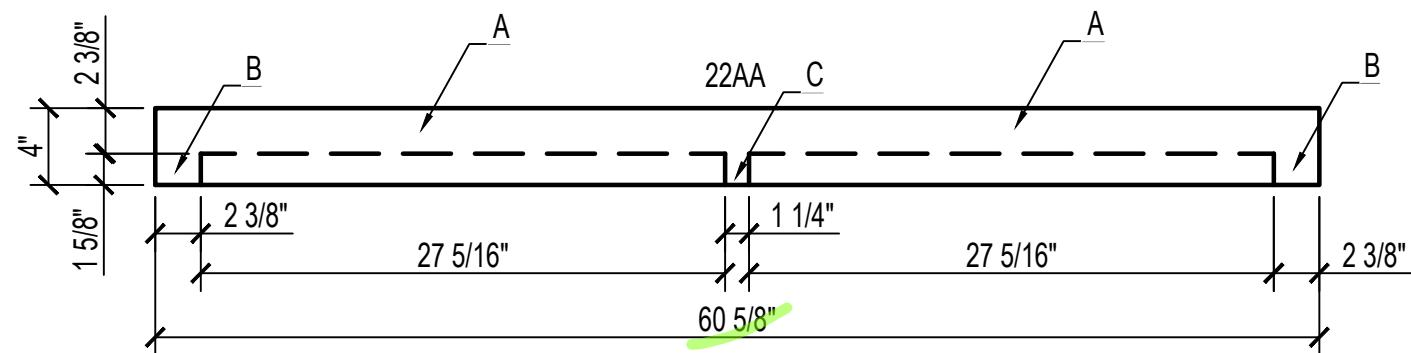

REFERENCE ONLY

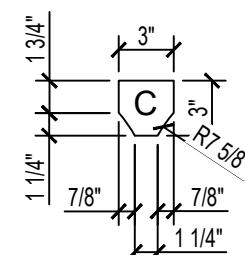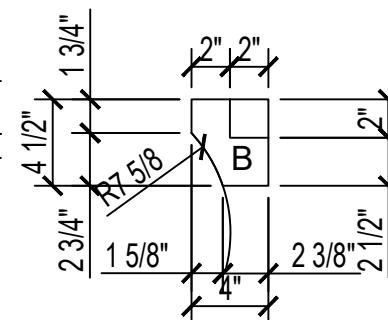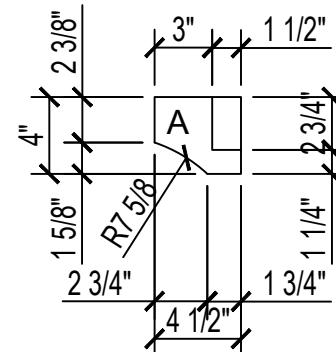

PART DESCRIPTION	DIM. A.	WIDE	HEIGHT	QTY	CUBIC FT	ARCH. SHEET	WDW / DR #	ROOM #	GRID LINE(S)	KEY #
WDW HEADER	60 5/8"	4 1/2"	4"	2	1.263	1/2.02	E215, E220	209b, 213a	4-5	22AA




820 WILLOW STREET
MANKATO MN, 56001
507-508-0684





PAGE 22AB
PAGE 22AC

JOB #: _____
SOLD TO: _____
JOB NAME: GALE ROAD
LOCATION: WOODLAND, MN
SECTION OR DETAIL DRAWING: 4/A6.4, 2/A8.2, 7/A6.4

DATE: 03/10/2021
STOCK: LIMESTONE
FINISH: HONED

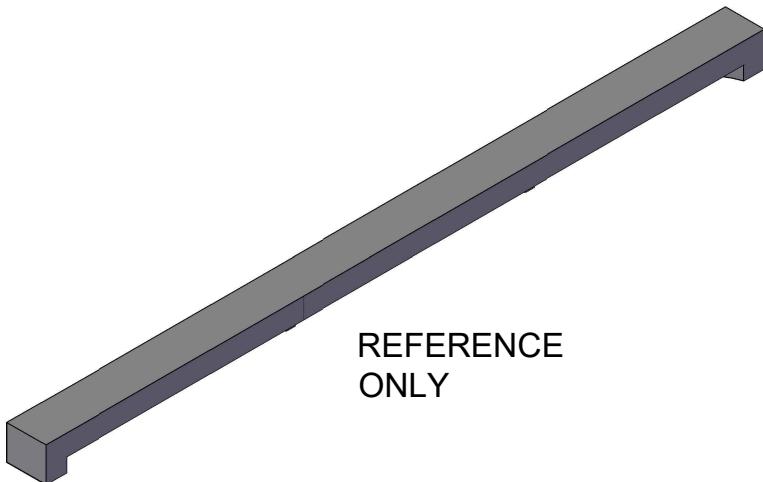

REFERENCE
ONLY

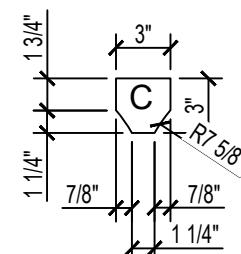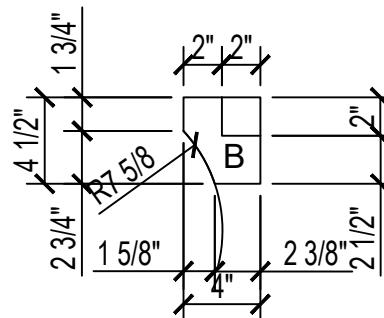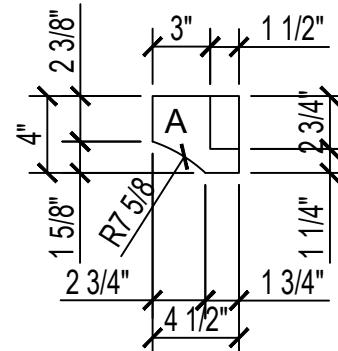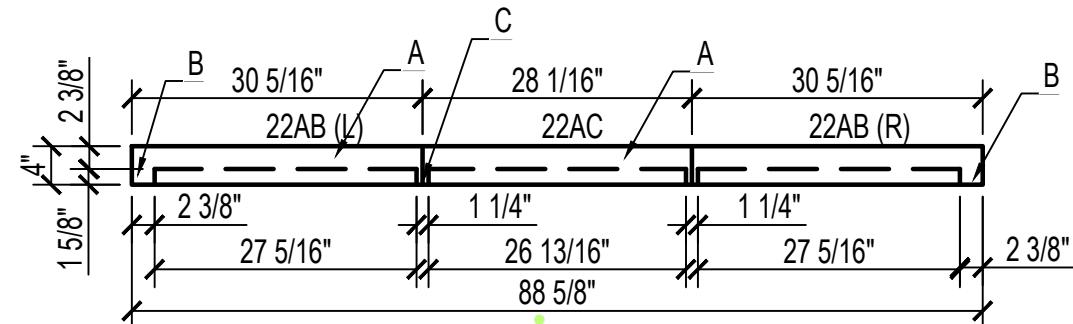

PART DESCRIPTION	DIM. A.	WIDE	HEIGHT	QTY	CUBIC FT	ARCH. SHEET	WDW / DR #	ROOM #	GRID LINE(S)	KEY #
WDW HEADER	30 5/16"	4 1/2"	4"	1(R) 1(L)	.63	1/2.02	E217, E219	213b	4-5	22AB
WDW HEADER	28"	4 1/2"	4"	1	.29	1/2.02	E218	213b	4-5	22AC



820 WILLOW STREET
MANKATO MN, 56001
507-508-0684

PAGE 22AD

JOB #: _____

SOLD TO: _____

DATE: 03/10/2021




JOB NAME: GALE ROAD

STOCK: LIMESTONE

LOCATION: WOODLAND, MN

FINISH: HONED

SECTION OR DETAIL DRAWING: 4/A6.4, 2/A8.2, 7/A6.4

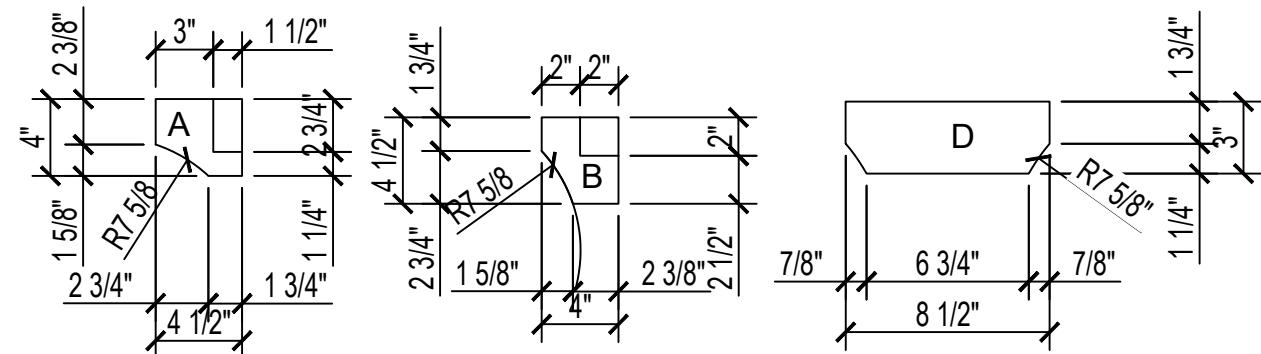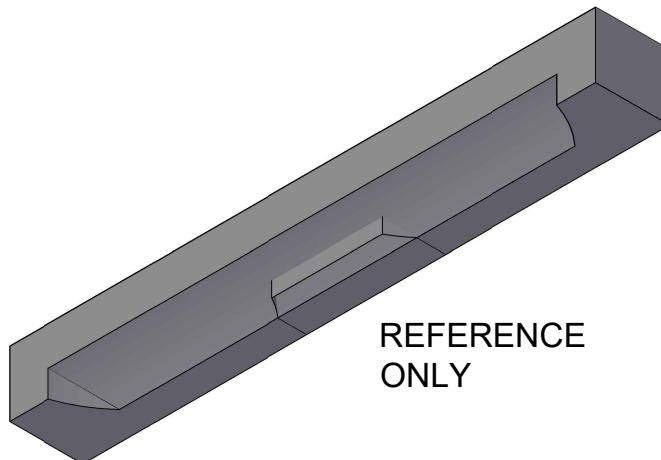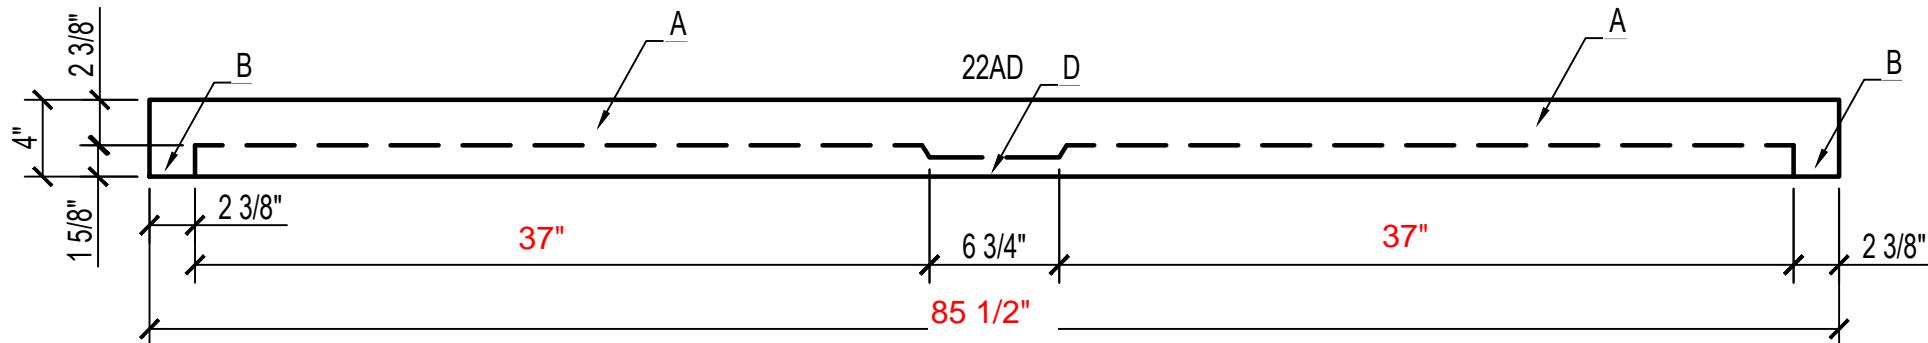

PART DESCRIPTION	DIM. A.	WIDE	HEIGHT	QTY	CUBIC FT	ARCH. SHEET	WDW / DR #	ROOM #	GRID LINE(S)	KEY #
WDW HEADER	85 1/2"	4 1/2"	4"	2	1.83	1/2.01	E233-234, E241-242	215	6-7	22AD



820 WILLOW STREET
MANKATO MN, 56001
507-508-0684

PAGE 22AE
PAGE 22AF

JOB #: _____

SOLD TO: _____

DATE: 03/10/2021


JOB NAME: GALE ROAD

STOCK: LIMESTONE

LOCATION: WOODLAND, MN

FINISH: HONED

SECTION OR DETAIL DRAWING: 4/A6.4, 2/A8.2, 7/A6.4

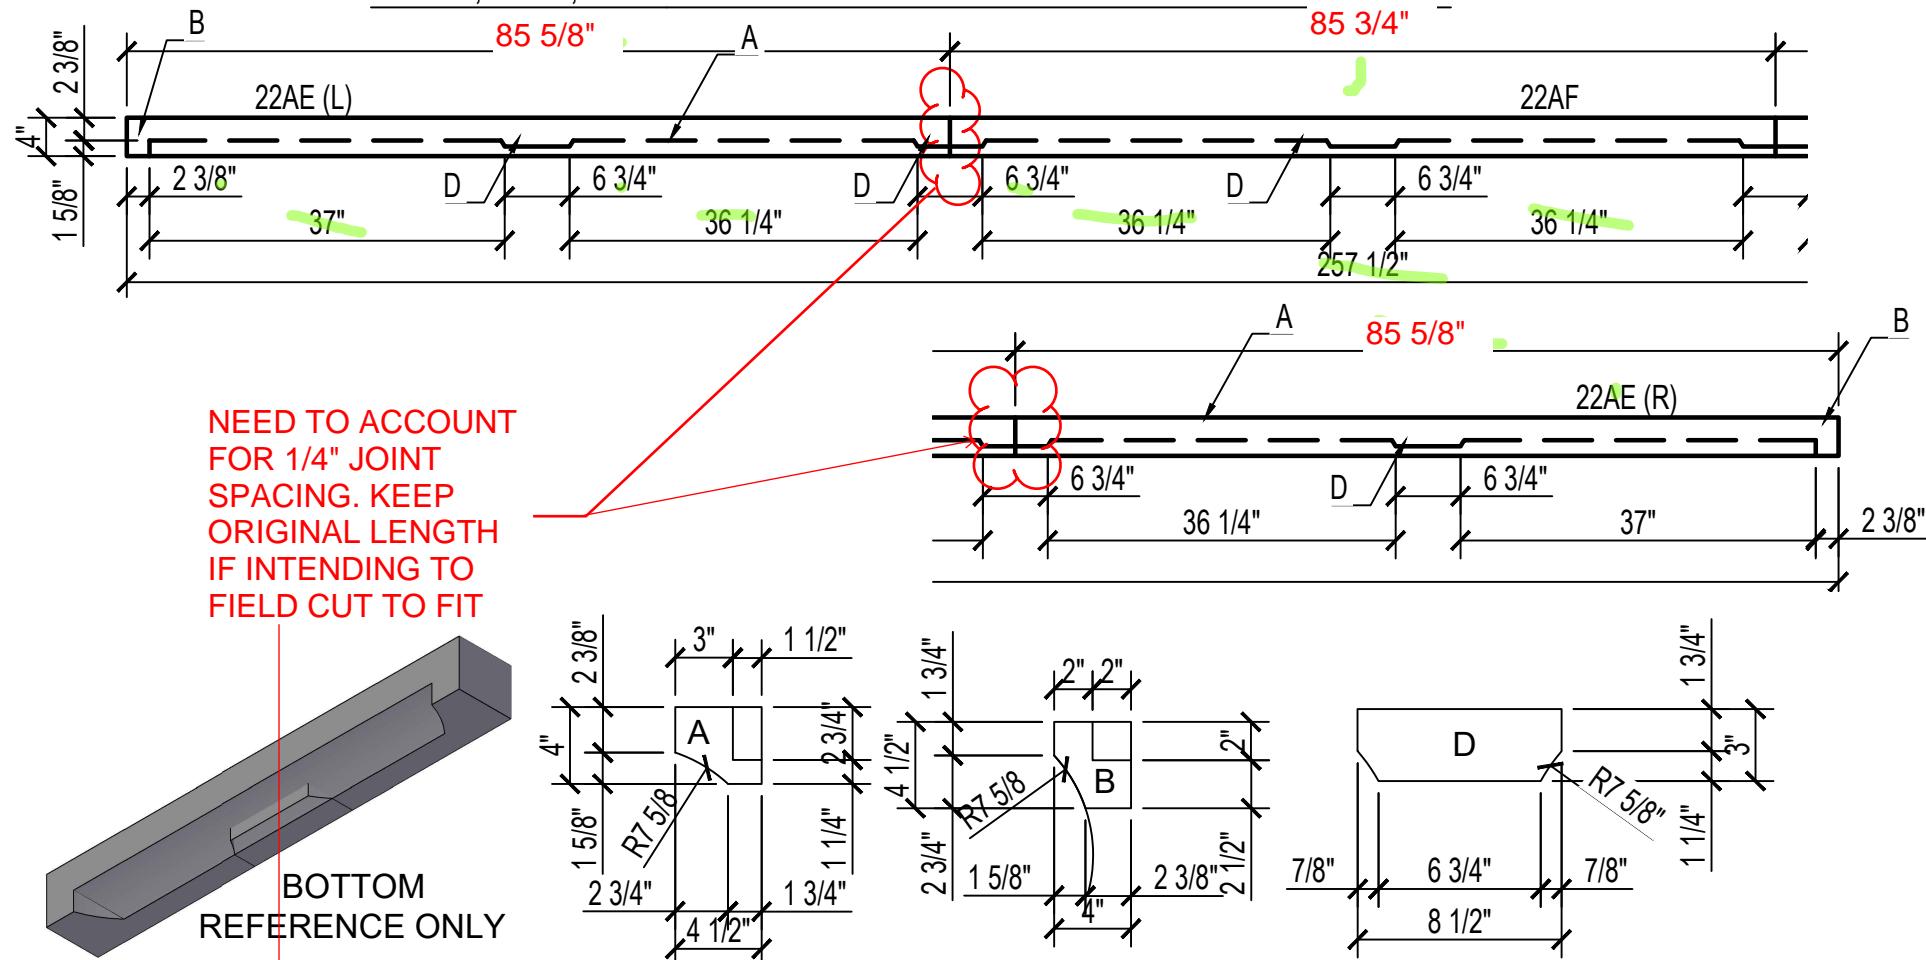

PART DESCRIPTION	DIM. A.	WIDE	HEIGHT	QTY	CUBIC FT	ARCH. SHEET	WDW / DR #	ROOM #	GRID LINE(S)	KEY #
WDW HEADER	85 3/4"	4 1/2"	4"	1(R) 1(L)	1.79	1/2.01	E235-236, E239-240	215	6-7	22AE
WDW HEADER	86"	4 1/2"	4"	1	.90	1/2.01	E237-238	215	6-7	22AF



820 WILLOW STREET
MANKATO MN, 56001
507-508-0684

PAGE 22AG
PAGE 22AH

JOB #: _____

SOLD TO: _____

JOB NAME: GALE ROAD






LOCATION: WOODLAND, MN

SECTION OR DETAIL DRAWING: 4/A6.4, 2/A8.2, 7/A6.4

DATE: 03/10/2021

STOCK: LIMESTONE

FINISH: HONED

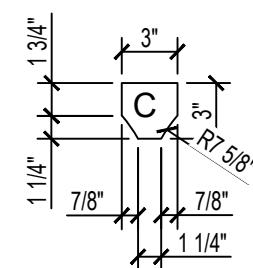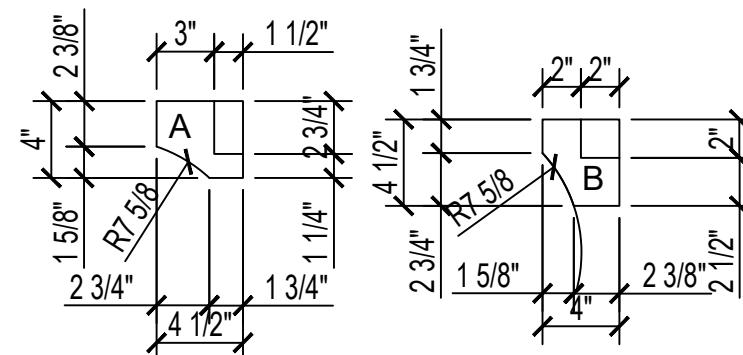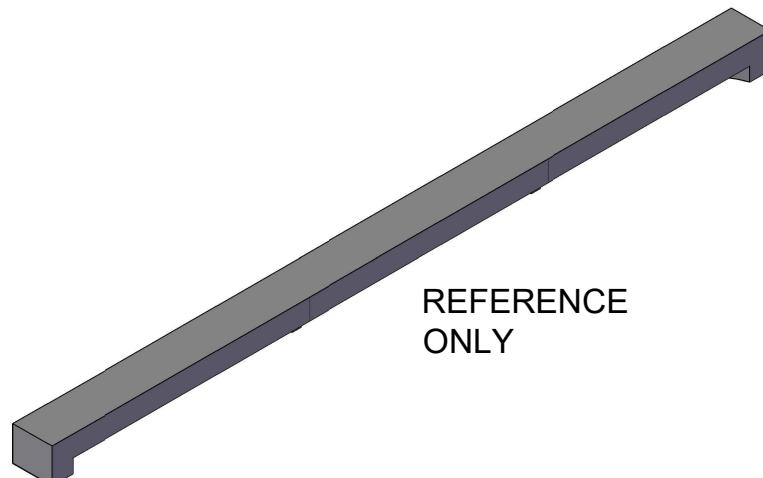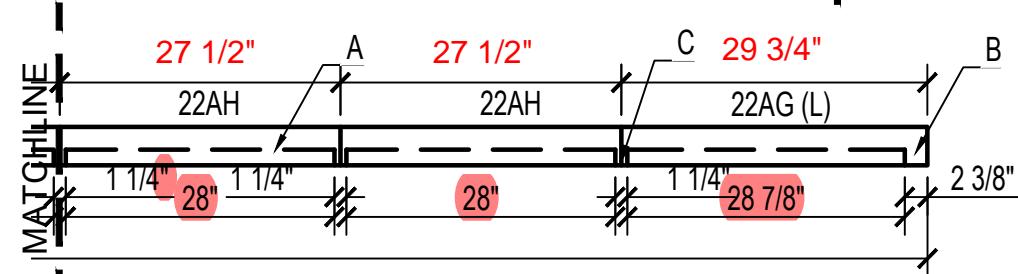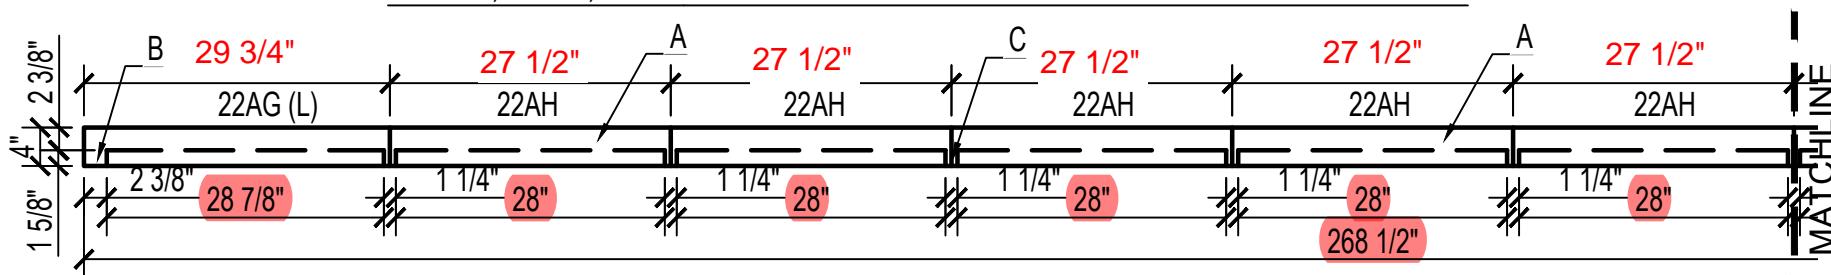

PART DESCRIPTION	DIM. A.	WIDE	HEIGHT	QTY	CUBIC FT	ARCH. SHEET	WDW / DR #	ROOM #	GRID LINE(S)	KEY #
WDW HEADER	29 3/4"	4 1/2"	4"	1(R) 1(L)	.66	2/2.02	W222, W230	209a	5-4	22AG
WDW HEADER	27 1/2"	4 1/2"	4"	7	2.13	2/2.02	W223-229	209a	5-4	22AH



820 WILLOW STREET
MANKATO MN, 56001
507-508-0684

PAGE 22AJ

JOB #: _____

SOLD TO: _____

DATE: 03/10/2021






JOB NAME: GALE ROAD

STOCK: LIMESTONE

LOCATION: WOODLAND, MN

FINISH: HONED

SECTION OR DETAIL DRAWING: 4/A6.4, 2/A8.2, 7/A6.4

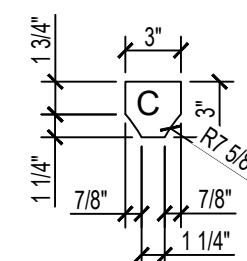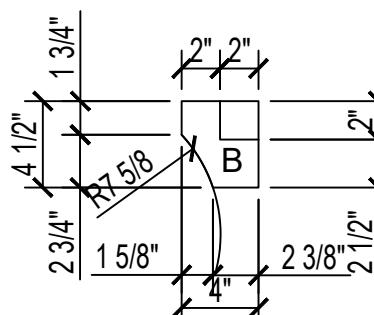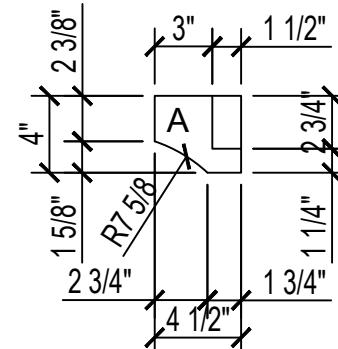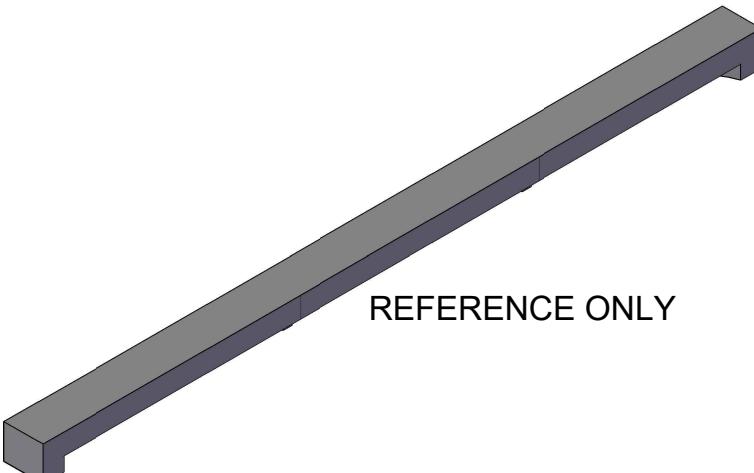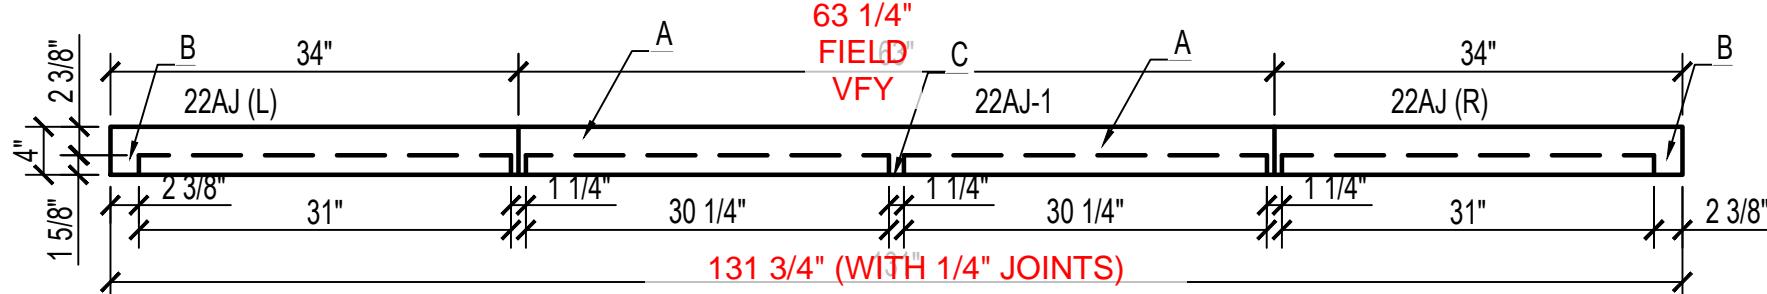

PART DESCRIPTION	DIM. A.	WIDE	HEIGHT	QTY	CUBIC FT	ARCH. SHEET	WDW / DR #	ROOM #	GRID LINE(S)	KEY #
WDW HEADER	34"	4 1/2"	4"	1(R) 1(L)	.71	2/2.04	N212-215	212	E	22AJ
WDW HEADER	63 1/4	4 1/2"	4"	1	.67	2/2.04	N212-215	212	E	22AJ-1



820 WILLOW STREET
MANKATO MN, 56001
507-508-0684

PAGE 22AK

JOB #: _____

SOLD TO: _____

JOB NAME: GALE ROAD





LOCATION: WOODLAND, MN

SECTION OR DETAIL DRAWING: 4/A6.4, 2/A8.2, 7/A6.4

DATE: 03/10/2021

STOCK: LIMESTONE

FINISH: HONED

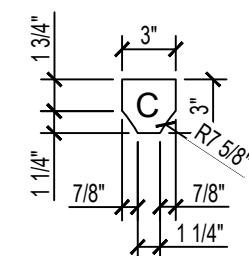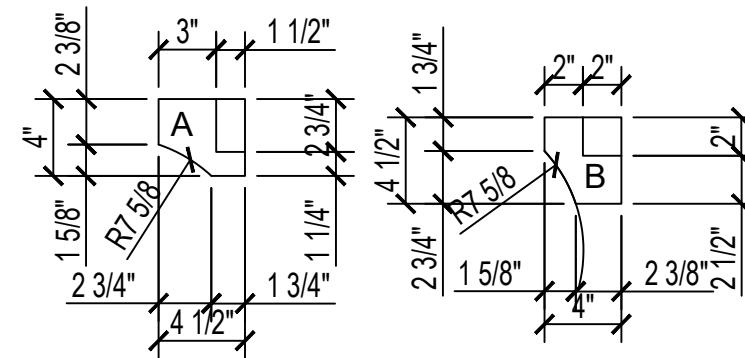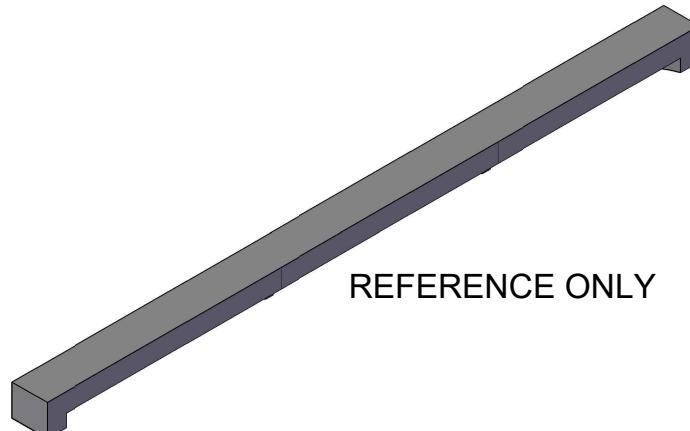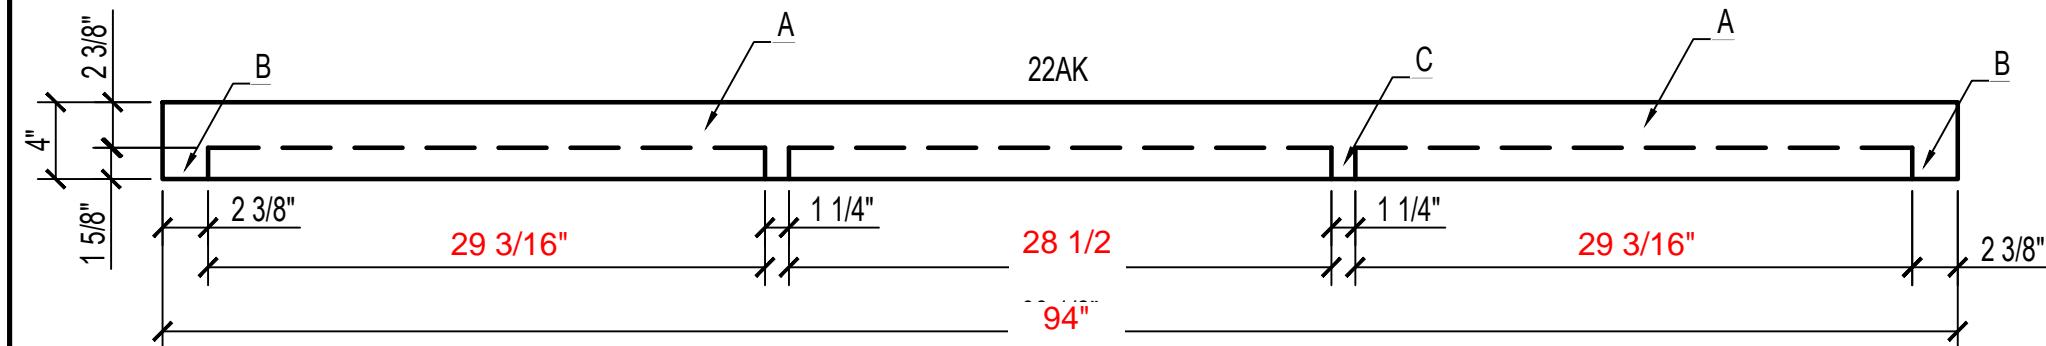

PART DESCRIPTION	DIM. A.	WIDE	HEIGHT	QTY	CUBIC FT	ARCH. SHEET	WDW / DR #	ROOM #	GRID LINE(S)	KEY #
WDW HEADER	94"	4 1/2"	4"	2	1.95	2/3.1	S215-207, S213-215		A-B	22AK






820 WILLOW STREET
MANKATO MN, 56001
507-508-0684

PAGE 22AL
PAGE 22AF

JOB #: _____
SOLD TO: _____
JOB NAME: GALE ROAD
LOCATION: WOODLAND, MN
SECTION OR DETAIL DRAWING: 4/A6.4, 2/A8.2, 7/A6.4

DATE: 03/10/2021
STOCK: LIMESTONE
FINISH: HONED

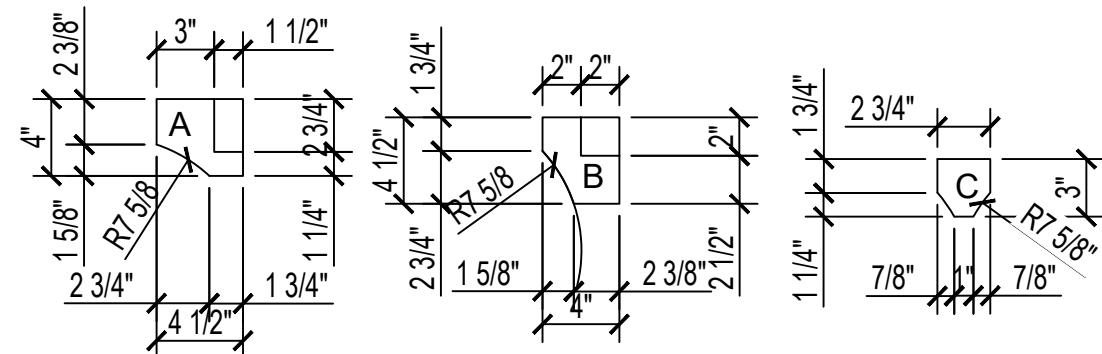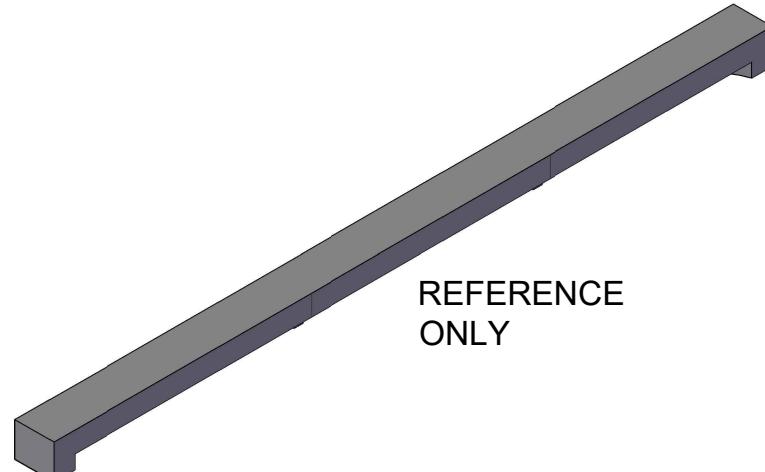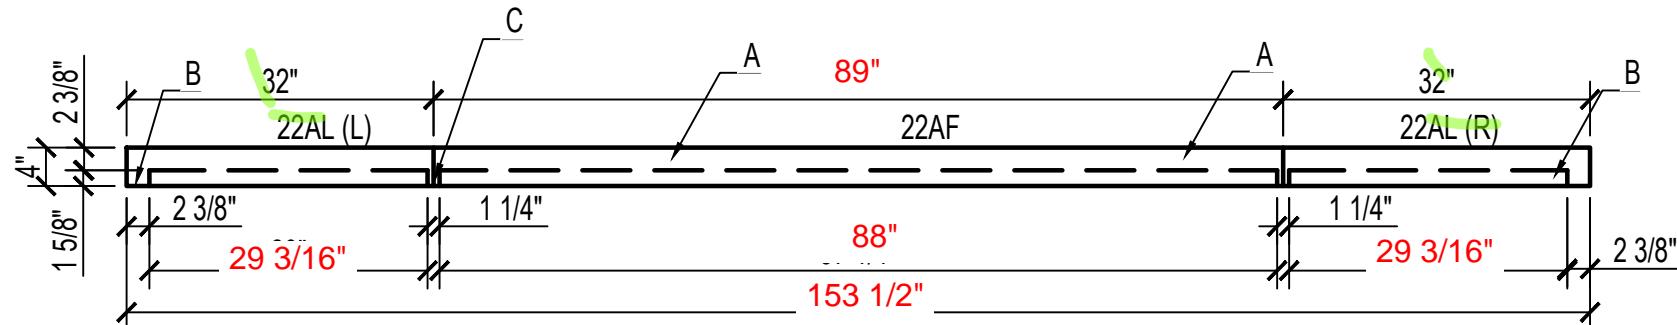

PART DESCRIPTION	DIM. A.	WIDE	HEIGHT	QTY	CUBIC FT	ARCH. SHEET	WDW / DR #	ROOM #	GRID LINE(S)	KEY #
WDW HEADER	32"	4 1/2"	4"	1(R) 1(L)	.67	2/3.1	S208, S212		A-B	22AL
WDW HEADER	89"	4 1/2"	4"	1	.92	2/3.1	S209-211		A-B	22AF

JOB #: _____

SOLD TO: _____

DATE: 03/10/2021

JOB NAME: GALE ROAD



STOCK: LIMESTONE

LOCATION: WOODLAND, MN

FINISH: HONED

SECTION OR DETAIL DRAWING: 5/A6.4, 1/A8.2

PART DESCRIPTION	DIM. A.	WIDE	HEIGHT	QTY	CUBIC FT	ARCH. SHEET	WDW / DR #	ROOM #	GRID LINE(S)	KEY #
WDW JAMB	46 1/16"	4"	4 1/2"	6	2.88	1/2.02	E215-221	209a,213a,213b	4-5	23J
WDW JAMB	34 3/4"	4"	4 1/2"	4	1.45	1/2.01	E233-234, E241-242	215	6-7	23K
WDW JAMB	49 15/16"	4"	4 1/2"	2	1.04	1/2.01	E235, E240	215	6-7	23L
WDW JAMB	44"	4"	4 1/2"	2	.92	2/2.02	W222, W230	209a	5-4	23M
WDW JAMB	28 1/2"	4"	4 1/2"	2	.59	2/2.04	N212, N215	212	E	23N
WDW JAMB	46 1/16"	4"	4 1/2"	6	2.88	2/3.1	S205-215		A-B	23J

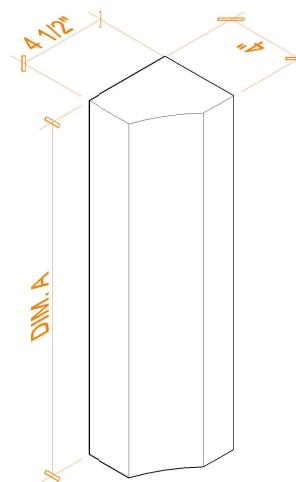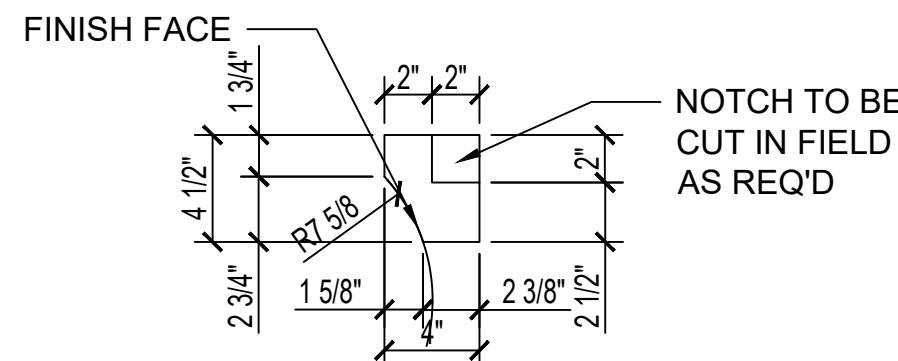



820 WILLOW STREET
MANKATO MN, 56001
507-508-0684


PAGE 25

JOB #: _____
SOLD TO: _____
JOB NAME: GALE ROAD
LOCATION: WOODLAND, MN
SECTION OR DETAIL DRAWING: 6/A6.4a, 9/A8.2, 9/A6.4


DATE: 03/10/2021
STOCK: LIMESTONE
FINISH: HONED

REFERENCE SHEET

SEE PAGE 25J, 25K, 25M, 25N, 25Q, 25R, AND
25S FOR INDIVIDUAL PARTS

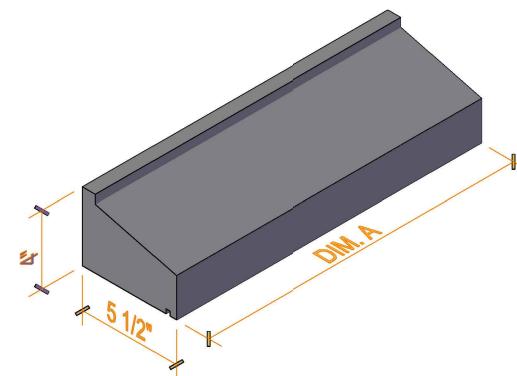

LUG SILL BEYOND
FINISH FACE

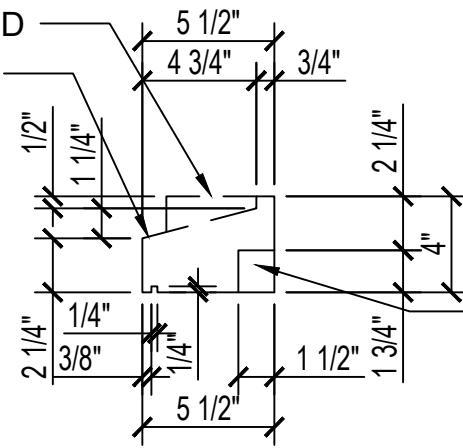

NOTCH TO BE
CUT IN FIELD
AS REQ'D






820 WILLOW STREET
MANKATO MN, 56001
507-508-0684

PAGE 25J

JOB #: _____
SOLD TO: _____
JOB NAME: GALE ROAD
LOCATION: WOODLAND, MN
SECTION OR DETAIL DRAWING: 6/A6.4a, 9/A8.2, 9/A6.4

DATE: 03/10/2021
STOCK: LIMESTONE
FINISH: HONED

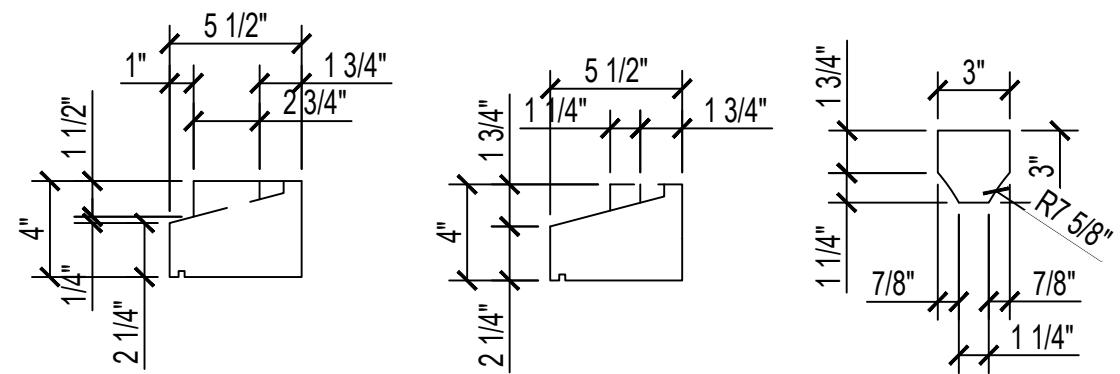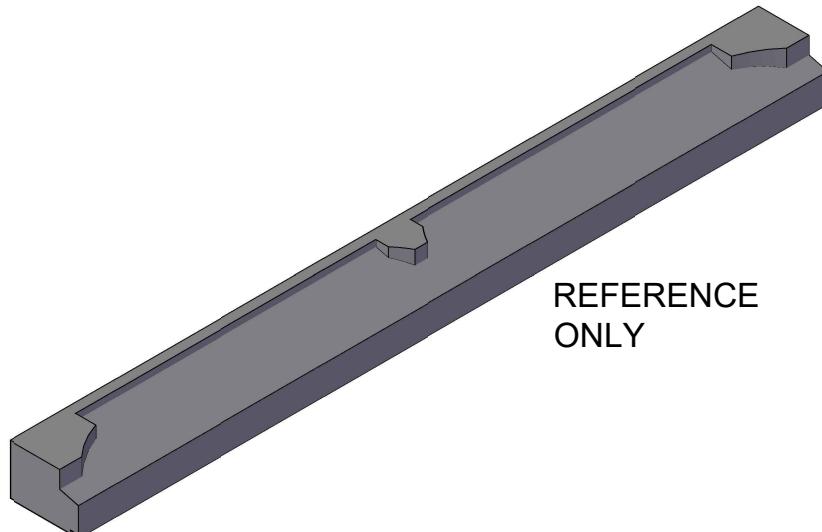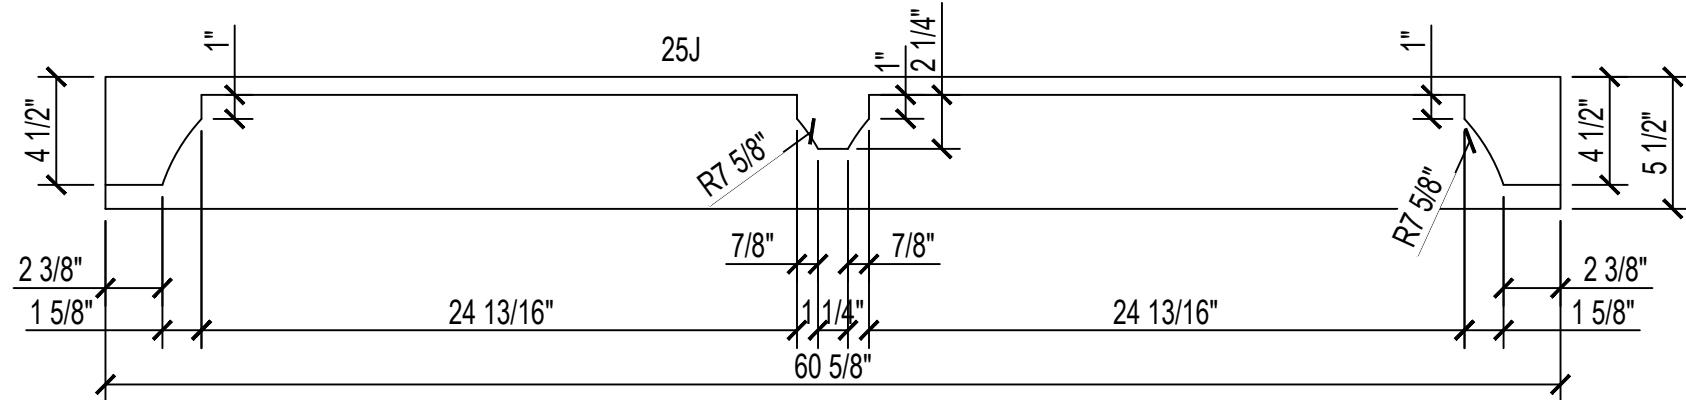

PART DESCRIPTION	DIM. A.	WIDE	DIM. B.	QTY	CUBIC FT	ARCH. SHEET	WDW / DR #	ROOM #	GRID LINE(S)	KEY #
WDW SILL	60 5/8"	5 1/2"	4"	2	1.54	1/2.02	E215, E220	209a, 213a	4-5	25J






820 WILLOW STREET
MANKATO MN, 56001
507-508-0684

PAGE 25K
PAGE 25L

JOB #: _____
SOLD TO: _____
JOB NAME: GALE ROAD
LOCATION: WOODLAND, MN
SECTION OR DETAIL DRAWING: 6/A6.4a, 9/A8.2, 9/A6.4

DATE: 03/10/2021
STOCK: LIMESTONE
FINISH: HONED

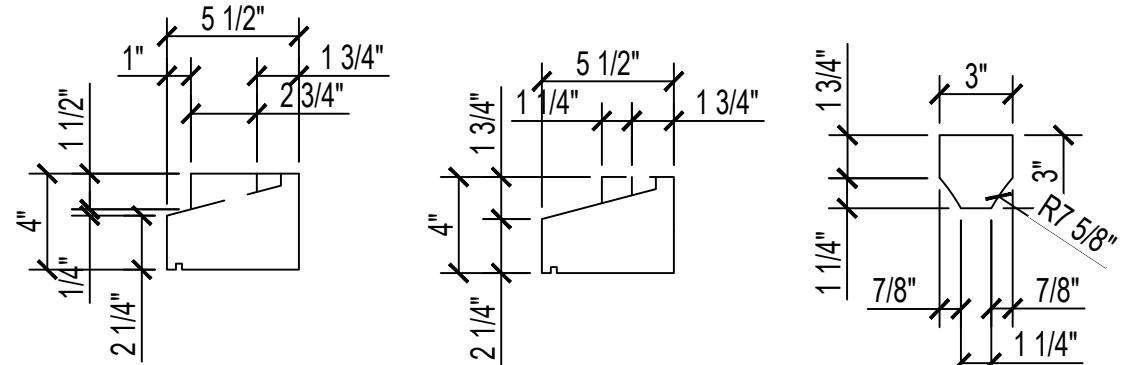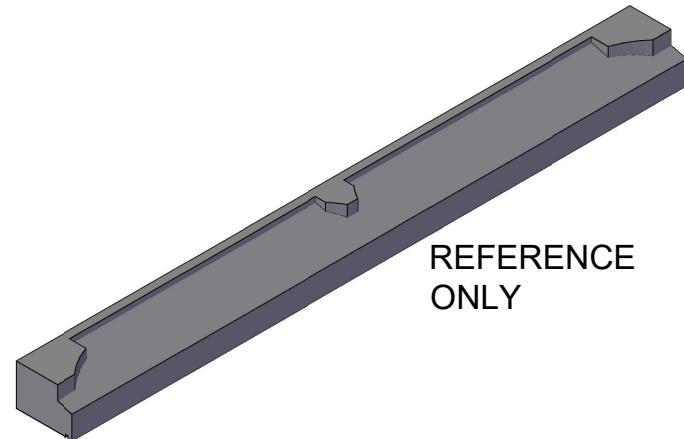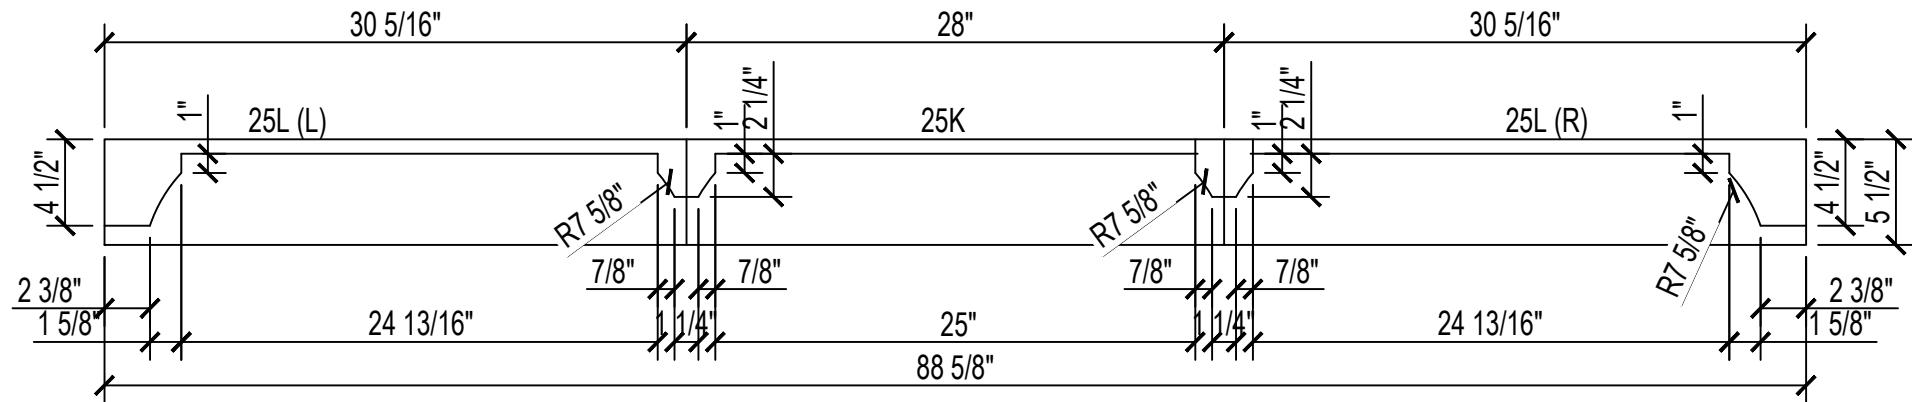

PART DESCRIPTION	DIM. A.	WIDE	DIM. B.	QTY	CUBIC FT	ARCH. SHEET	WDW / DR #	ROOM #	GRID LINE(S)	KEY #
WDW SILL	30 5/16"	5 1/2"	4"	1 (R)1(L)	.77	1/A2.02	E217, E219	213b	4-5	25K
WDW SILL	28"	5 1/2"	4"	1	.36	1/A2.02	E218	213b	4-5	25L



820 WILLOW STREET
MANKATO MN, 56001
507-508-0684

PAGE 25M

JOB #: _____

SOLD TO: _____

DATE: 03/10/2021




JOB NAME: GALE ROAD

STOCK: LIMESTONE

LOCATION: WOODLAND, MN

FINISH: HONED

SECTION OR DETAIL DRAWING: 6/A6.4a, 9/A8.2, 9/A6.4

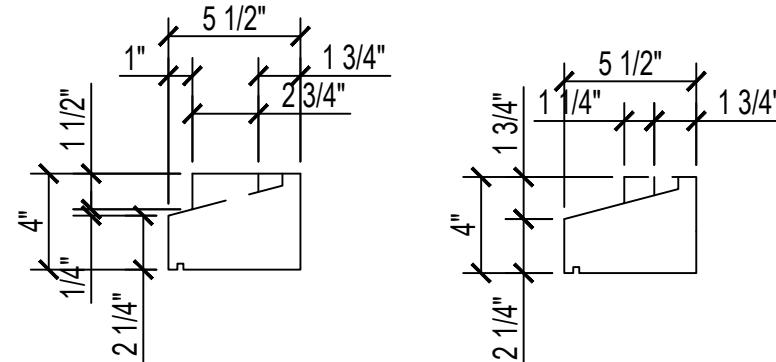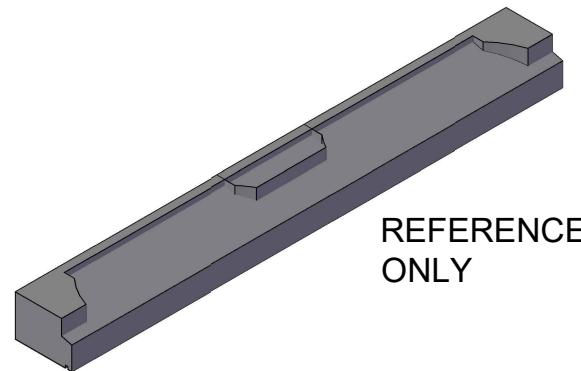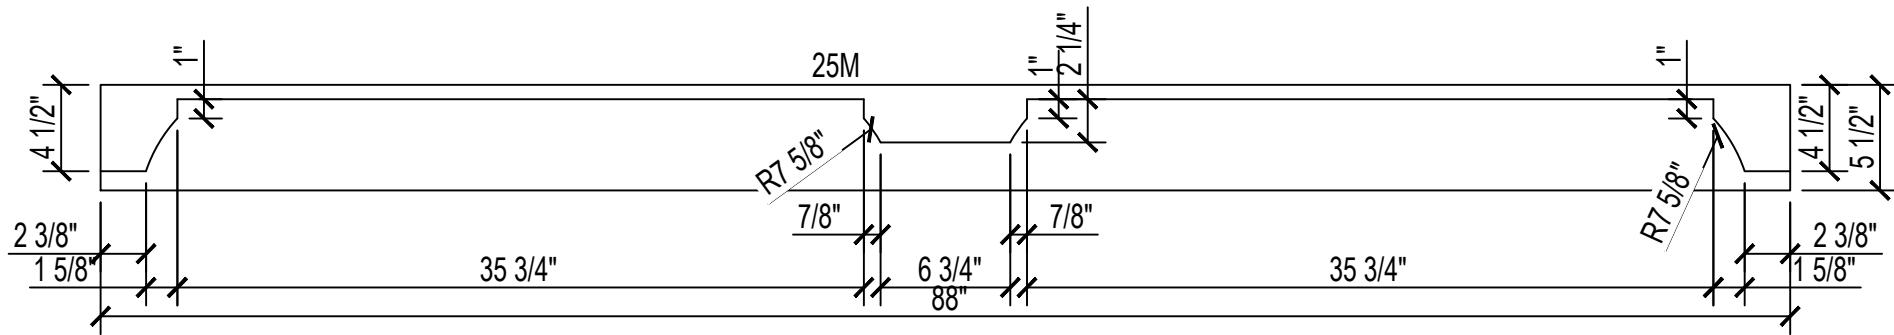

PART DESCRIPTION	DIM. A.	WIDE	DIM. B.	QTY	CUBIC FT	ARCH. SHEET	WDW / DR #	ROOM #	GRID LINE(S)	KEY #
WDW SILL	88"	5 1/2"	4"	2	2.24	1/2.01	E233, E241	215	6-7	25M



820 WILLOW STREET
MANKATO MN, 56001
507-508-0684

PAGE 25N
PAGE 25P

JOB #: _____

SOLD TO: _____

JOB NAME: GALE ROAD

LOCATION: WOODLAND, MN


SECTION OR DETAIL DRAWING: 6/A6.4a, 9/A8.2, 9/A6.4

DATE: 03/10/2021

STOCK: LIMESTONE


FINISH: HONED

85 3/4"

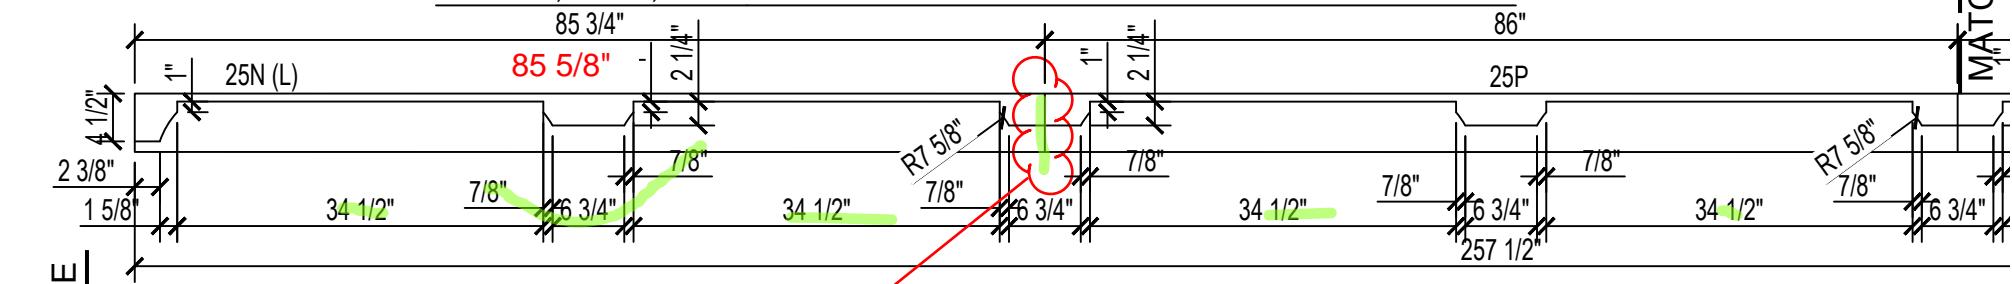


NEED TO ACCOUNT
FOR 1/4" JOINT
SPACING. KEEP
ORIGINAL LENGTH
IF INTENDING TO
FIELD CUT TO FIT

INNCORRECT DIMS

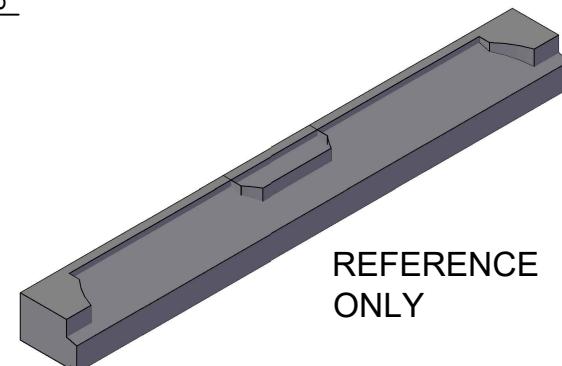

REFERENCE
ONLY

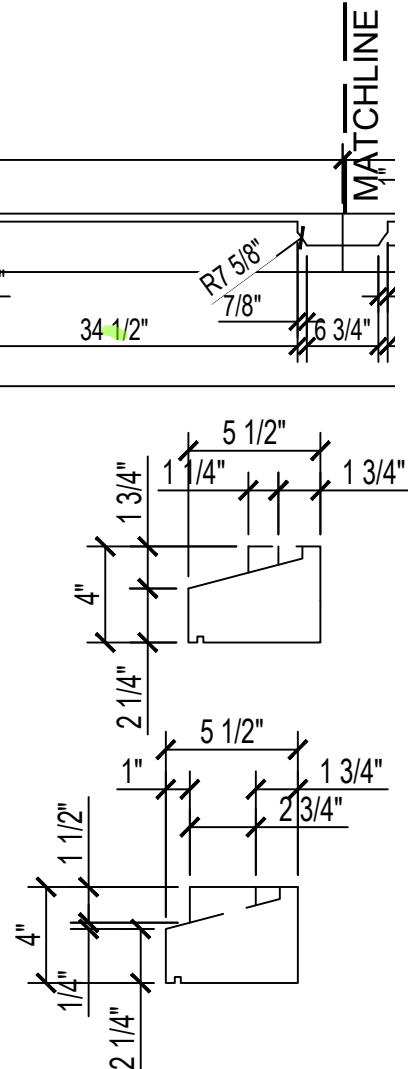

PART DESCRIPTION	DIM. A	WIDE	DIM. B.	QTY	CUBIC FT	ARCH. SHEET	WDW / DR #	ROOM #	GRID LINE(S)	KEY #
WDW SILL	88 1/4"	5 1/2"	4"	1 (R)1(L)	2.25	1/A2.01	E235-240	215	6-7	25N
WDW SILL	88 1/2"	5 1/2"	4"	1	1.13	1/A2.01	E235-240	215	6-7	25P






820 WILLOW STREET
MANKATO MN, 56001
507-508-0684

PAGE 25Q

JOB #: _____
SOLD TO: _____
JOB NAME: GALE ROAD
LOCATION: WOODLAND, MN
SECTION OR DETAIL DRAWING: 6/A6.4a, 9/A8.2, 9/A6.4

DATE: 03/08/2021
STOCK: LIMESTONE
FINISH: HONED

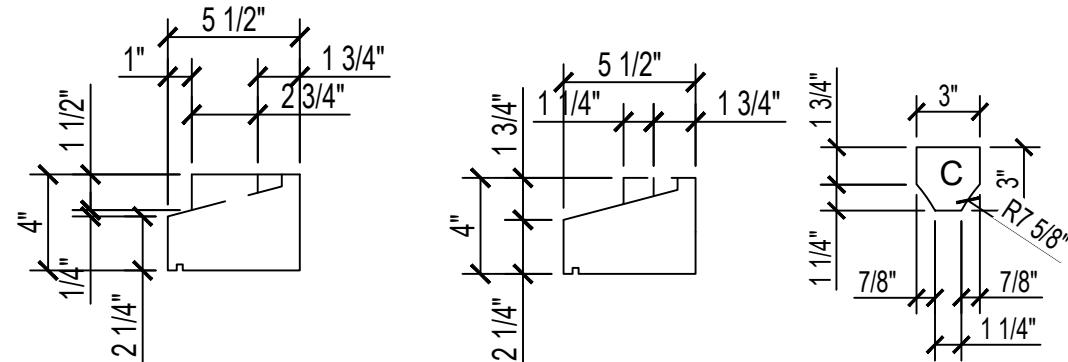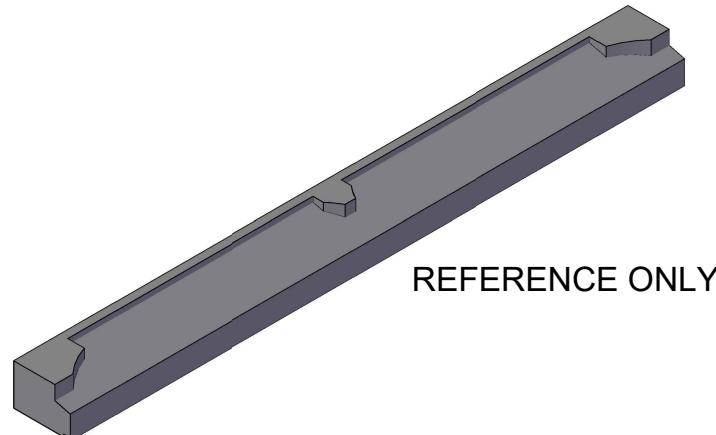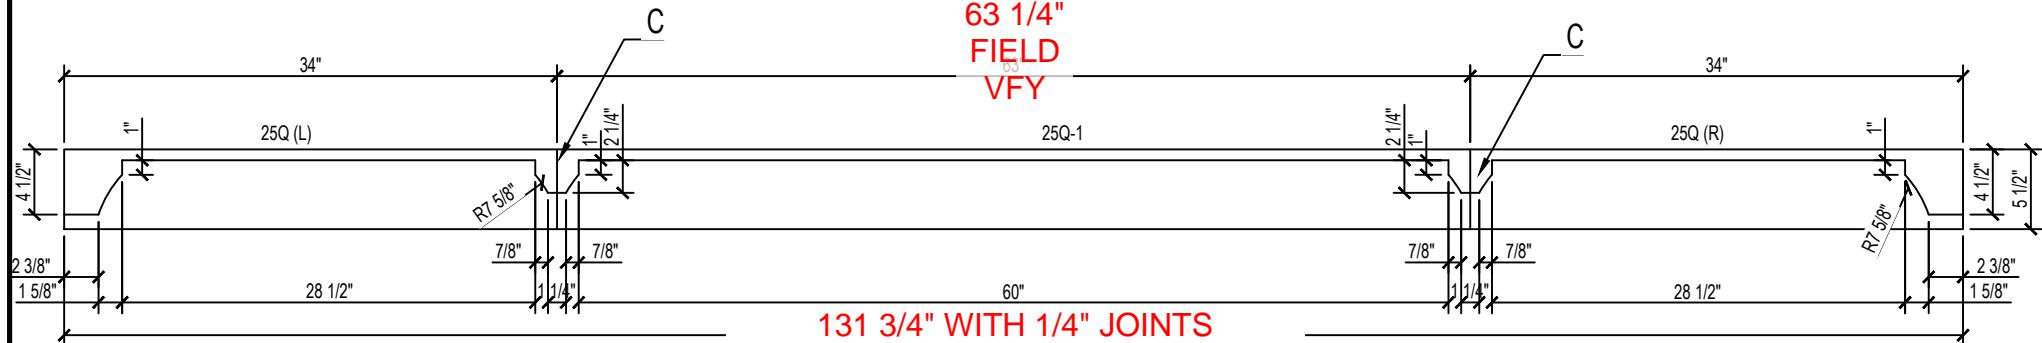

PART DESCRIPTION	DIM. A.	WIDE	DIM. B.	QTY	CUBIC FT	ARCH. SHEET	WDW / DR #	ROOM #	GRID LINE(S)	KEY #
WDW SILL	34"	5 1/2"	4"	1(L)1(R)	.87	2/2.04	N212-215	212	E	25Q
WDW SILL	63 1/4"	5 1/2"	4"	1	.81	2/2.04	N212-215	212	E	25Q-1



820 WILLOW STREET
MANKATO MN, 56001
507-508-0684

PAGE 25R

JOB #: _____

SOLD TO: _____

JOB NAME: GALE ROAD




LOCATION: WOODLAND, MN

SECTION OR DETAIL DRAWING: 6/A6.4a, 9/A8.2, 9/A6.4

DATE: 03/10/2021

STOCK: LIMESTONE

FINISH: HONED

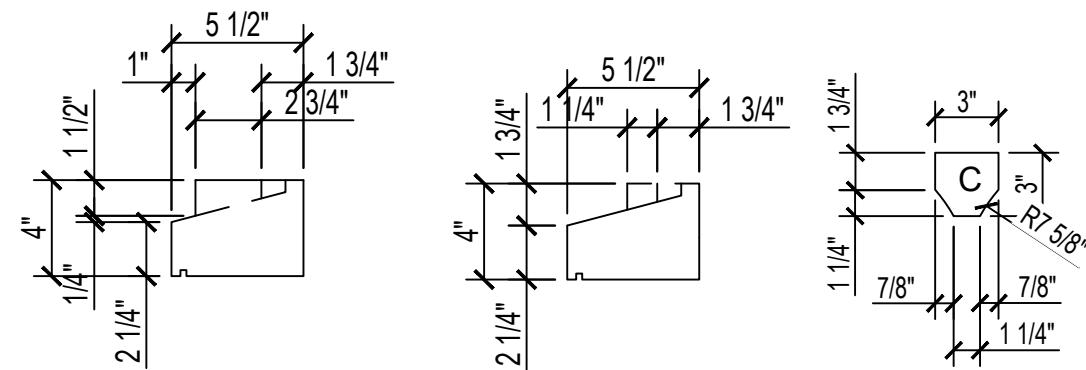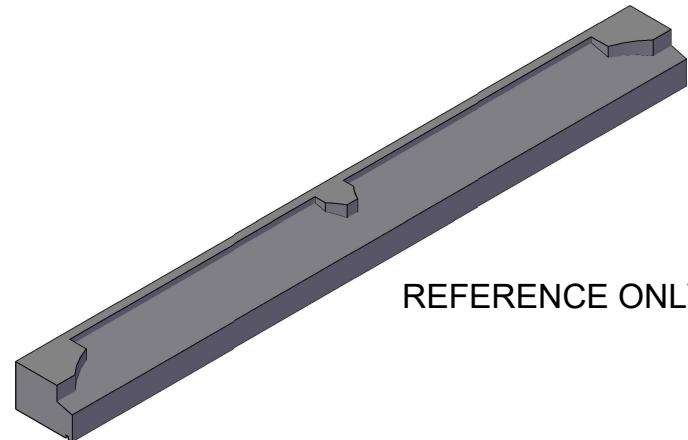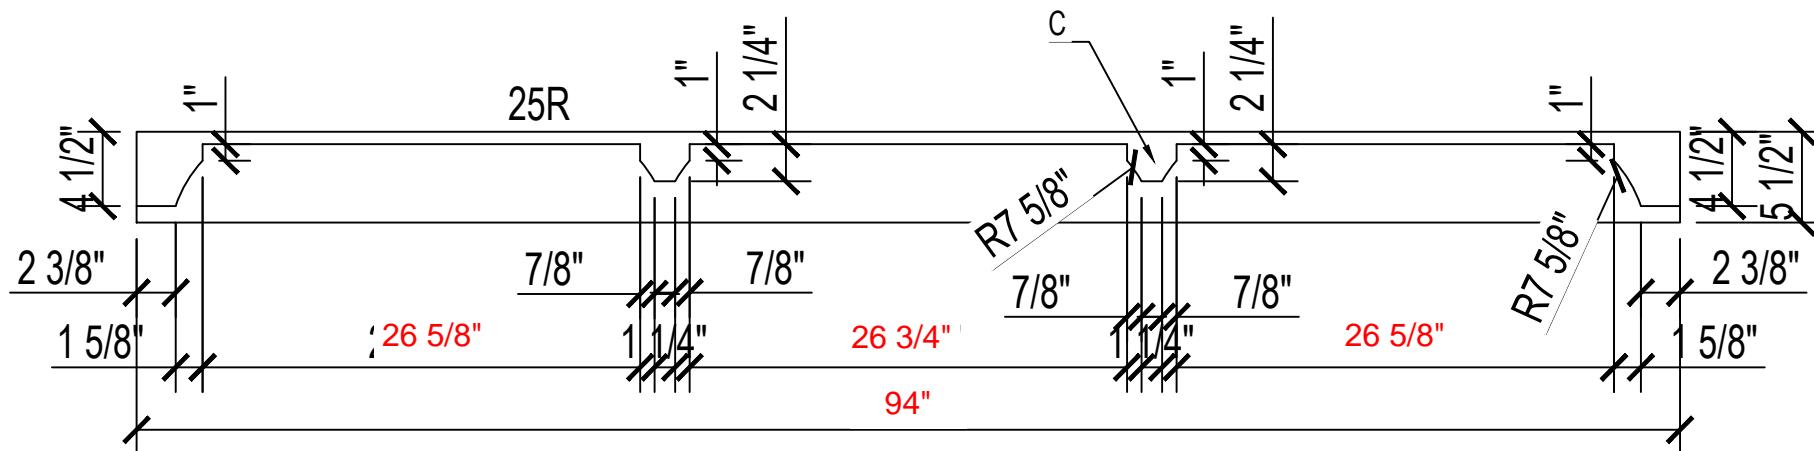

PART DESCRIPTION	DIM. A.	WIDE	DIM. B.	QTY	CUBIC FT	ARCH. SHEET	WDW / DR #	ROOM #	GRID LINE(S)	KEY #
WDW SILL	94"	5 1/2"	4"	2	2.38	2/3.1	S205-207, S213-215		A-B	25R



820 WILLOW STREET
MANKATO MN, 56001
507-508-0684

PAGE 25S
PAGE 25U

JOB #: _____

SOLD TO: _____

JOB NAME: GALE ROAD






LOCATION: WOODLAND, MN

SECTION OR DETAIL DRAWING: 6/A6.4a, 9/A8.2, 9/A6.4

DATE: 03/10/2021

STOCK: LIMESTONE

FINISH: HONED

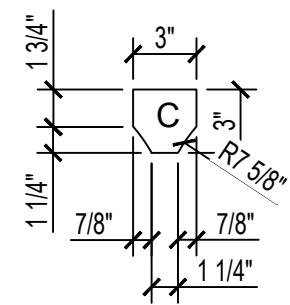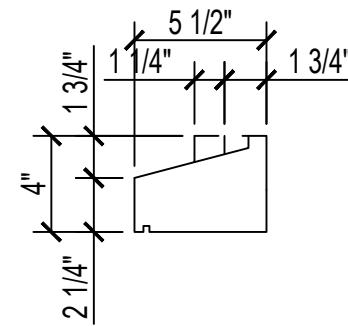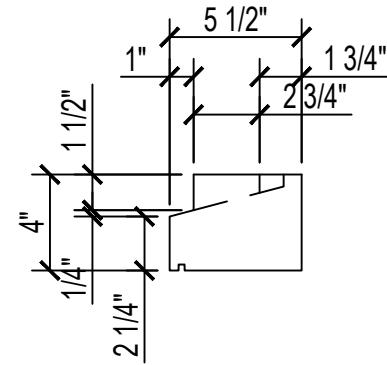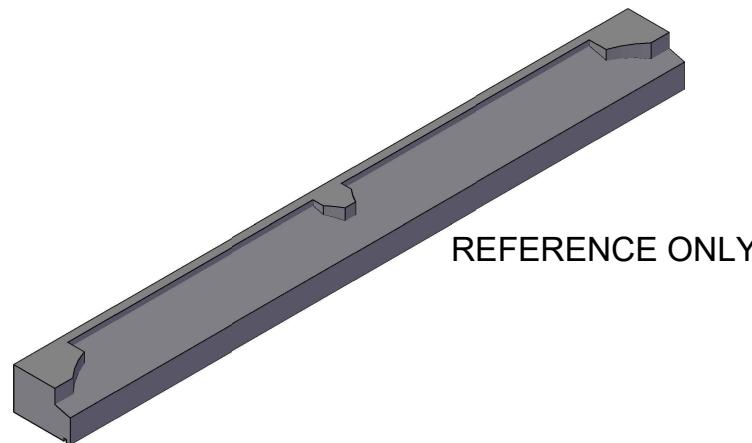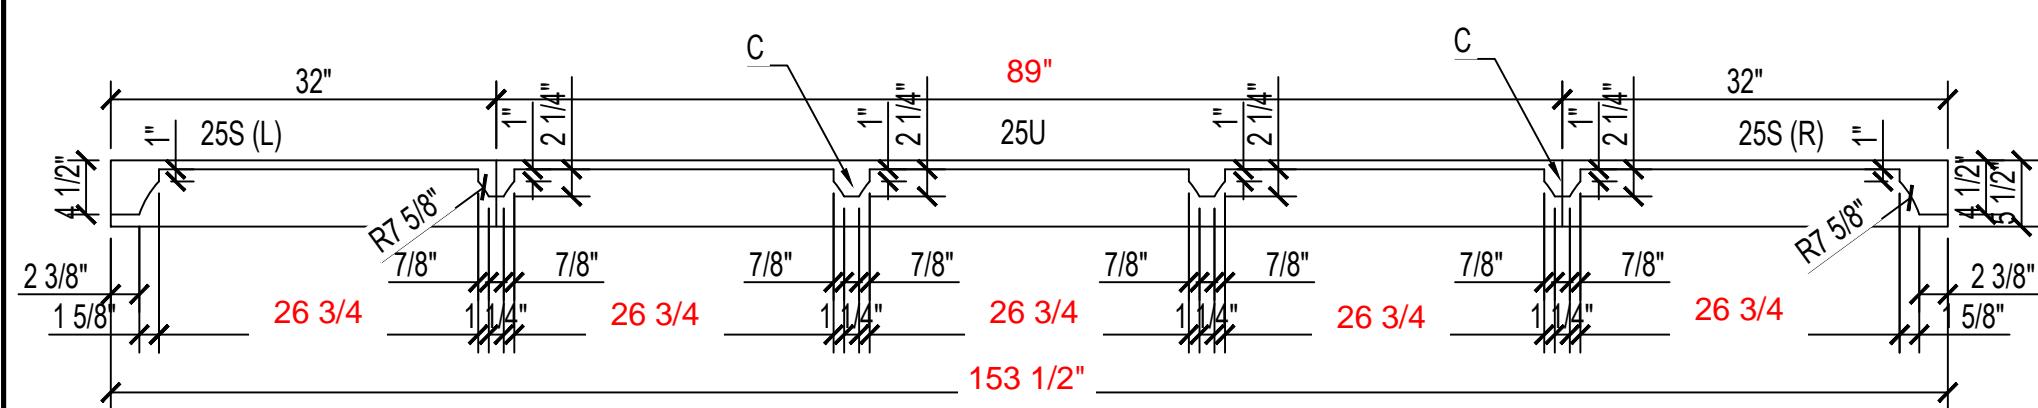

PART DESCRIPTION	DIM. A.	WIDE	DIM. B.	QTY	CUBIC FT	ARCH. SHEET	WDW / DR #	ROOM #	GRID LINE(S)	KEY #
WDW SILL	32"	5 1/2"	4"	1(R)1(L)	.81	2/3.1	S208, S212		A-B	25S
WDW SILL	89"	5 1/2"	4"	1	1.13	2/3.1	S209-211		A-B	25U





820 WILLOW STREET
MANKATO MN, 56001
507-508-0684

PAGE 27

JOB #: _____
SOLD TO: _____
JOB NAME: GALE ROAD
LOCATION: WOODLAND, MN
SECTION OR DETAIL DRAWING: 6/A6.4a, 9/A8.2, 9/A6.4

DATE: 03/10/2021
STOCK: LIMESTONE
FINISH: HONED

REFERENCE SHEET
SEE 27J FOR INDIVIDUAL PARTS

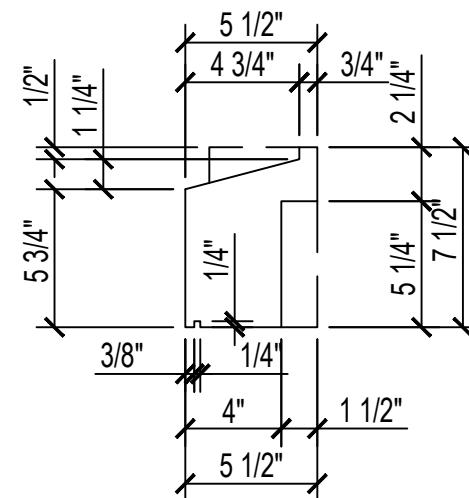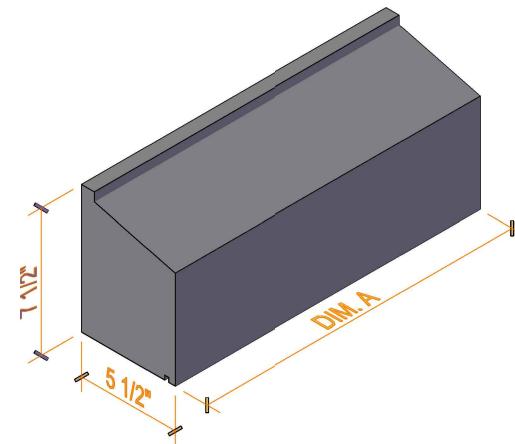




820 WILLOW STREET
MANKATO MN, 56001
507-508-0684




PAGE 27

JOB #: _____
SOLD TO: _____
JOB NAME: GALE ROAD
LOCATION: WOODLAND, MN
SECTION OR DETAIL DRAWING: 6/A6.4a, 9/A8.2, 9/A6.4

DATE: 03/10/2021
STOCK: LIMESTONE
FINISH: HONED

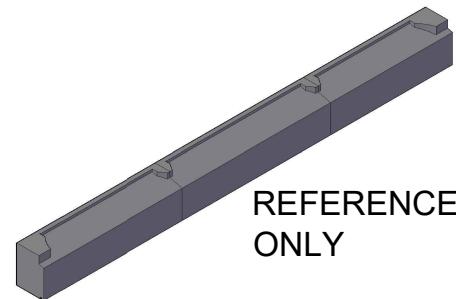


REFERENCE
ONLY

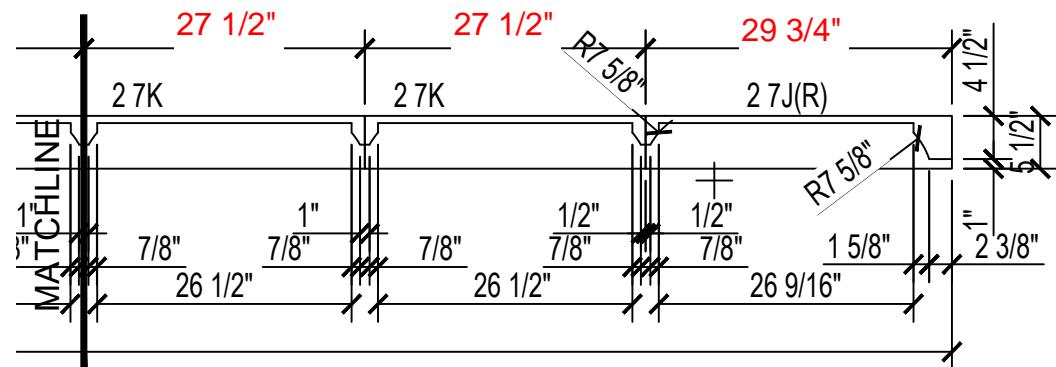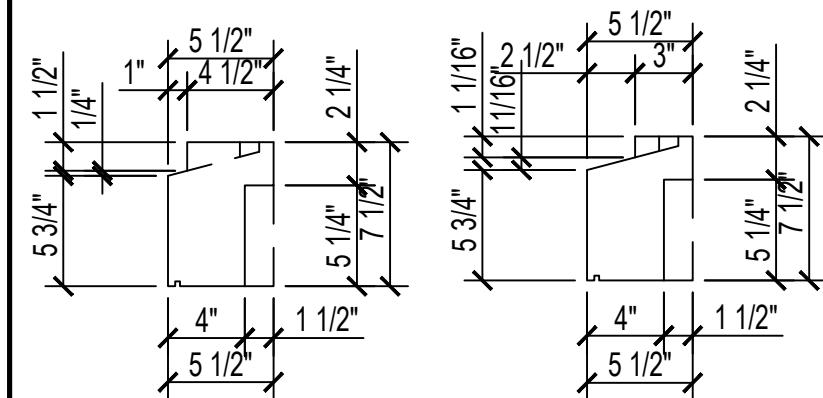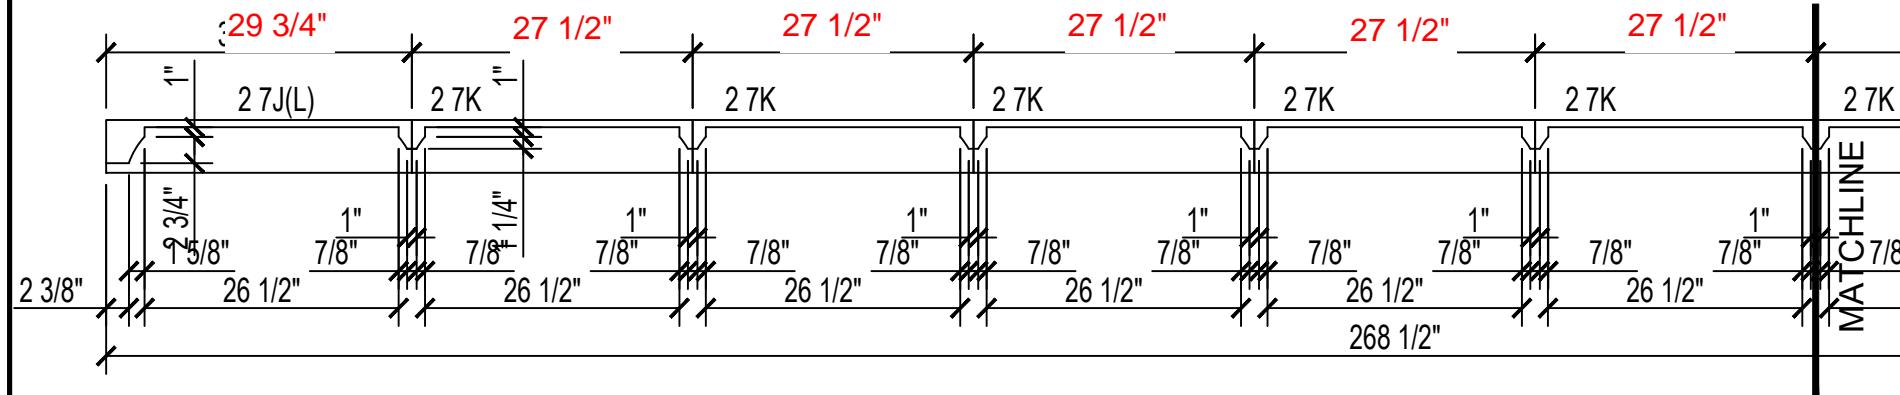

PART DESCRIPTION	DIM. A.	WIDE	HEIGHT	QTY	CUBIC FT	ARCH. SHEET	WDW / DR #	ROOM #	GRID LINE(S)	KEY #
WDW SILL - DORMER	29 3/4"	5 1/2"	7 1/2"	1(R) 1(L)	1.52	2/2.02	W222, W230	209a	5-4	27J
WDW SILL - DORMER	27 1/2"	5 1/2"	7 1/2"	7	4.89	2/2.02	W223-229	209a	5-4	27K

JOB #: _____
 SOLD TO: _____
 JOB NAME: GALE ROAD
 LOCATION: WOODLAND, MN
 SECTION OR DETAIL DRAWING: 1/A6.5, 3/A8.3; 1/A6.8

DATE: 03/10/2021
 STOCK: LIMESTONE
 FINISH: HONED

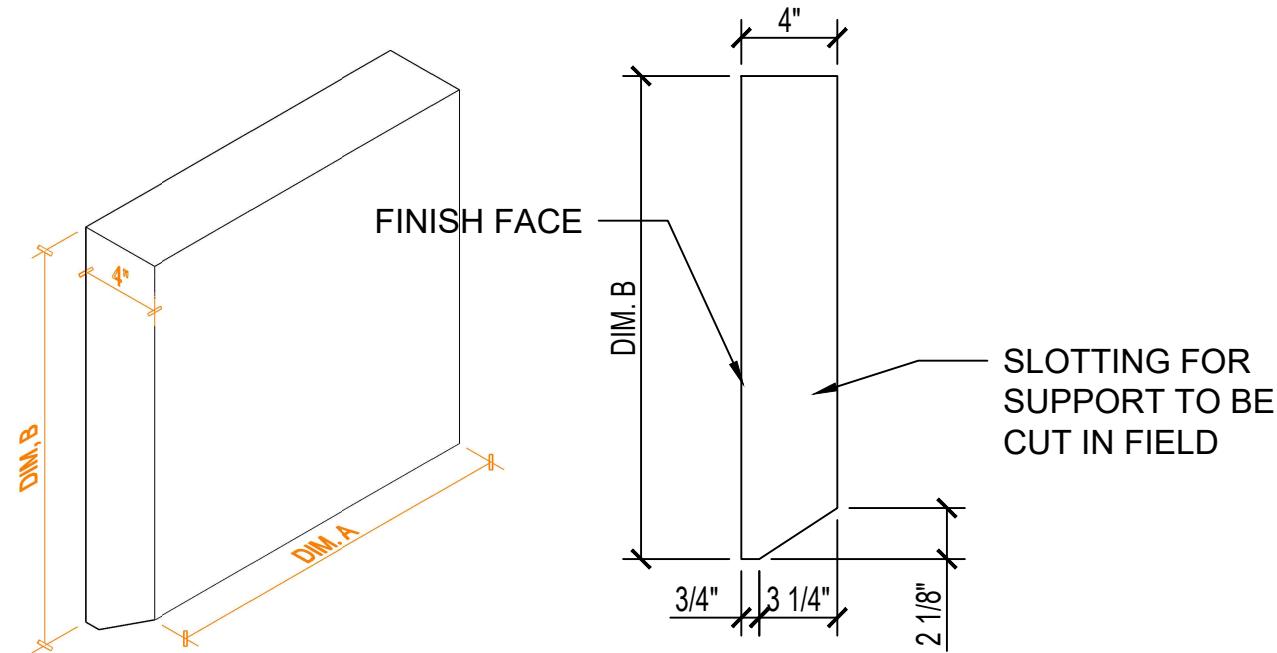

PART DESCRIPTION	DIM. A.	WIDE	HEIGHT	QTY	CUBIC FT	ARCH. SHEET	WDW / DR #	ROOM #	GRID LINE(S)	KEY #
HEADER - TYPE 1A	77 3/8"	4"	20 1/8"	2	7.21	2/A2.01	W111, W123	126	8-7	28M
STONE HEADER 1A	53 1/2"	4"	20 1/8"	1	2.5	1/2.01	E118	116	5-6	28P
STONE HEADER 1A	88 3/4"	4"	20 1/8"	2	8.27	1/2.01a	E131-132, E139-140	119a	6-7	28T
STONE HEADER 1A	93 1/2"	4"	20 1/8"	3	13.08	1/2.01a	E137,E125-126,E145-146	119a	6-7	28U
STONE HEADER 1A	120 1/2"	4"	20 1/8"	1	28.07	2/2.04	N110, N113	116	E	28V
STONE HEADER 1B	60 1/2"	4"	16"	1L 1R	4.	NEEDS REVERSE LUG @ EACH END SIMILAR TO 28Y CONFIG				28W
STONE HEADER 1B	35 3/4"	4"	16"	1	1.32	1/2.03	N135	131a	B-A	28X




820 WILLOW STREET
MANKATO MN, 56001
507-508-0684

PAGE 28AA
PAGE 28AB

JOB #: _____
SOLD TO: _____
JOB NAME: GALE ROAD
LOCATION: WOODLAND, MN
SECTION OR DETAIL DRAWING: 1/A6.5, 3/A8.3; 1/A6.8

DATE: 03/10/2021
STOCK: LIMESTONE
FINISH: HONED

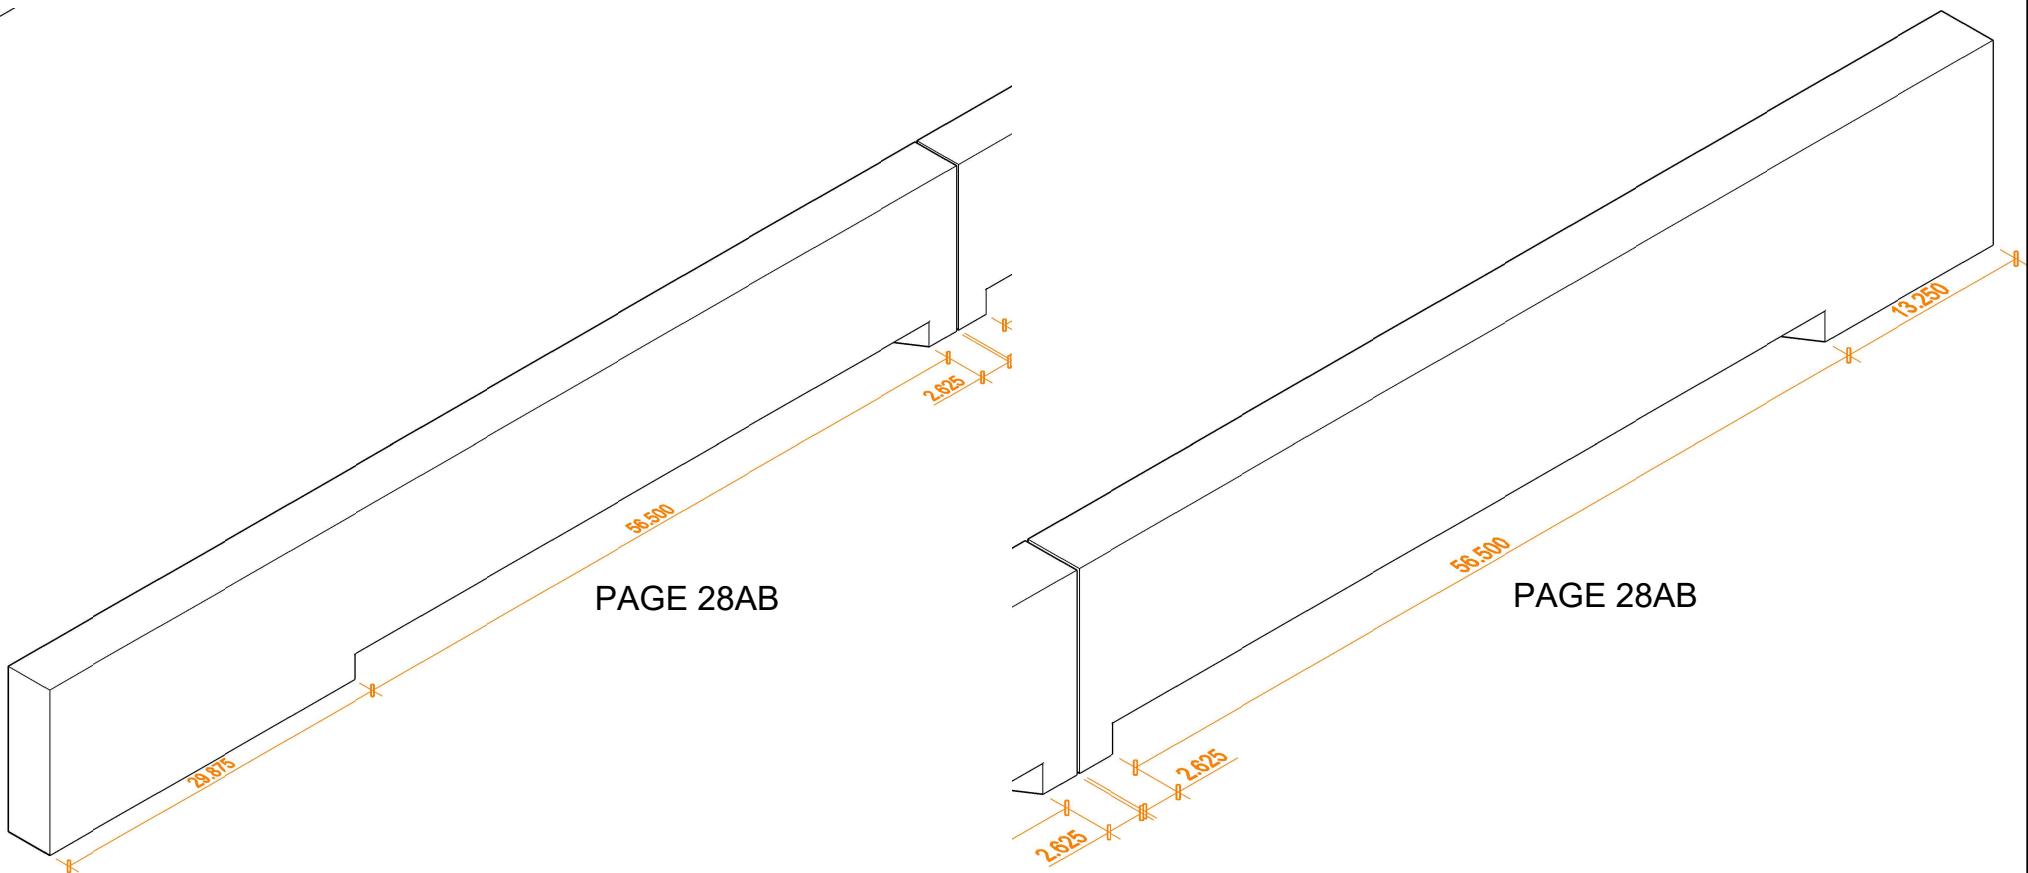

PART DESCRIPTION	DIM. A.	WIDE	DIM. B.	QTY	CUBIC FT	ARCH. SHEET	WDW / DR #	ROOM #	GRID LINE(S)	KEY #
STONE HEADER 1C	89"	4"	14"	1	2.88	2/3.1	S115a	111		28AA
STONE HEADER 1C	72 3/8"	4"	14"	1	2.24	2/3.1	S116a	111		28AB






820 WILLOW STREET
MANKATO MN, 56001
507-508-0684

PAGE 28AC
PAGE 28AD
PAGE 28AE

JOB #: _____
SOLD TO: _____
JOB NAME: GALE ROAD
LOCATION: WOODLAND, MN
SECTION OR DETAIL DRAWING: 1/A6.5, 3/A8.3; 1/A6.8

DATE: 03/10/2021
STOCK: LIMESTONE
FINISH: HONED

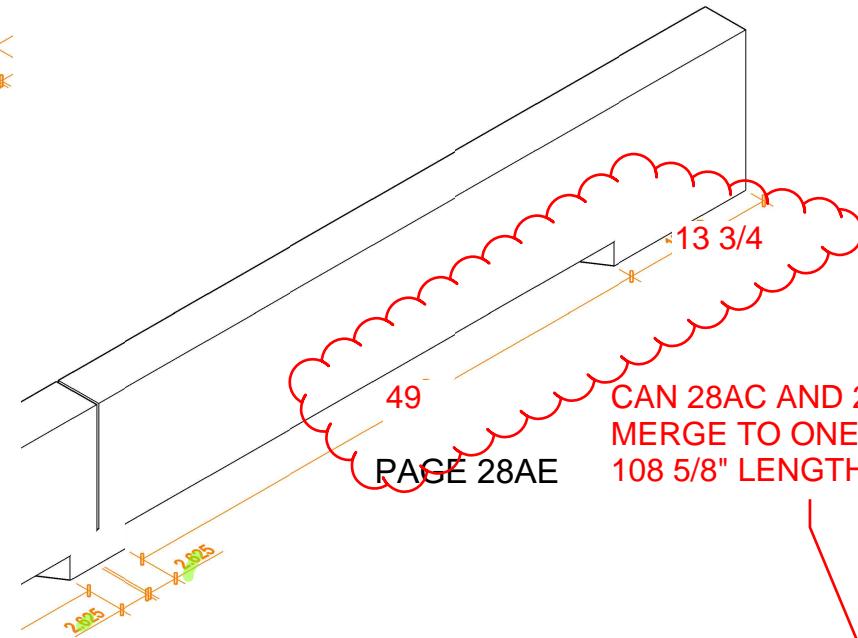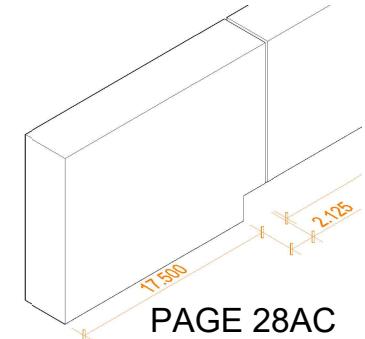
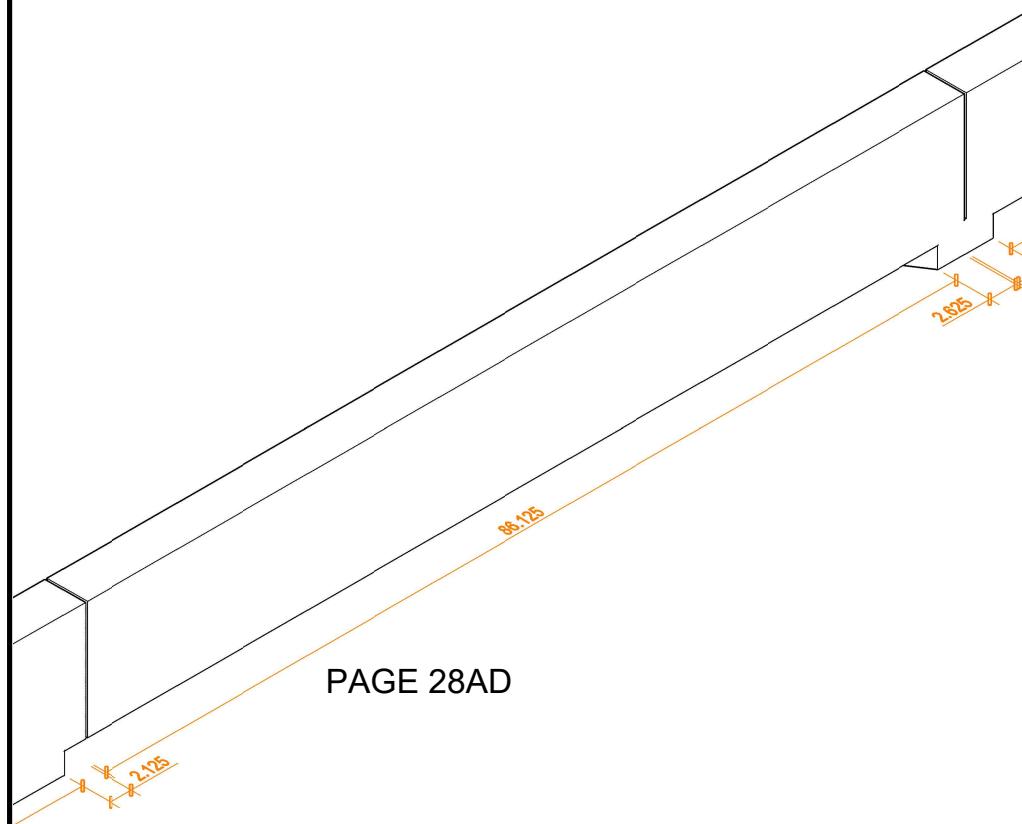


CAN 28AC AND 28AD
MERGE TO ONE STONE?
108 5/8" LENGTH

PART DESCRIPTION	DIM. A.	WIDE	DIM. B.	QTY	CUBIC FT	ARCH. SHEET	WDW / DR #	ROOM #	GRID LINE(S)	KEY #
STONE HEADER 1C	19 5/8"	4"	14"	1	.63	2/2.02	W142-146	115	5-4	28AC
STONE HEADER 1C	88 3/4"	4"	14"	1	2.87	2/2.02	W142-146	115	5-4	28AD
STONE HEADER 1C	65 3/8"	4"	14"	1	2.13	2/2.02	W142-146	115	5-4	28AE

JOB #: _____
 SOLD TO: _____
 JOB NAME: GALE ROAD
 LOCATION: WOODLAND, MN
 SECTION OR DETAIL DRAWING: 1/A6.5, 3/A8.3; 1/A6.8

DATE: 03/10/2021
 STOCK: LIMESTONE
 FINISH: HONED

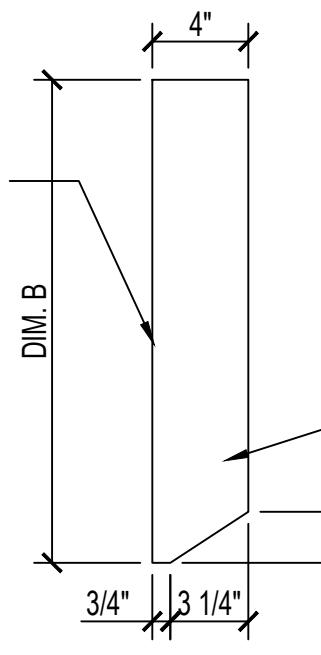
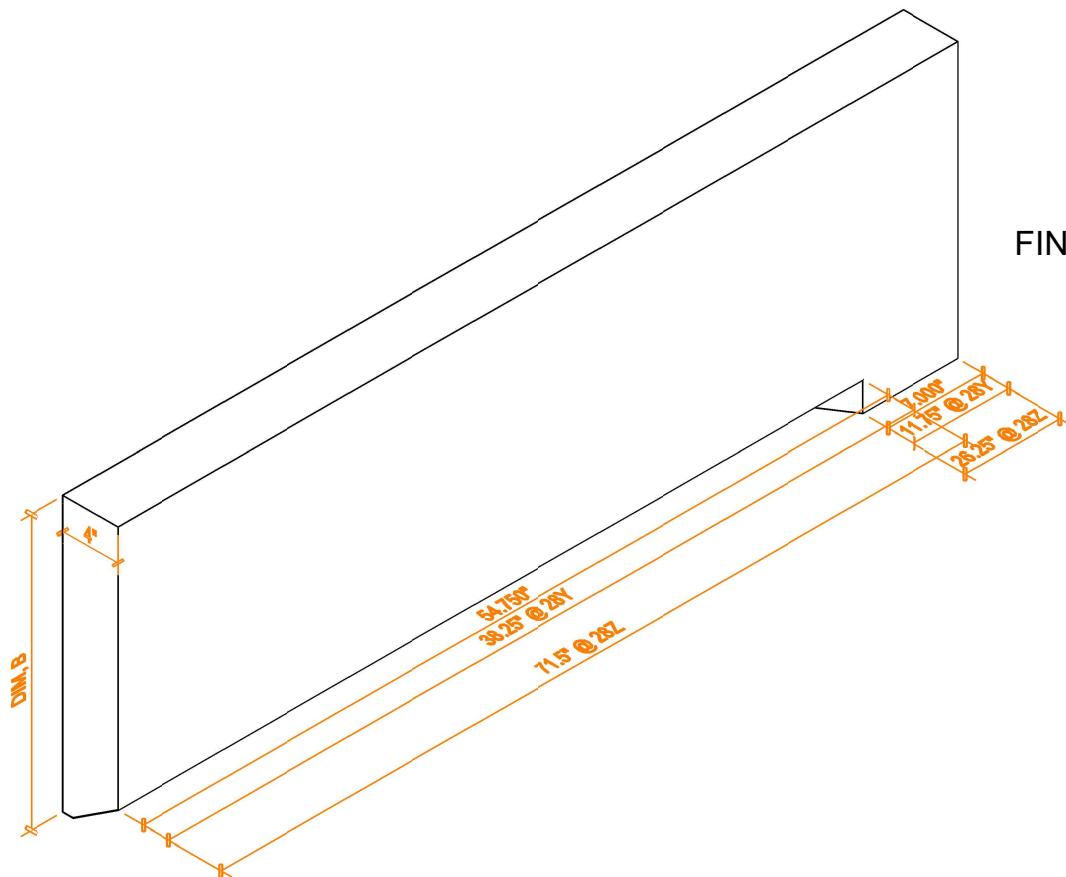


**SEE ELEVATION
NOTE ABOUT
BEVEL/ ALIGNMENT
TO BRACKET**

PART DESCRIPTION	DIM. A.	WIDE	DIM. B.	QTY	CUBIC FT	ARCH. SHEET	WDW / DR #	ROOM #	GRID LINE(S)	KEY #
STONE HEADER 1A	61 3/4"	4"	20 1/8"	1(L)1(R)	5.75	1/2.01	E112, E124	116	5-6	28Q
STONE HEADER 1B	50"	4"	16"	1(L)1(R)	3.70	1/2.03	N132, N138	131a	B-A	28Y
STONE HEADER 1A	93 31/2	4"	20 1/8"	1	4.55	2/3.1	S113	112		28Z

JOB #: _____
 SOLD TO: _____
 JOB NAME: GALE ROAD
 LOCATION: WOODLAND, MN
 SECTION OR DETAIL DRAWING: 1/A6.5, 3/A8.3; 1/A6.8

DATE: 03/10/2021
 STOCK: LIMESTONE
 FINISH: HONED

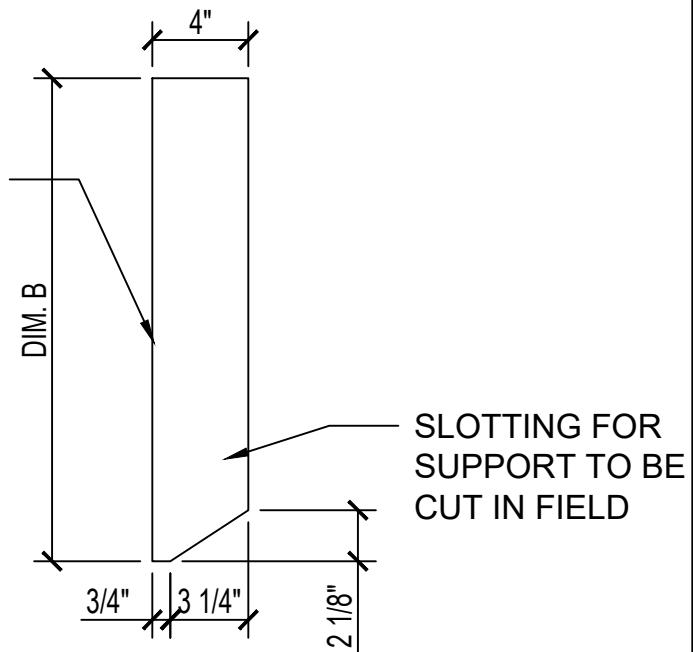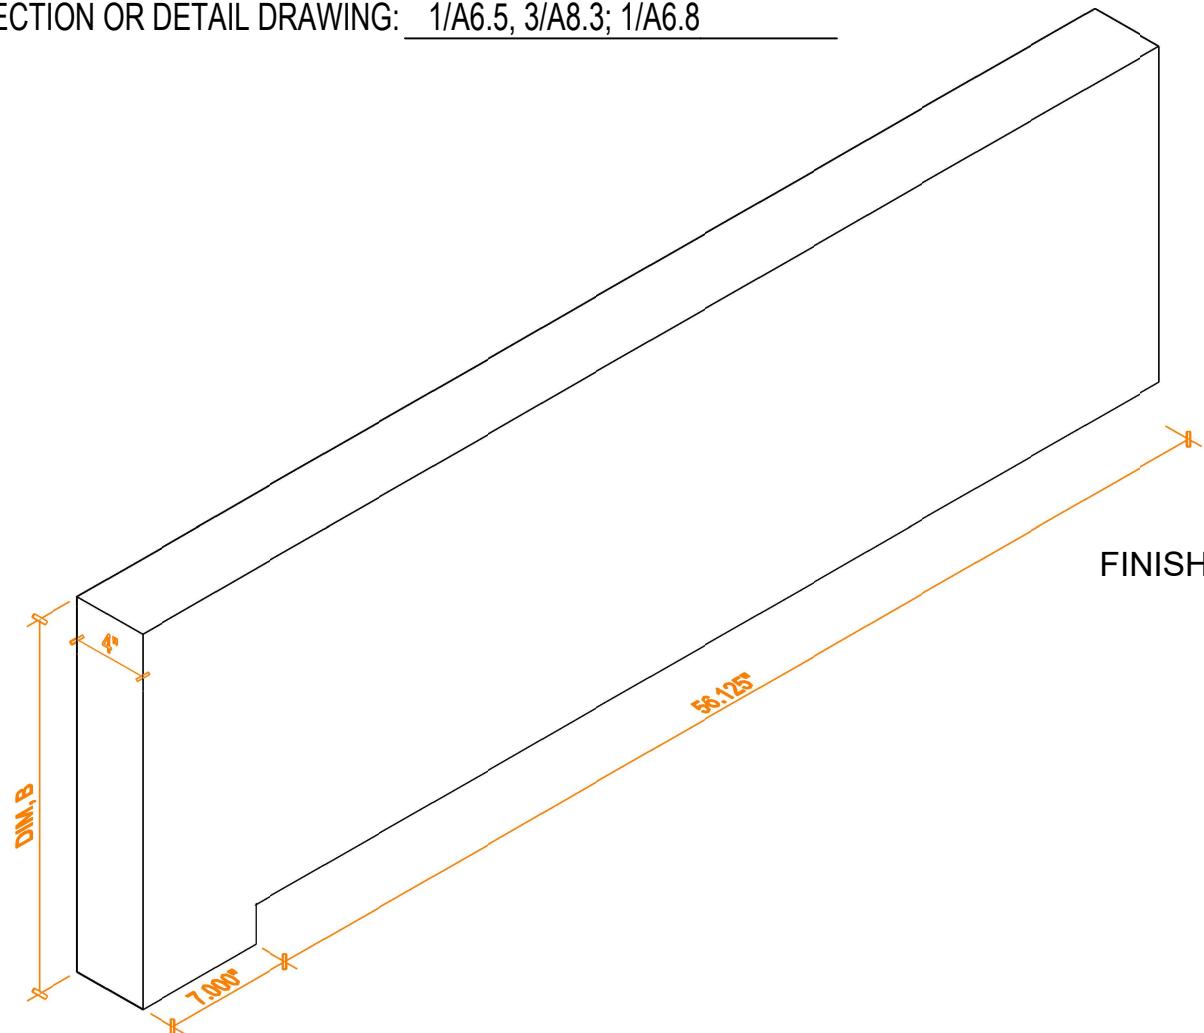

PART DESCRIPTION	DIM. A.	WIDE	DIM. B.	QTY	CUBIC FT	ARCH. SHEET	WDW / DR #	ROOM #	GRID LINE(S)	KEY #
STONE HEADER 1A	63 1/8"	4"	20 1/8"	1(L)1(R)	5.88	1/2.01	E115, E121	116	5-6	28R





820 WILLOW STREET
MANKATO MN, 56001
507-508-0684

PAGE 29

JOB #: _____
SOLD TO: _____
JOB NAME: GALE ROAD
LOCATION: WOODLAND, MN
SECTION OR DETAIL DRAWING: 3/A6.5, 18/A8.3

DATE: 03/10/2021
STOCK: LIMESTONE
FINISH: HONED

REFERENCE SHEET
SEE SHEET 29G, 29K FOR
INDIVIDUAL PARTS

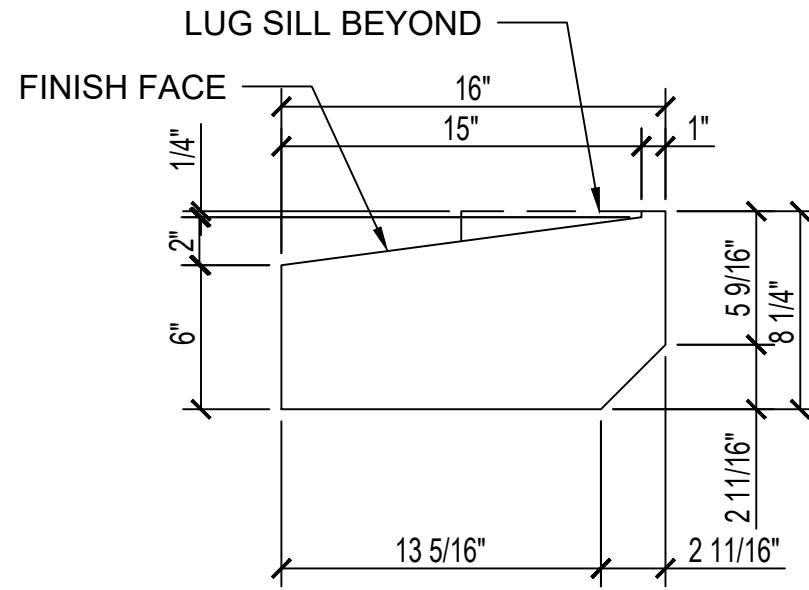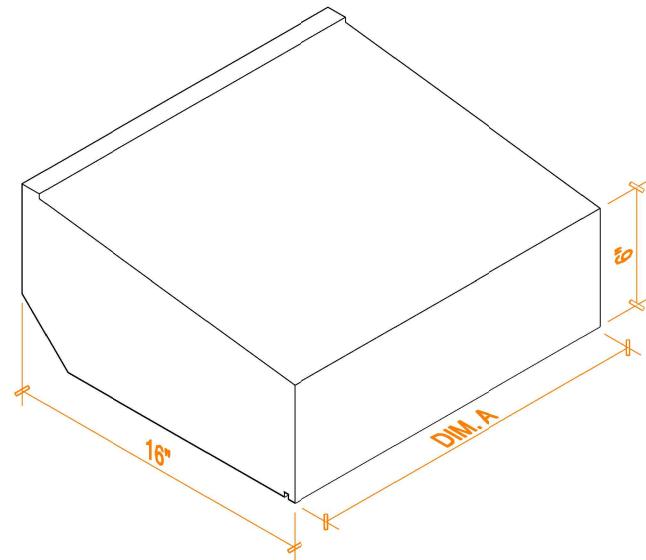




820 WILLOW STREET
MANKATO MN, 56001
507-508-0684

PAGE 29G
PAGE 29H
PAGE 29J

JOB #: _____
SOLD TO: _____
JOB NAME: GALE ROAD
LOCATION: WOODLAND, MN
SECTION OR DETAIL DRAWING: 3/A6.5, 18/A8.3

DATE: 03/10/2021
STOCK: LIMESTONE
FINISH: HONED

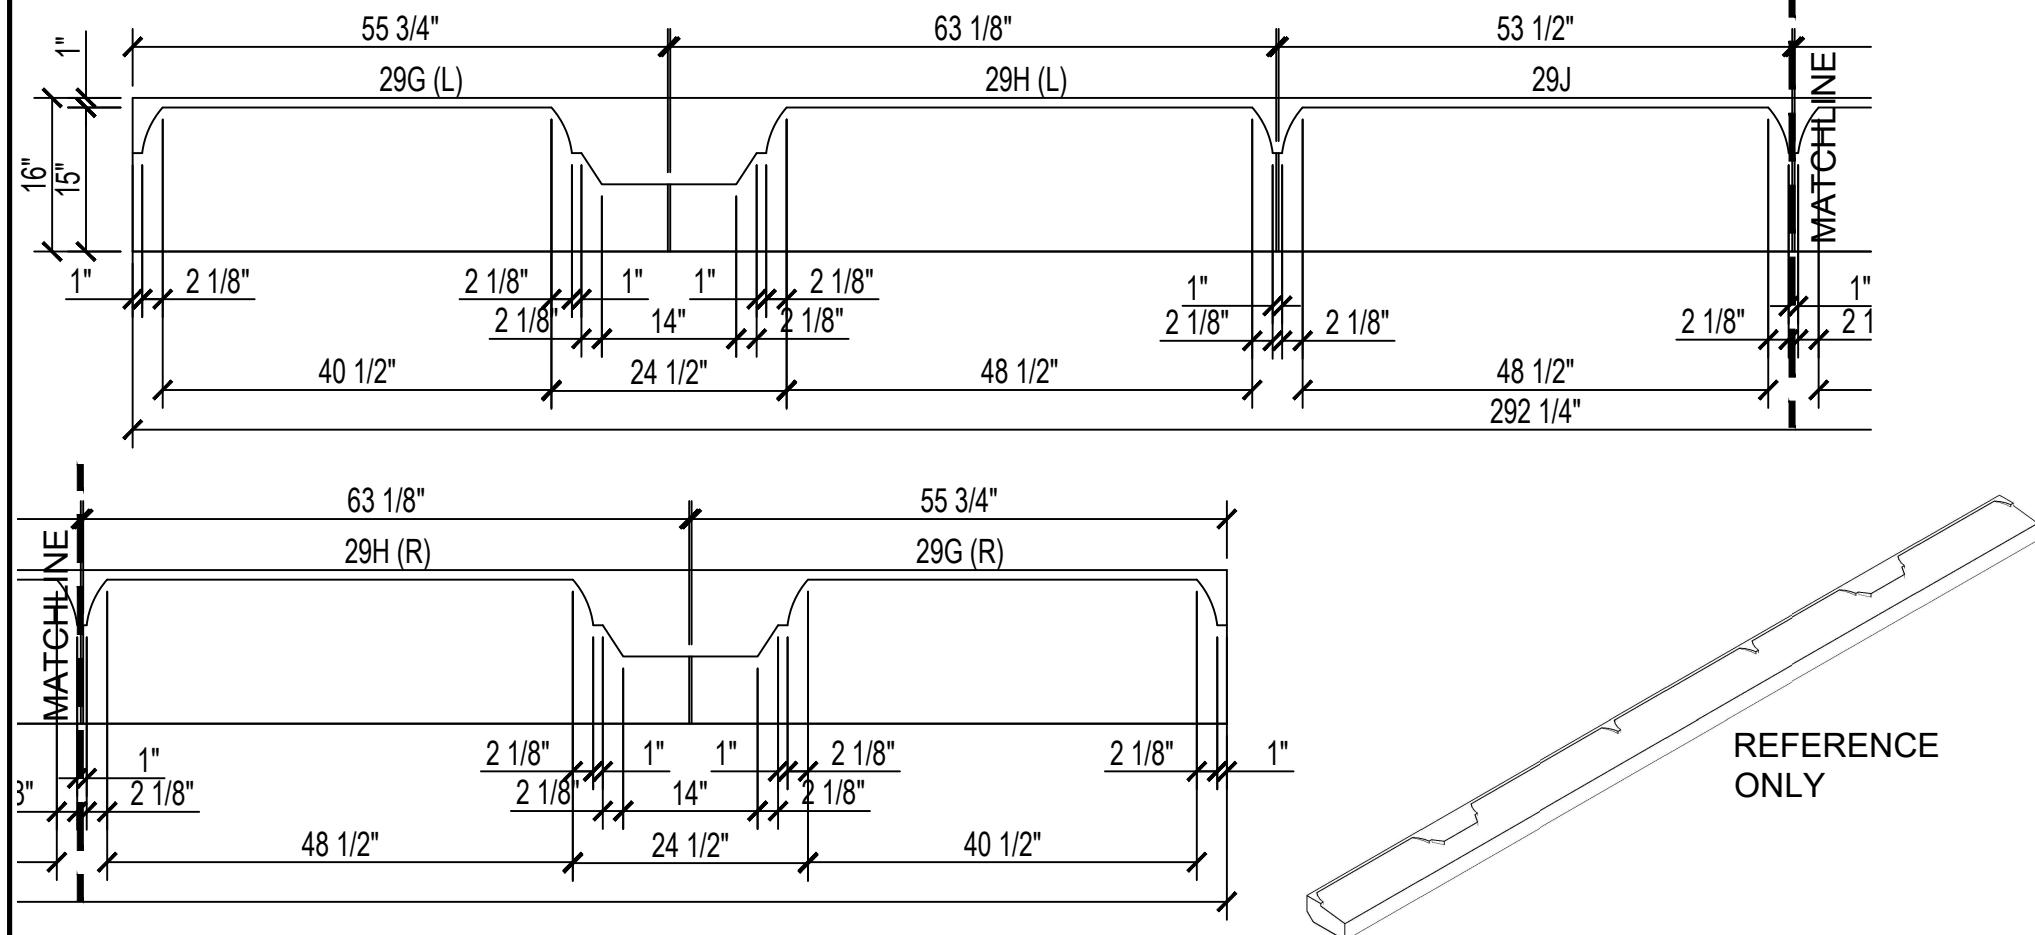

PART DESCRIPTION	DIM. A.	WIDE	DIM. B.	QTY	CUBIC FT	ARCH. SHEET	WDW / DR #	ROOM #	GRID LINE(S)	KEY #
STONE SILL TYPE 6	<u>55 3/4"</u>	16"	8 1/4"	1(R)1(L)	8.52	1/2.01	E112-124	116	5-6	<u>29G</u>
STONE SILL TYPE 6	<u>63 1/8"</u>	16"	8 1/4"	1(R)1(L)	9.64	1/2.01	E112-124	116	5-6	<u>29H</u>
STONE SILL TYPE 6	<u>53 1/2"</u>	16"	8 1/4"	1	4.09	1/2.01	E112-124	116	5-6	<u>29J</u>



820 WILLOW STREET
MANKATO MN, 56001
507-508-0684

PAGE 29K

JOB #: _____

SOLD TO: _____

DATE: 03/10/2021



JOB NAME: GALE ROAD

STOCK: LIMESTONE

LOCATION: WOODLAND, MN

FINISH: HONED

SECTION OR DETAIL DRAWING: 3/A6.5, 18/A8.3

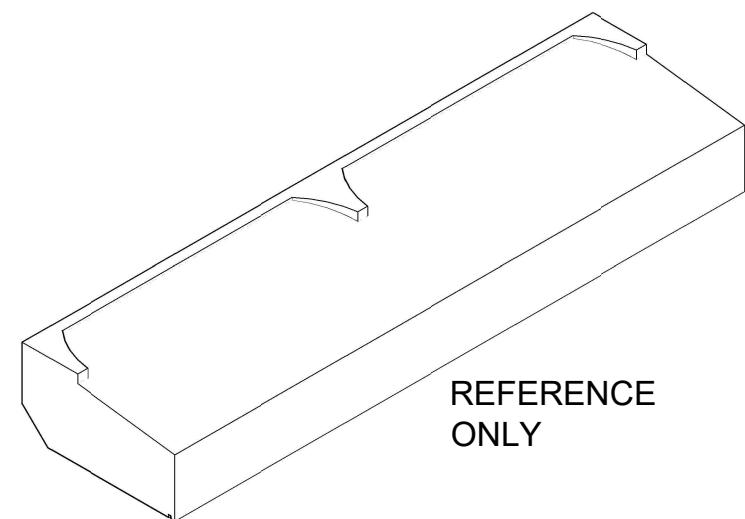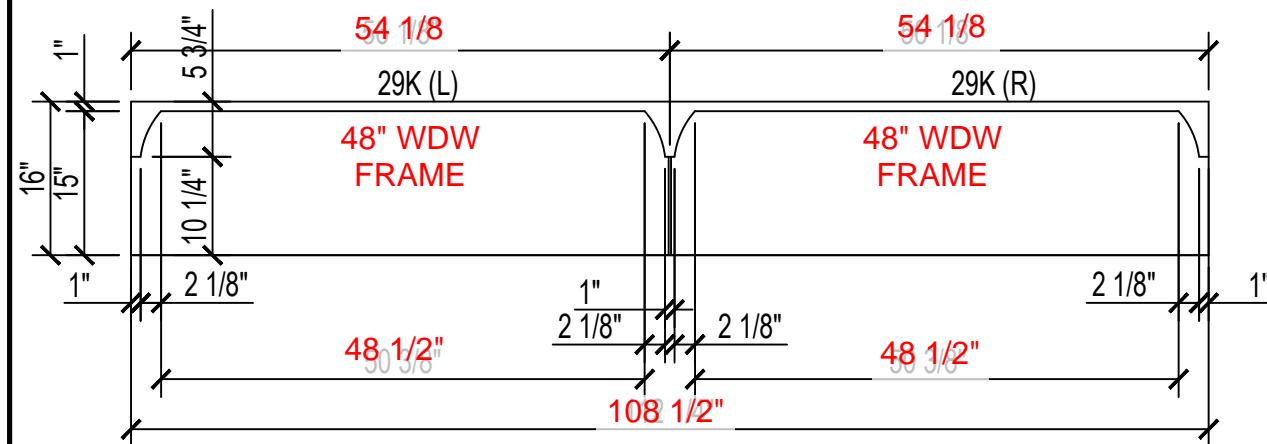

REFERENCE
ONLY

PART DESCRIPTION	DIM. A.	WIDE	DIM. B.	QTY	CUBIC FT	ARCH. SHEET	WDW / DR #	ROOM #	GRID LINE(S)	KEY #
STONE SILL TYPE 6	54 1/8	16"	8 1/4"	1(R)1(L)	8.88	2/2.04	N112, N115	116	E	29K



820 WILLOW STREET
MANKATO MN, 56001
507-508-0684

PAGE 30

JOB #: _____

SOLD TO: _____

DATE: 03/10/2021

JOB NAME: GALE ROAD


STOCK: LIMESTONE

LOCATION: WOODLAND, MN

FINISH: HONED

SECTION OR DETAIL DRAWING: 2/A6.5, 8/A8.3a

PART DESCRIPTION	DIM. A.	WIDE	HEIGHT	QTY	CUBIC FT	ARCH. SHEET	WDW / DR #	ROOM #	GRID LINE(S)	KEY #
MULLION TYPE 3	39 7/16"	18 1/4"	4"	4	6.66	1/2.01	E111, 114, 120, 123	116	5-6	30A
MULLION TYPE 3	39 1/2"	18 1/4"	4"	2	3.34	1/2.01	E111, 114, 120, 123	116	5-6	30B

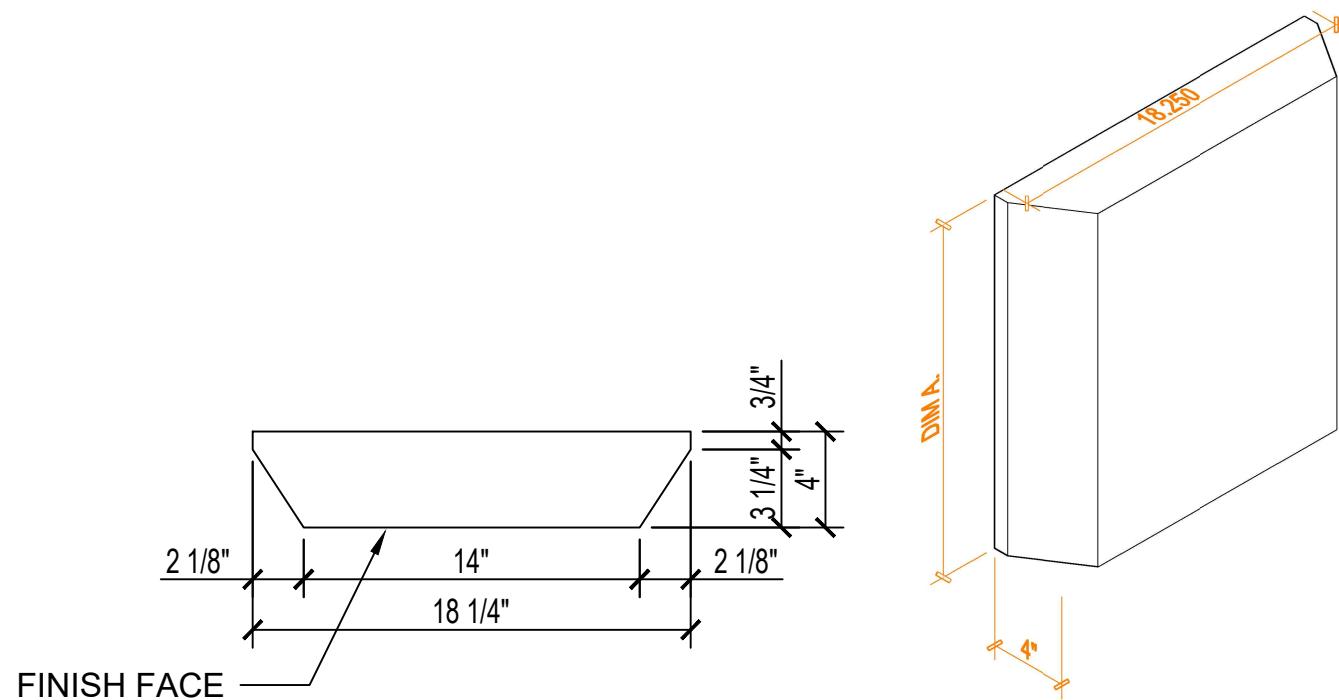




820 WILLOW STREET
MANKATO MN, 56001
507-508-0684

PAGE 31


JOB #: _____
SOLD TO: _____
JOB NAME: GALE ROAD
LOCATION: WOODLAND, MN
SECTION OR DETAIL DRAWING: 2/A6.8, 25/A8.3

DATE: 03/10/2021
STOCK: LIMESTONE
FINISH: HONED

REFERENCE SHEET
SEE SHEETS 31A, 31B FOR
INDIVIDUAL PARTS

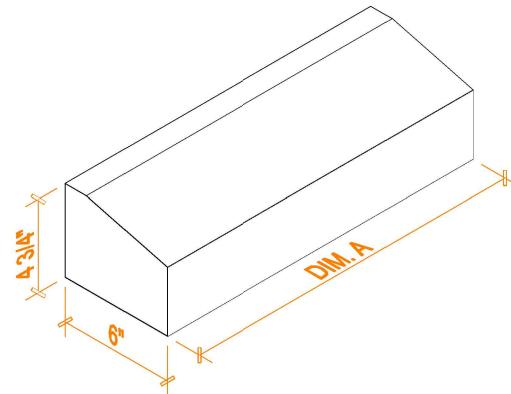

FINISH FACE

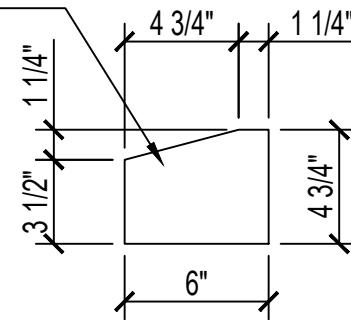



820 WILLOW STREET
MANKATO MN, 56001
507-508-0684

PAGE 31A

JOB #: _____

SOLD TO: _____

JOB NAME: GALE ROAD


LOCATION: WOODLAND, MN

SECTION OR DETAIL DRAWING: 2/A6.8, 25/A8.3

DATE: 03/10/2021

STOCK: LIMESTONE






FINISH: HONED

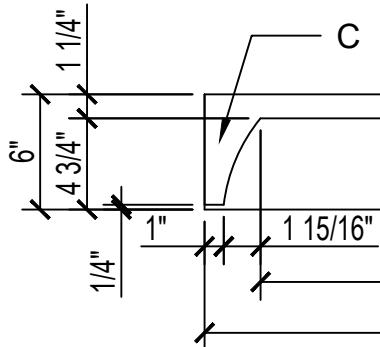

31A (R) (L)

84 1/16"

89 3/8"

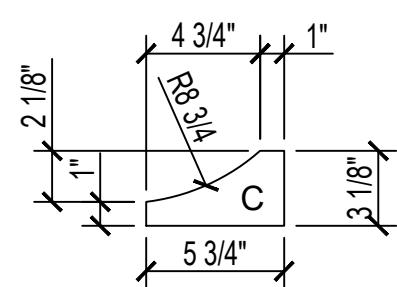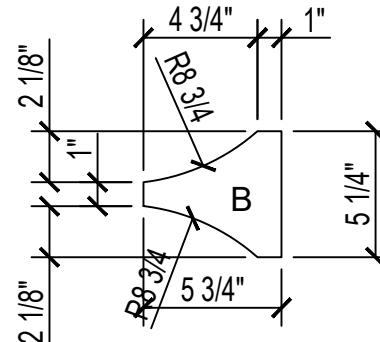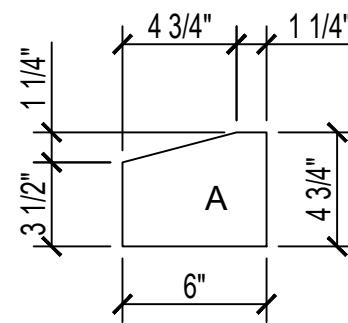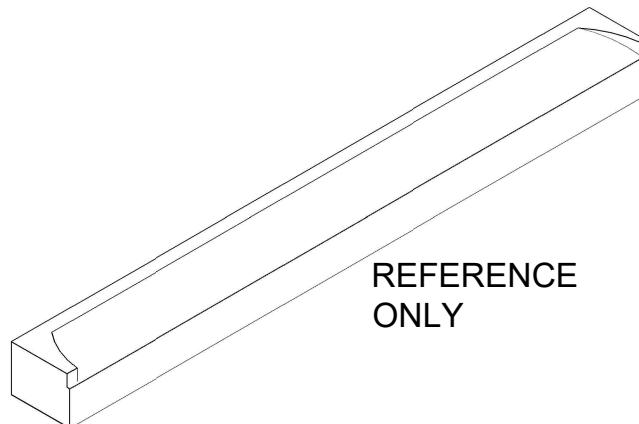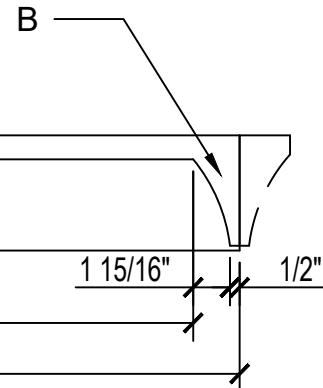

PART DESCRIPTION	DIM. A.	WIDE	DIM. B.	QTY	CUBIC FT	ARCH. SHEET	WDW / DR #	ROOM #	GRID LINE(S)	KEY #
SILL	89 3/8"	6"	4 3/4"	1(R) 1(L)	2.95	1/2.01a	E129-130, E149-150	119a	6-7	31A
SILL	88 3/4"	6"	4 3/4"	2	2.93	1/2.01a	E135-136, E143-144	119a	6-7	31B
SILL	93 1/2"	6"	4 3/4"	1	1.54	1/2.01a	E138	119a	6-7	31C

JOB #: _____

SOLD TO: _____

JOB NAME: GALE ROAD




LOCATION: WOODLAND, MN

SECTION OR DETAIL DRAWING: 2/A6.8, 25/A8.3

DATE: 03/10/2021

STOCK: LIMESTONE

FINISH: HONED

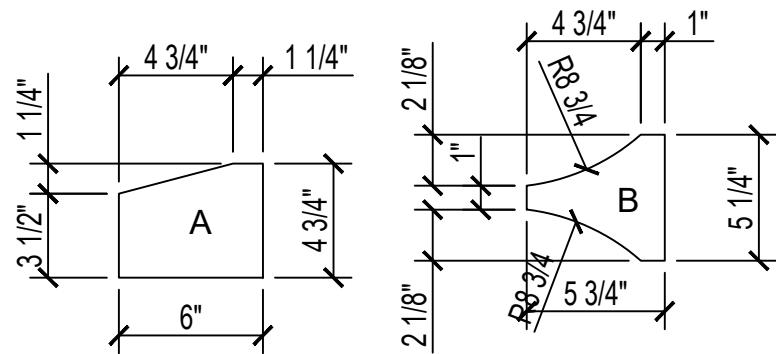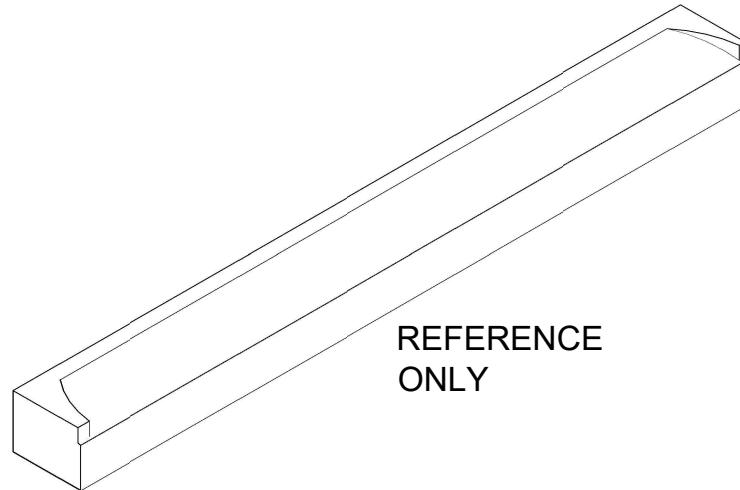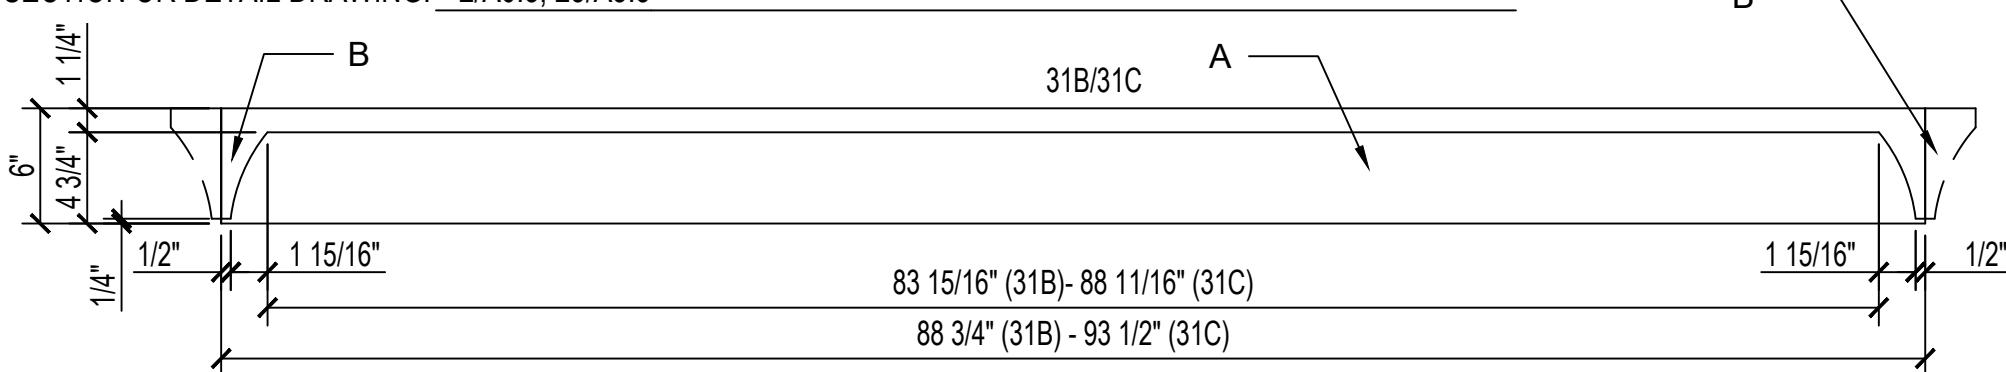

PART DESCRIPTION	DIM. A.	WIDE	DIM. B.	QTY	CUBIC FT	ARCH. SHEET	WDW / DR #	ROOM #	GRID LINE(S)	KEY #
SILL	89 3/8"	6"	4 3/4"	1(R) 1(L)	2.95	1/2.01a	E129-130, E149-150	119a	6-7	31A
SILL	88 3/4"	6"	4 3/4"	2	2.93	1/2.01a	E135-136, E143-144	119a	6-7	31B
SILL	93 1/2"	6"	4 3/4"	1	1.54	1/2.01a	E138	119a	6-7	31C




820 WILLOW STREET
MANKATO MN, 56001
507-508-0684

PAGE 32

JOB #: _____
SOLD TO: _____
JOB NAME: GALE ROAD
LOCATION: WOODLAND, MN
SECTION OR DETAIL DRAWING: 5/A6.4a, 4a/A8.2

DATE: 03/10/2021
STOCK: LIMESTONE
FINISH: HONED

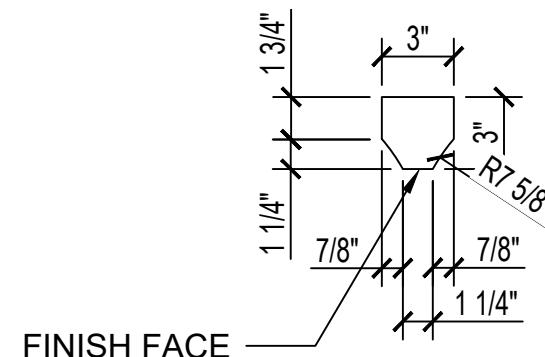

PART DESCRIPTION	DIM. A.	WIDE	HEIGHT	QTY	CUBIC FT	ARCH. SHEET	WDW / DR #	ROOM #	GRID LINE(S)	KEY #
MULLION	46 1/16"	3"	3"	4	.96	1/2.01	E215-221	209a,213a,213b	4-5	32D
MULLION	44"	3"	3"	8	1.83	2/2.02	W222-230	209a	5-4	32E
MULLION	28 1/2"	3"	3"	3	.45	2/2.04	N212-215	212	E	32F
MULLION	46 1/16"	3"	3"	8	1.92	2/3.1	S205-215		A-B	32D



820 WILLOW STREET
MANKATO MN, 56001
507-508-0684

PAGE 35

JOB #: _____

SOLD TO: _____

DATE: 03/08/2021


JOB NAME: GALE ROAD

STOCK: LIMESTONE

LOCATION: WOODLAND, MN


FINISH: HONED

SECTION OR DETAIL DRAWING: 13/A8.3

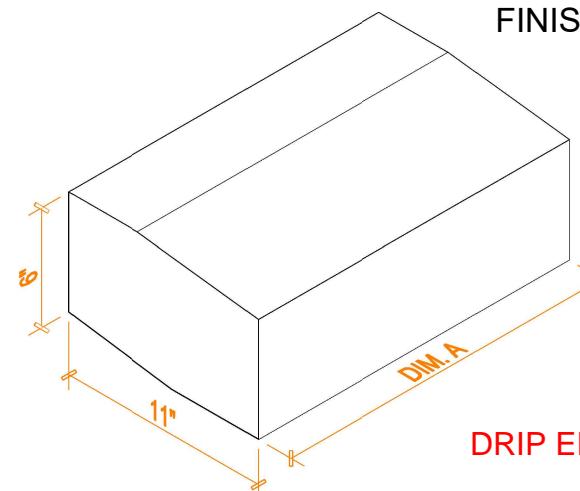

FINISH FACE

DRIP EDGE

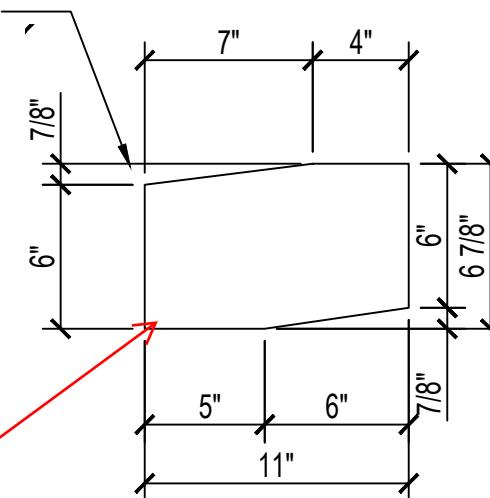

**RETURN CORNER

PART DESCRIPTION	DIM. A.	WIDE	HEIGHT	QTY	CUBIC FT	ARCH. SHEET	WDW / DR #	ROOM #	GRID LINE(S)	KEY #
WATERTABLE BASE #1	59 5/8"	9 9/16"	7 3/4"	2	5.81	1/2.01			5-6	35R
WATERTABLE BASE #1	53 1/2"	9 9/16"	7 3/4"	1	2.12	2/2.04			E	35S **
WATERTABLE BASE #1	60 1/2"	9 9/16"	7 3/4"	1	2.51	2/2.04	NEEDS OUTER CORNER RETURN			35T **
WATERTABLE BASE #1	24 3/4	9 9/16"	7 3/4"	1	3.17		NEEDS OUTER CORNER RETURN			35U



820 WILLOW STREET
MANKATO MN, 56001
507-508-0684

PAGE 36

JOB #: _____

SOLD TO: _____

DATE: 03/10/2021

JOB NAME: GALE ROAD

STOCK: LIMESTONE


LOCATION: WOODLAND, MN

FINISH: HONED

SECTION OR DETAIL DRAWING: 17/A8.3

PART DESCRIPTION	DIM. A.	WIDE	HEIGHT	QTY	CUBIC FT	ARCH. SHEET	WDW / DR #	ROOM #	GRID LINE(S)	KEY #
STONE SILL - TYPE 5	28 ¹ / ₈ "	4"	9 3/4"	1	.48	2/3.1	S113	112		36E

FIELD CUT AS REQ'D

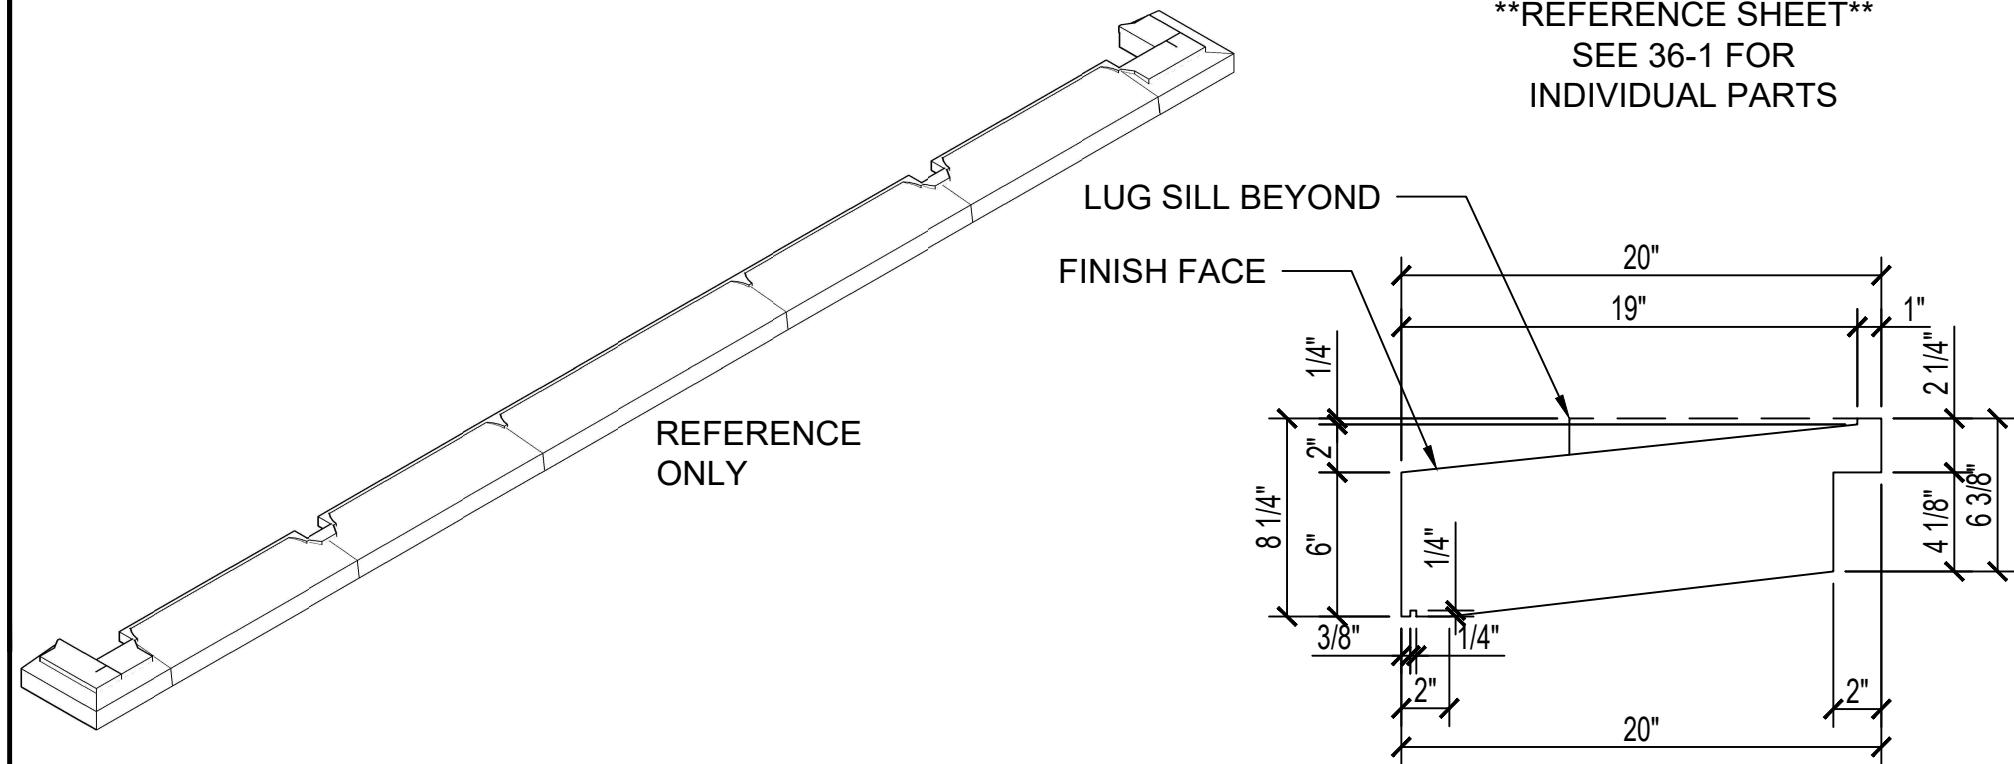







820 WILLOW STREET
MANKATO MN, 56001
507-508-0684

PAGE 36-1

JOB #: _____
SOLD TO: _____
JOB NAME: GALE ROAD
LOCATION: WOODLAND, MN
SECTION OR DETAIL DRAWING: 17/A8.3

DATE: 03/10/2021
STOCK: LIMESTONE
FINISH: HONED

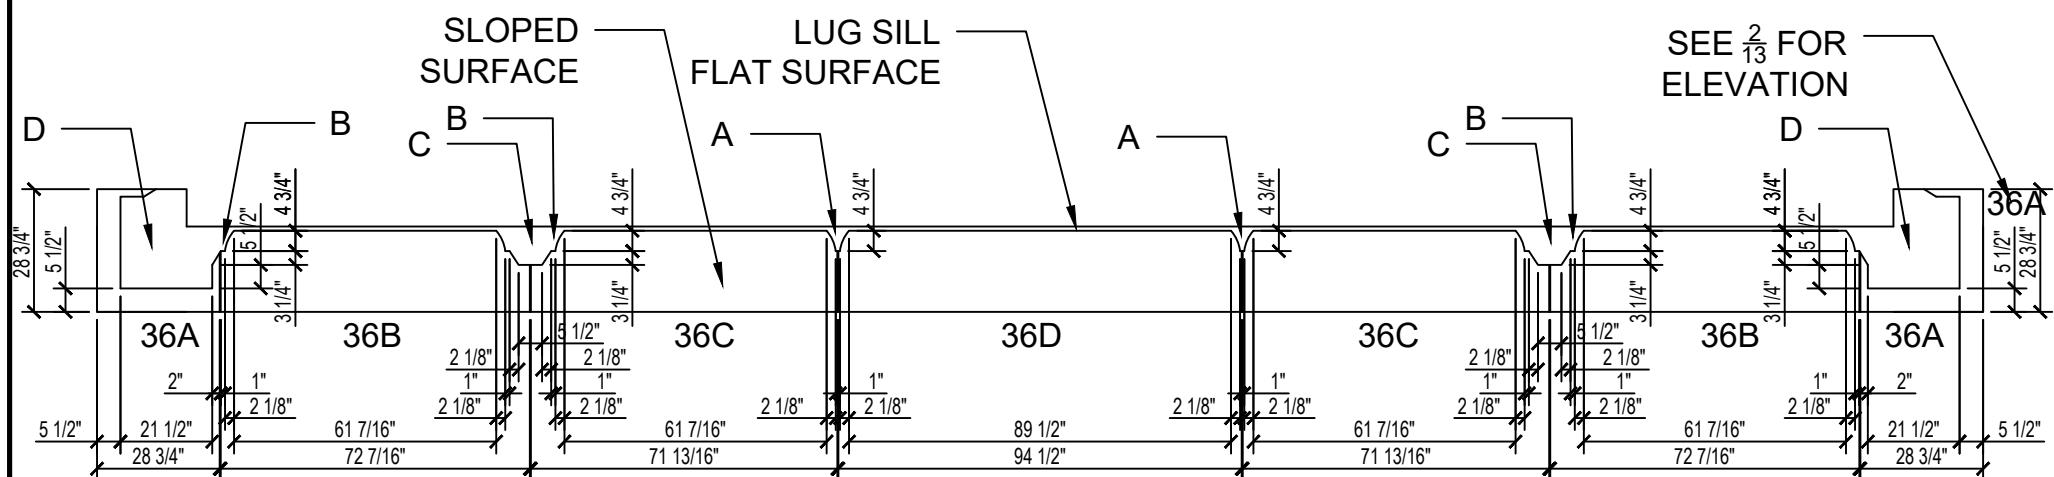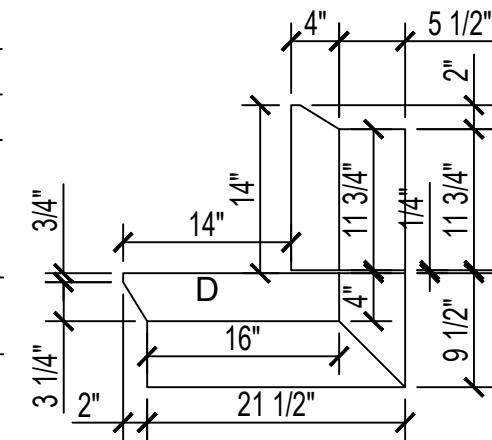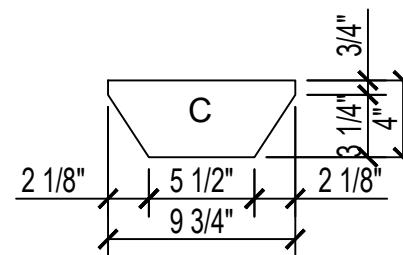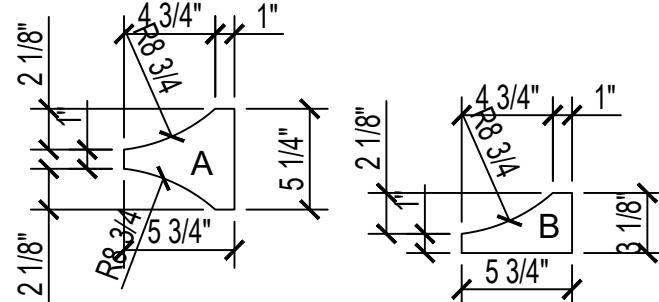

SEE $\frac{2}{13}$ FOR ELEVATION

PART DESCRIPTION	DIM. A.	WIDE	HEIGHT	QTY	CUBIC FT	ARCH. SHEET	WDW / DR #	ROOM #	GRID LINE(S)	KEY #
STONE SILL - TYPE 5	28 3/4"	4"	9 3/4"	5	3.25	2/A2.01, 2/3.1	W111-125, S113	126, 112	8-7	36A
STONE SILL - TYPE 5	72 7/16"	4"	9 3/4"	2	3.27	2/A2.01	W111-125	126	8-7	36B
STONE SILL - TYPE 5	71 13/16"	4"	9 3/4"	2	3.24	2/A2.01	W111-125	126	8-7	36C
STONE SILL - TYPE 5	94 1/2"	4"	9 3/4"	1	2.13	2/A2.01	W111-125	126	8-7	36D





820 WILLOW STREET
MANKATO MN, 56001
507-508-0684

PAGE 37

JOB #: _____
SOLD TO: _____
JOB NAME: GALE ROAD
LOCATION: WOODLAND, MN
SECTION OR DETAIL DRAWING: 7/A8.3a



DATE: 03/10/2021
STOCK: LIMESTONE
FINISH: HONED

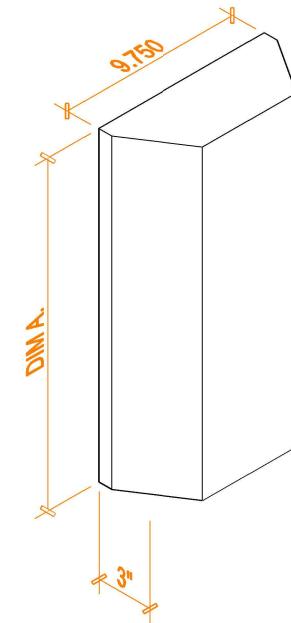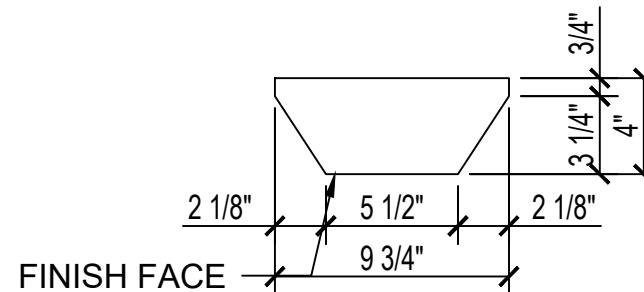

PART DESCRIPTION	DIM. A.	WIDE	WIDTH	QTY	CUBIC FT	ARCH. SHEET	WDW / DR #	ROOM #	GRID LINE(S)	KEY #
MULLION TYPE 2	34 3/8"	4"	9 3/4"	2	1.55	2/A2.01	W127-141	112	6-5	37A
MULLION TYPE 2	36 7/16"	4"	9 3/4"	2	1.64	2/A2.01	W127-141	112	6-5	37B
MULLION TYPE 2	36 3/8"	4"	9 3/4"	2	1.64	2/A2.01	W127-141	112	6-5	37C
MULLION TYPE 2	11"	4"	9 3/4"	2	.49	2/2.01	W127-141	112	6-5	37D
MULLION TYPE 2	32 3/4"	4"	9 3/4"	5	3.70	2/3.1	S115a-116b	111		37E
MULLION TYPE 2	32 13/16"	4"	9 3/4"	1	.74	2/2.02	W144-147	115	5-4	37F

JOB #: _____
 SOLD TO: _____
 JOB NAME: GALE ROAD
 LOCATION: WOODLAND, MN
 SECTION OR DETAIL DRAWING: 6/A8.3


DATE: 03/10/2021
 STOCK: LIMESTONE
 FINISH: HONED

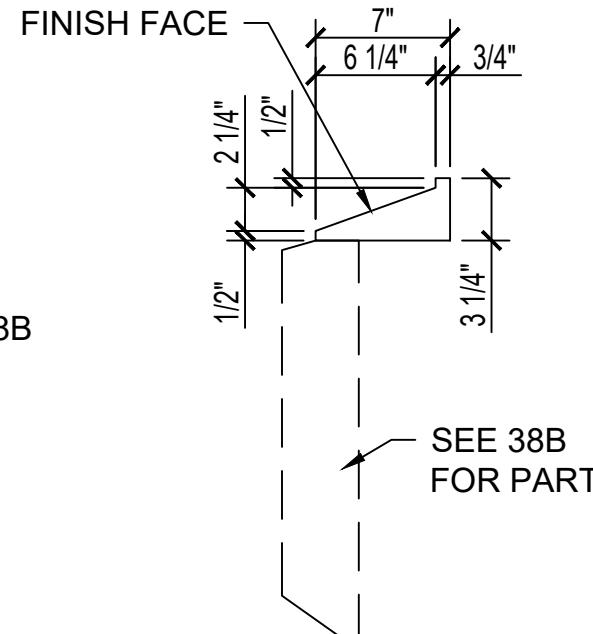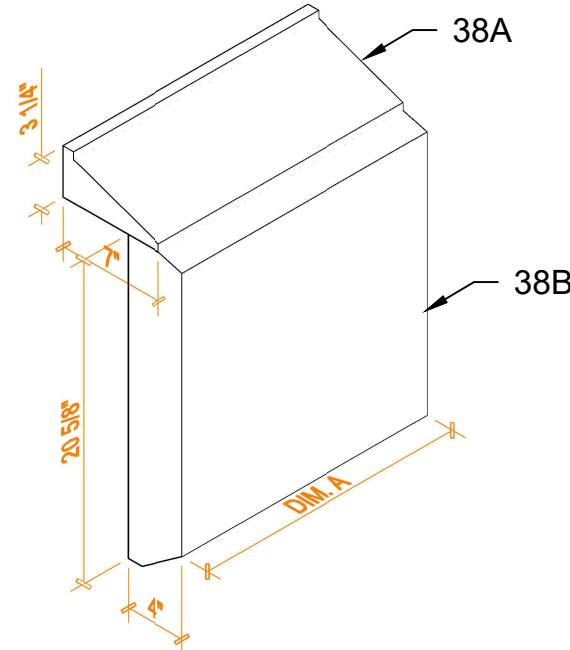

PART DESCRIPTION	DIM. A.	WIDE	HEIGHT	QTY	CUBIC FT	ARCH. SHEET	WDW / DR #	ROOM #	GRID LINE(S)	KEY #
STONE HEADER - 1D	66 7/8"	3 1/4"	7"	2	1.76	2/A2.01	W114-117	126	8-7	38A-1
STONE HEADER - 1D	94 1/2"	3 1/4"	7"	1	1.24	2/A2.01	W114-117	126	8-7	38A-2

JOB #: _____
 SOLD TO: _____
 JOB NAME: GALE ROAD
 LOCATION: WOODLAND, MN
 SECTION OR DETAIL DRAWING: 6/A8.3

DATE: 03/10/2021
 STOCK: LIMESTONE
 FINISH: HONED

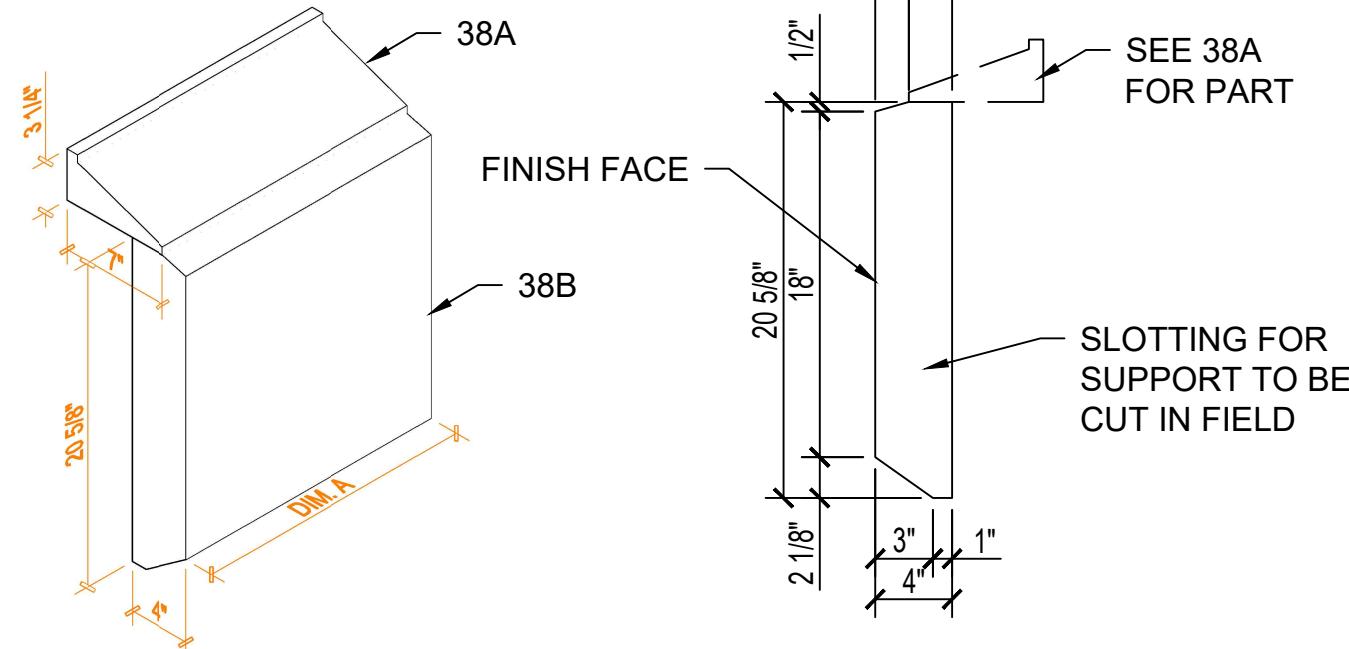

PART DESCRIPTION	DIM. A.	WIDE	HEIGHT	QTY	CUBIC FT	ARCH. SHEET	WDW / DR #	ROOM #	GRID LINE(S)	KEY #
STONE HEADER - 1D	66 7/8"	3 1/4"	7"	2	1.76	2/A2.01	W114-117	126	8-7	38B-1
STONE HEADER - 1D	94 1/2"	3 1/4"	7"	1	1.24	2/A2.01	W114-117	126	8-7	38B-2



820 WILLOW STREET
MANKATO MN, 56001
507-508-0684

PAGE 44

JOB #: _____

SOLD TO: _____

DATE: 03/10/2021

JOB NAME: GALE ROAD

STOCK: LIMESTONE



LOCATION: WOODLAND, MN

FINISH: HONED

SECTION OR DETAIL DRAWING: 3/A6.3, 12/A8.3

PART DESCRIPTION	DIM. A.	WIDE	LENGTH	QTY	CUBIC FT	ARCH. SHEET	WDW / DR #	ROOM #	GRID LINE(S)	KEY #
BASE FLARE -TYPE A	11"	9 1/2"	23 1/2"	2(L)2(R)	5.68	1/2.03, 2/2.01	N134,N140,W129,W141	131a	B-A	44C
BASE FLARE -TYPE B	11"	9 1/2"	13 3/4"	2(L)1(R)	2.49	1/2.01, 2/2.01, 2/3.1	E178, W108, S113	131a, 112	9	44D

2L 2R - AN
ELEVATION IS NOT
ACCOUNTED FOR
SEE 3/12 FOR
ADDITIONAL NOTE

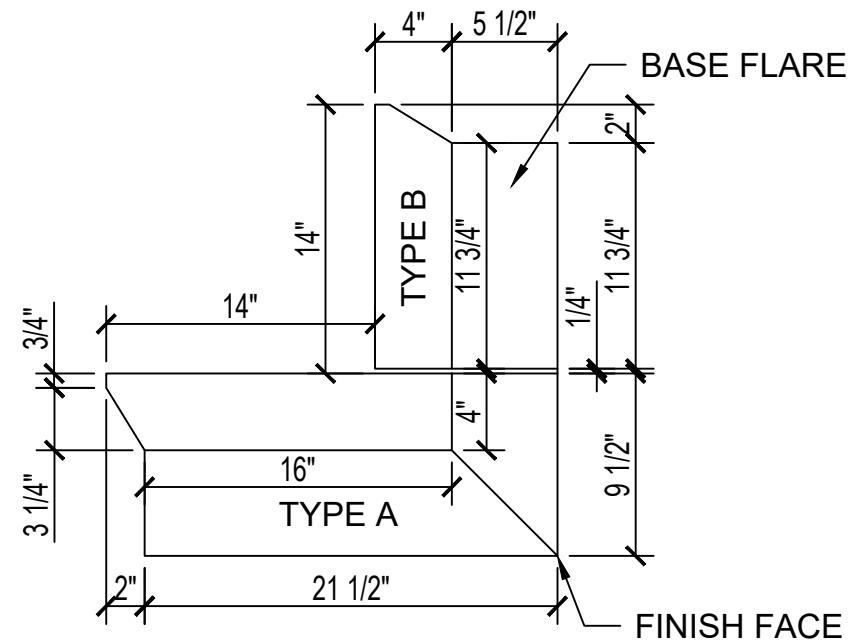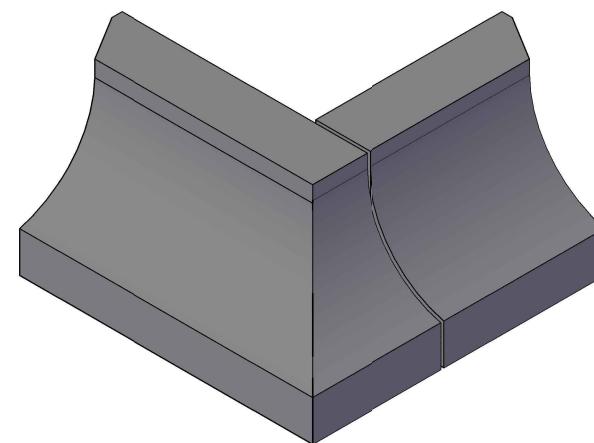




820 WILLOW STREET
MANKATO MN, 56001
507-508-0684

PAGE 45


JOB #: _____
SOLD TO: _____
JOB NAME: GALE ROAD
LOCATION: WOODLAND, MN
SECTION OR DETAIL DRAWING: 21/A8.3

DATE: 03/10/2021
STOCK: LIMESTONE
FINISH: HONED

REFERENCE SHEET
SEE SHEET 45-1 FOR
INDIVIDUAL PARTS

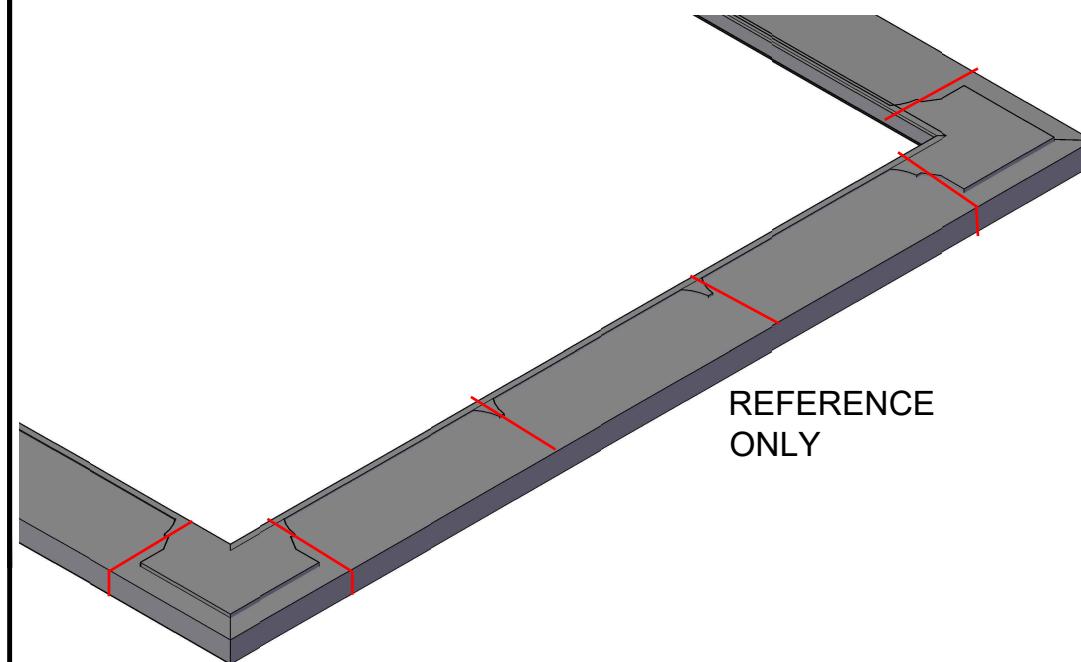

FINISH FACE

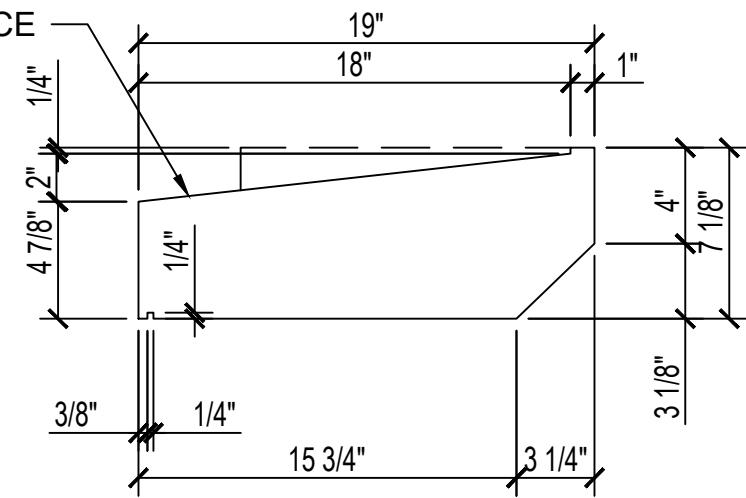




820 WILLOW STREET
MANKATO MN, 56001
507-508-0684

PAGE 45-1


ADJUST PER PLAN
AND ELEV. NOTES

JOB #: _____
SOLD TO: _____
JOB NAME: GALE ROAD
LOCATION: WOODLAND, MN
SECTION OR DETAIL DRAWING: 21/A8.3

DATE: 03/10/2021
STOCK: LIMESTONE
FINISH: HONED

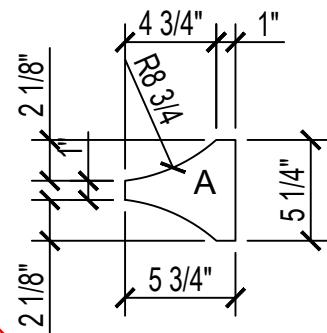

PART DESCRIPTION	DIM. A.	WIDE	HEIGHT	QTY	CUBIC FT	ARCH. SHEET	WDW / DR #	ROOM #	GRID LINE(S)	KEY #
STONE SILL TYPE 9	5 1/4"	19"	7 1/8"	1L21R	.82	SEE PLAN NOTE BELOW	21/A8.3, W108	131a	9	45C
STONE SILL TYPE 9	36 3/4"	19"	7 1/8"	2	5.76	1/2.01, 2/2.01	E178, W108	131a	9	45D
STONE SILL TYPE 9	27 3/4"	19"	7 1/8"	2	4.35	1/2.01, 2/2.01	E178, W108	131a	9	45E
STONE SILL TYPE 9	36 3/8" VFY	19"	7 1/8"	2	10.09	1/2.03	N134-140	131a	B-A	45F
STONE SILL TYPE 9	35 3/4"	19"	7 1/8"	1	2.80	1/2.03	N134-140	131a	B-A	45G

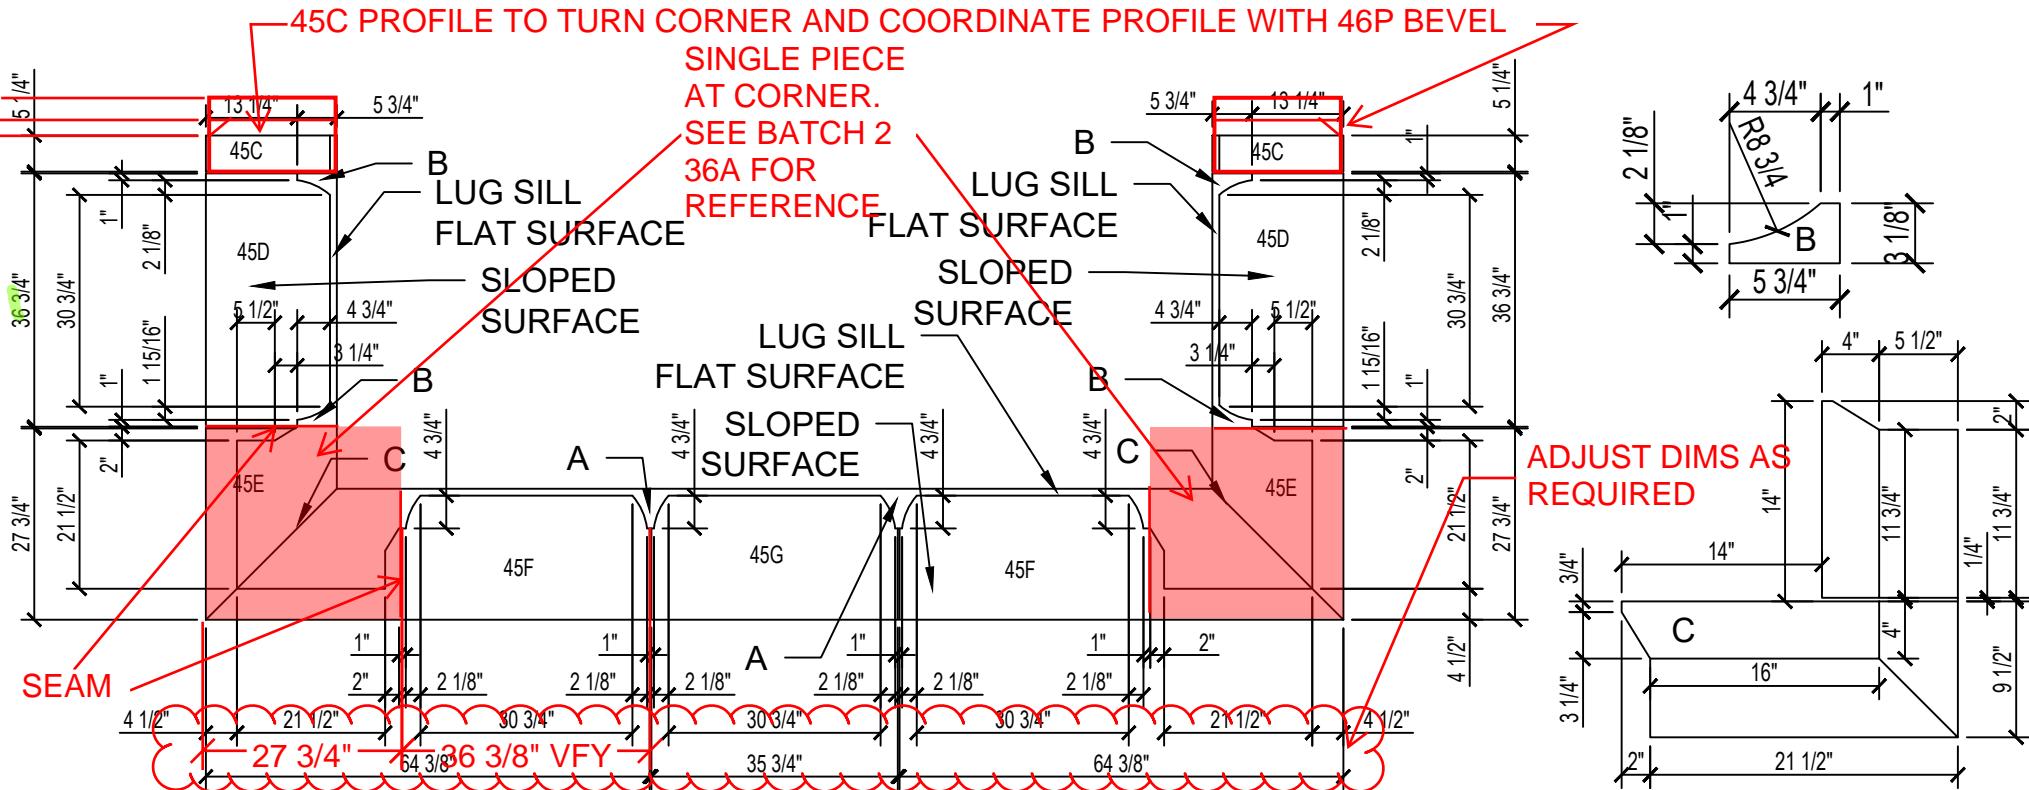





820 WILLOW STREET
MANKATO MN, 56001
507-508-0684

PAGE 47A
PAGE 47B
PAGE 47C
PAGE 47D


JOB #: _____
SOLD TO: _____
JOB NAME: GALE ROAD
LOCATION: WOODLAND, MN
SECTION OR DETAIL DRAWING: 19/A8.3

DATE: 03/10/2021
STOCK: LIMESTONE
FINISH: HONED

PART DESCRIPTION	DIM. A.	WIDE	HEIGHT	QTY	CUBIC FT	ARCH. SHEET	WDW / DR #	ROOM #	GRID LINE(S)	KEY #
SILL TYPE 7 - A	46"	5 3/4"	1 3/4"	2	.53	2/3.1	115b, 116b	111		47A
SILL TYPE 7 - B	57"	12 1/8"	6 1/2"	2	5.2	2/3.1	115b, 116b	111		47B
SILL TYPE 7 - B	9"	12 1/8"	6 1/2"	1	.41	2/3.1	115b, 116b	111		47C
SILL TYPE 7 - B	8 1/4"	12 1/8"	6 1/2"	1	.37	2/3.1	115b, 116b	111		47D

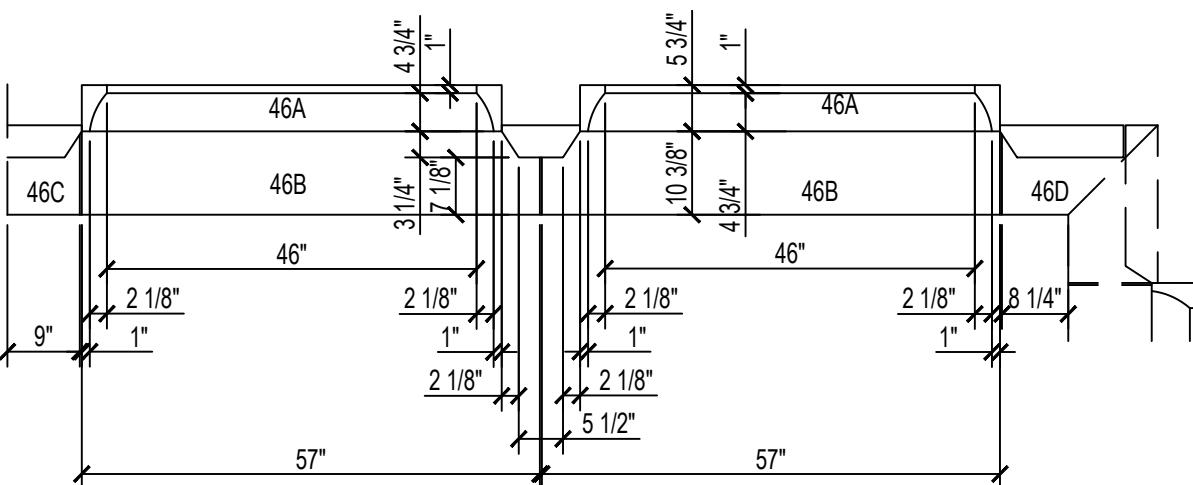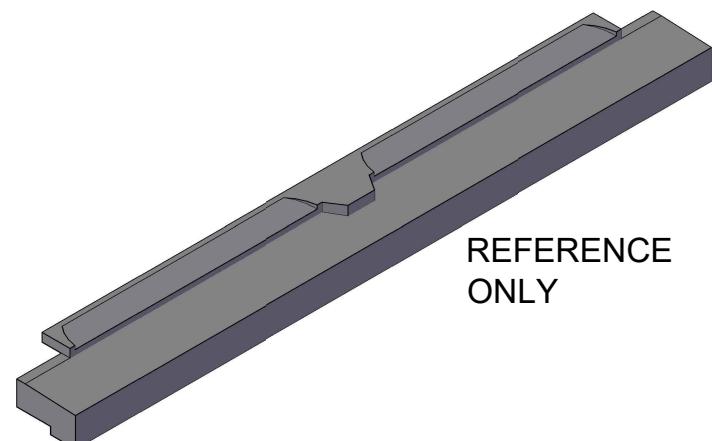

FINISH FACE

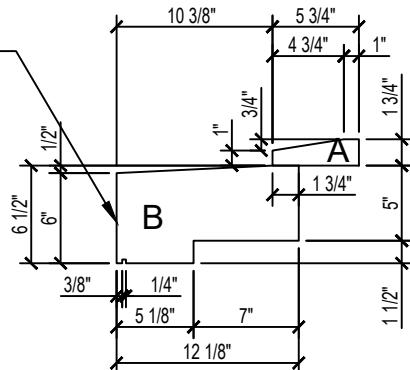




820 WILLOW STREET
MANKATO MN, 56001
507-508-0684


PAGE 47E

JOB #: _____
SOLD TO: _____
JOB NAME: GALE ROAD
LOCATION: WOODLAND, MN
SECTION OR DETAIL DRAWING: 19/A8.3

DATE: 03/10/2021
STOCK: LIMESTONE
FINISH: HONED

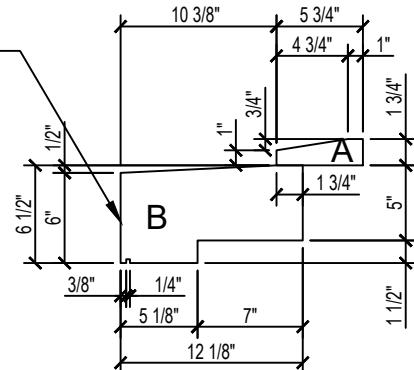

PART DESCRIPTION	DIM. A.	WIDE	HEIGHT	QTY	CUBIC FT	ARCH. SHEET	WDW / DR #	ROOM #	GRID LINE(S)	KEY #
SILL TYPE 7 - B	8 1/2"	12 1/8"	6 1/2"	1	DOES THIS TURN THE INNER CORNER?			115	5-4	47E
SILL TYPE 7 - A	84 1/4"	5 3/4"	1 3/4"	1	.45	2/2.02	W143-147	115	5-4	47F
SILL TYPE 7 - B	88 3/4"	12 1/8"	6 1/2"	1	3.82	2/2.02	W143-147	115	5-4	47G
SILL TYPE 7 - B	9 3/4"	12 1/8"	6 1/2"	1	.44	2/2.02	W143-147	115	5-4	47H
SILL TYPE 7 - A	44 3/4"	5 3/4"	1 3/4"	1	.22	2/2.02	W143-147	115	5-4	47J
SILL TYPE 7 - B	49 1/4"	12 1/8"	6 1/2"	1	1.89	2/2.02	W143-147	115	5-4	47K
SILL TYPE 7 - B	9 3/8"	12 1/8"	6 1/2"	1	.57	2/2.02	W143-147	115	5-4	47L

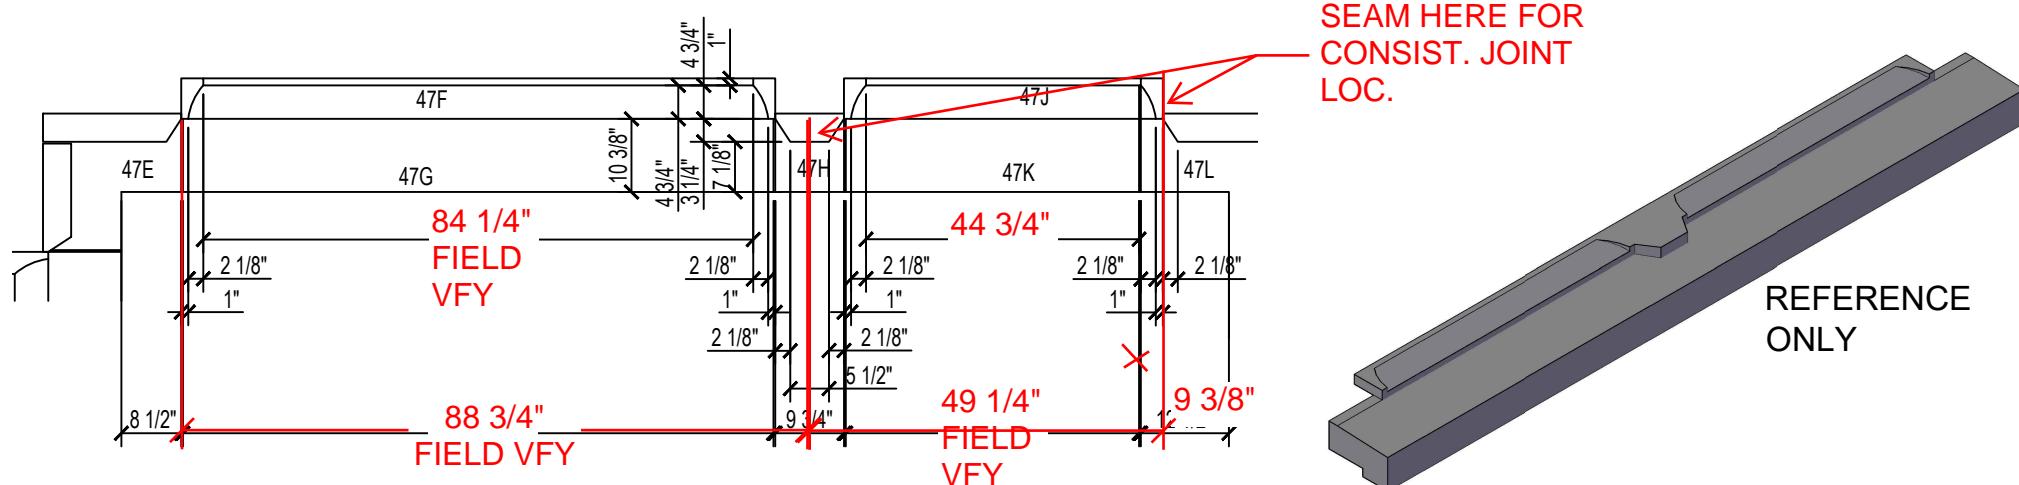





820 WILLOW STREET
MANKATO MN, 56001
507-508-0684


PAGE 48

JOB #: _____
SOLD TO: _____
JOB NAME: GALE ROAD
LOCATION: WOODLAND, MN
SECTION OR DETAIL DRAWING: 10/A8.2

DATE: 03/10/2021
STOCK: LIMESTONE
FINISH: HONED

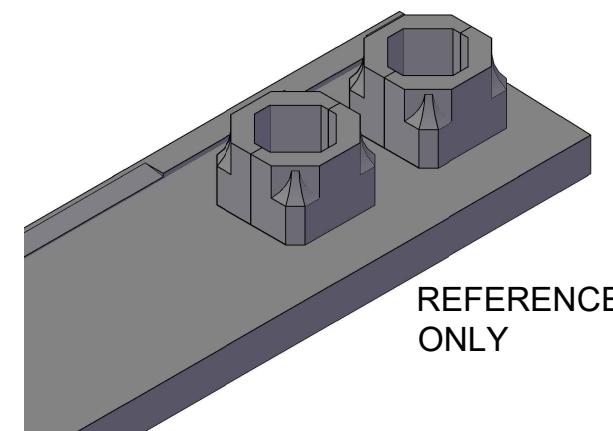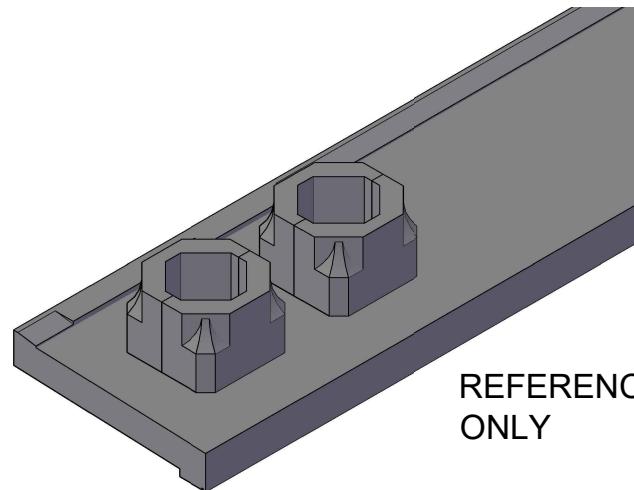

REFERENCE SHEET
SEE SHEETS 48-1 AND 48-1
FOR INDIVIDUAL PARTS

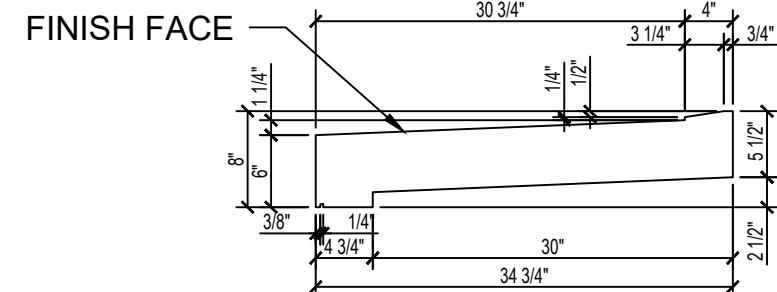




820 WILLOW STREET
MANKATO MN, 56001
507-508-0684

PAGE 48-1

JOB #: _____
SOLD TO: _____
JOB NAME: GALE ROAD
LOCATION: WOODLAND, MN
SECTION OR DETAIL DRAWING: 10/A8.2

DATE: 03/10/2021
STOCK: LIMESTONE
FINISH: HONED

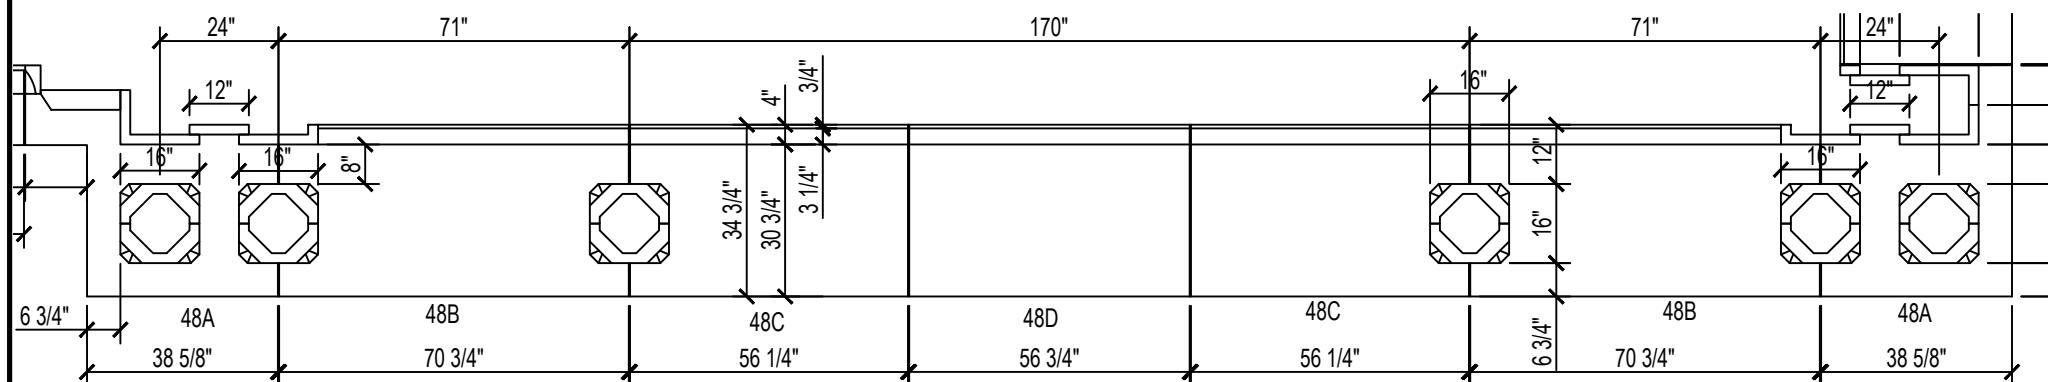

PART DESCRIPTION	DIM. A.	WIDE	HIEGHT	QTY	CUBIC FT	ARCH. SHEET	WDW / DR #	ROOM #	GRID LINE(S)	KEY #
STONE SILL TYPE 10	38 5/8"	34 3/4"	8"	2	12.43	2/2.02	W149-152	102	4-3	48A
STONE SILL TYPE 10	70 3/4"	34 3/4"	8"	2	22.76	2/2.02	W149-152	102	4-3	48B
STONE SILL TYPE 10	56 1/4"	34 3/4"	8"	2	18.09	2/2.02	W149-152	102	4-3	48C
STONE SILL TYPE 10	56 3/4"	34 3/4"	8"	1	9.13	2/2.02	W149-152	102	4-3	48D
STONE SILL TYPE 10	46 13/16"	34 3/4"	8"	1	7.53	2/2.02	W149-152	102	4-3	48E
STONE SILL TYPE 10	40 5/8"	34 3/4"	8"	2	13.07	2/2.02	W149-152	102	4-3	48F
STONE SILL TYPE 10	38 9/16"	34 3/4"	8"	1	6.20	2/2.02	W149-152	102	4-3	48G




820 WILLOW STREET
MANKATO MN, 56001
507-508-0684

PAGE 48-2

JOB #: _____
SOLD TO: _____
JOB NAME: GALE ROAD
LOCATION: WOODLAND, MN
SECTION OR DETAIL DRAWING: 10/A8.2

DATE: 03/10/2021
STOCK: LIMESTONE
FINISH: HONED

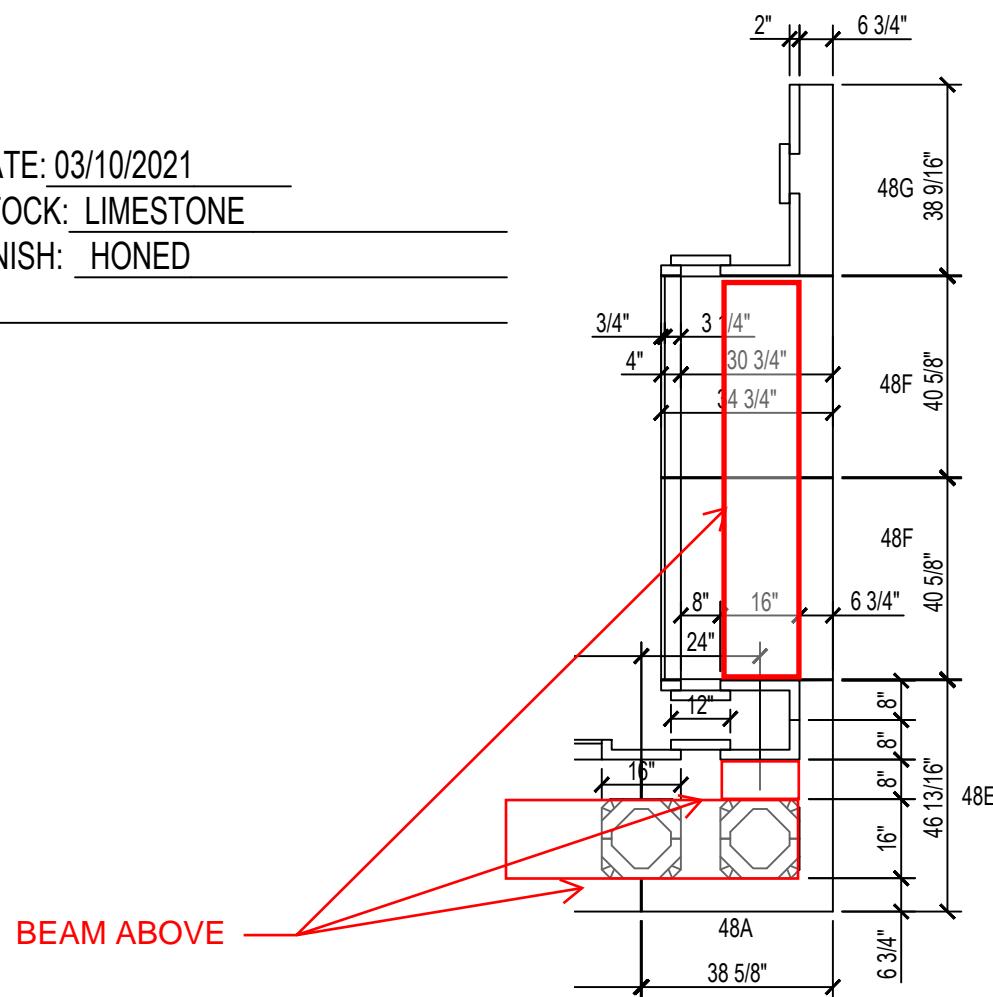

PART DESCRIPTION	DIM. A.	WIDE	HIEGHT	QTY	CUBIC FT	ARCH. SHEET	WDW / DR #	ROOM #	GRID LINE(S)	KEY #
STONE SILL TYPE 10	38 5/8"	34 3/4"	8"	2	12.43	2/2.02	W149-152	102	4-3	48A
STONE SILL TYPE 10	70 3/4"	34 3/4"	8"	2	22.76	2/2.02	W149-152	102	4-3	48B
STONE SILL TYPE 10	56 1/2"	34 3/4"	8"	2	18.09	2/2.02	W149-152	102	4-3	48C
STONE SILL TYPE 10	56 3/4"	34 3/4"	8"	1	9.13	2/2.02	W149-152	102	4-3	48D
STONE SILL TYPE 10	46 13/16"	34 3/4"	8"	1	7.53	2/2.02	W149-152	102	4-3	48E
STONE SILL TYPE 10	40 5/8"	34 3/4"	8"	2	13.07	2/2.02	W149-152	102	4-3	48F
STONE SILL TYPE 10	38 9/16"	34 3/4"	8"	1	6.20	2/2.02	W149-152	102	4-3	48G

JOB #: _____

SOLD TO: _____

DATE: 03/10/2021

JOB NAME: GALE ROAD



STOCK: LIMESTONE

LOCATION: WOODLAND, MN

FINISH: HONED

SECTION OR DETAIL DRAWING: 20/A8.3

PART DESCRIPTION	DIM. A.	WIDE	HIEGHT	QTY	CUBIC FT	ARCH. SHEET	WDW / DR #	ROOM #	GRID LINE(S)	KEY #
STONE SILL TYPE 8	33 1/2"	5 1/2"	6 1/4"	1	1.33	2/3.1	S113	112		49A
STONE SILL TYPE 8	33 1/2"	16"	9 1/8"	1	5.66	2/3.1	A113	112		49B

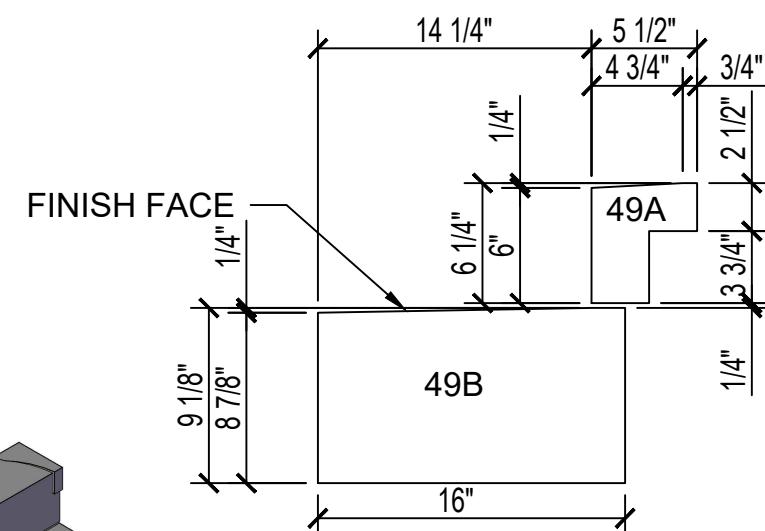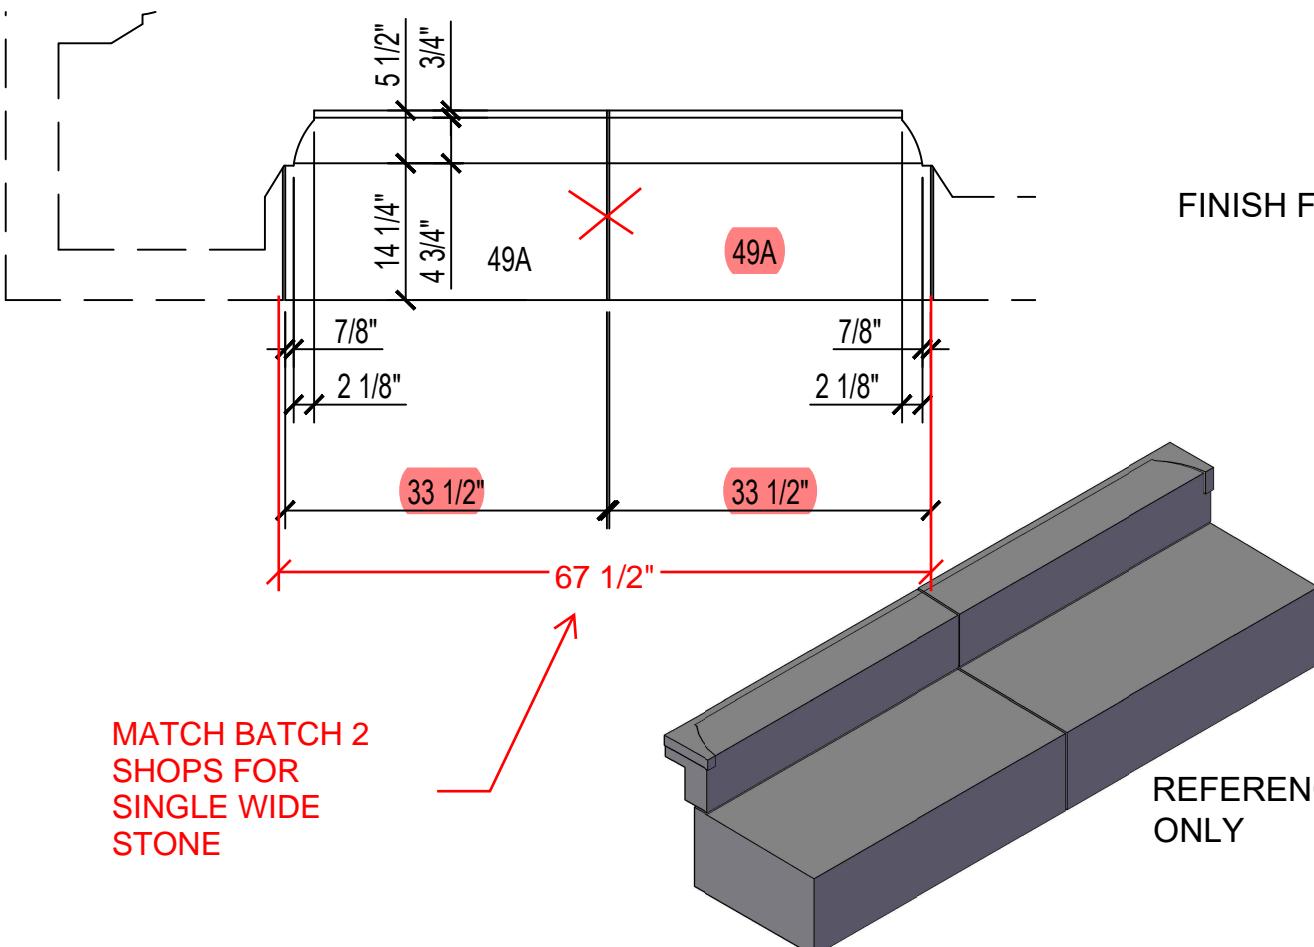

REFERENCE
ONLY




820 WILLOW STREET
MANKATO MN, 56001
507-508-0684

PAGE 52


JOB #: _____
SOLD TO: _____
JOB NAME: GALE ROAD
LOCATION: WOODLAND, MN
SECTION OR DETAIL DRAWING: 2/A8.2a

DATE: 03/10/2021
STOCK: LIMESTONE
FINISH: HONED

FINISH FACE

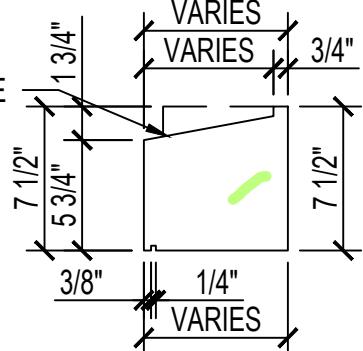

PART DESCRIPTION	DIM. A.	WIDE	HIEGHT	QTY	CUBIC FT	ARCH. SHEET	WDW / DR #	ROOM #	GRID LINE(S)	KEY #
TURRET WDW SILL										
TURRET WDW SILL										
TURRET WDW SILL										
TURRET WDW SILL										

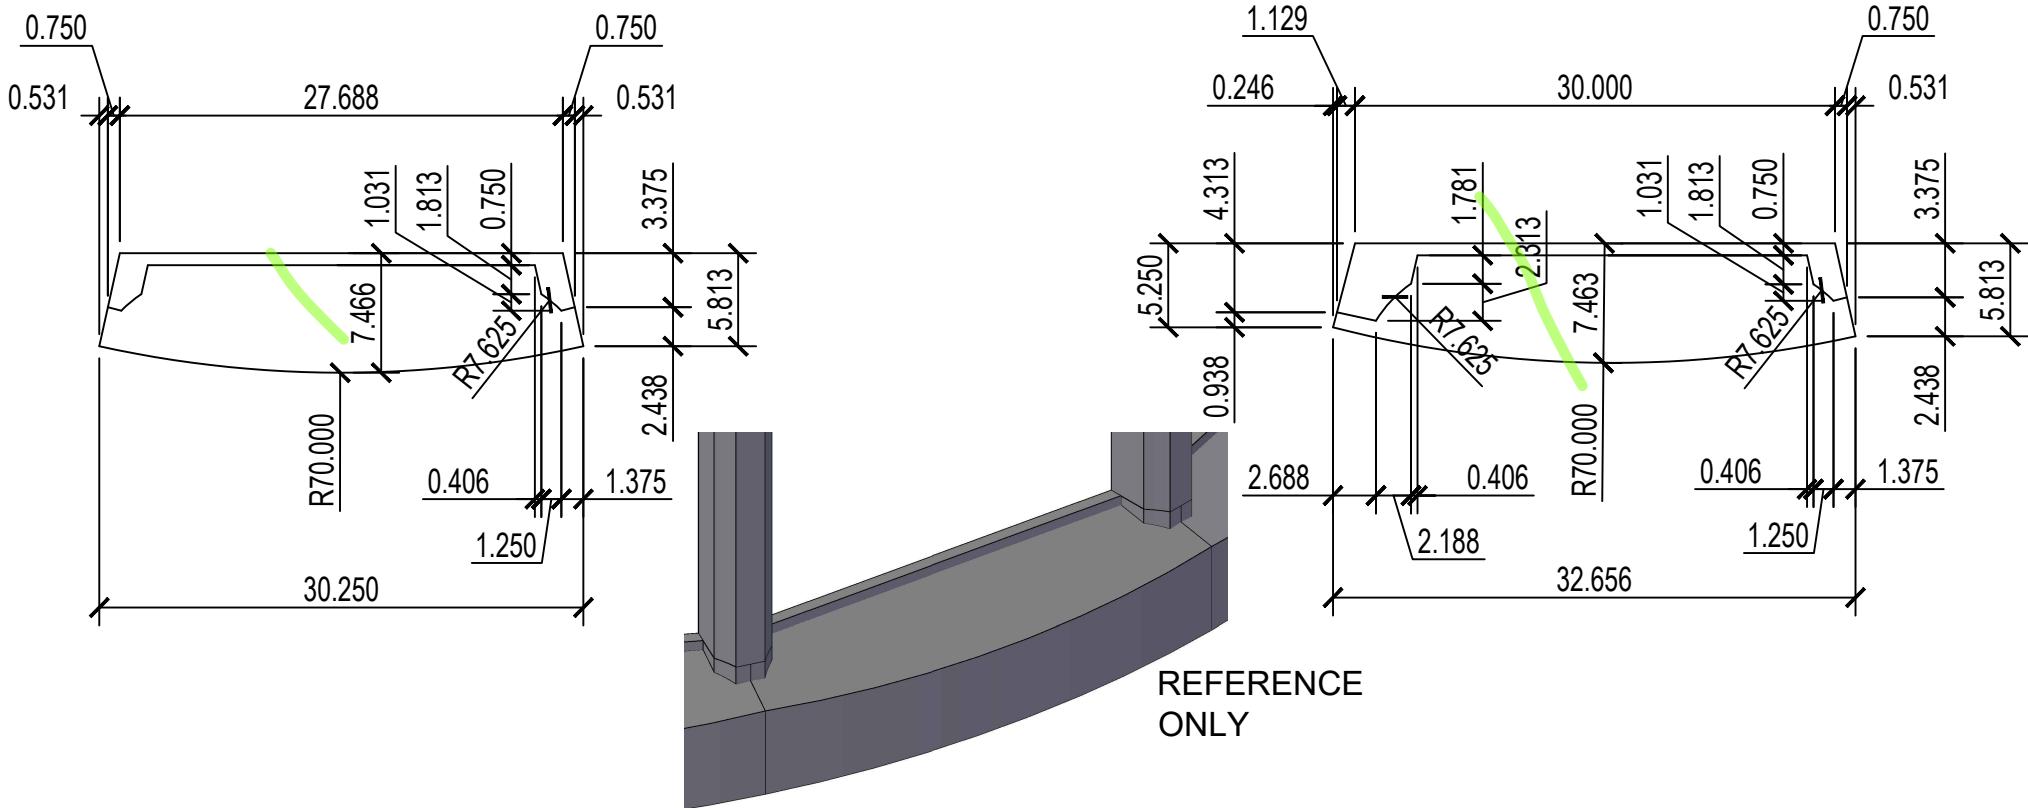

JOB #: _____

SOLD TO: _____

JOB NAME: GALE ROAD

LOCATION: WOODLAND, MN


SECTION OR DETAIL DRAWING: 5/A8.2a

DATE: 03/10/2021

STOCK: LIMESTONE

FINISH: HONED


PART DESCRIPTION	DIM. A.	WIDE	HIEGHT	QTY	CUBIC FT	ARCH. SHEET	WDW / DR #	ROOM #	GRID LINE(S)	KEY #
TURRET WDW MULL.										

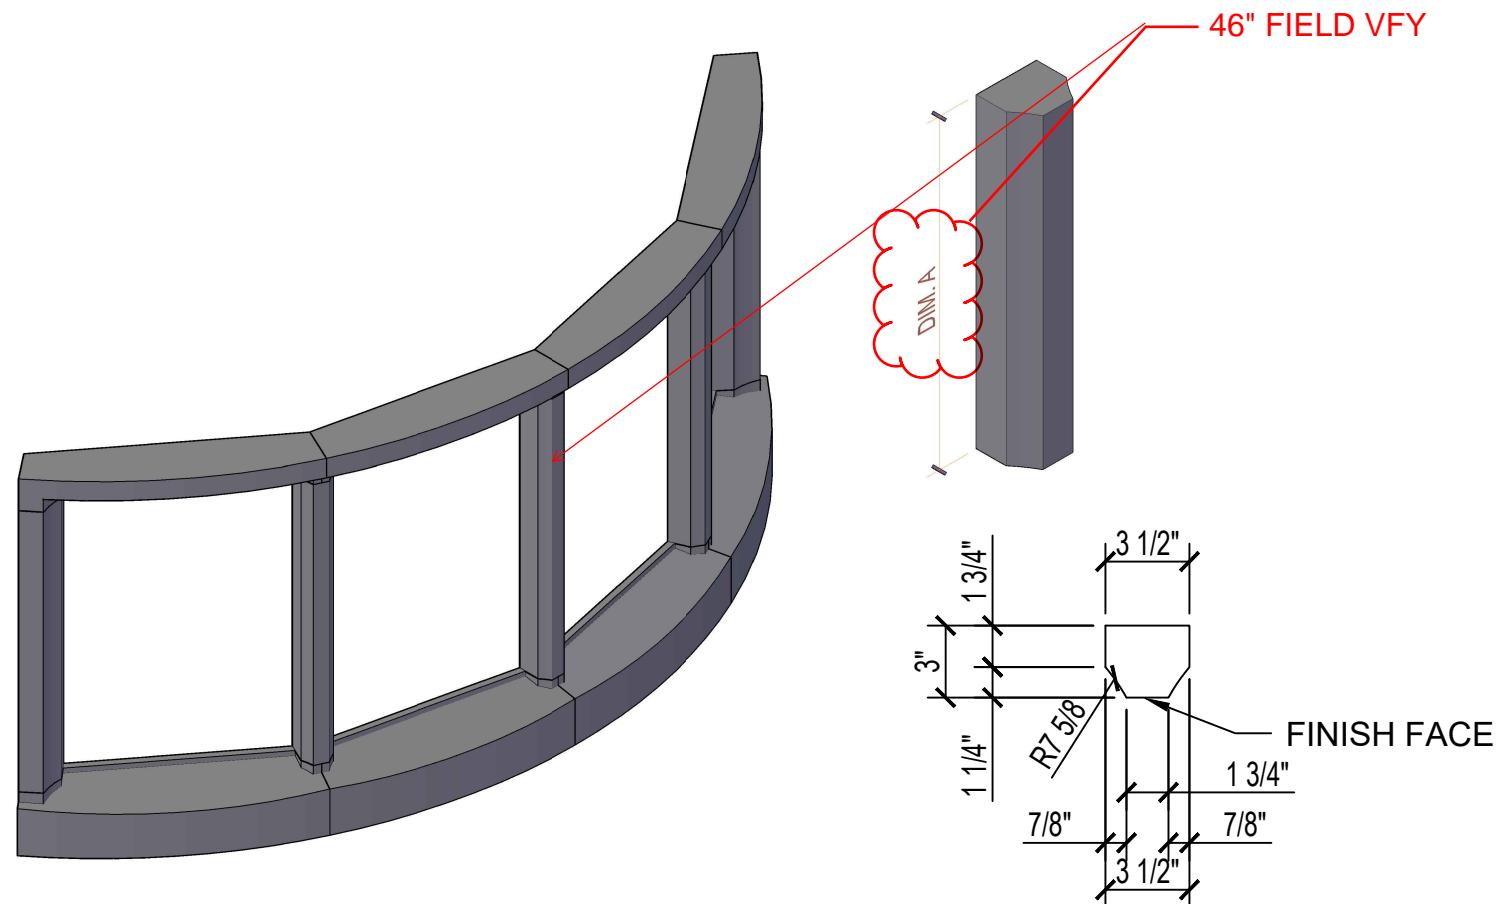




JOB #: _____
 SOLD TO: _____
 JOB NAME: GALE ROAD
 LOCATION: WOODLAND, MN
 SECTION OR DETAIL DRAWING: 7/A8.2a

DATE: 03/10/2021
 STOCK: LIMESTONE
 FINISH: HONED

FINISH FACE

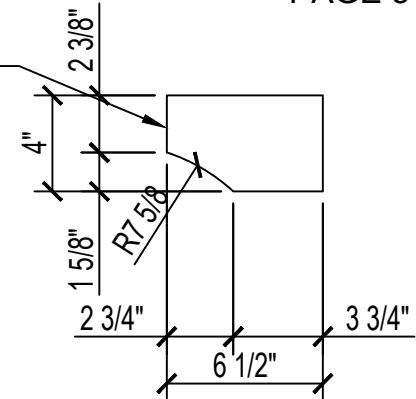

PART DESCRIPTION	DIM. A.	WIDE	HIEGHT	QTY	CUBIC FT	ARCH. SHEET	WDW / DR #	ROOM #	GRID LINE(S)	KEY #
TURRET WDW HEAD										
TURRET WDW HEAD										
TURRET WDW HEAD										
TURRET WDW HEAD										

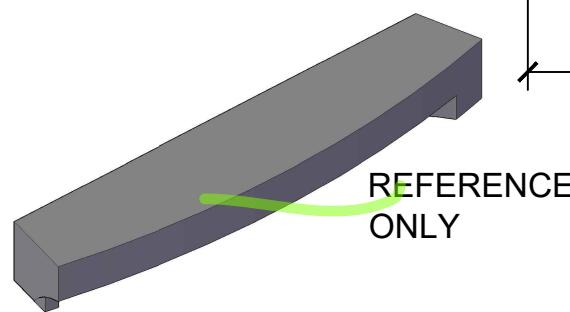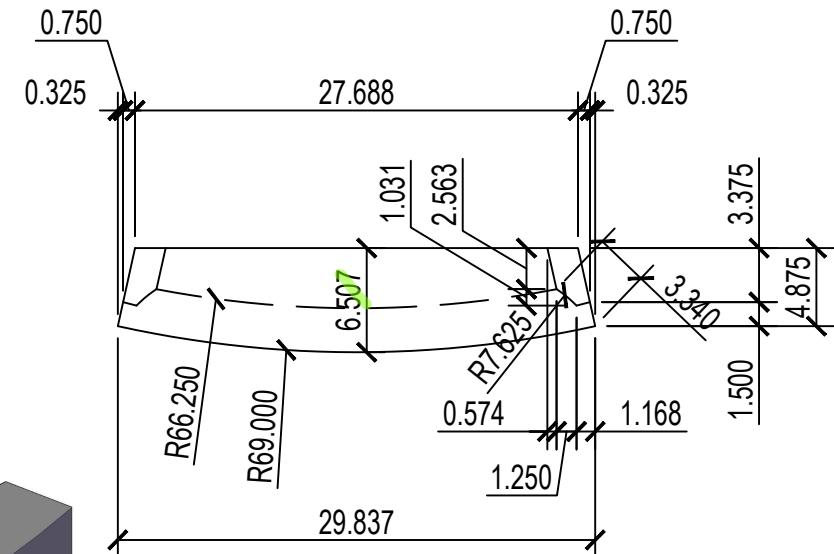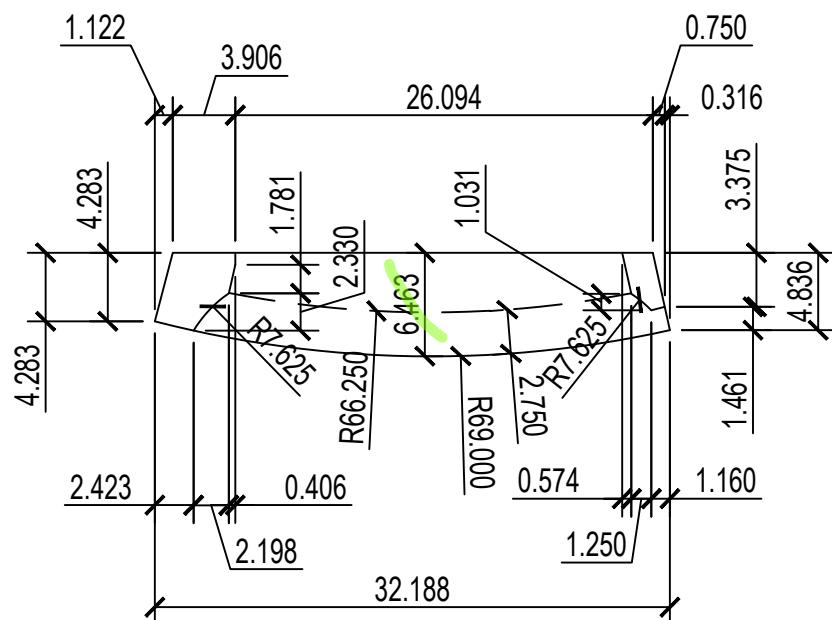



820 WILLOW STREET
MANKATO MN, 56001
507-508-0684

PAGE 55

JOB #: _____

DATE: 03/10/2021

SOLD TO: _____

STOCK: LIMESTONE



JOB NAME: GALE ROAD

FINISH: HONED

LOCATION: WOODLAND, MN

SECTION OR DETAIL DRAWING: 2/A6.5a

PART DESCRIPTION	DIM. A.	WIDE	LENGTH	QTY	CUBIC FT	ARCH. SHEET	WDW / DR #	ROOM #	GRID LINE(S)	KEY #
I.S. CORNER -TYPE A	36 1/2"	4"	15 3/8"	1	1.30	2/3.1	S113	112		55A
I.S. CORNER -TYPE A	36 5/16"	4"	15 3/8"	1	1.29	2/3.1	S113	112		55B
I.S. CORNER -TYPE A	47 7/16"	4"	15 3/8"	1	1.69	2/3.1	S113	112		55C
I.S. CORNER -TYPE A	32 3/4"	4"	15 3/8"	3	3.50	2/3.1	S115a-116B	112		55D
I.S. CORNER -TYPE A	32 13/16"	4"	15 3/8"	1	1.17	2/2.02	W146-147	115	5-4	55E
I.S. CORNER -TYPE B	32 3/4"	4"	19 5/8"	2	2.98	2/2.02	W142-143	115	5-4	55F
I.S. CORNER -TYPE B	32 13/16"	4"	19 5/8"	1	1.49	2/2.02	W142-143	115	5-4	55G

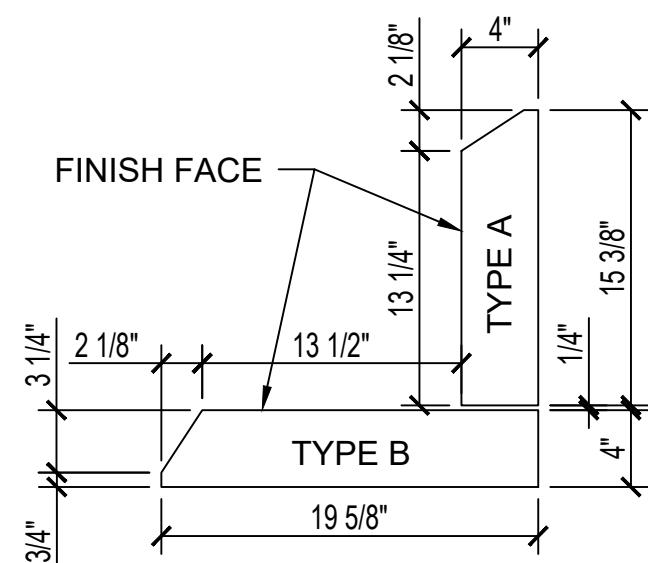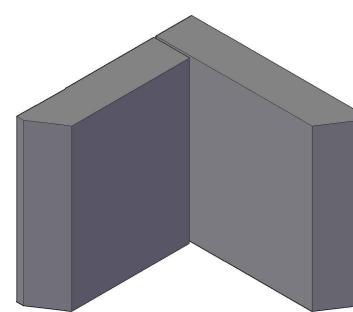



820 WILLOW STREET
MANKATO MN, 56001
507-508-0684

PAGE 56

JOB #: _____

SOLD TO: _____

DATE: 03/10/2021

JOB NAME: GALE ROAD

STOCK: LIMESTONE



LOCATION: WOODLAND, MN

FINISH: HONED

SECTION OR DETAIL DRAWING: 9/A8.3a, 10/A8.3a

PART DESCRIPTION	DIM. A.	WIDE	LENGTH	QTY	CUBIC FT	ARCH. SHEET	WDW / DR #	ROOM #	GRID LINE(S)	KEY #
PANTRY BRACKET										
PANTRY BRACKET										
HOLD

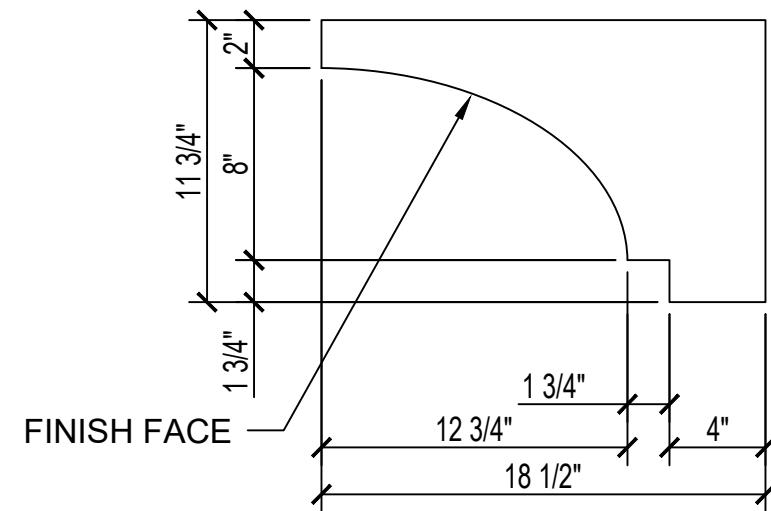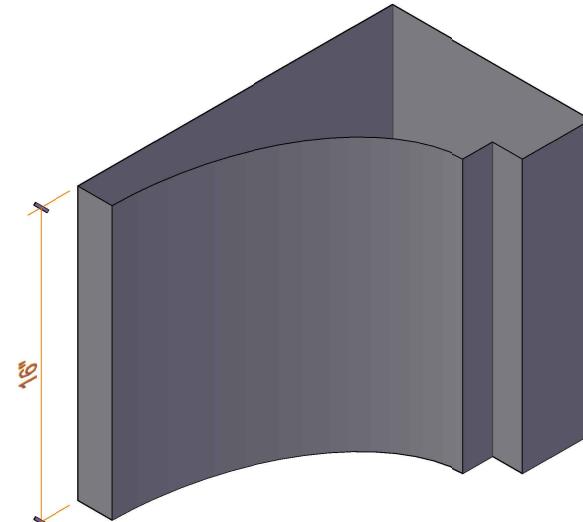

JOB #: _____

SOLD TO: _____

DATE: 03/08/2021

JOB NAME: GALE ROAD


STOCK: LIMESTONE

LOCATION: WOODLAND, MN

FINISH: HONED

SECTION OR DETAIL DRAWING: _____

PART DESCRIPTION	DIM. A.	WIDE	LENGTH	QTY	CUBIC FT	ARCH. SHEET	WDW / DR #	ROOM #	GRID LINE(S)	KEY #
SILL	20 7/8	5 3/4"	7"	1	.34	1/2.02	NEEDS INNER CORNER RETURN	4-5	57A	
SILL	58 1/4"	5 3/4"	7"	2	2.71	1/2.02	E104a, E109a	106,109	4-5	57B
SILL	37 1/4"	5 3/4"	7"	2	1.74	1/2.02			4-5	57C
SILL	54 3/4"	5 3/4"	7"	2	2.71	1/2.02	E106a-E107a	108	4-5	57D
SILL	20 7/8	5 3/4"	7"	1	.39	1/2.02	NEEDS INNER CORNER RETURN	4-5	57E	

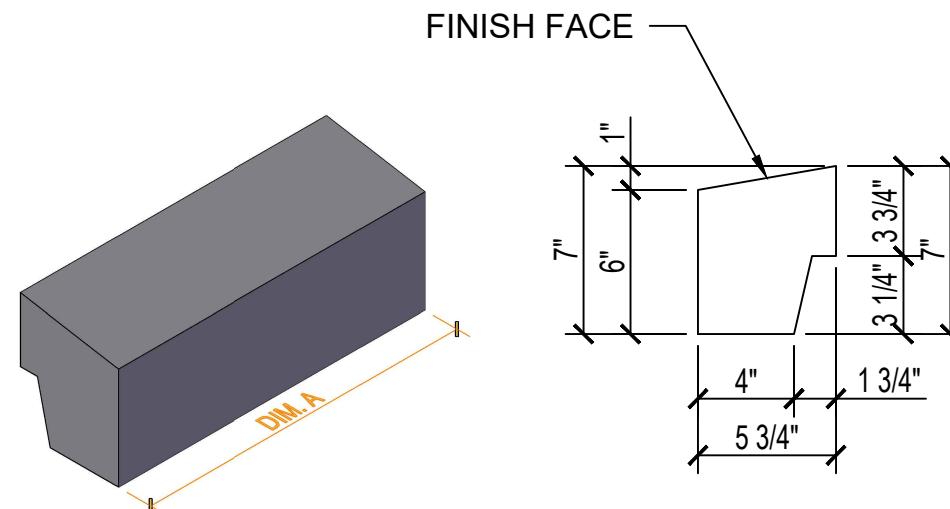



820 WILLOW STREET
MANKATO MN, 56001
507-508-0684

PAGE 58

JOB #: _____

SOLD TO: _____

DATE: 03/10/2021

JOB NAME: GALE ROAD


STOCK: LIMESTONE

LOCATION: WOODLAND, MN

FINISH: HONED

SECTION OR DETAIL DRAWING: 5/8.2



PART DESCRIPTION	DIM. A.	WIDE	LENGTH	QTY	CUBIC FT	ARCH. SHEET	WDW / DR #	ROOM #	GRID LINE(S)	KEY #
MULLION	34 3/4"	3"	8 1/2"	2	1.03	1/2.01	E233, E241	215	6-7	58A
MULLION	49 15/16"	3"	8 1/2"	5	3.68	1/2.01	E235-E240	215	6-7	58B

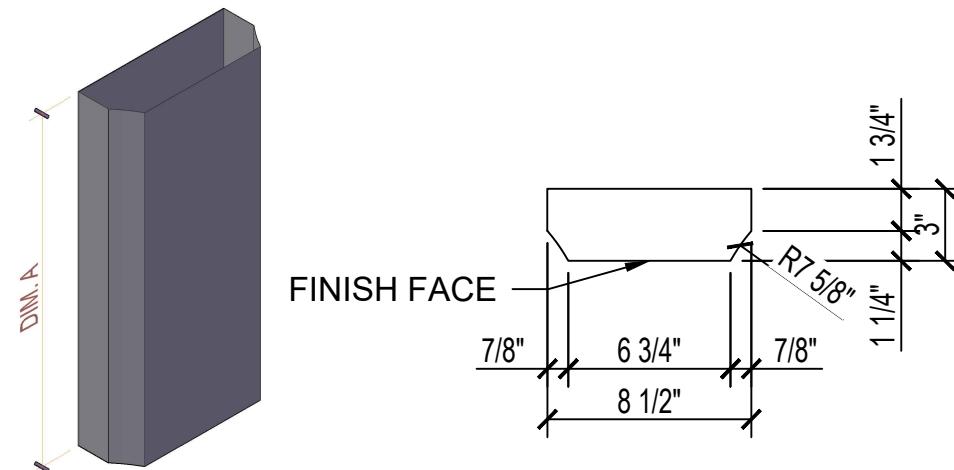

JOB #: _____
 SOLD TO: _____
 JOB NAME: GALE ROAD
 LOCATION: WOODLAND, MN
 SECTION OR DETAIL DRAWING: 5/8.2

DATE: 03/10/2021
 STOCK: LIMESTONE
 FINISH: HONED

PART DESCRIPTION	DIM. A.	WIDE	LENGTH	QTY	CUBIC FT	ARCH. SHEET	WDW / DR #	ROOM #	GRID LINE(S)	KEY #
SILL - PIECE 1	46 7/16"	2 1/2"	14"	2	1.76	2/2.02	W001-003	009	5-4	59A
SILL - PIECE 1	53 5/16"	2 1/2"	14"	2	2.16	2/2.02	W001-003	009	5-4	59B
SILL - PIECE 2	46 7/16"	2 1/2"	14 3/4"	2	1.98	2/2.02	W001-003	009	5-4	59C
SILL - PIECE 2	53 5/16"	2 1/2"	14 3/4"	2	2.28	2/2.02	W001-003	009	5-4	59D

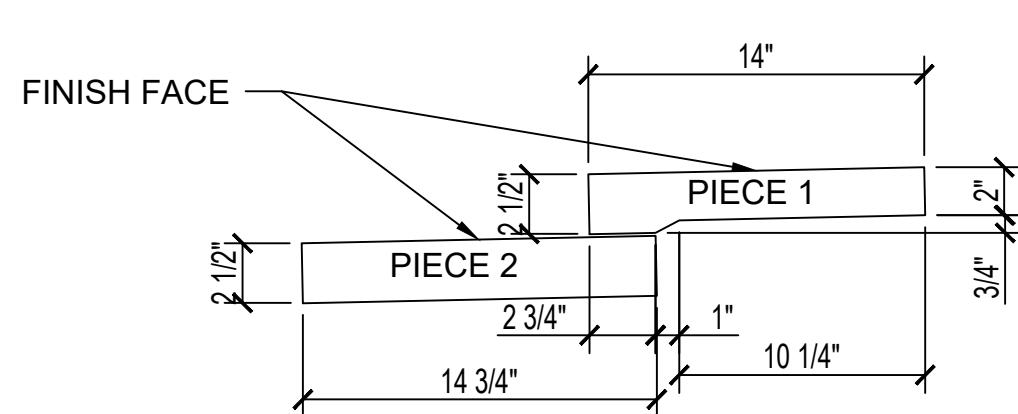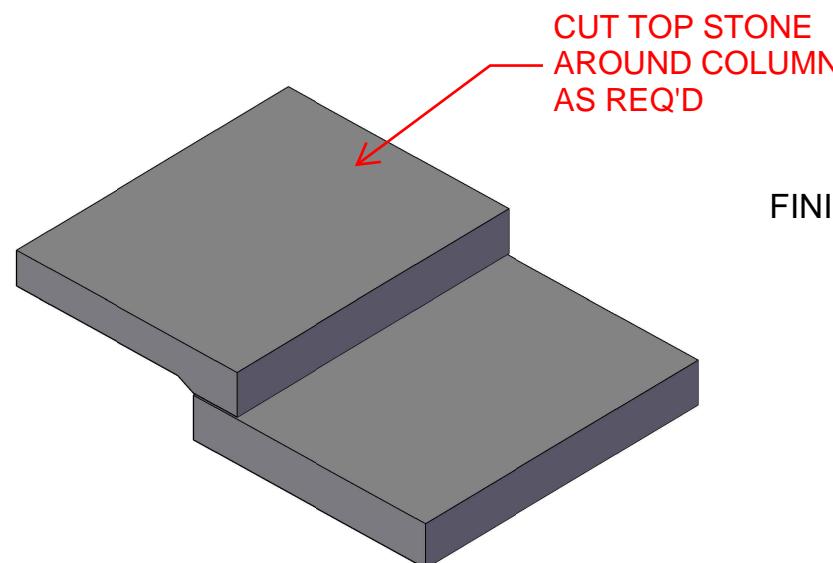

JOB #: _____

SOLD TO: _____

DATE: 03/10/2021

JOB NAME: GALE ROAD


STOCK: LIMESTONE

LOCATION: WOODLAND, MN

FINISH: HONED

SECTION OR DETAIL DRAWING: 5/8.2

PART DESCRIPTION	DIM. A.	WIDE	LENGTH	QTY	CUBIC FT	ARCH. SHEET	WDW / DR #	ROOM #	GRID LINE(S)	KEY #
STONE BASE	20 1/2"	6 15/16"	5 3/8"	1	.30	2/2.02	NEEDS INNER CORNER RETURN	500	RETURN 5-4	60A
STONE BASE	16 1/8	6 15/16"	5 3/8"	1	.23	2/2.02	NEEDS INNER CORNER RETURN	500	RETURN 5-4	60B
STONE BASE	49 5/8	6 15/16"	5 3/8"	5	5.78	2/2.02,2/2.03,2/3.1		006	4-3	60C
STONE BASE	24 7/8"	6 15/16"	5 3/8"	1	.43	2/2.02	NEEDS INNER CORNER RETURN			60D
STONE BASE	36"	6 15/16"	5 3/8"	1	.78	2/2.02	NEEDS OUTER CORNER RETURN	2		60E
STONE BASE	20 7/8"	6 15/16"	5 3/8"	2	.67	2/2.02	NEEDS 1L & 1R INNER CORNER RETURN			60F
STONE BASE	11 5/8"	6 15/16"	5 3/8"	2	.36	2/2.02	NEEDS 1L & 1R INNER CORNER RETURN			60G
STONE BASE	48 1/2"	6 15/16"	5 3/8"	3	3.14	2/2.02				60H
STONE BASE	168"	6 15/16"	5 3/8"	1	1.46	2/4.5	NEEDS OUTER CORNER RETURN	2		60I
STONE BASE	11"	6 15/16"	5 3/8"	1	.43	1/4.5		024	E	60K

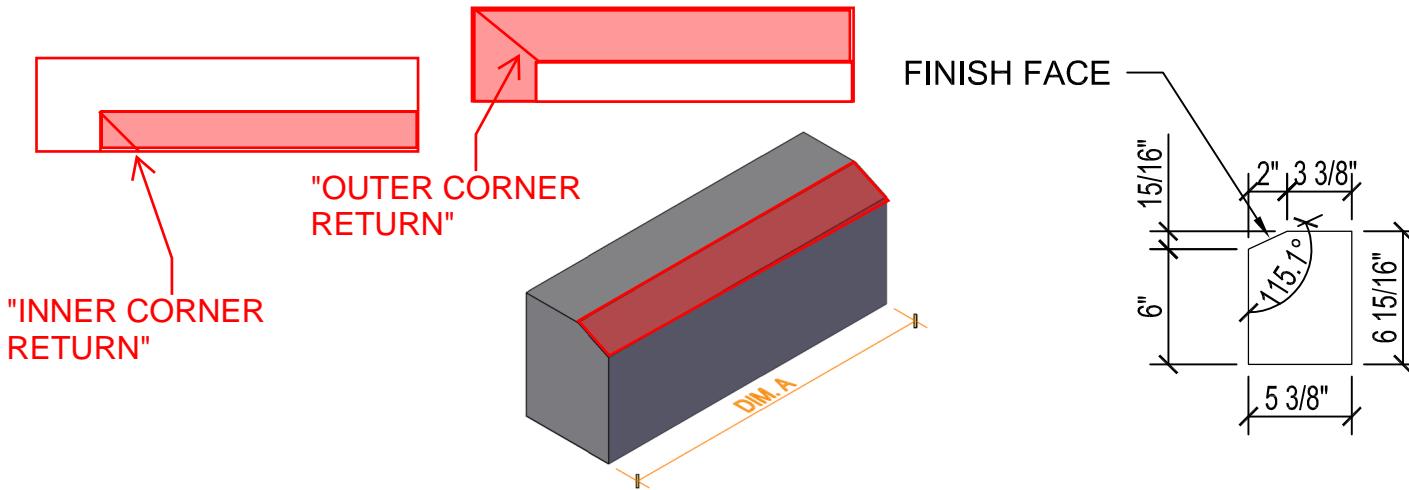

THIN STONE
VENEER WITH
RETURN TO
DOORS. SEE 1/7a



820 WILLOW STREET
MANKATO MN, 56001
507-508-0684

PAGE 60-1

JOB #:

DATE: 03/10/2021

SOLD TO:

STOCK LIMESTONE

JOB NAME: GALE ROAD

FINISH: HONED

LOCATION: WOODBINE, MN
SECTION OR DETAIL DRAWING: 5/8-2

FINISH: SHINED

JOB #: _____

SOLD TO: _____

JOB NAME: GALE ROAD

LOCATION: WOODLAND, MN



SECTION OR DETAIL DRAWING: 19/A8.3

DATE: 03/10/2021

STOCK: LIMESTONE

FINISH: HONED

PART DESCRIPTION	DIM. A	WIDE	HEIGHT	QTY.	CUBIC FT	ARCH. SHEET	WDW/DR#	ROOM #	GRID LINE(S)	KEY #
HEADER - PIECE A	52 3/8"	6 1/2"	16"	2	6.24	2/2.02		SC. PORCH	5-4	61A
HEADER - PIECE A	52 3/8"	6 1/2"	16"	1	3.12	2/2.02		SC. PORCH	5-4	61B
HEADER - PIECE B	52 3/8"	3"	3/4"	2	.14	2/2.02		SC. PORCH	5-4	61C
HEADER - PIECE B	52 3/8"	3"	3/4"	1	.08	2/2.02		SC. PORCH	5-4	61D
HEADER - PIECE C	52 3/8"	4"	16"	2	3.80	2/2.02		SC. PORCH	5-4	61E
HEADER - PIECE C	52 3/8"	4"	16"	1	1.92	2/2.02		SC. PORCH	5-4	61F
HEADER - PIECE A	59 13/16"	6 1/2"	16"	2	7.20	2/3.1		SC. PORCH		61G
HEADER - PIECE A	59 7/8"	6 1/2"	16"	1	3.60	2/3.1		SC. PORCH		61H

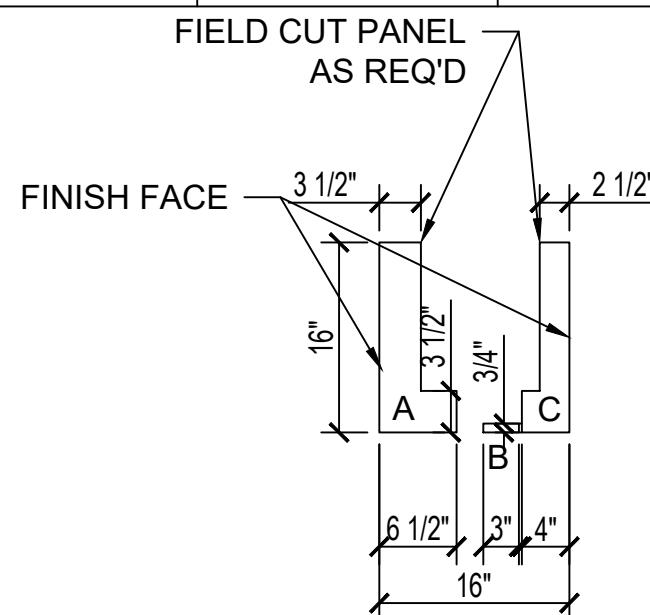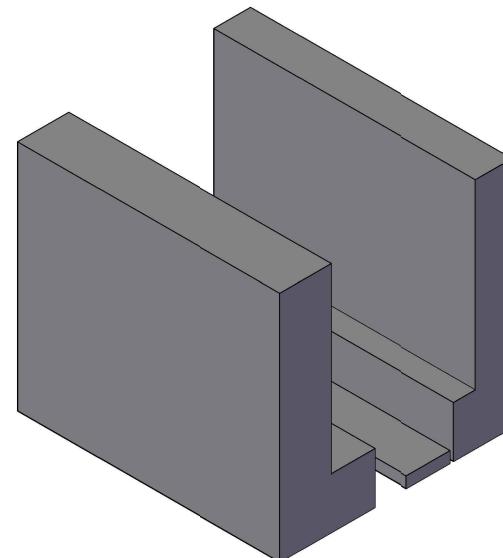



820 WILLOW STREET
MANKATO MN, 56001
507-508-0684

PAGE 61-1

JOB #: _____

SOLD TO: _____

DATE: 03/10/2021

JOB NAME: GALE ROAD

STOCK: LIMESTONE

LOCATION: WOODLAND, MN

FINISH: HONED

SECTION OR DETAIL DRAWING: 19/A8.3

PART DESCRIPTION	DIM. A	WIDE	HEIGHT	QTY.	CUBIC FT	ARCH. SHEET	WDW/DR#	ROOM #	GRID LINE(S)	KEY #
HEADER - PIECE A	40 1/2"	6 1/2"	16"	3	7.31	2/3.1		SC. PORCH		61J
HEADER - PIECE A	31 7/8"	6 1/2"	16"	2	3.84	2/3.1		SC. PORCH		61K
HEADER - PIECE A	48 3/4"	6 1/2"	16"	4	11.74	2/3.1		SC. PORCH		61L
HEADER - PIECE B	40 1/2"	3"	3/4"	3	.16	2/3.1		SC. PORCH		61M
HEADER - PIECE B	31 7/8"	3"	3/4"	2	.08	2/3.1		SC. PORCH		61N
HEADER - PIECE B	48 3/4"	3"	3/4"	4	.25	2/3.1		SC. PORCH		61P
HEADER - PIECE C	40 1/2"	4"	16"	3	4.50	2/3.1		SC. PORCH		61Q
HEADER - PIECE C	31 7/8"	4"	16"	2	2.36	2/3.1		SC. PORCH		61R
HEADER - PIECE C	48 3/4"	4"	16"	4	7.22	2/3.1		SC. PORCH		61S



820 WILLOW STREET
MANKATO MN, 56001
507-508-0684

PAGE 62

JOB #: _____

SOLD TO: _____

DATE: 03/10/2021

JOB NAME: GALE ROAD


STOCK: LIMESTONE

LOCATION: WOODLAND, MN

FINISH: HONED

SECTION OR DETAIL DRAWING: 19/A8.3

PART DESCRIPTION	DIM. A	WIDE	HEIGHT	QTY.	CUBIC FT	ARCH. SHEET	WDW/DR#	ROOM #	GRID LINE(S)	KEY #
HEADER	31 7/8"	4"	4 1/2"	2	.66	2/2.02	W148-152	102	4-3	62A
HEADER	70 3/4"	4"	4 1/2"	2	1.47	2/2.02	W148-152	102	4-3	62B
HEADER	56 1/2"	4"	4 1/2"	2	1.18	2/2.02	W148-152	102	4-3	62C
HEADER	56 1/4"	4"	4 1/2"	1	.59	2/2.02	W148-152	102	4-3	62D
HEADER	35 3/4"	4"	4 1/2"	1	.37	2/2.03	S118-121	102	B	62E
HEADER	40 5/8"	4"	4 1/2"	2	.85	2/2.03	S118-121	102	B	62F
HEADER	38 9/16"	4"	4 1/2"	1	.41	2/2.03	S118-121	102	B	62G

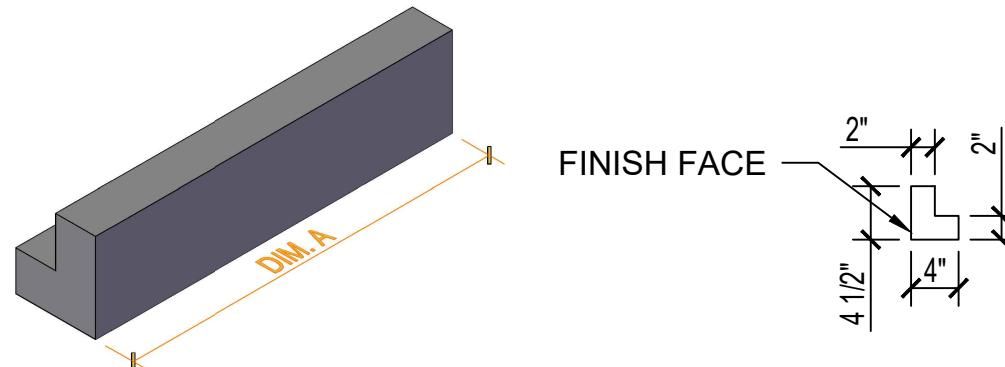

JOB #: _____

SOLD TO: _____

DATE: 03/10/2021

JOB NAME: GALE ROAD



STOCK: LIMESTONE

LOCATION: WOODLAND, MN

FINISH: HONED

SECTION OR DETAIL DRAWING: 19/A8.3

PART DESCRIPTION	DIM. A.	WIDE	LENGTH	QTY	CUBIC FT	ARCH. SHEET	WDW / DR #	ROOM #	GRID LINE(S)	KEY #
STONE PAVER	14 5/8"	52"	2"	1	.88	1/2.02			4-5	63A
STONE PAVER-LUG	58 1/4"	52"	2"	2	7.01	1/2.02	E104a, E109a	106,109	4-5	63B
STONE PAVER	37 1/4"	52"	2"	2	4.48	1/2.02			4-5	63C
STONE PAVER-LUG	54 3/4"	52"	2"	1(R)1(L)	6.59	1/2.02	E106a-E107a	108	4-5	63D
STONE PAVER	16 5/8"	52"	2"	1	1.00	1/2.02			4-5	63E

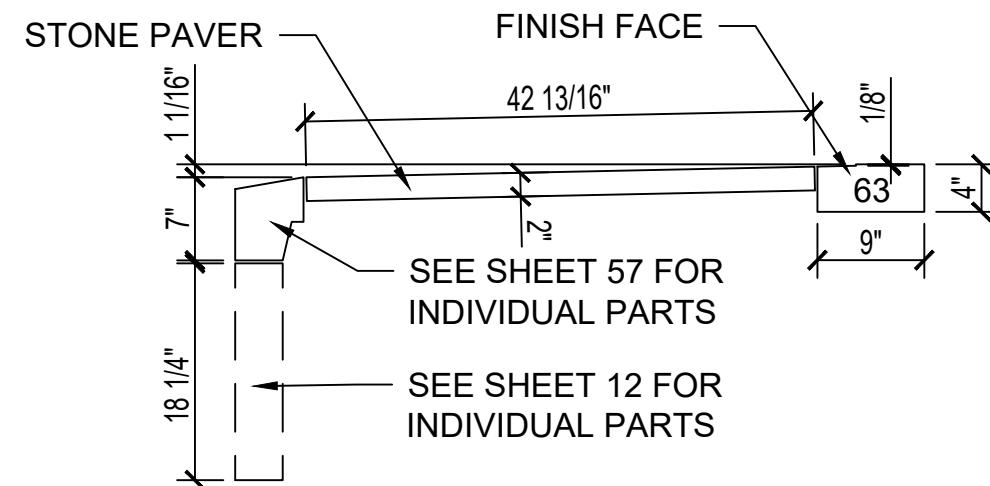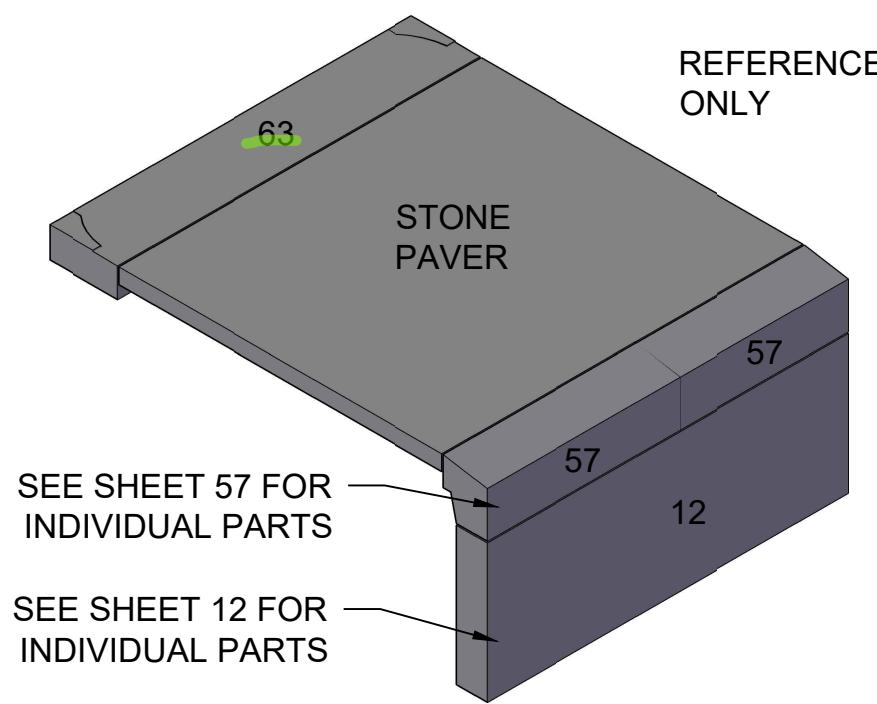



820 WILLOW STREET
MANKATO MN, 56001
507-508-0684

PAGE 64

JOB #: _____

SOLD TO: _____

DATE: 03/10/2021

JOB NAME: GALE ROAD

STOCK: LIMESTONE


LOCATION: WOODLAND, MN

FINISH: HONED


SECTION OR DETAIL DRAWING: 19/A8.3

PART DESCRIPTION	LENGTH	WIDE	HIEGHT	QTY	CUBIC FT	ARCH. SHEET	WDW / DR #	ROOM #	GRID LINE(S)	KEY #
STONE BRACKET	63 1/2"	7 1/4"	8 3/4"	2	4.66	2/2.01	W126	117	7-6	64A

REFERENCE
ONLY

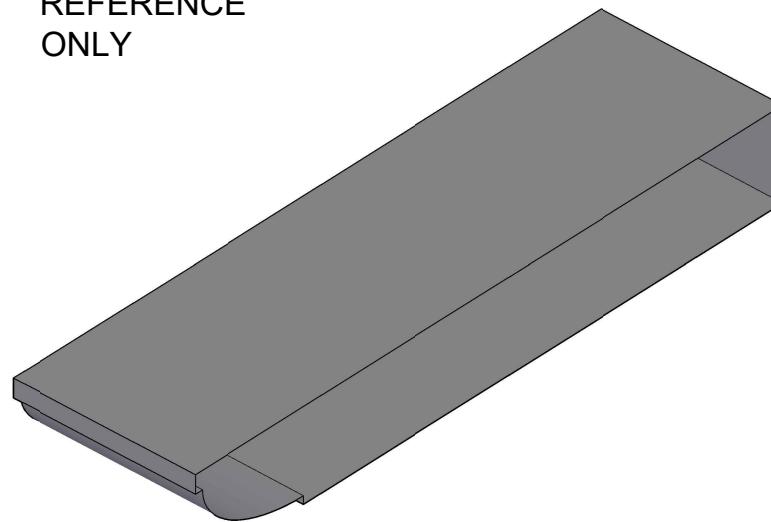

FIELD VERIFY STEEL
LOCATION AND NOTCH
STONE AS REQUIRED

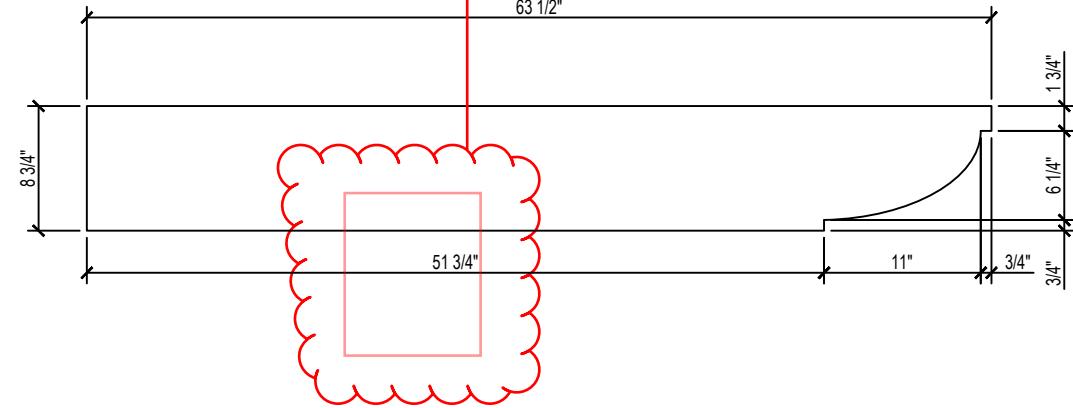



820 WILLOW STREET
MANKATO MN, 56001
507-508-0684

PAGE 70

JOB #: _____

SOLD TO: _____

JOB NAME: GALE ROAD




LOCATION: WOODLAND, MN

SECTION OR DETAIL DRAWING: _____

DATE: 03/10/2021

STOCK: LIMESTONE

FINISH: HONED

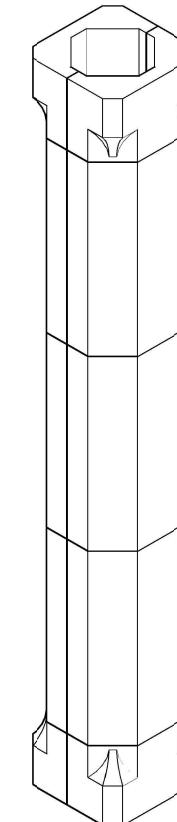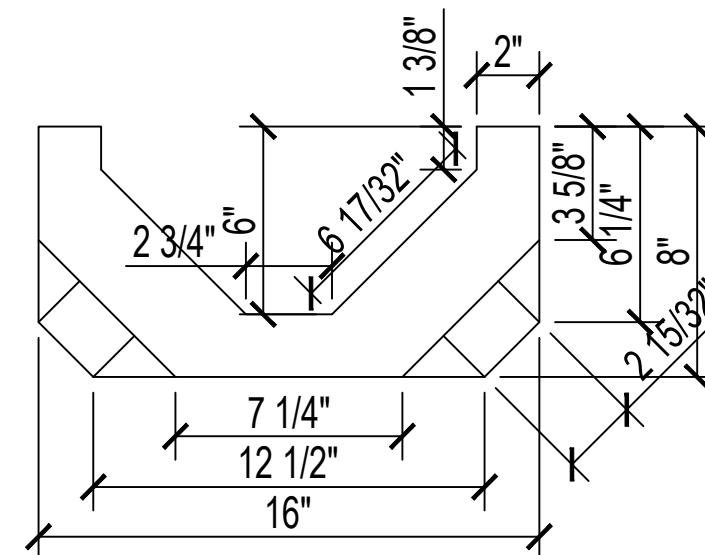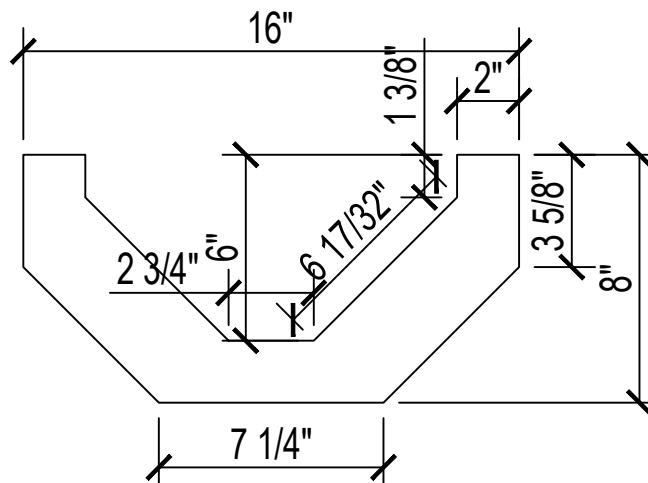

**FIELD CUT AS REQ'D
FOR SLOPED SURFACES

PART DESCRIPTION	DIM. A.	WIDE	HEIGHT	QTY	CUBIC FT	ARCH. SHEET	WDW / DR #	ROOM #	GRID LINE(S)	KEY #
COL. TYPE 1-TOP/BTM	11"	8"	16"	16	13.04	2/2.02	W005-007,W001-003	006,009	4-3, 5-4	70A
COL. TYPE 1-TOP/BTM	11"	8"	16"	44	35.86	2/2.02, 2/3.1		SC. PORCH	5-4	70A
COL. TYPE 1	25 1/2"	8"	16"	12	22.67	2/2.02	W005-007	006, SC. PROCH	4-3, 5-4	70B
COL. TYPE 1	25 5/8"	8"	16"	6	11.38	2/2.02	W005-007	006, SC. PORCH	4-3, 5-4	70C
COL. TYPE 1	26 3/4"	8"	16"	12	32.66	2/2.02	W001-003	009	5-4	70D
COL. TYPE 1	24 3/4"	8"	16"	24	43.99	2/3.1		SC. PORCH		70E
COL. TYPE 1	24 3/8"	8"	16"	24	43.34	2/2.02				70F
COL. TYPE 1	24 1/2"	8"	16"	12	21.78	2/2.02				70G
COL. TYPE 1-TOP/BTM	13"	8"	16"	30	28.89	2/2.02,2/3.1	W005-007,W001-003	006,009	4-3,5-4	70H **



820 WILLOW STREET
MANKATO MN, 56001
507-508-0684

PAGE 71

JOB #: _____

SOLD TO: _____

DATE: 03/10/2021




JOB NAME: GALE ROAD

STOCK: LIMESTONE

LOCATION: WOODLAND, MN

FINISH: HONED

SECTION OR DETAIL DRAWING: _____

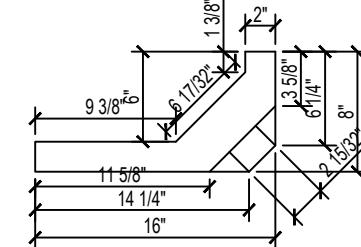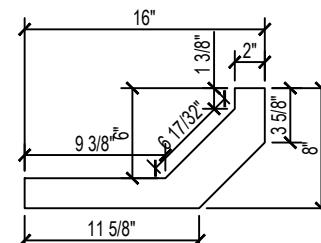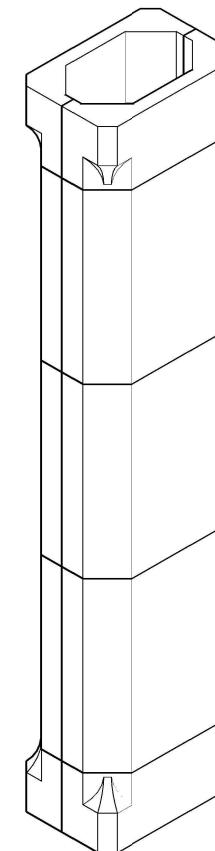

**FIELD CUT AS REQ'D
FOR SLOPED SURFACES

PART DESCRIPTION	DIM. A.	WIDE	HEIGHT	QTY	CUBIC FT	ARCH. SHEET	WDW / DR #	ROOM #	GRID LINE(S)	KEY #
COL. TYPE 2-TOP/BTM	11"	8"	23 3/4"	2	2.42	2/2.02		SC. PORCH	5-4	71A
COL. TYPE 2	25 1/2"	8"	23 3/4"	4	11.22	2/2.02		SC. PORCH	5-4	71B
COL. TYPE 2	25 5/8"	8"	23 3/4"	2	5.86	2/2.02		SC. PORCH	5-4	71C
COL. TYPE 2	13"	8"	23 3/4"	2	2.86	2/2.02		SC. PORCH	5-4	71D **



820 WILLOW STREET
MANKATO MN, 56001
507-508-0684

PAGE 72

JOB #: _____

SOLD TO: _____

DATE: 03/10/2021




JOB NAME: GALE ROAD

STOCK: LIMESTONE

LOCATION: WOODLAND, MN

FINISH: HONED

SECTION OR DETAIL DRAWING: _____

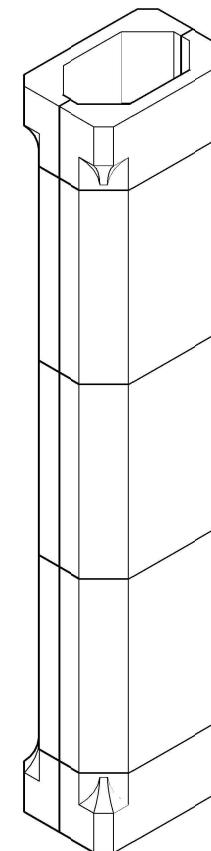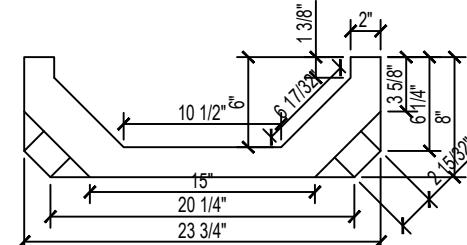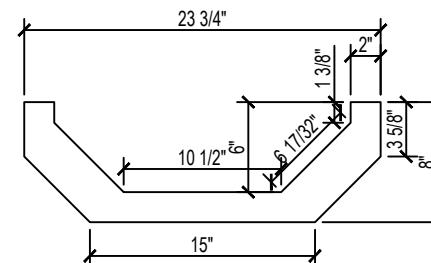

**FIELD CUT AS REQ'D
FOR SLOPED SURFACES

PART DESCRIPTION	DIM. A.	WIDE	HEIGHT	QTY	CUBIC FT	ARCH. SHEET	WDW / DR #	ROOM #	GRID LINE(S)	KEY #
COL. TYPE 2-TOP/BTM	11"	8"	23 3/4"	16	19.34	1/2.01		119a, 117	6-7, 7-6	72A
COL. TYPE 2	34 3/8"	8"	23 3/4"	8	30.24	1/2.02		117	6-7	72B
COL. TYPE 2	34 1/4"	8"	23 3/4"	4	15.06	1/2.02		117	6-7	72C
COL. TYPE 2	40 5/8"	8"	23 3/4"	12	53.60	2/2.01		119a	7-6	72D
COL. TYPE 2-TOP/BTM	13"	8"	23 3/4"	8	11.43	1/2.01, 2/2.01		119a, 117	6-7, 7-6	72E **