



1 Generator Foundation Plan  
SCALE: 1/4" = 1'-0"

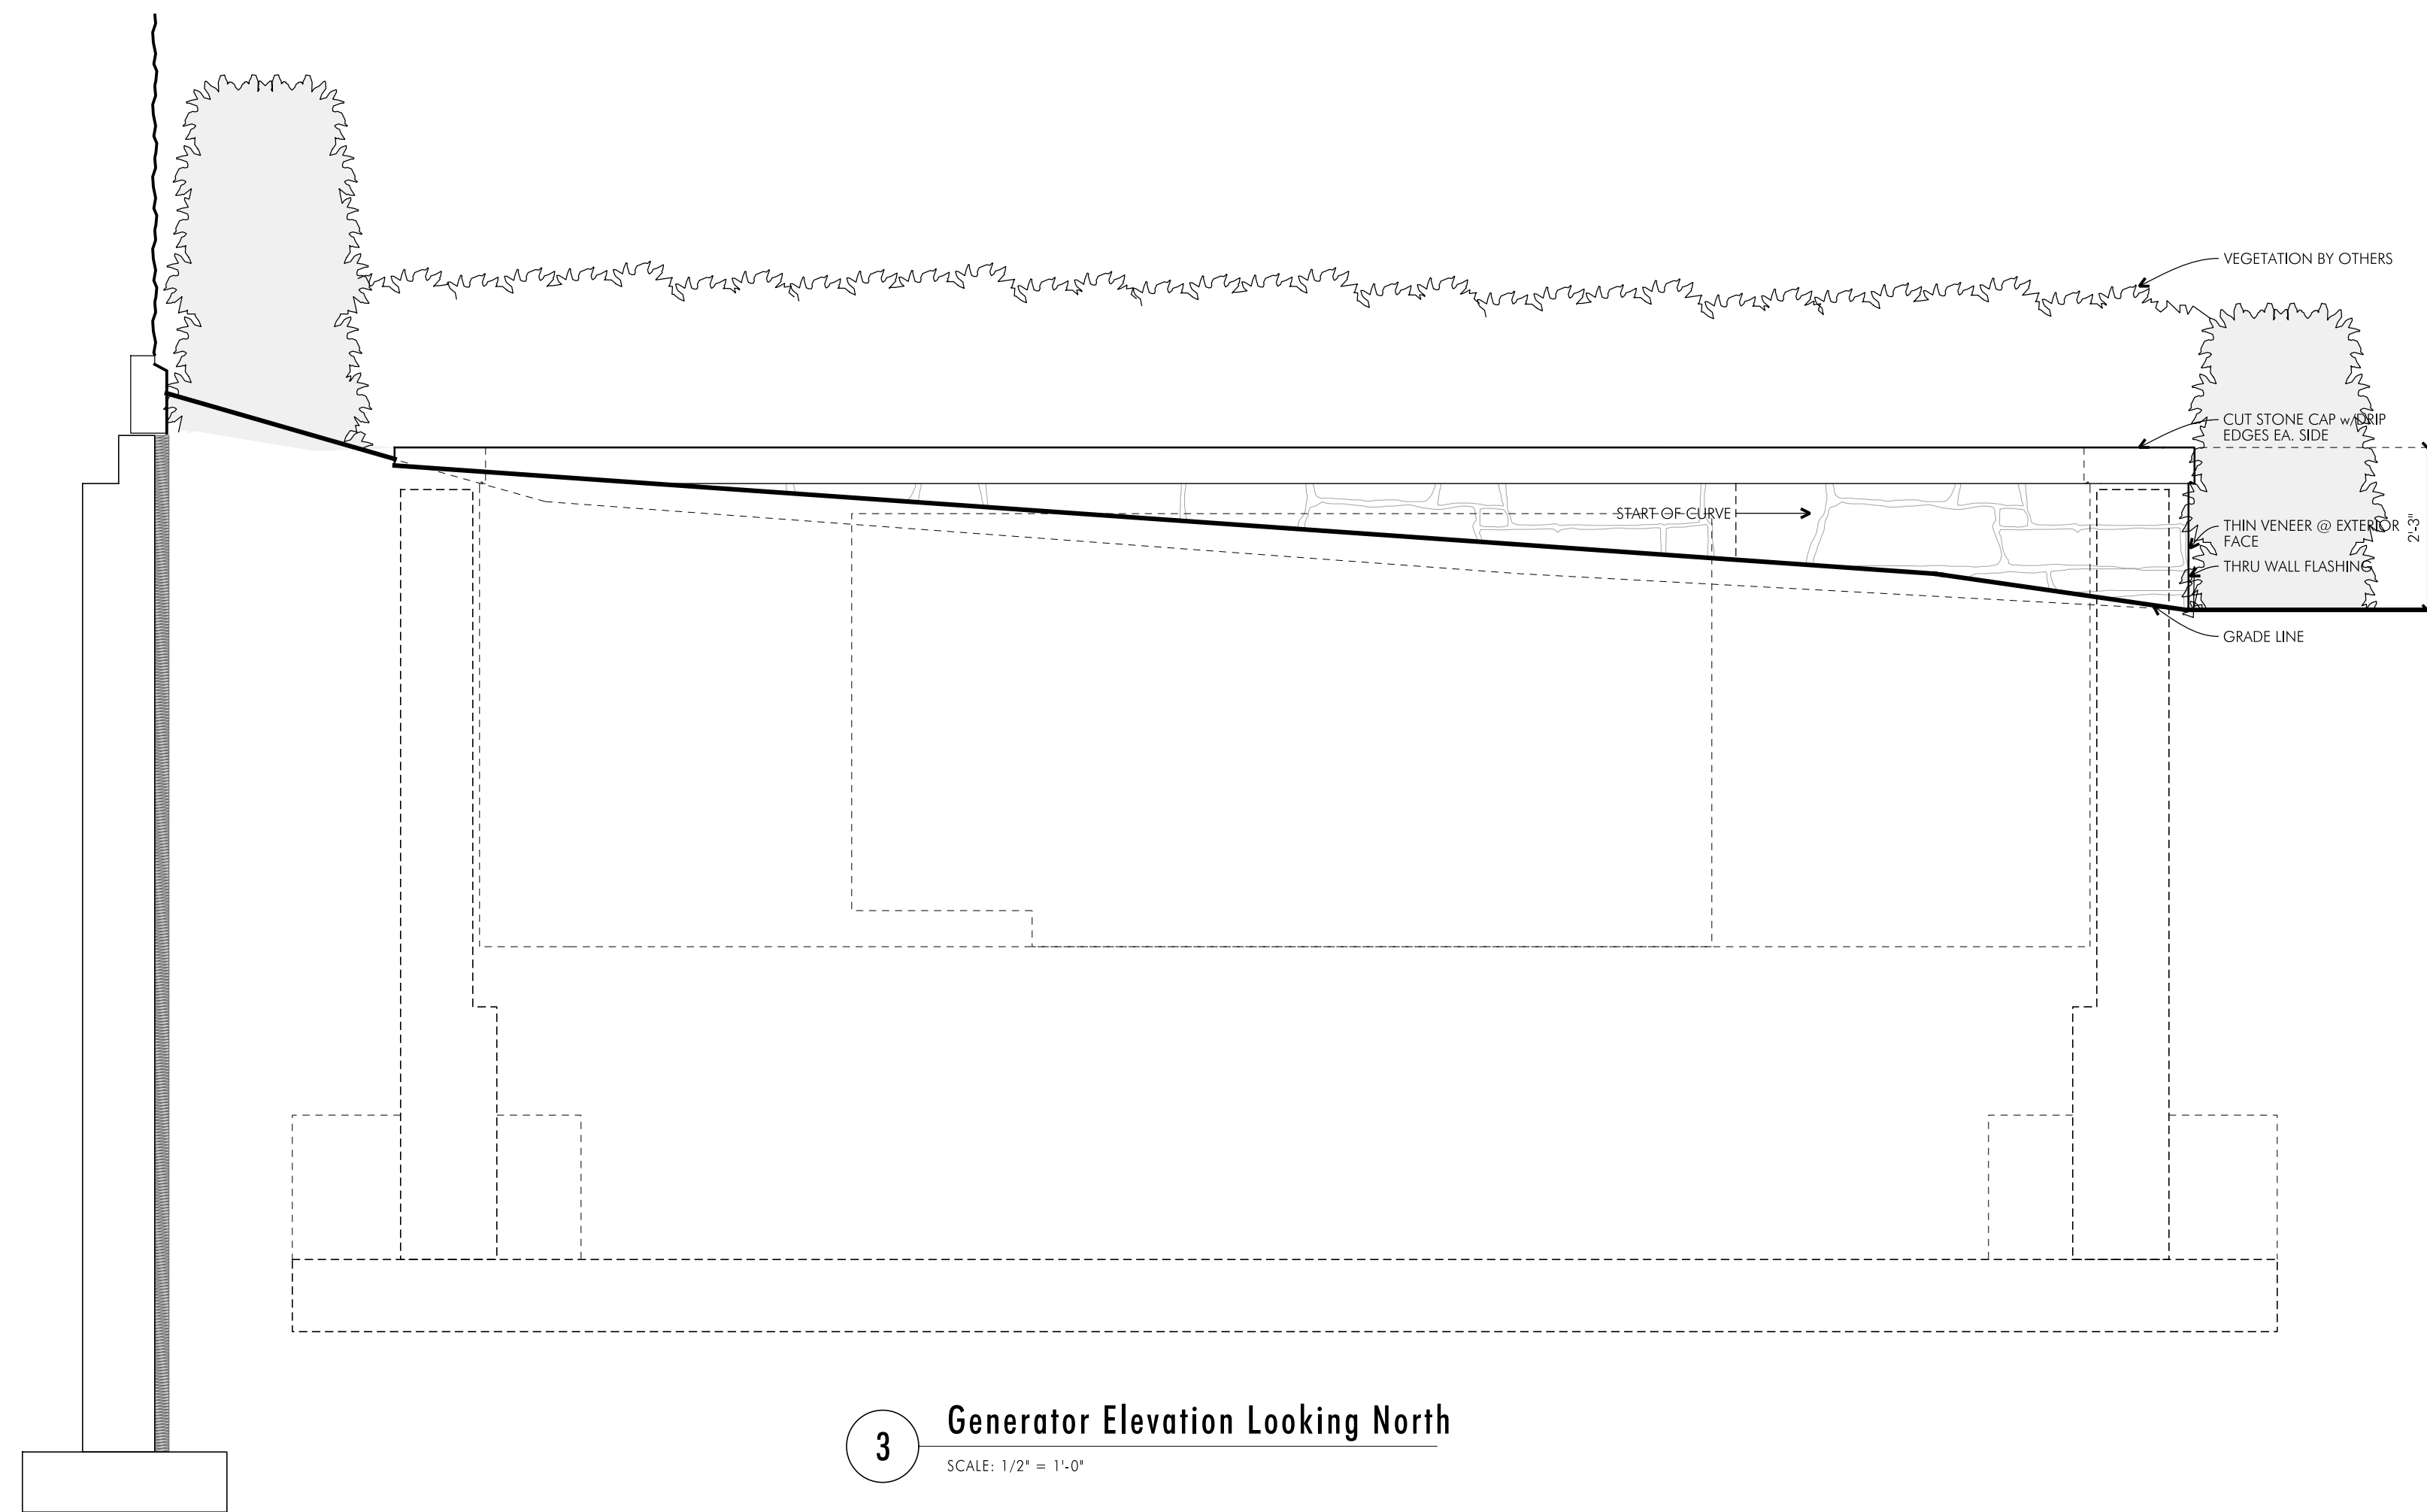


3 Generator Elevation Looking North  
SCALE: 1/2" = 1'-0"

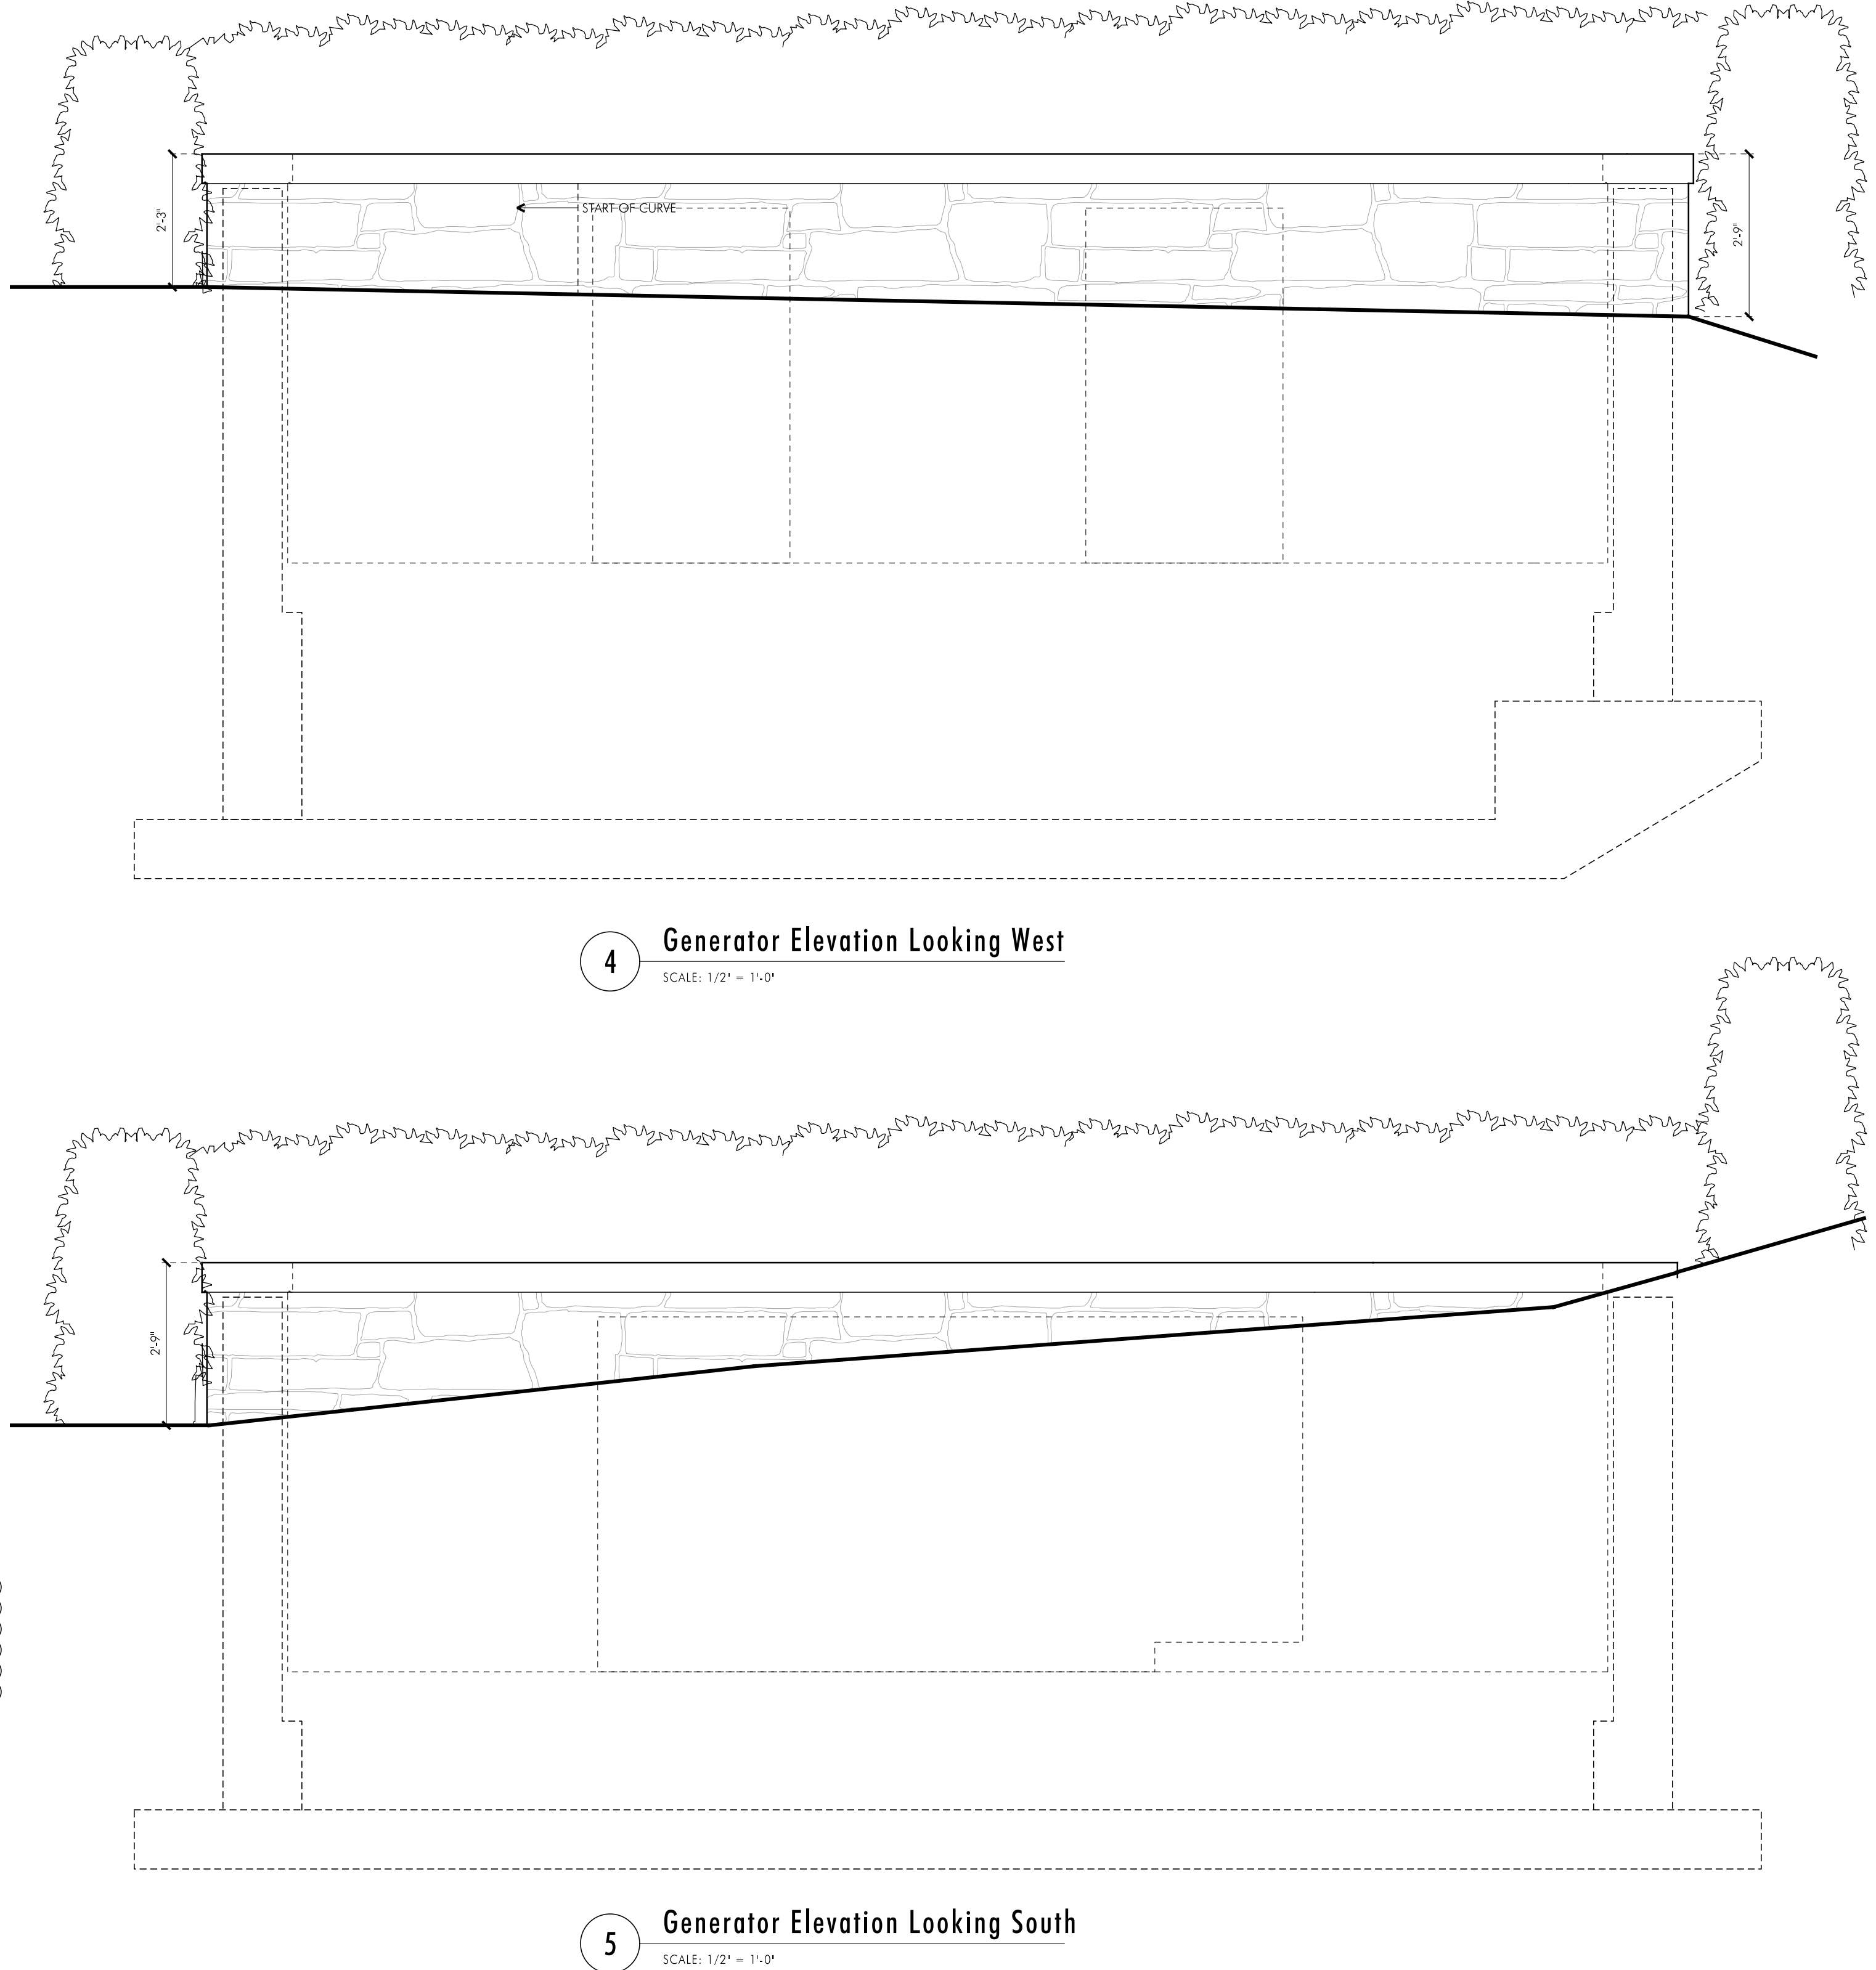


4 Generator Elevation Looking West  
SCALE: 1/2" = 1'-0"

5 Generator Elevation Looking South  
SCALE: 1/2" = 1'-0"

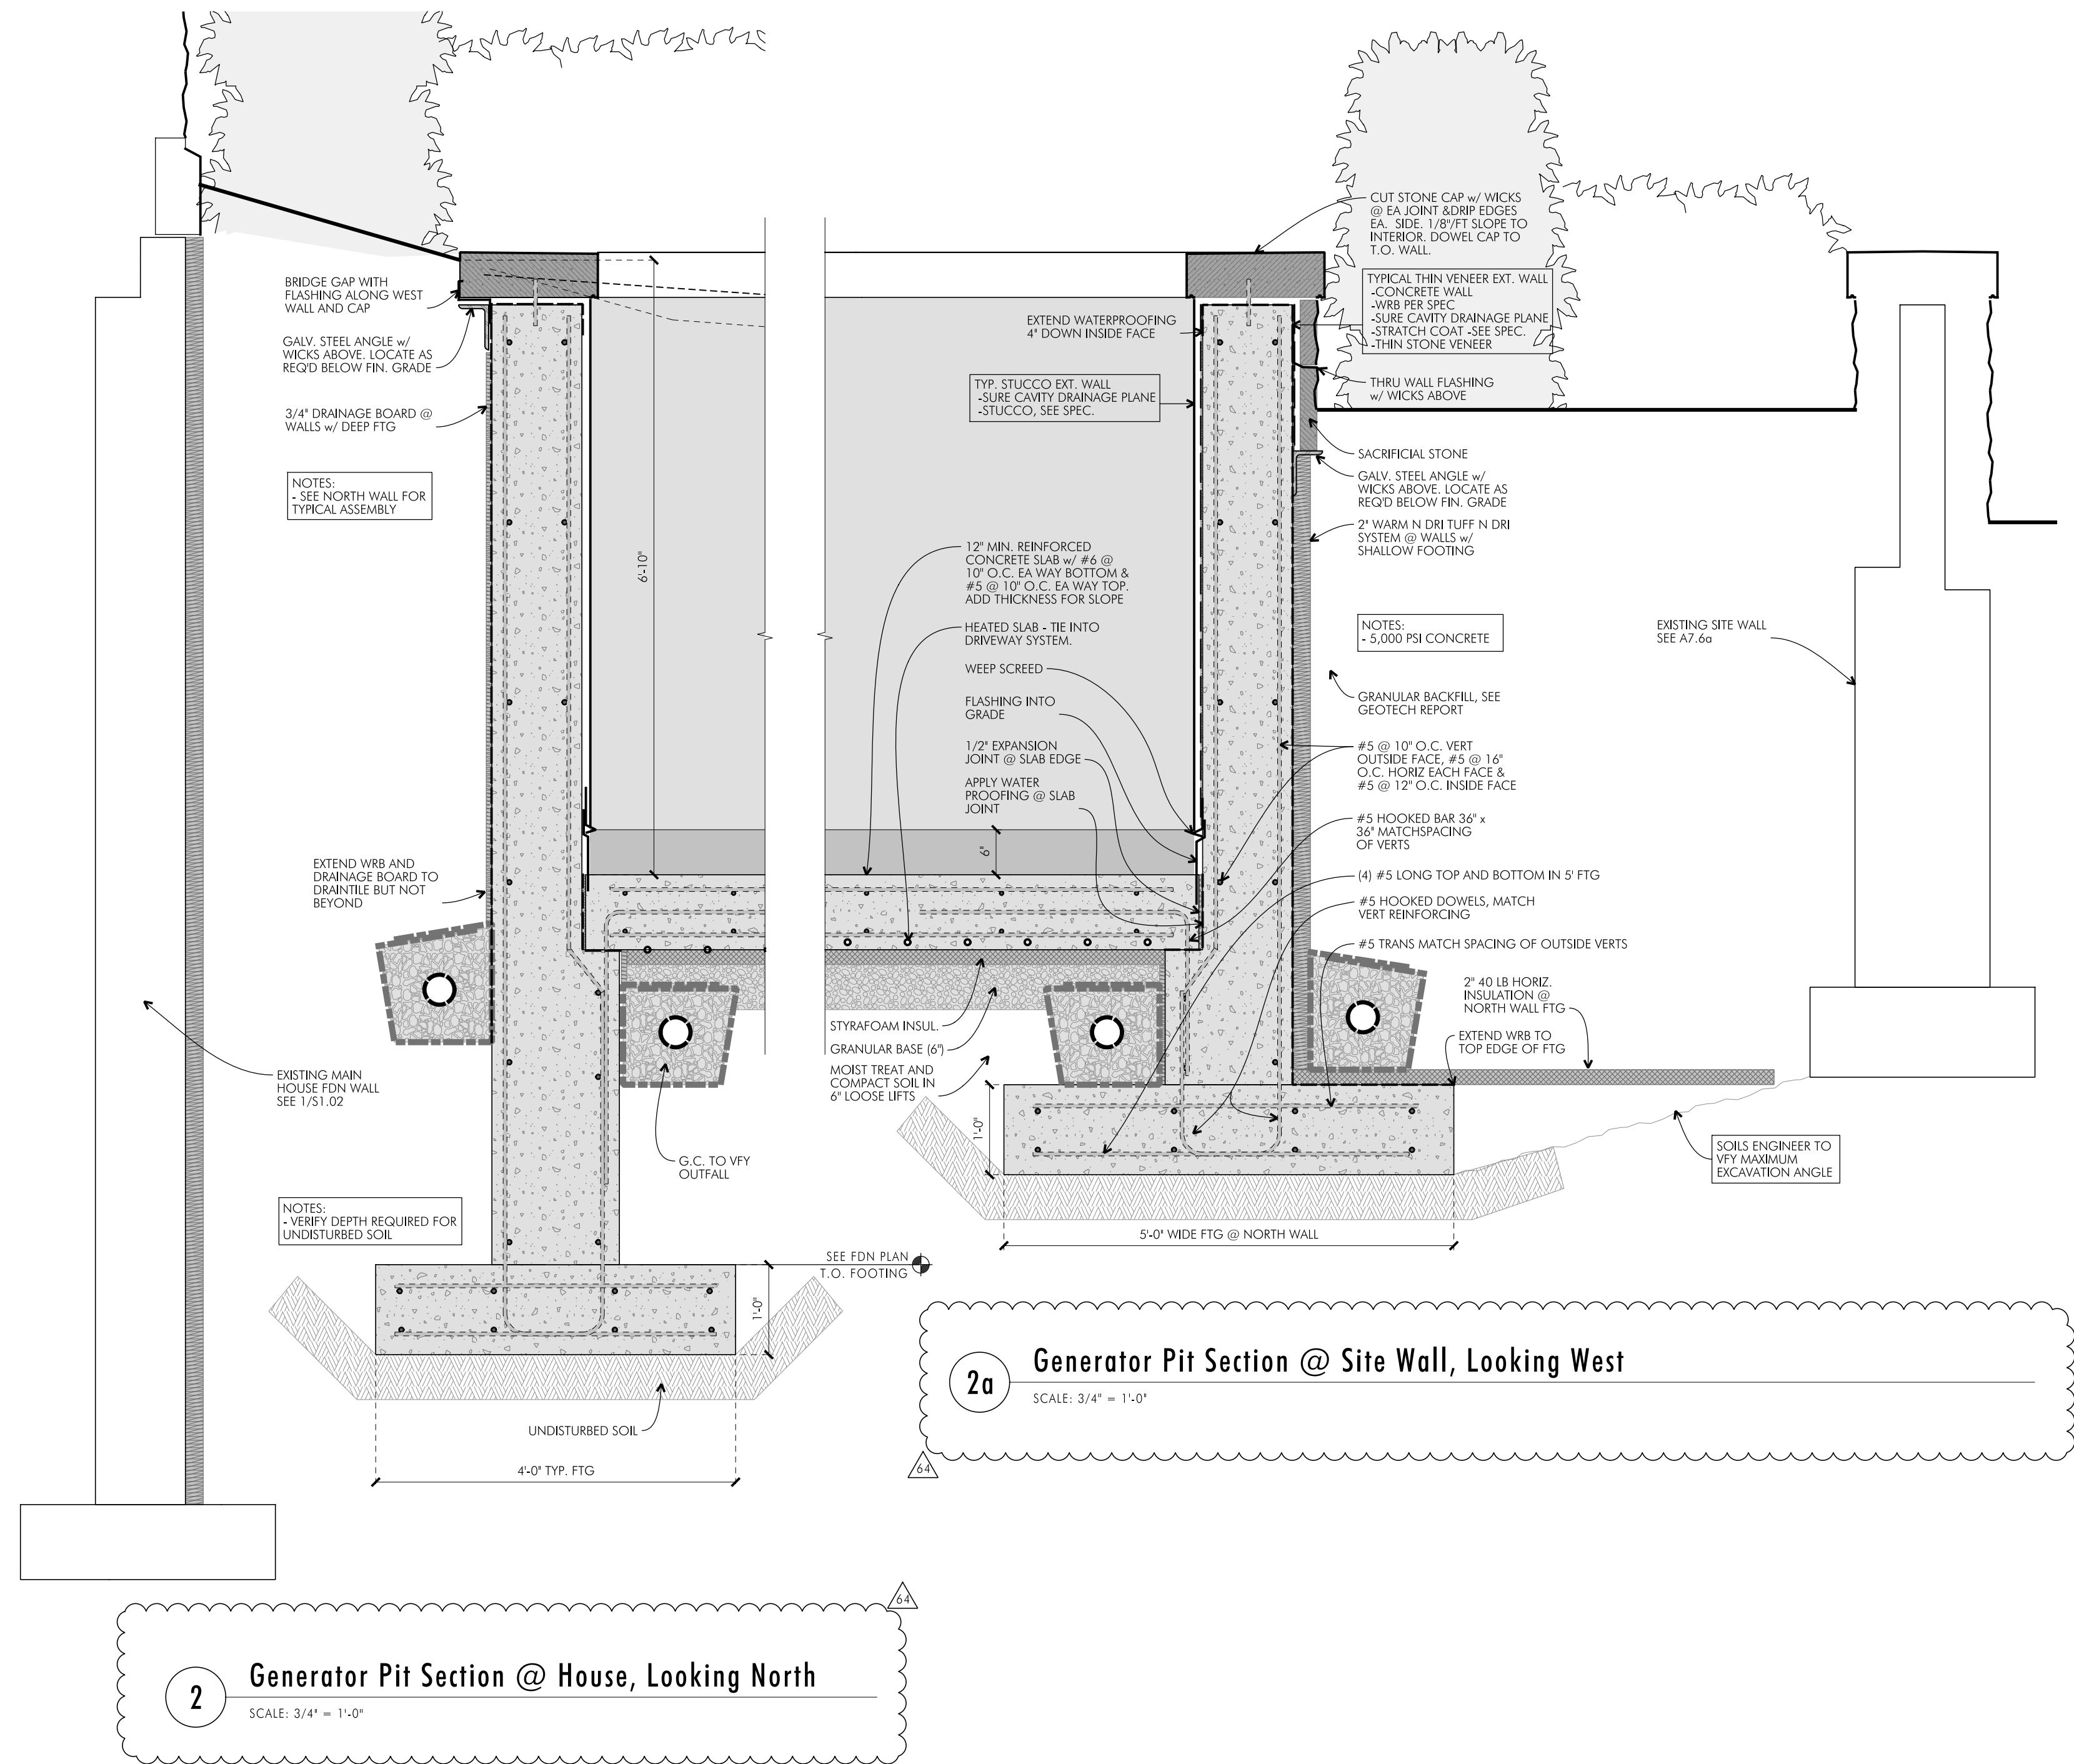

2a Generator Pit Section @ Site Wall, Looking West  
SCALE: 3/4" = 1'-0"

2 Generator Pit Section @ House, Looking North  
SCALE: 3/4" = 1'-0"

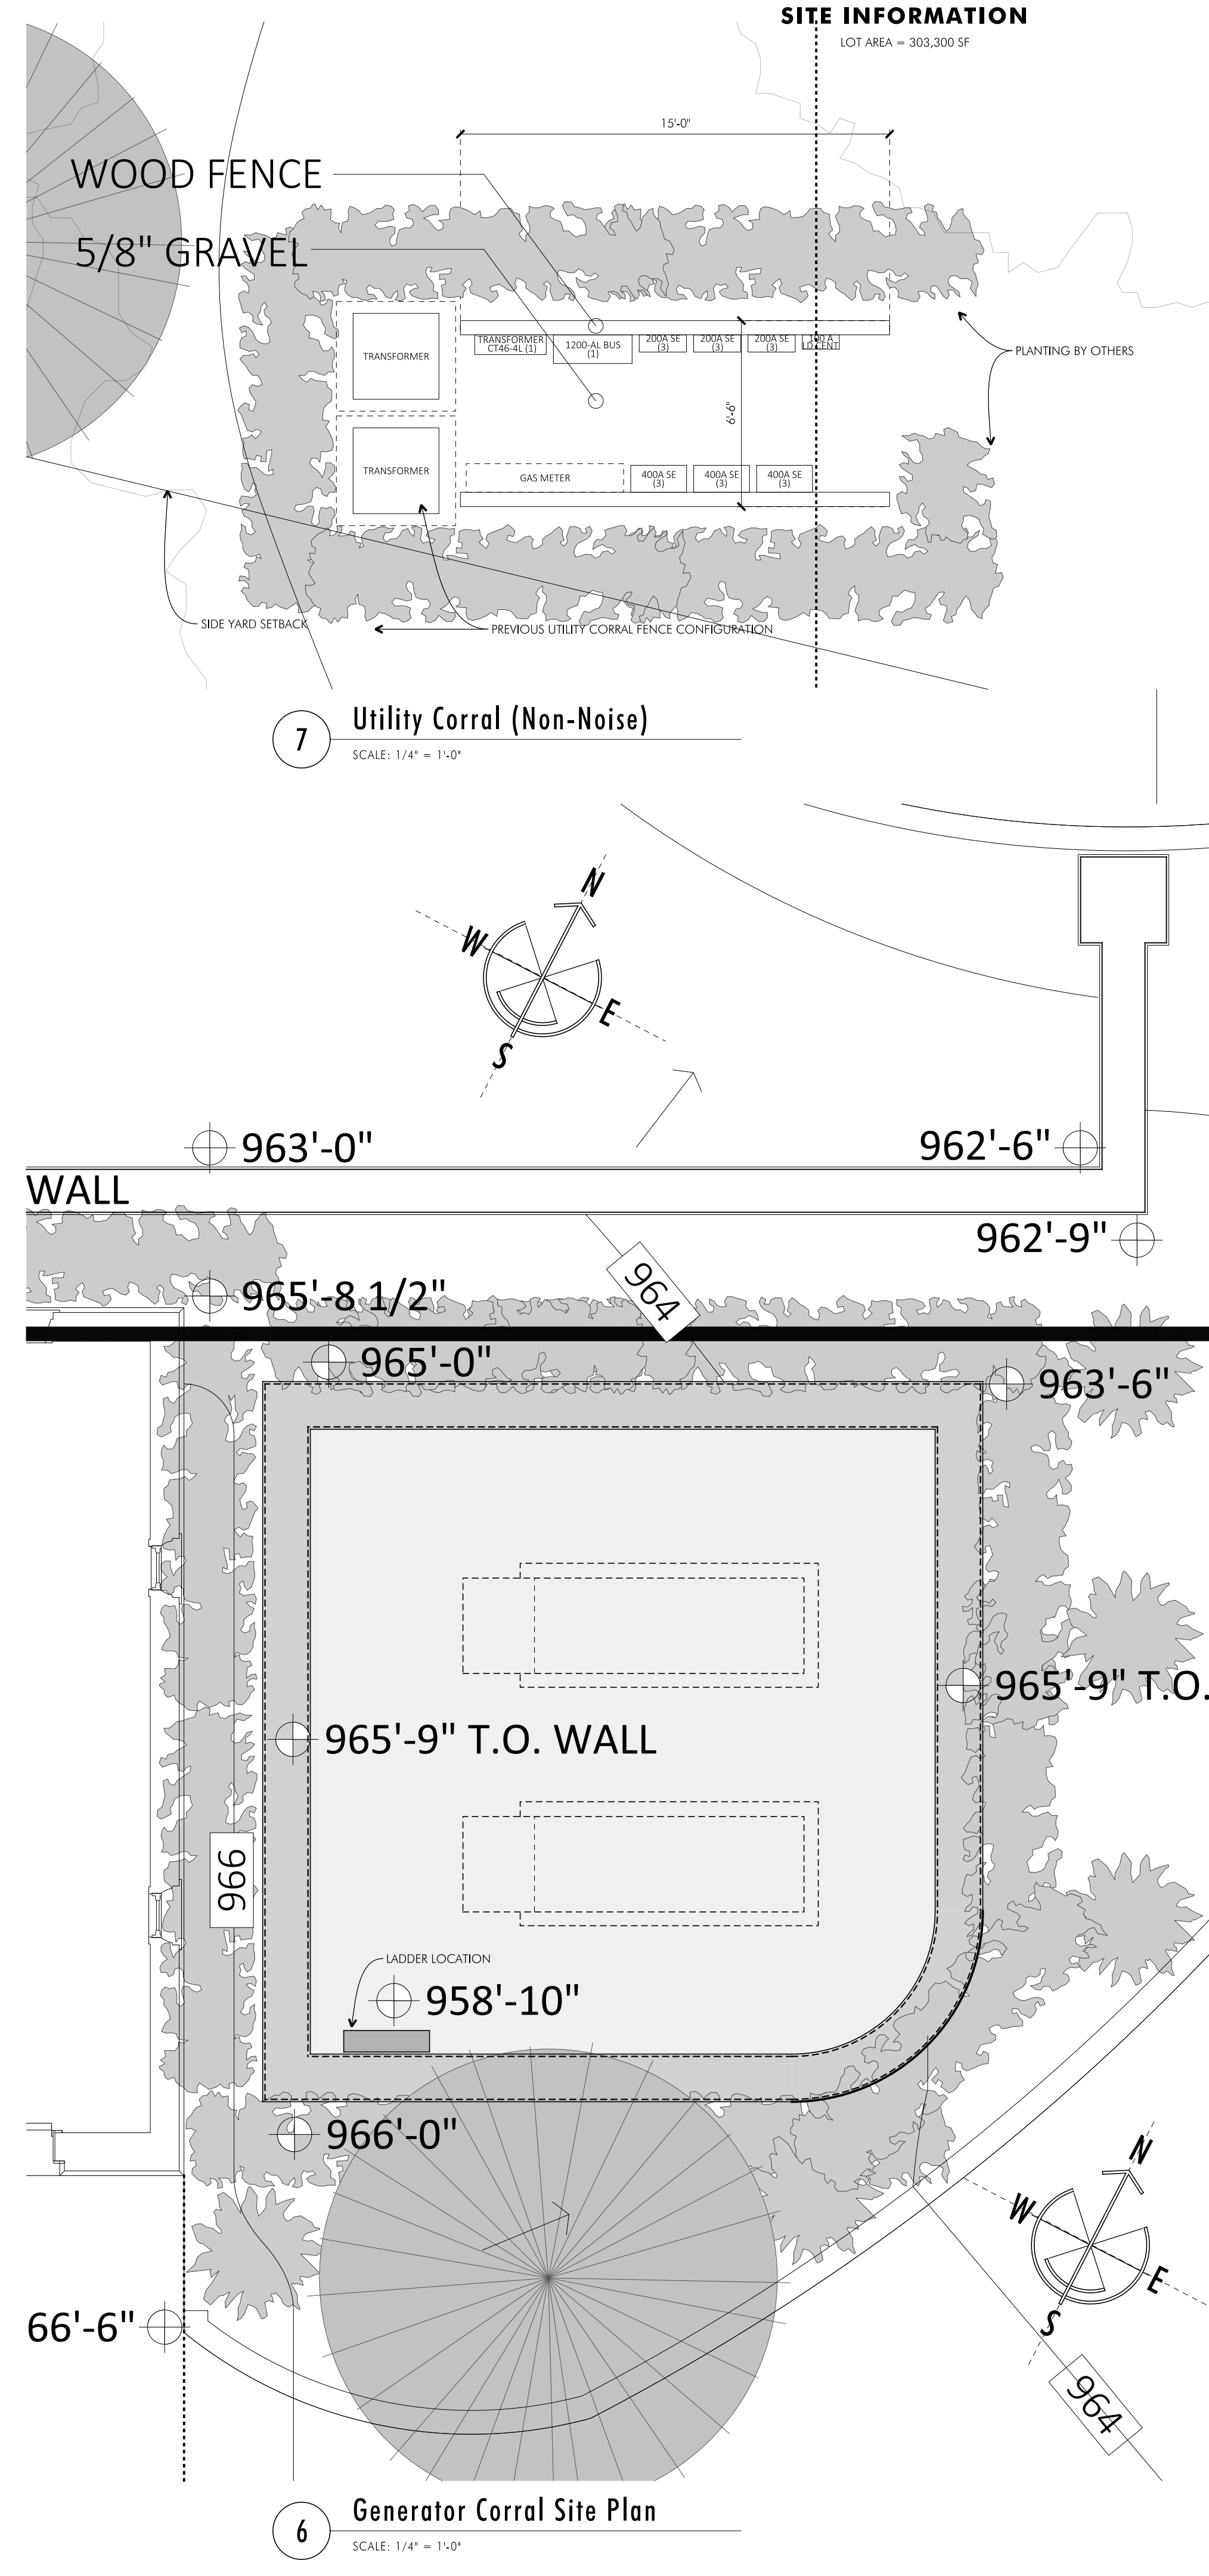

6 Generator Corral Site Plan  
SCALE: 1/4" = 1'-0"

CONTOUR KEY	GENERAL NOTES
1' EXISTING CONTOURS	1. THIS SITE PLAN IS BASED ON SURVEY INFORMATION PROVIDED BY THE OWNER. THE GEN. CONTR. IS RESPONSIBLE FOR VERIFICATION OF EXISTING CONDITIONS, INCLUDING SETBACKS, EASEMENTS AND FINAL LOCATION OF BUILDING.
5' EXISTING CONTOURS	2. G.C. TO VERIFY ALL LOCATIONS OF UTILITIES INTO SITE. PROPOSE ANY NEW LOCATIONS OF UTILITIES TO ARCHITECT & OWNER FOR APPROVAL, PRIOR TO THE COMMENCEMENT OF WORK, IF DIFFERENT THAN SHOWN ON THIS SITE PLAN.
ABANDONED	3. SEE CIVIL DRAWINGS FOR EROSION CONTROL & CONSTRUCTION SITE PLAN.
1' NEW CONTOURS	4. PROTECT ALL EXISTING TREES TO REMAIN WITH PROTECTION FENCE AT OUTER PERIMETER OF TREES AT A MINIMUM, NO DRIVING, STORAGE OR TRENCHING ALLOWED WITHIN DRIPPING.
5' NEW CONTOURS	5. SEE S.I. 0 FOR CONTINUOUS DRAIN TILE AT PERIMETER OF HOUSE AND SLOPE TO OUTFALL OR DISCHARGE W/ SLUMP PUMP.
	6. NEW DRIVEWAY TO BE STAKED BY G.C. FOR APPROVAL BY ARCH. & OWNER BEFORE GRADING COMMENCES IN THAT AREA.
	7. PROVIDE POSITIVE DRAINAGE AWAY FROM HOUSE AT ALL LOCATIONS AS SHOWN ON THIS SITE PLAN.
	8. LANDSCAPE ARCHITECT TO PROVIDE DRAINAGE CATCH BASINS, PLANTINGS AND HARDSCAPE INCLUDING DETAIL RETAINING WALLS.

LANDSCAPE KEYS
EXISTING TREE
NEW TREE

SITE INFORMATION  
LOT AREA = 303,300 SF